


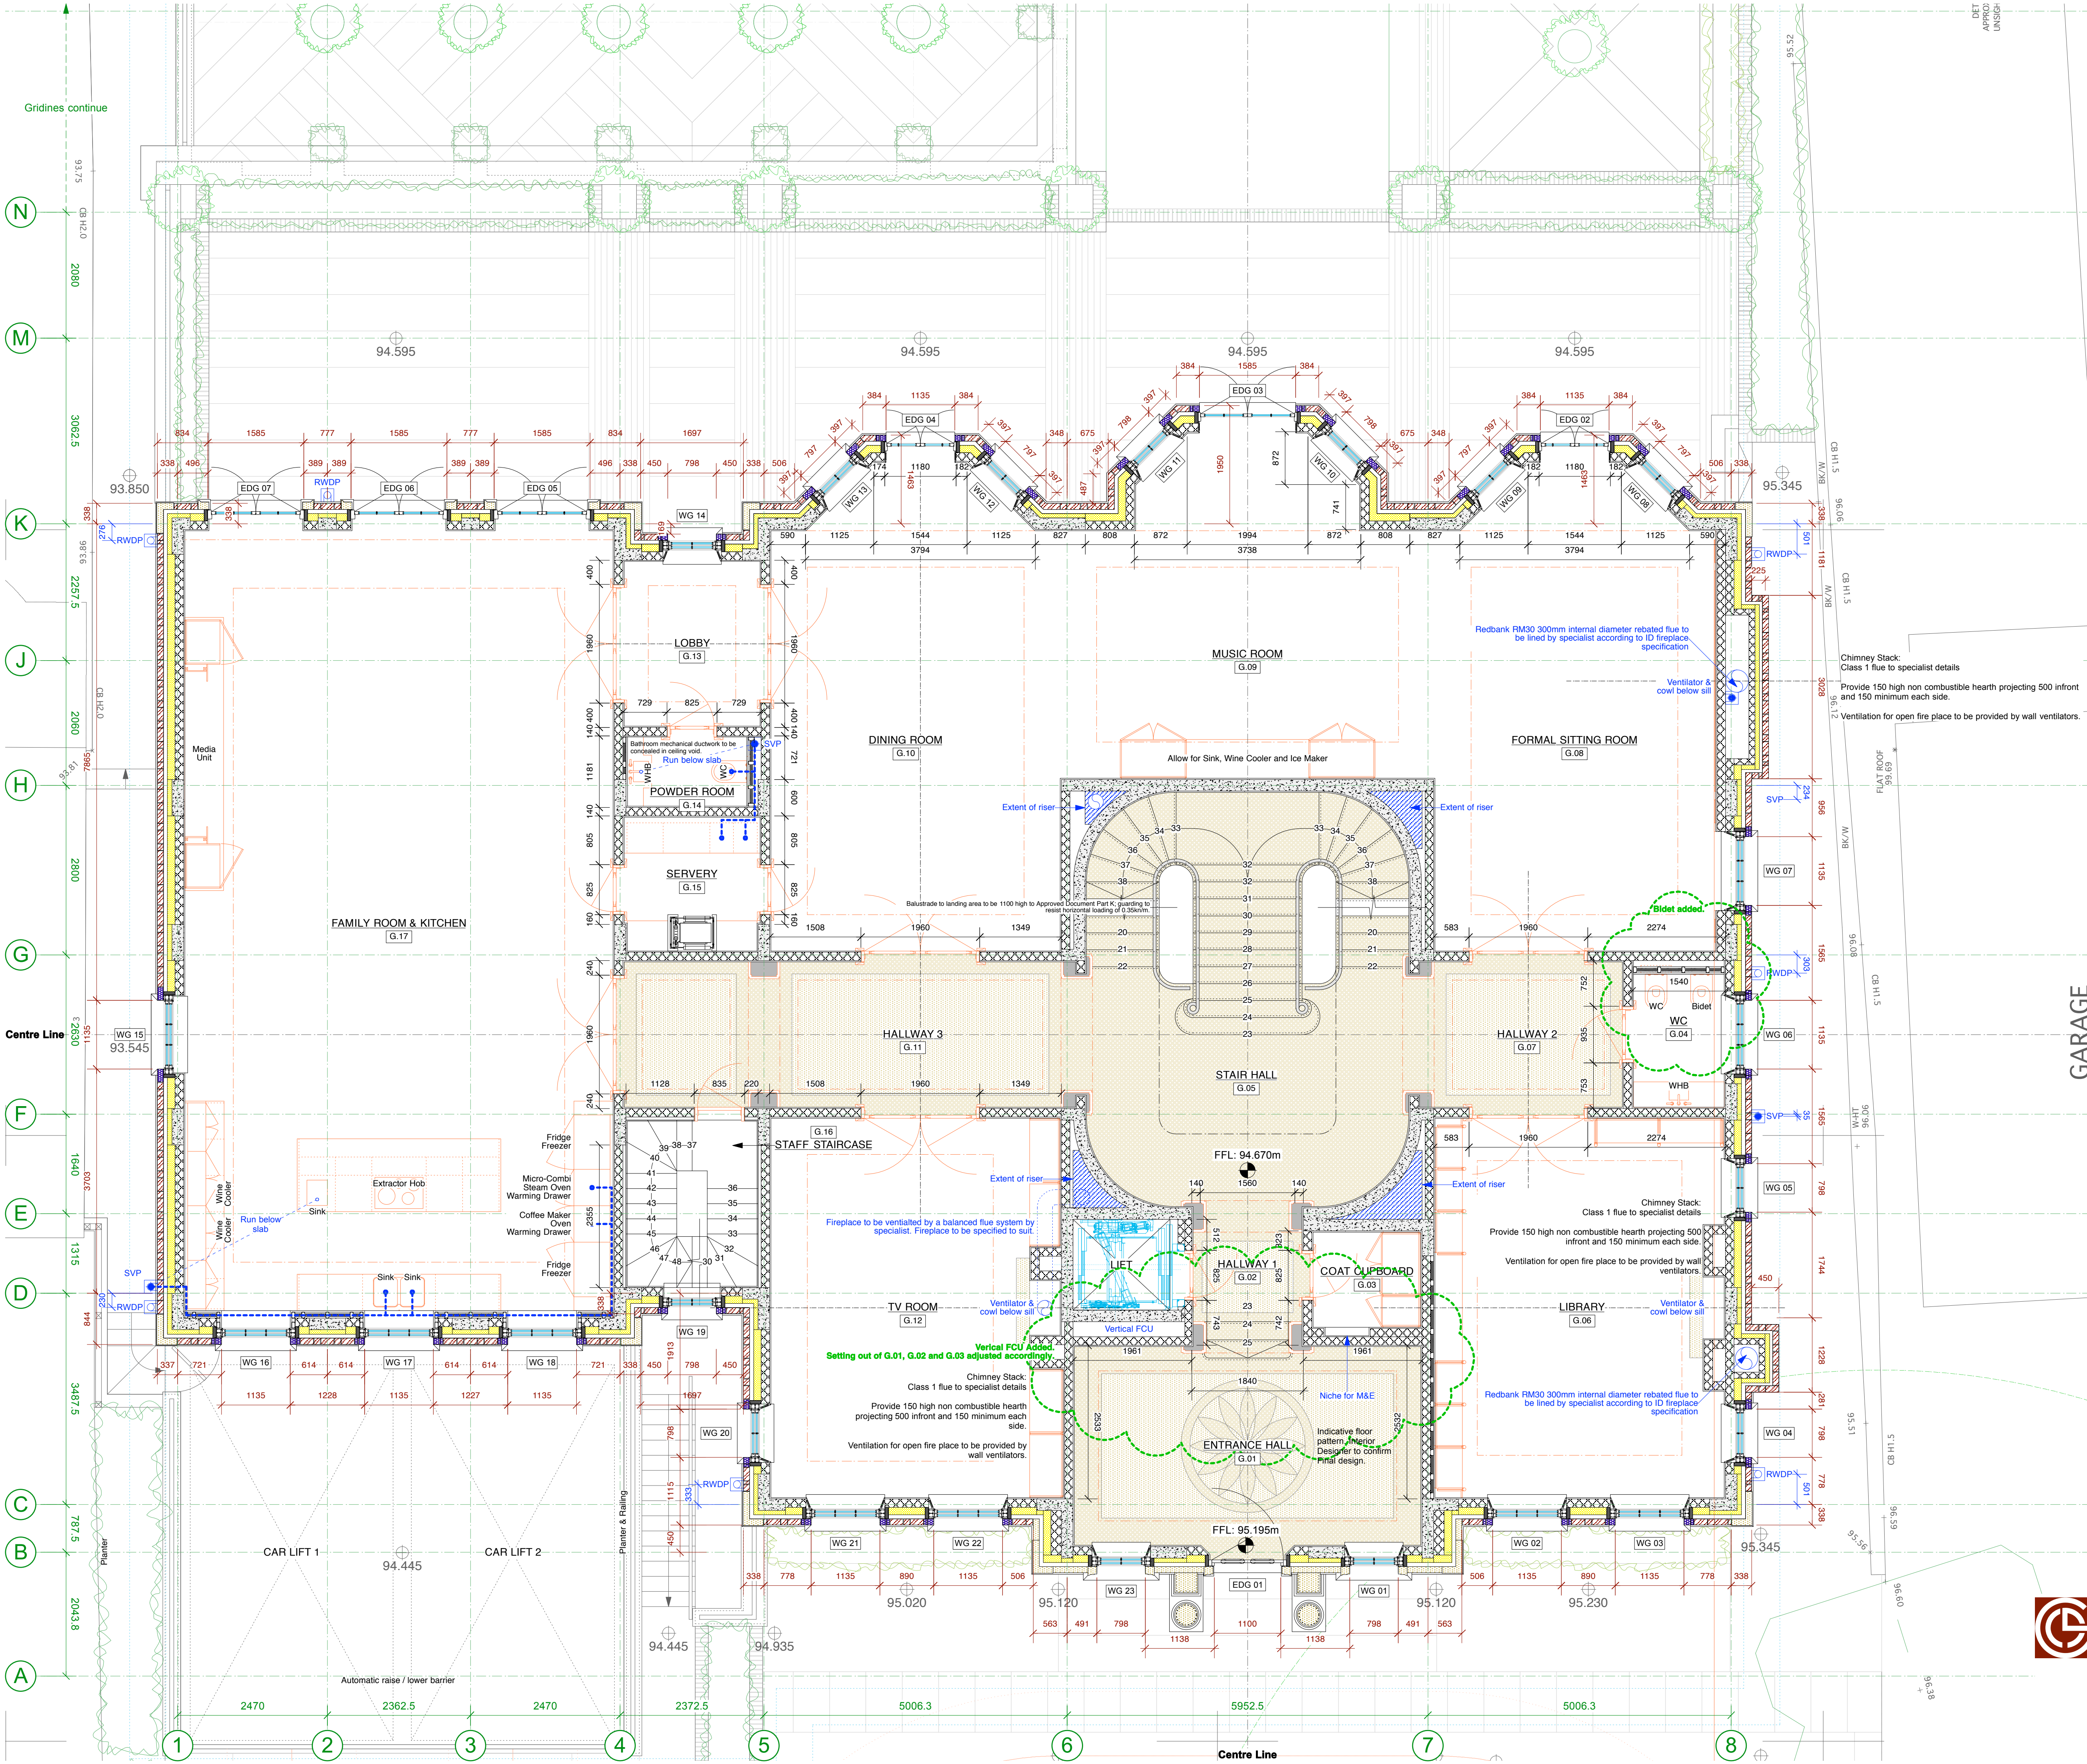

Waterproof reinforced concrete:
To Structural Engineer's details with Grace "Adprute" waterproof additive.

Reinforced concrete:
To Structural Engineer's details.

Insulation:
Foil backed, non-ventilated. All joints to be well taped.

Insulation:
Ventilated.

Insulation:
"Perinsul", by Foamglas, load-bearing insulation element for brickwork laid in mortar bed.

External Stone:
Jordans basebed Portland stone with detailing as shown in elevation.

Brick:
102.5mm HG Matthews machine made 'Hayes Blend' bricks in Flemish bond with 1 cement, 1 lime, 6 sand mortar.

Brick to window reveals:
102.5mm selected bricks from the HG Matthews machine made 'Hayes Blend' (to match the approved sample panel) with 1 cement, 1 lime, 6 sand mortar.

Internal blockwork:
140mm Hemelitte standard lightweight blocks 3.5kn restrained at head.

Other Consultants Information:
Items shown for co-ordination only. Please refer to the latest version of **Argent / Intervari** drawings.

Other Consultants Information:
Items shown for co-ordination only. Please refer to the latest version of **Cooper Homewood** drawings.

Brick Cavity Walls:
HG Matthews machine made 'Hayes Blend' bricks in Flemish bond with 1 cement, 1 lime, 6 sand mortar, cavity, Kingspan Kooltherm K8 dense cavity board insulation, Hemelitte standard lightweight blocks (3.5kn restrained at head) and wet plaster finish.

Brick Structural Cavity Walls:
HG Matthews machine made 'Hayes Blend' bricks in Flemish bond with 1 cement, 1 lime, 6 sand mortar, cavity, Kingspan Kooltherm K8 Dense Cavity Board insulation, reinforced concrete structure to SE's details and wet plaster finish.

Basement Walls:
Reinforced waterproof concrete to SE's details (Grace Preprute waterproofing membrane to external face, Grace Hydrodud cavity drain to internal face), cavity partially filled with Kingspan Kooltherm K8 Dense Cavity Board insulation, Hemelitte standard lightweight blocks (3.5kn restrained at head) and wet plaster finish.

Stone Cavity Walls:
Jordans basebed Portland stone with detailing as shown in elevation, cavity, Kingspan Kooltherm K8 Dense Cavity Board insulation, reinforced concrete structure to SE's details and wet plaster finish.

Stone Structural Cavity Walls:
Jordans basebed Portland stone with detailing as shown in elevation, cavity, Kingspan Kooltherm K8 Dense Cavity Board insulation, reinforced concrete structure to SE's details and wet plaster finish.

440 x 215 x 140mm (as shown) thick Hemelitte standard lightweight blocks with 20mm thick wet plaster (to faces shown). All walls to be restrained at head.

British Gypsum single frame acoustic wall system - Gypwall Quiet SF - 60mins. fr & rw61 db acoustic rating; Gypframe studs to suit partition height, 50mm Isover APR1200 in cavity. 2no. layers of 12.5mm British Gypsum 'Soundbloc' to both sides with skim finish.

NB: moisture resistant board to be used in wet areas.

Allow for expansion joints to be formed as per drawings.

Movement joints - low modulus modified polymer sealant on closed cell expanded polyethylene foam.

Tops of walls to be fire stopped with intumescent sealant on intumescent foam filler to u/s of structure to provide 60mins fr.

All details of building enclosure to be executed so as to ensure air tightness and compliance with the requirements of ad part 11b.

Sanitaryware shown for M&E design and first fix only.

See Interior Design drawings / information for all interior finishes specifications, furniture and fittings.

Sample panels of external brickwork are to be provided to CBA and approved in writing before work on this item is carried out.

Masons detailed drawings of all stonework items are to be provided to CBA and approved in writing prior to fabrication.

details	date	by	rev
Tender Issue - Blockwork setting out added. Drawing issued for internal wall construction...	25/02/15	CT	T6
Tender Issue - Setting out of G.04, G.07, G.13 and G.14 confirmed. Drawing issued for internal wall construction.	09/03/15	CT	T7
Tender Issue - Alterations highlighted in PINK. Drawing issued for M&E update.	16/03/15	CT	T8
Tender Issue - Rear bay window check dims added. Lift and Coat Cupboard (G.03) door locations confirmed.	14/04/15	CT	T9
Tender Issue - Setting out to Main entrance facade.	17/04/15	NC	T10
Tender Issue - Additional lining wall to G.01 added.	29/07/15	CT	T11
Tender Issue - See changes shown in GREEN.	17/08/15	CT	T12
Tender Issue - See changes shown in GREEN.	30/09/15	CT	T13

SECTION KEY

EXTERNAL WALL LEGEND

WALL TYPE 1.1

WALL TYPE 1.2

WALL TYPE 1.3

WALL TYPE 1.4

WALL TYPE 1.5

WALL TYPE 1.6

WALL TYPE 1.7

INTERNAL PARTITIONS

Charlton Brown Architects

Ridgefield, Courtenay Avenue, London N6 4LP.

G.A. Ground Floor Plan

1186 / WD 103

The Belvedere, 2 Back Lane, Hampstead, London NW3 1HL. Scale 1:50 @ A1(L), 1:100 @ A3(L)
T 020 7794 1234 F 020 7435 5085 E office@charltonbrown.com This drawing is copyright
Please follow the drawings exactly. If you find errors or omissions ask for clarification. Do not proceed without revised instructions. No dimensions to be scaled