


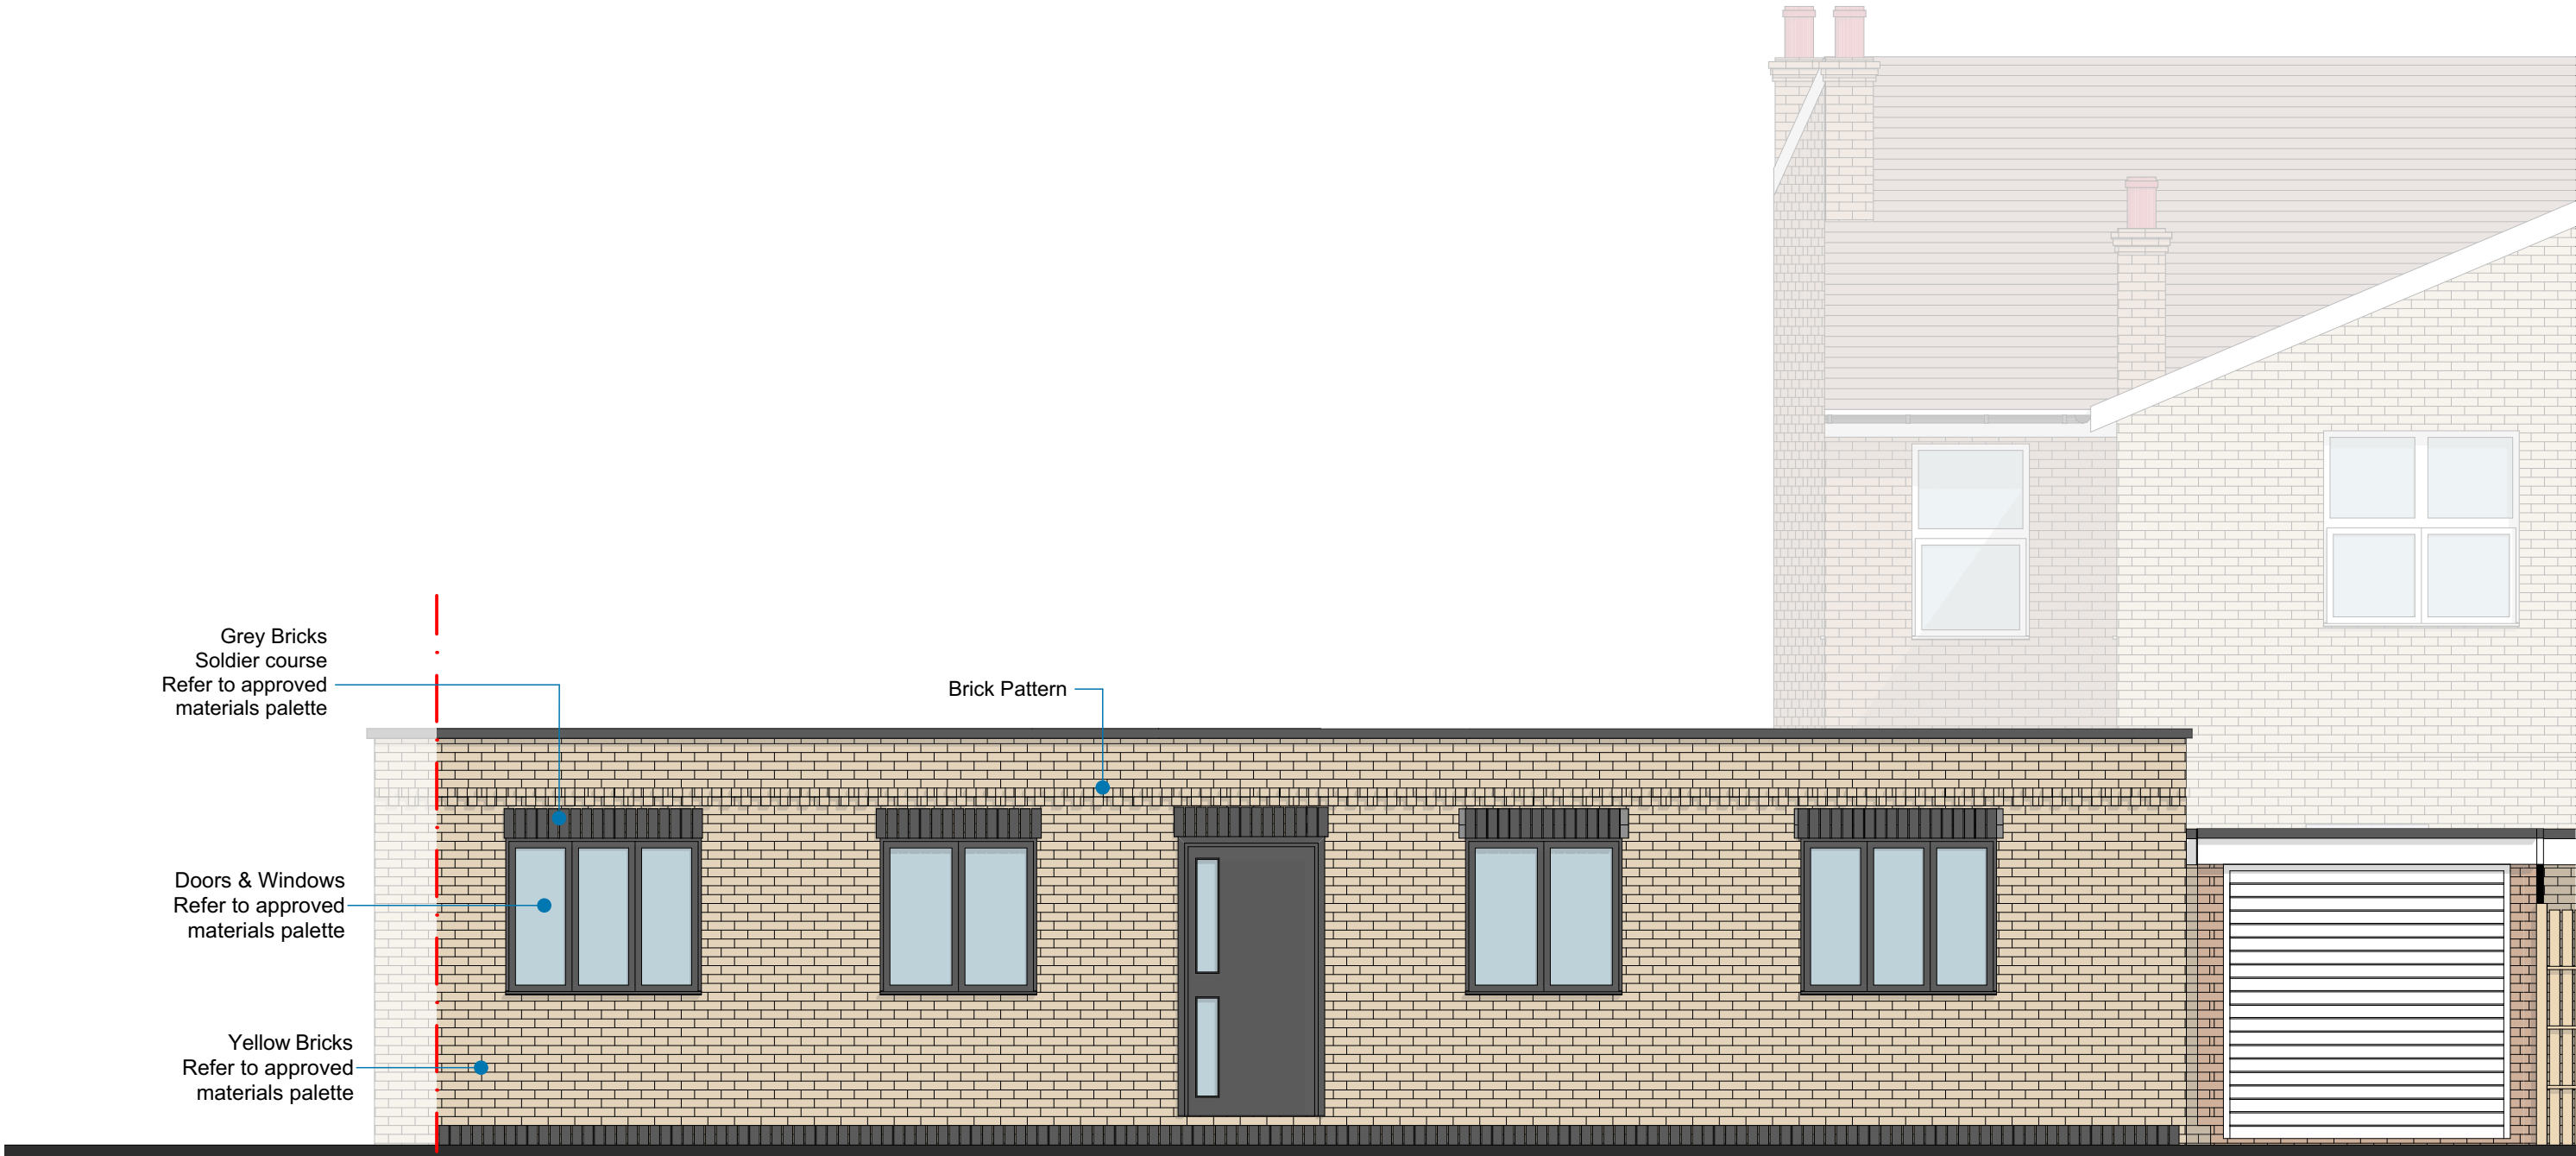

Existing (As Built) Front Elevation 1:50

COPYRIGHT: The contents of this drawing may not be reproduced in whole or in part without express written consent of ARKSS Design Limited.

Drawings to be read in conjunction with relevant drawing and specs. Drawings can only be scaled for planning purposes. Drawings not to be scaled. figured dimensions only for construction and anyother purpose. Any discrepancies are to be pointed to the Agent/Engineer/Contractor. The agent is not liable for any faults not raised. Drawings not to be scaled for land transfer purposes.

PLANNING ISSUE

Scale: 1:50@A3

Date: May 2023

Project Title:
RETENSION OF FRONT ELEVATION
AT 75 WINDERMERE ROAD,
LONDON, N10 2RD

Drawing Title:
**EXISTING (As Built)
ELEVATIONS**

Project no:
2305007

Drawing no:
PL04

Revision:

Revision Detail Date:

E.mail:
contact@arkssdesign.co.uk
Tel: 0208 0905070
Mob: 078 2555 7465