


This confidential drawing and the copyright is the property of MD Designs and is neither to be copied in any way nor disclosed to any third party without the express and written consent of MD Designs. This drawing is to be read strictly together with the Specification and the Employer Requirement Schedule. Any conflict between the Specification and any drawings shall be referred to MD Designs for decision.

The Contractor, and all specialist Sub-contractors are to check all levels, dimensions and features on site prior to performing any element of work or installations. Any and all discrepancies are to be reported immediately to MD Designs for decision.


PLANNING & BUILDING CONTROL PERMISSION TO BE OBTAINED PRIOR TO COMMENCEMENT OF WORK ON SITE CLIENT & CONTRACTOR TAKE FULL RESPONSIBILITY FOR WORK COMMENCED PRIOR TO LOCAL AUTHORITY APPROVAL

DO NOT SCALE FROM THIS DRAWING

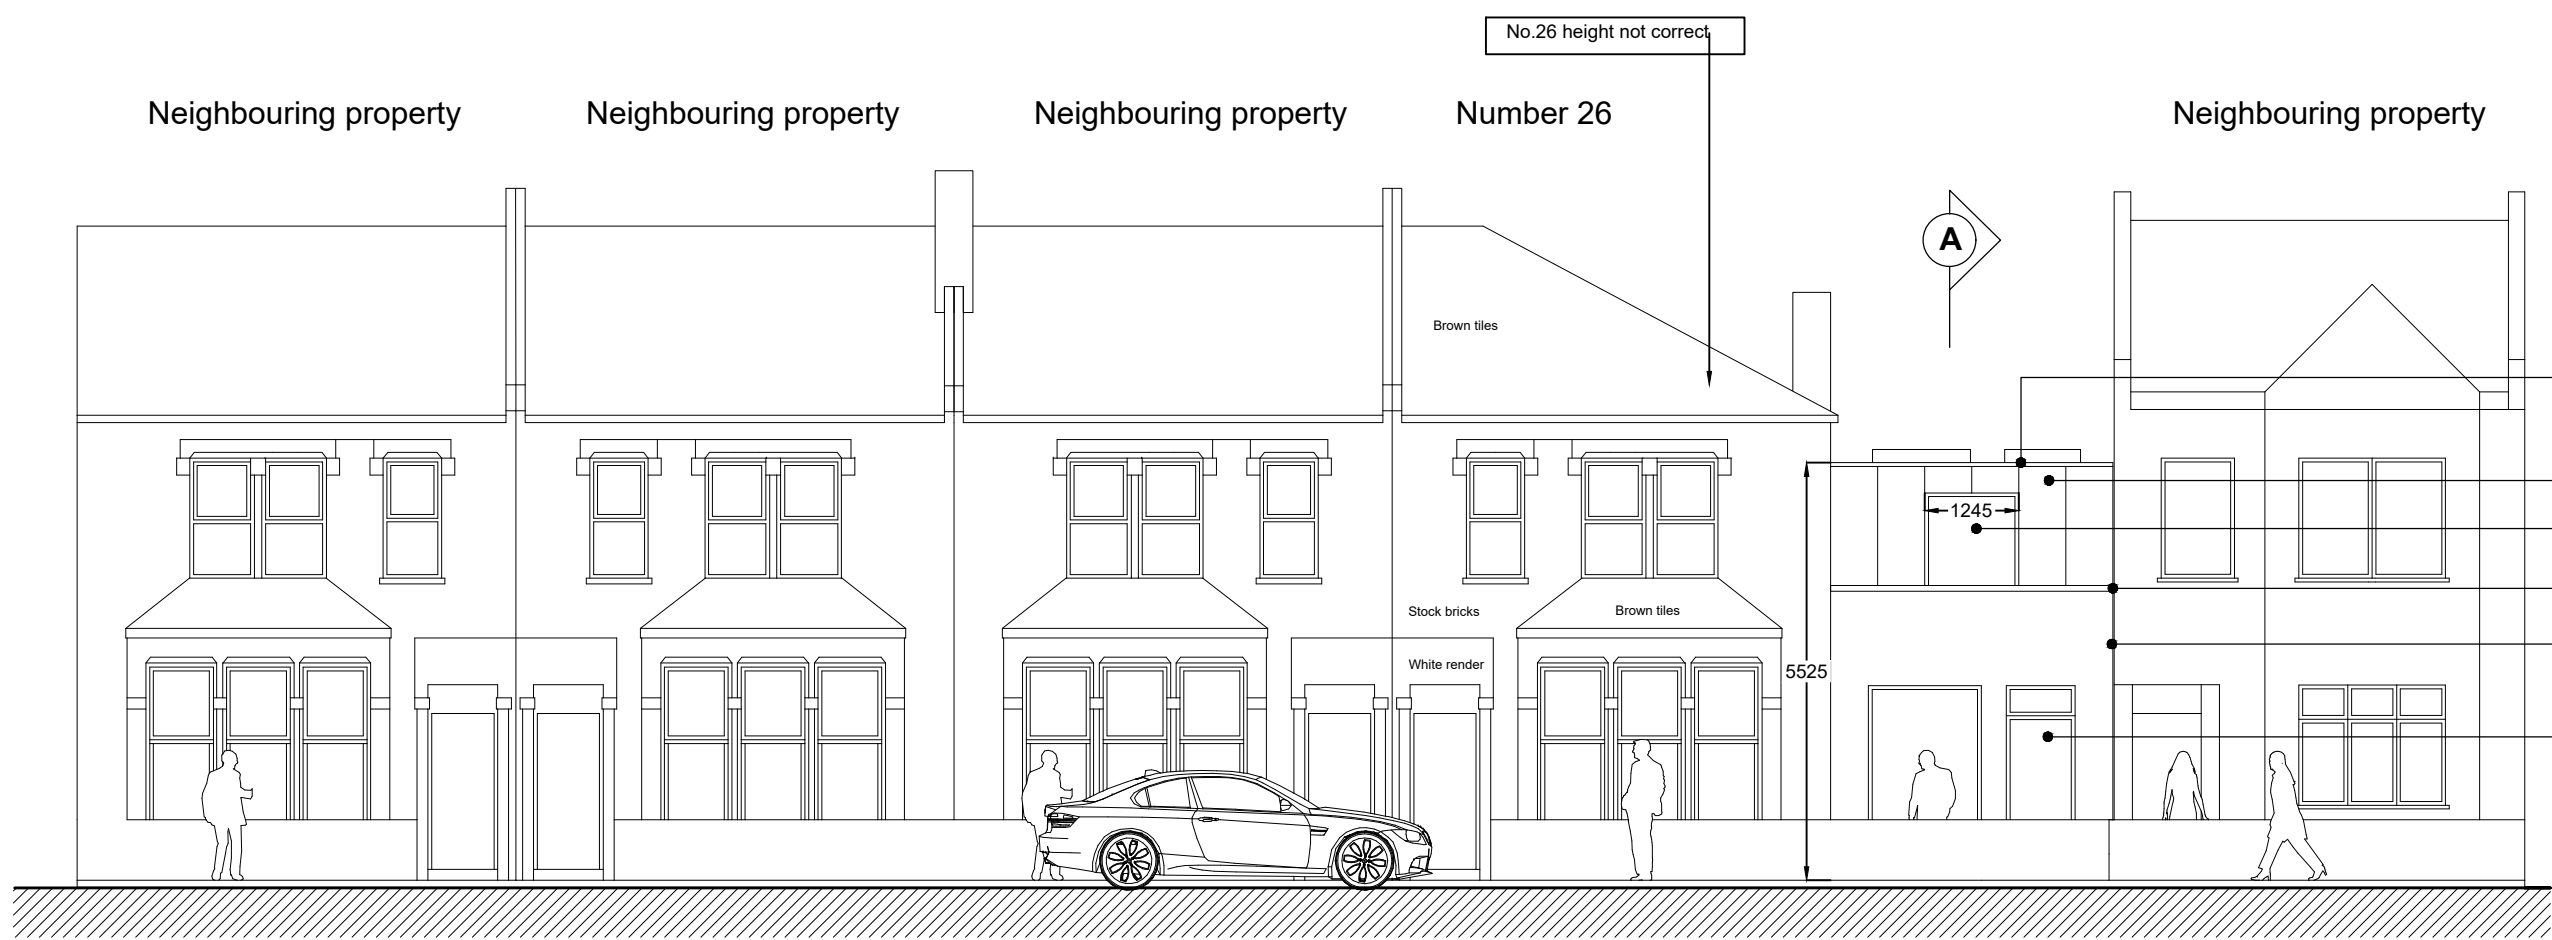

HERMITAGE ROAD
Street scene elevation as approved

- Facing materials
1. Green roof sphagnum moss
 2. Grey colour vertical cladding panel
 3. White colour sealed double glazed unit
 4. Natural finish Concrete coping stone
 5. Yellow stock brickwork
 6. White colour sealed double glazed door
 7. door canopy

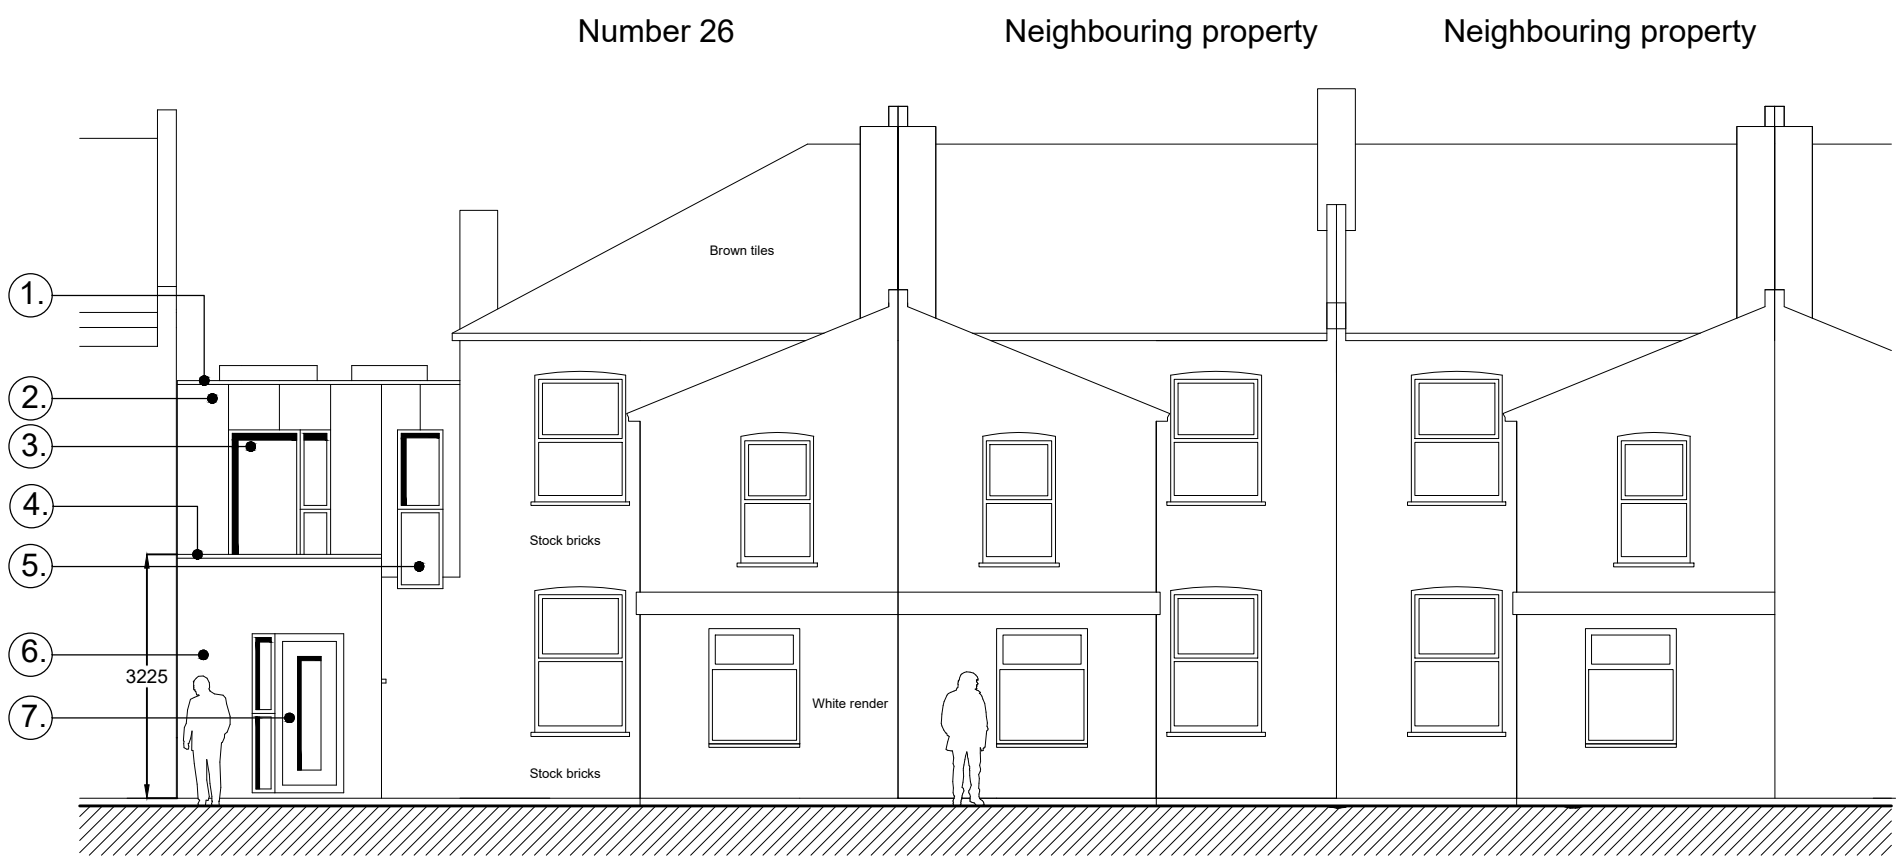


VALE ROAD
Rear elevation as approved

- Facing materials
1. Green roof sphagnum moss
 2. Grey colour vertical cladding panel
 3. White colour sealed double glazed unit
 4. Natural finish Concrete coping stone
 5. Grey colour solid infill panel
 6. Yellow stock brickwork
 7. Composite door and window set



HERMITAGE ROAD
Street scene elevation proposed

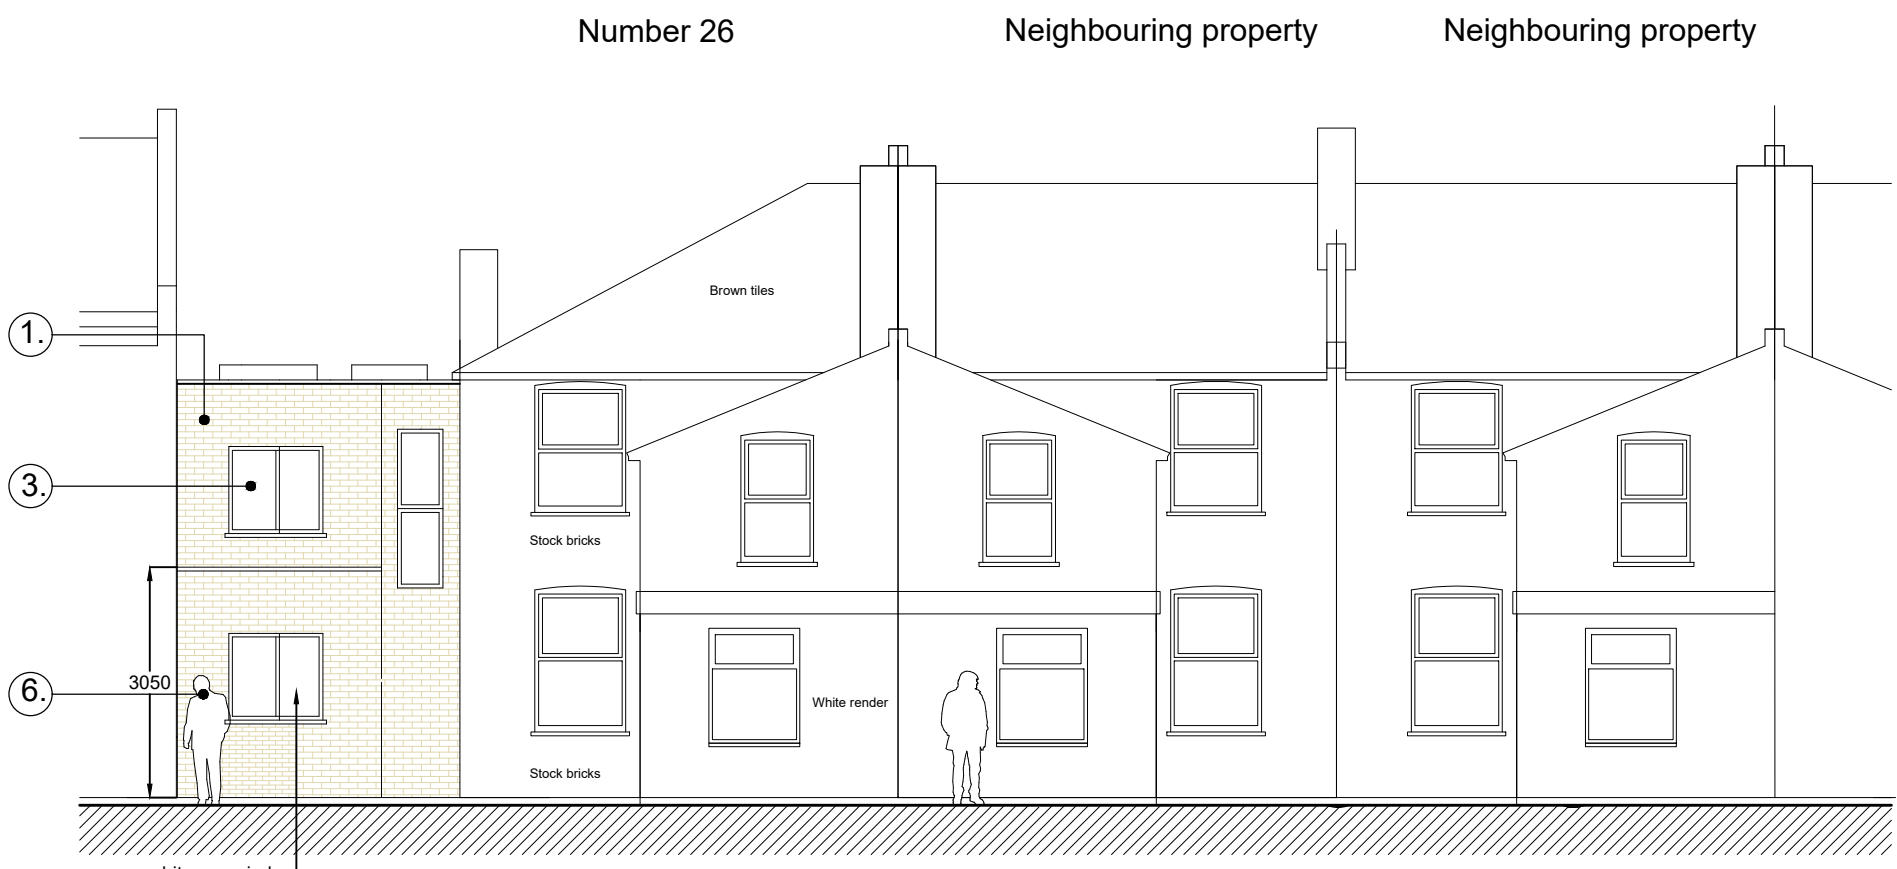

VALE ROAD
Rear elevation as built



0 5m

1:100 Scale

0 2m

1:50 Scale

..\\..\\Desktop\\logo.jpg

Where new work is on/near boundary line/party wall the property owner is to serve party wall notice to the adjoining property/land owner in accordance with the requirements of the 'Party Wall etc.' Act 1996.

CLIENT

sms property investments ltd

Proposal

elevations

LOCATION

26 Hermitage Road
London
N4 1LY

Date: 15 November 2023

Scale: A1@1:100

Dwg: 31/19 1

Drawn by: md

Rev Details Date

MD DESIGNS
UNIT 6-7 EAST LODGE VILLAGE,
EAST LODGE LANE, ENFIELD,
EN2 8AS
01992 630 520