
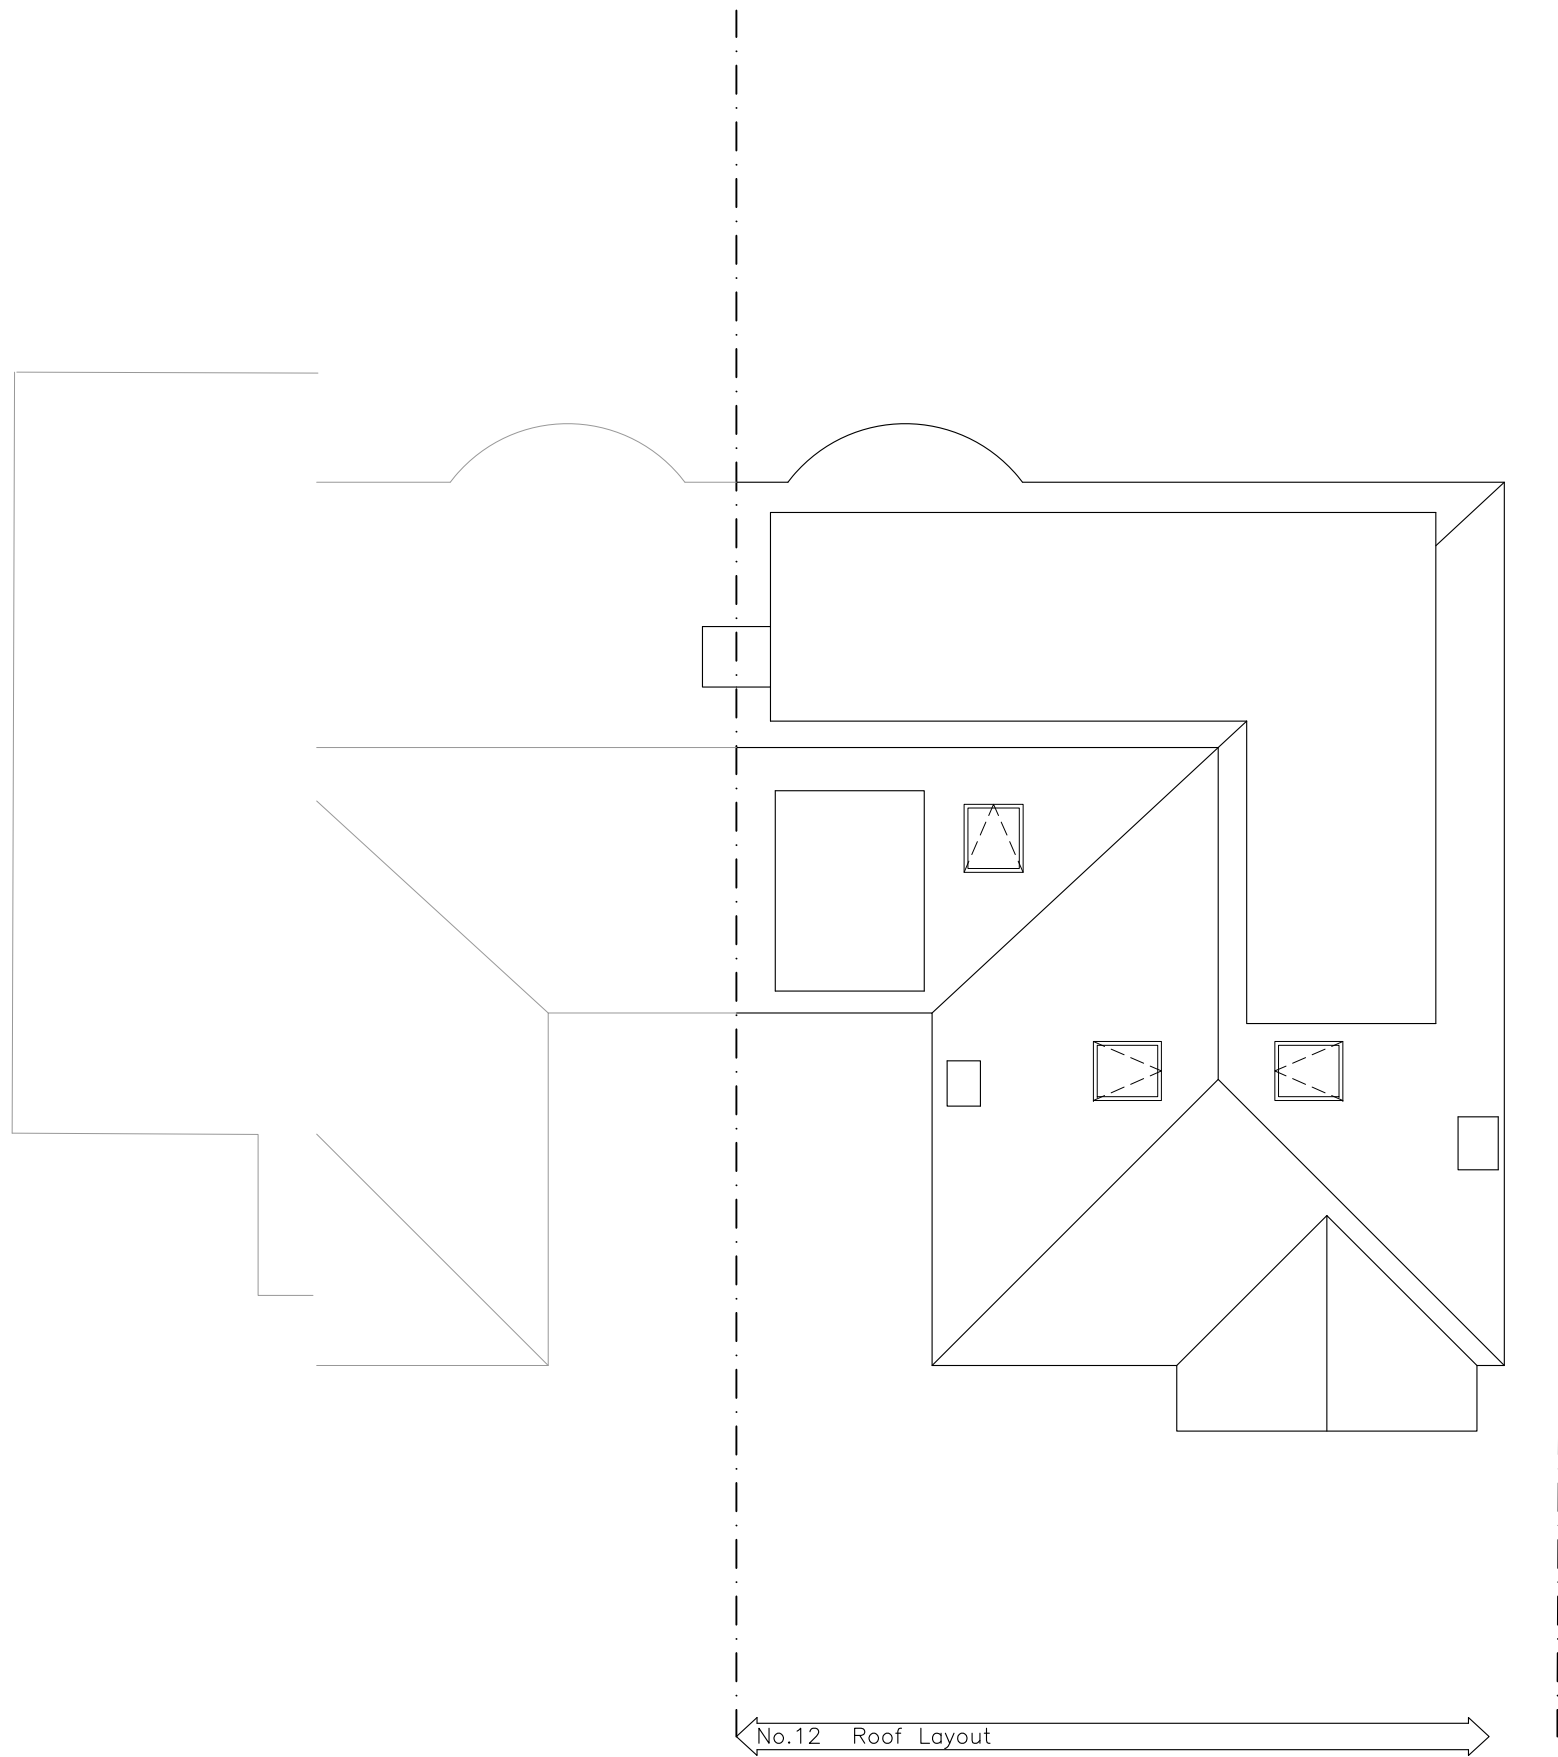
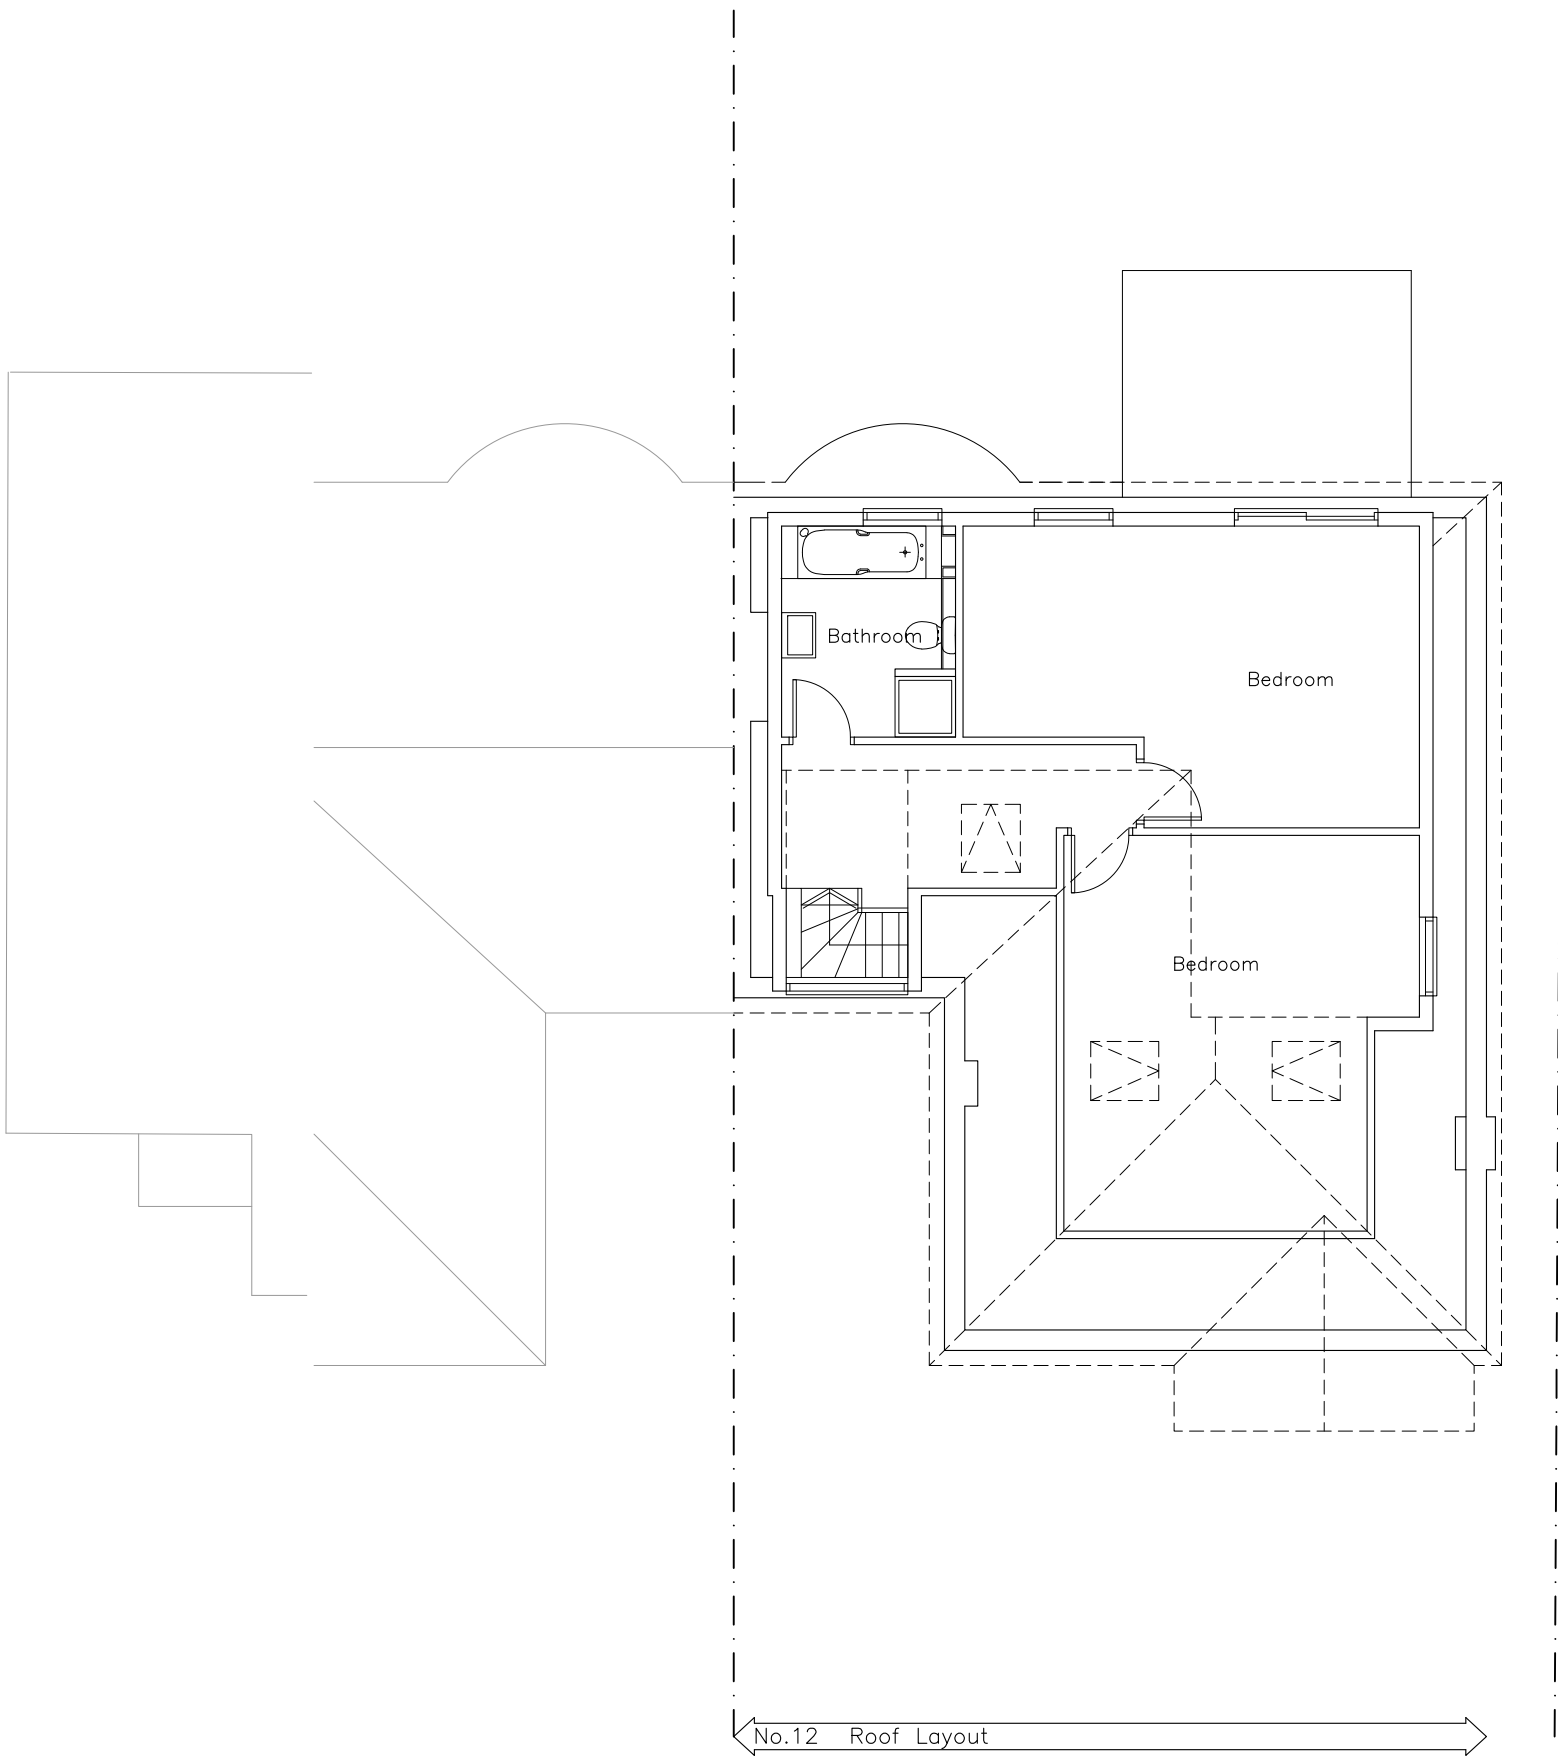
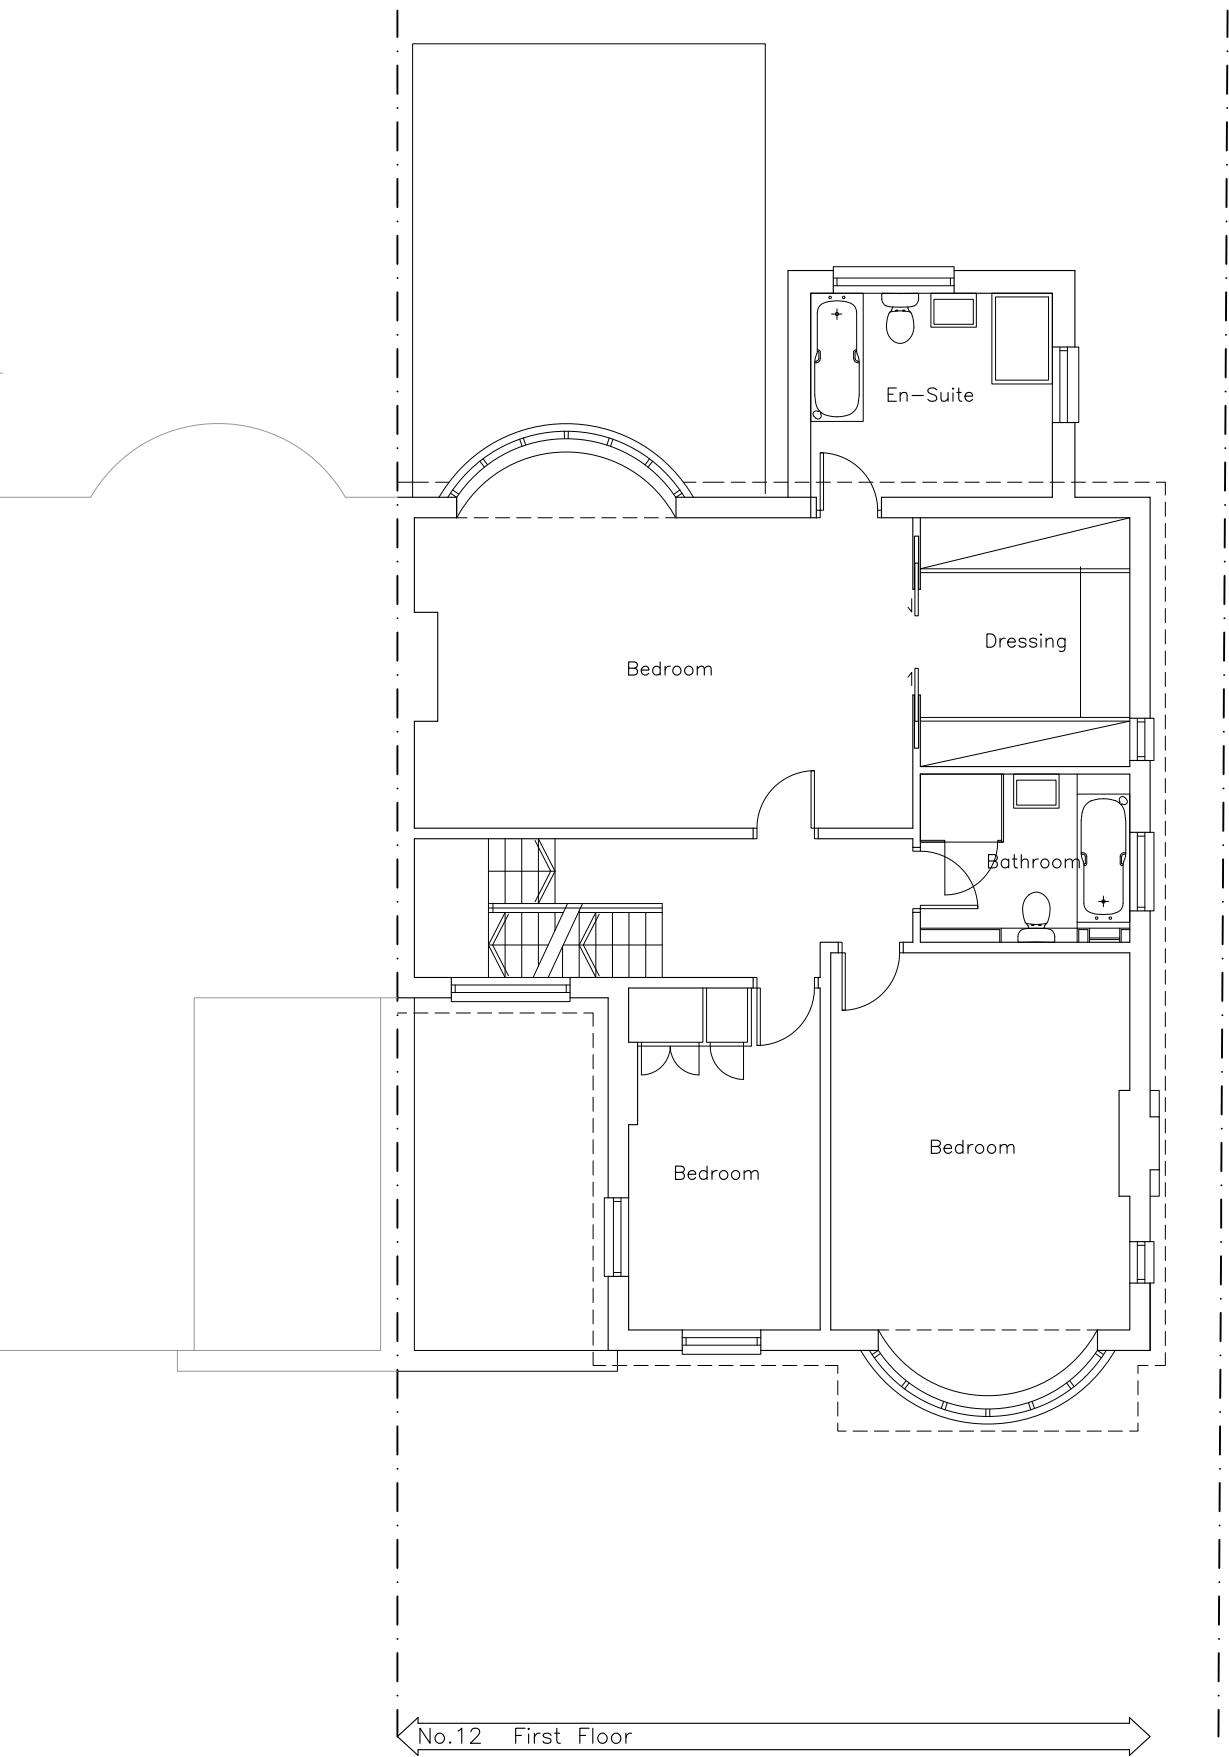


Do not scale: All written dimensions must be checked on site before work commences on site or in shop. Figured dimensions take precedence over those scaled. Discrepancies, where identified must be reported immediately.

All work must be carried out in accordance with the Building Regulations and to the satisfaction of the Local Authority.

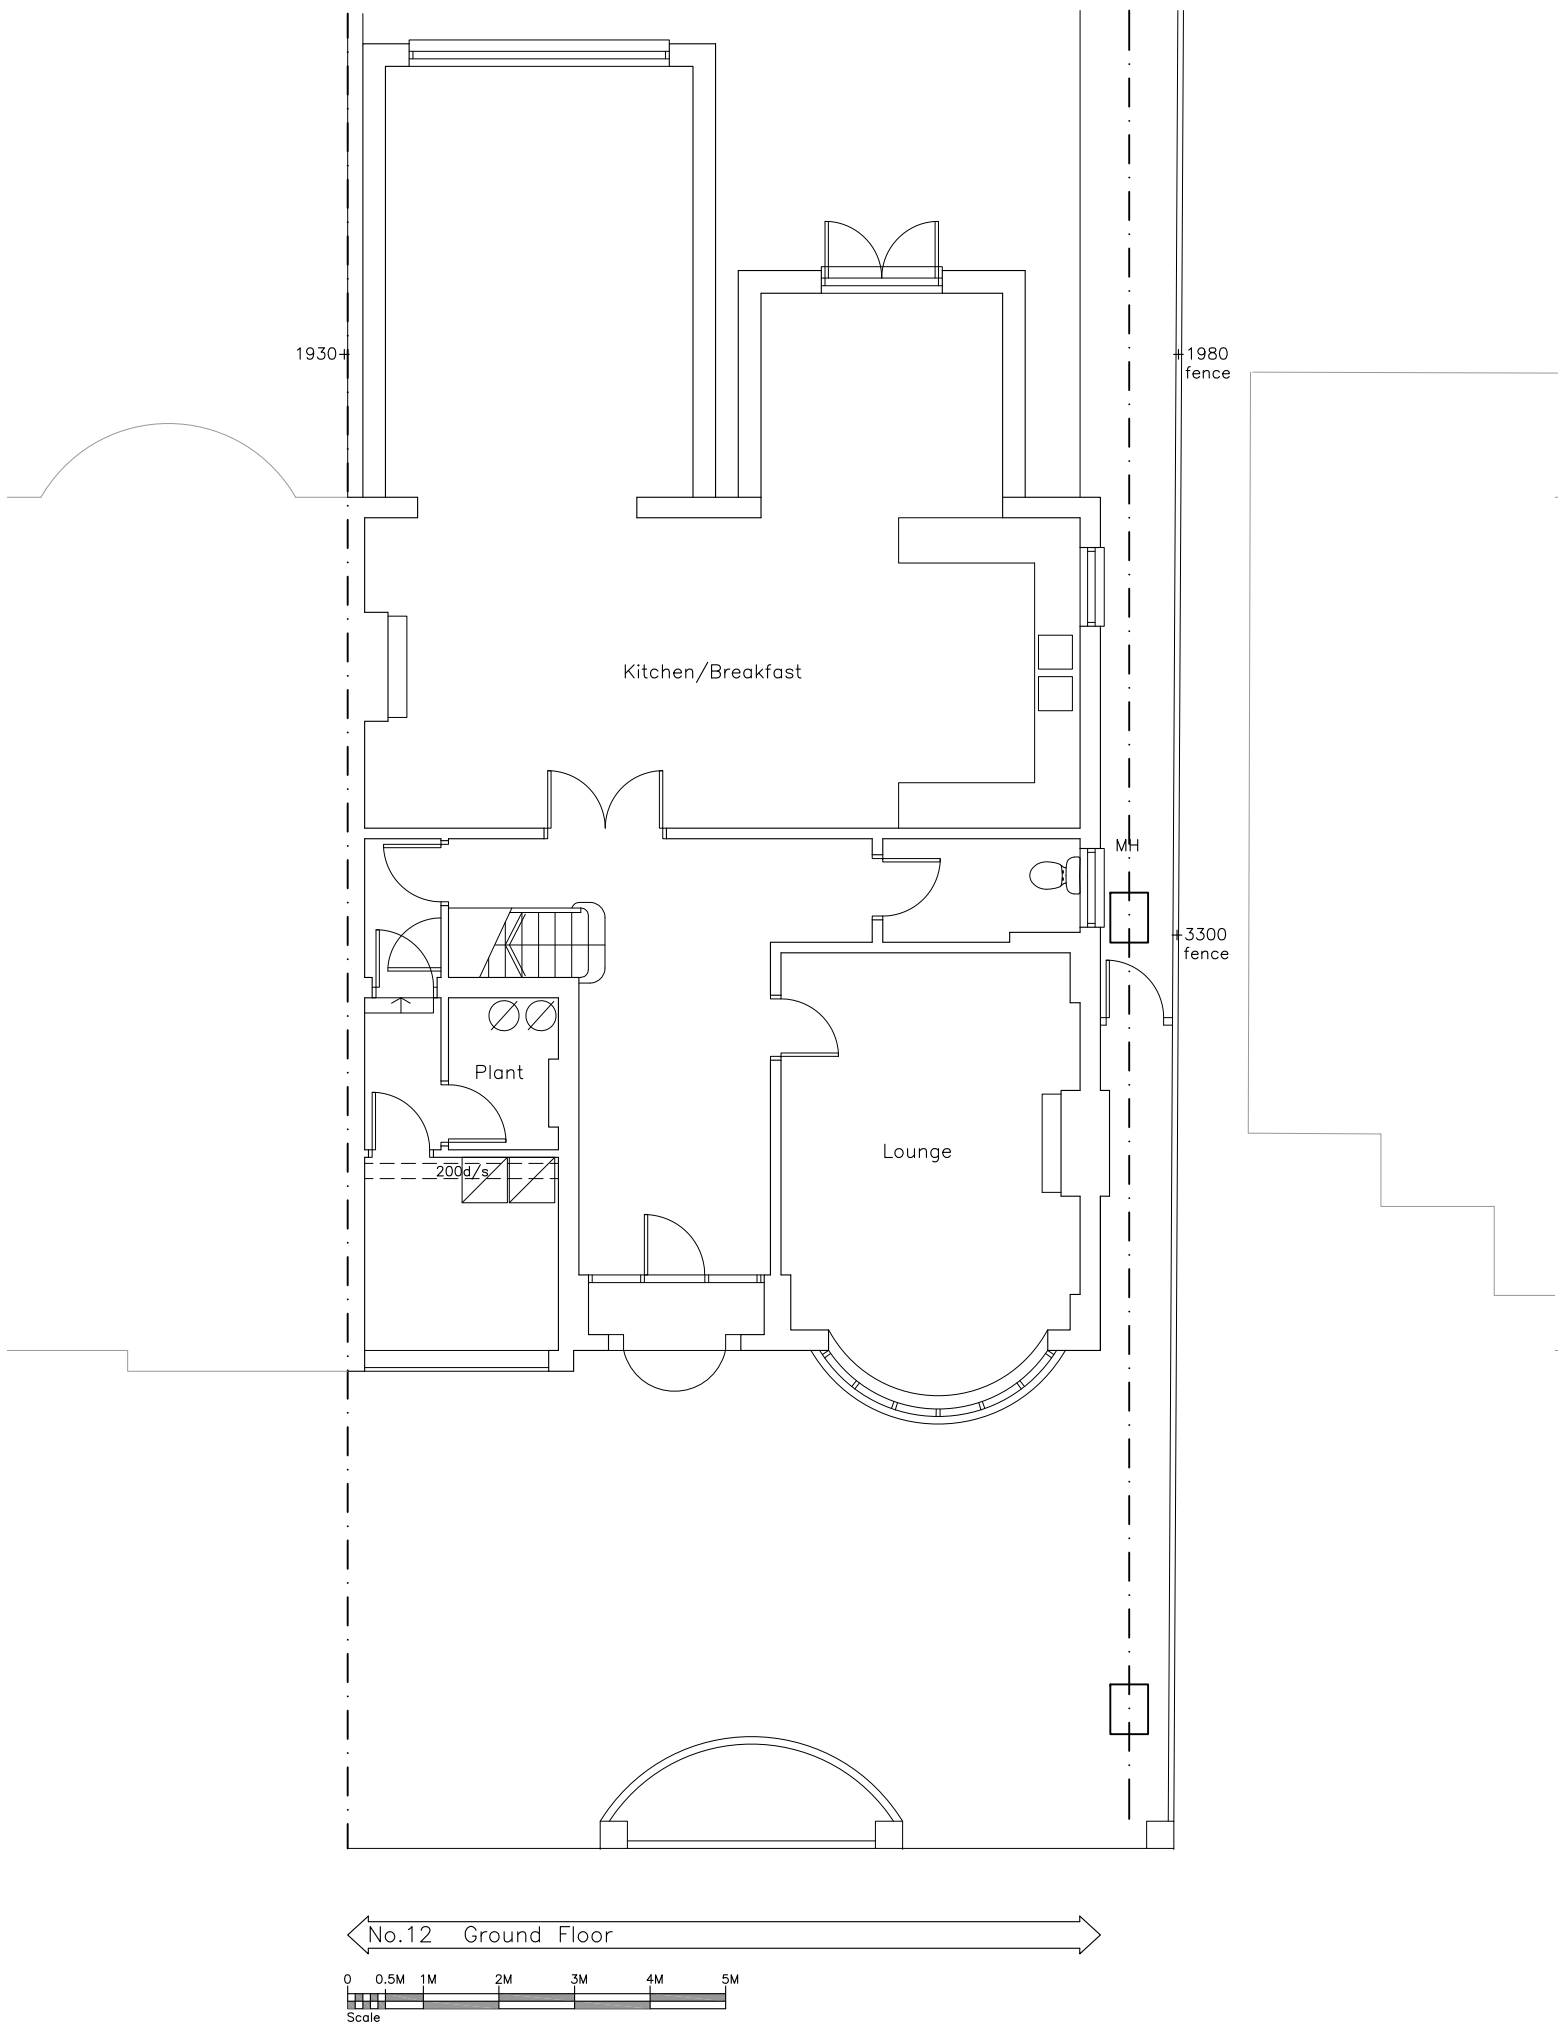

Client:

Project Title:
12 Bancroft Avenue
East Finchley
London
N2 0AS

Drawing Title:
Existing As-built Floor Plans
and Elevations

Drawn: Date: 27.11.2023

Scale: 1:100 @ A1

Dwg.No.: BA.01.13

HARTLEYS PROJECTS LTD
PO BOX 43391, LONDON
N5 1SZ 07919 893380