


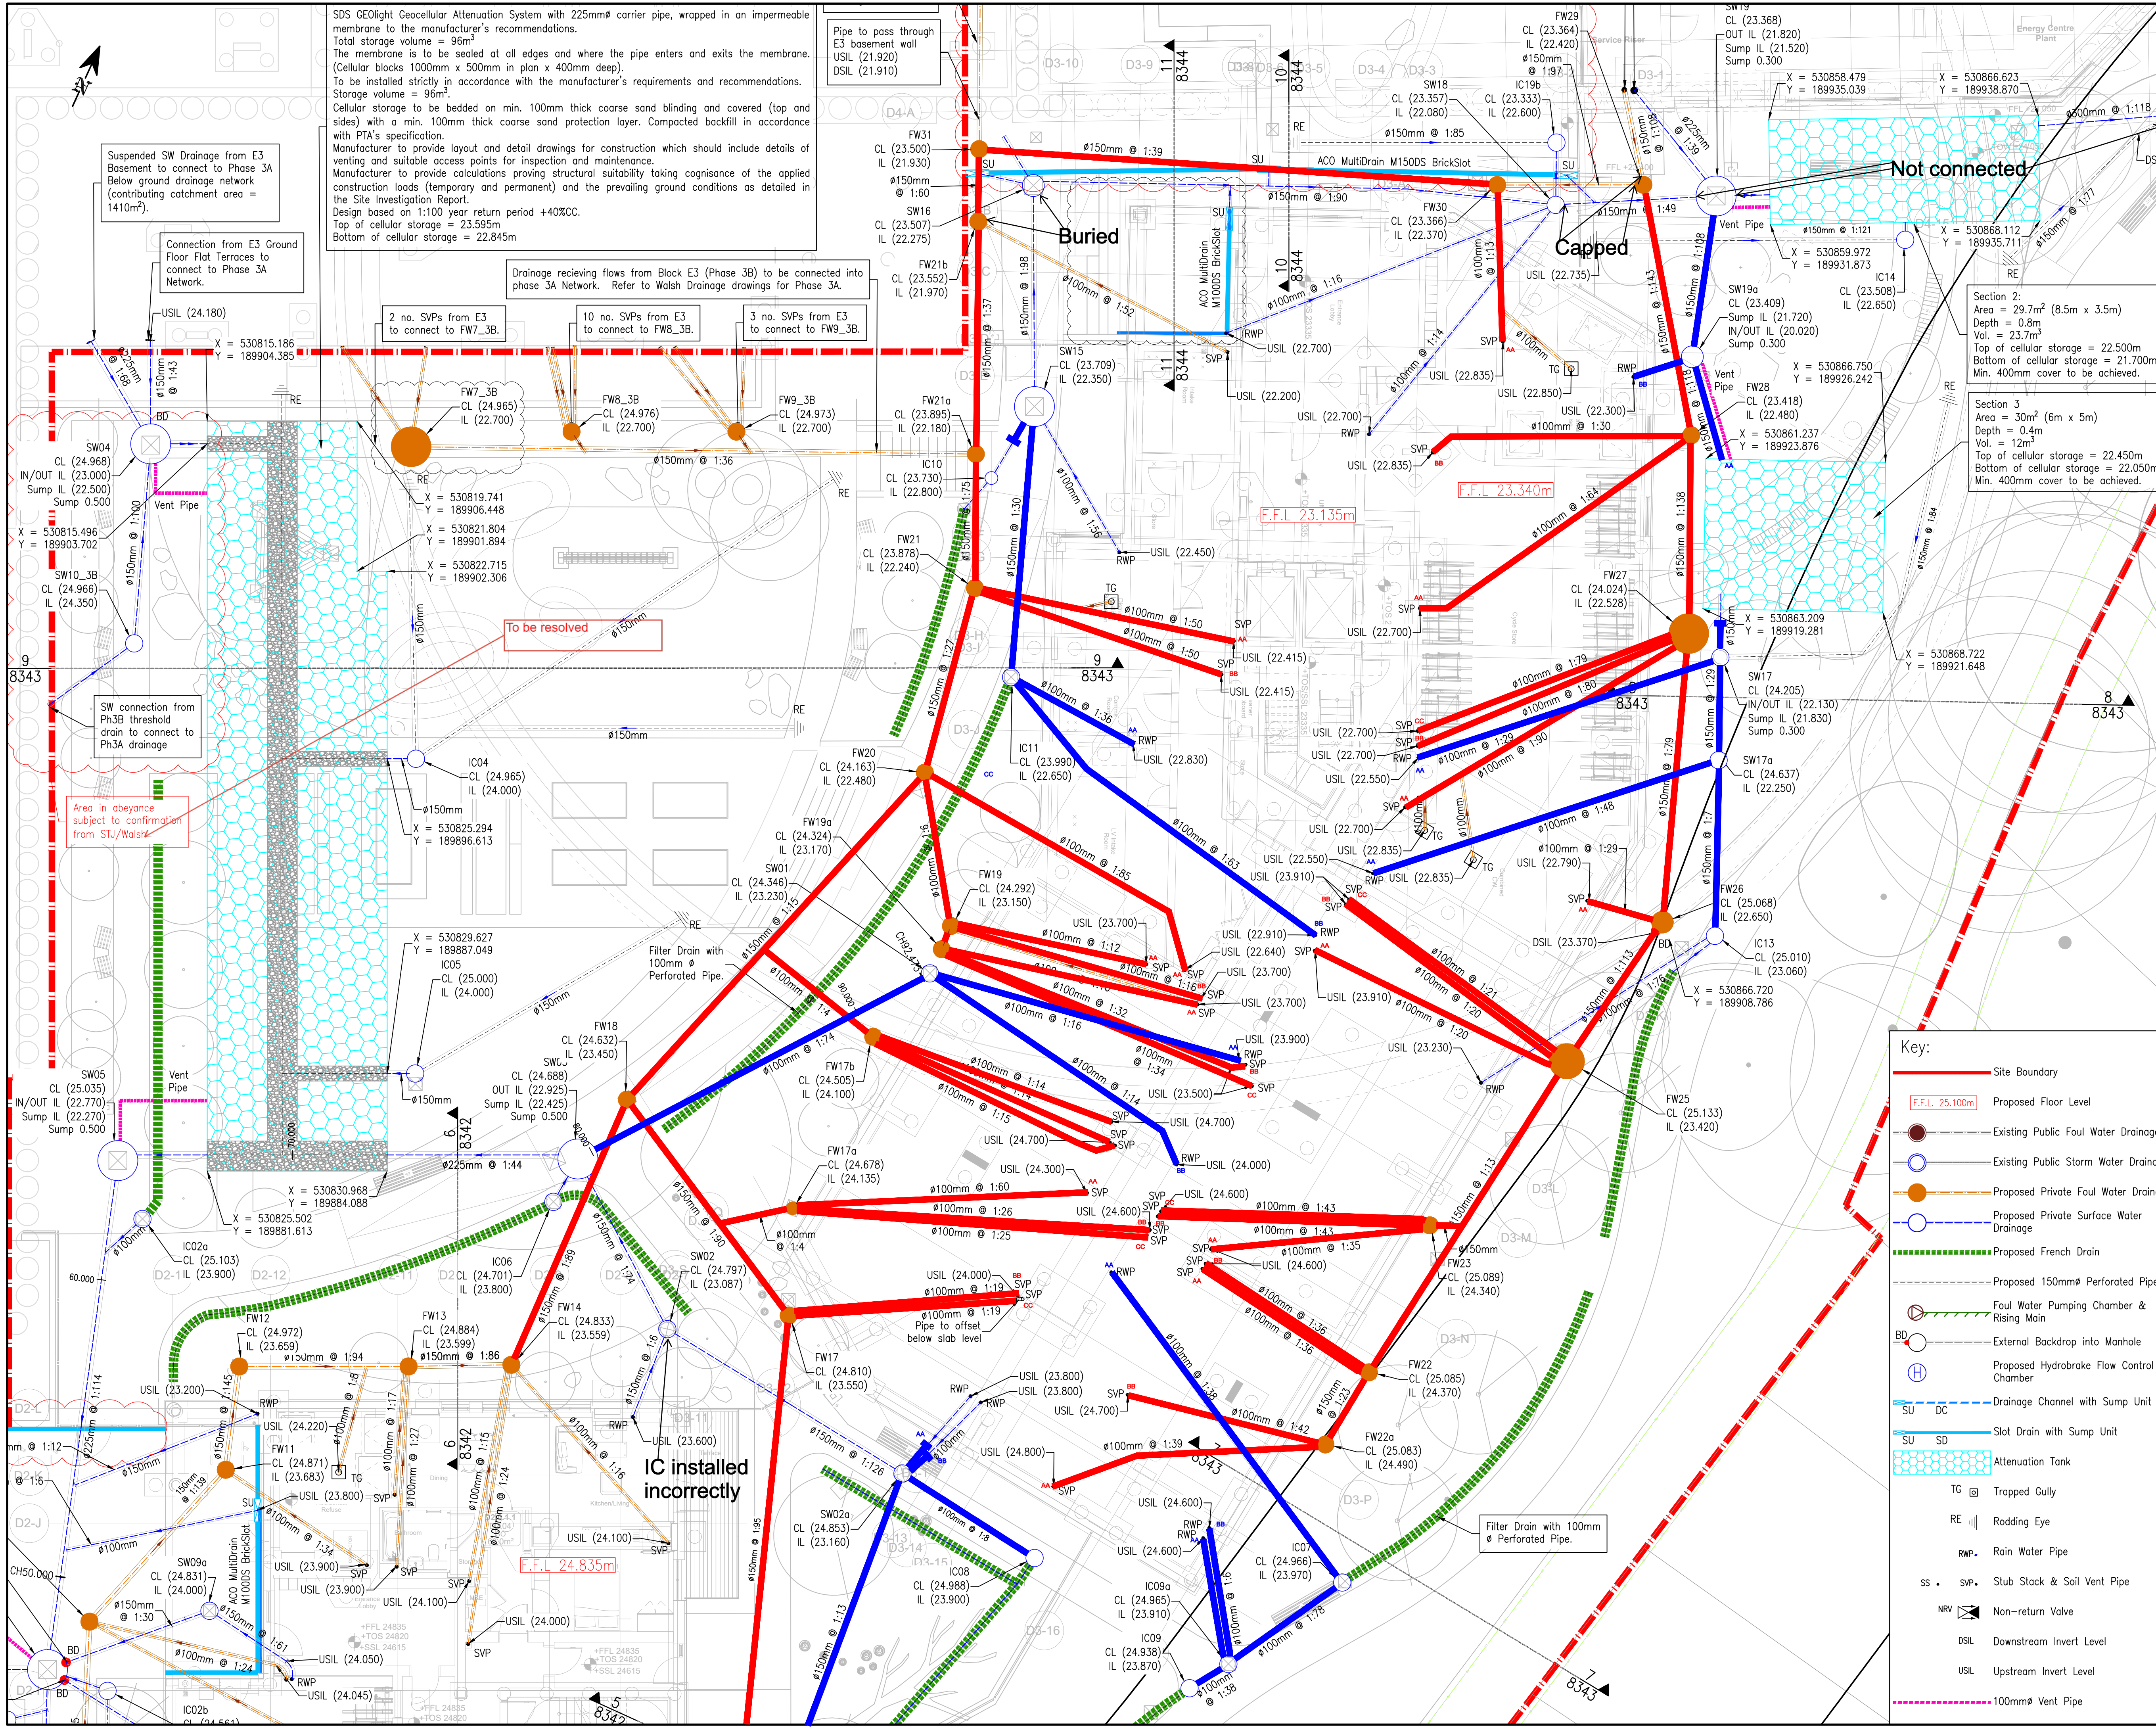

Notes:

- Do not scale from this drawing.
- In case of any discrepancies in drawings, details or bills, refer to engineers for clarification: unilateral decisions by the Contractor will not be accepted.
- This drawing is to be read in conjunction with all related Architects, Consultants & Sub-Contractors drawings and specifications.
- The Contractor is advised that all design drawings and information are to be read concurrently and any discrepancies or omissions reported directly to PTA Civil Department.
- The topographical survey is based on CD Surveys Ltd drawings: SW/1808045/1-3 dated October 2018, SW/1601057/1 dated February 2016, WH/1903054 dated April 2019.
- Utilities survey is based on drawing MSC32138-U-AI-01 received from Murphy Surveys dated August 2019.
- For information on existing site conditions and services refer to the National Grid H&S File report ref: W60170220-1R10-HR-H&S-0001. Any discrepancies between this and the provided information are to be referred to the engineer prior to commencement of works.
- Refer to PTA drawing W257-PTA-SW-ZZ-DR-S-0045 for site constraints.

Treepit & Soft landscaping area drainage to be designed by Landscaping Architect.

S278 Works drainage refer to Walsh series drawings W250-WAL-SW-00-DR-C-95-0390 to 0399.

Refer to PTA Drawings for Manholes Schedule & Drainage details:
W257-PTA-DE-ZZ-DR-C-01-8130
W257-PTA-DE-ZZ-DR-C-01-8131
W257-PTA-DE-ZZ-DR-C-01-8150
W257-PTA-DE-ZZ-DR-C-01-8151

Refer to Foreman Roberts Drawings for locations of SVP/SS & RWP :
W257-FRC-D1-00-DR-PH-52-0001
W257-FRC-D2-00-DR-PH-52-0001
W257-FRC-D3-00-DR-PH-52-0001
W257-FRC-D4-00-DR-PH-52-0001

Refer to LDA Drawings for Soft/Treepit & External Linear Channel drain location :
W257-LDA-DD-XX-DR-LS-90-3004, 3005 & 3006

© Powell Tolner & Associates Ltd.
The contents of this drawing may not be reproduced in whole or in part without the prior written permission of Powell Tolner & Associates.

DRAWING STATUS

FOR CONSTRUCTION

Item	Description	By	Date	Checked
C16	D3 SD position updated. Key updated.	JP	15.05.23	AH
C15	Ph3B Drainage connection to SW04 Updated.	JP	26.10.22	AH
C14	Attenuation Dims Updated to Wavin Spec, as Clouded.	JP	21.10.22	AH
C13	Attenuation Tank Layout Updates, as Clouded.	JP	27.07.22	AH
C12	D3 Updated BWIC. Updated Drainage as Clouded	JP	08.04.22	AH
C11	Updated Landscape GAs, drainage as-built surveys, desing team coordination	JP	11.02.22	AH
C10	As-built drainage update. D1 FW outfall update. D4/E4 suspended drainage update. MHs relocated into paths.	JP	23.09.21	AH
C9	Top of Cellular Storage Level Updated	JP	12.03.21	AM
C8	FW17/18 levels updated	JP	02.03.21	AM
C1	Issue for Construction.	SN	17.04.20	AH
P1	First Issue.	SN	13.03.20	

REV	DESCRIPTION	BY	DATE	CHKD
1				

PROJECT TITLE
Clarendon Ph3a

DRAWING TITLE
Drainage Layout Sheet 2 of 3

DATE	Feb 20	CHECKED DO	CHECKED ENG	PTA PROJ No
DRAWN	JP			9669

SCALE	1 : 100	JP	AH	REVISION
DRG SIZE	A1			C16

W257-PTA-DE-ZZ-DR-C-01-8102

Consulting Civil & Structural Engineers

pta
29 Red Lion Street
Chesham
Bucks.
HP5 1EJ
Tel. 01494 772721
www.placonsult.co.uk