



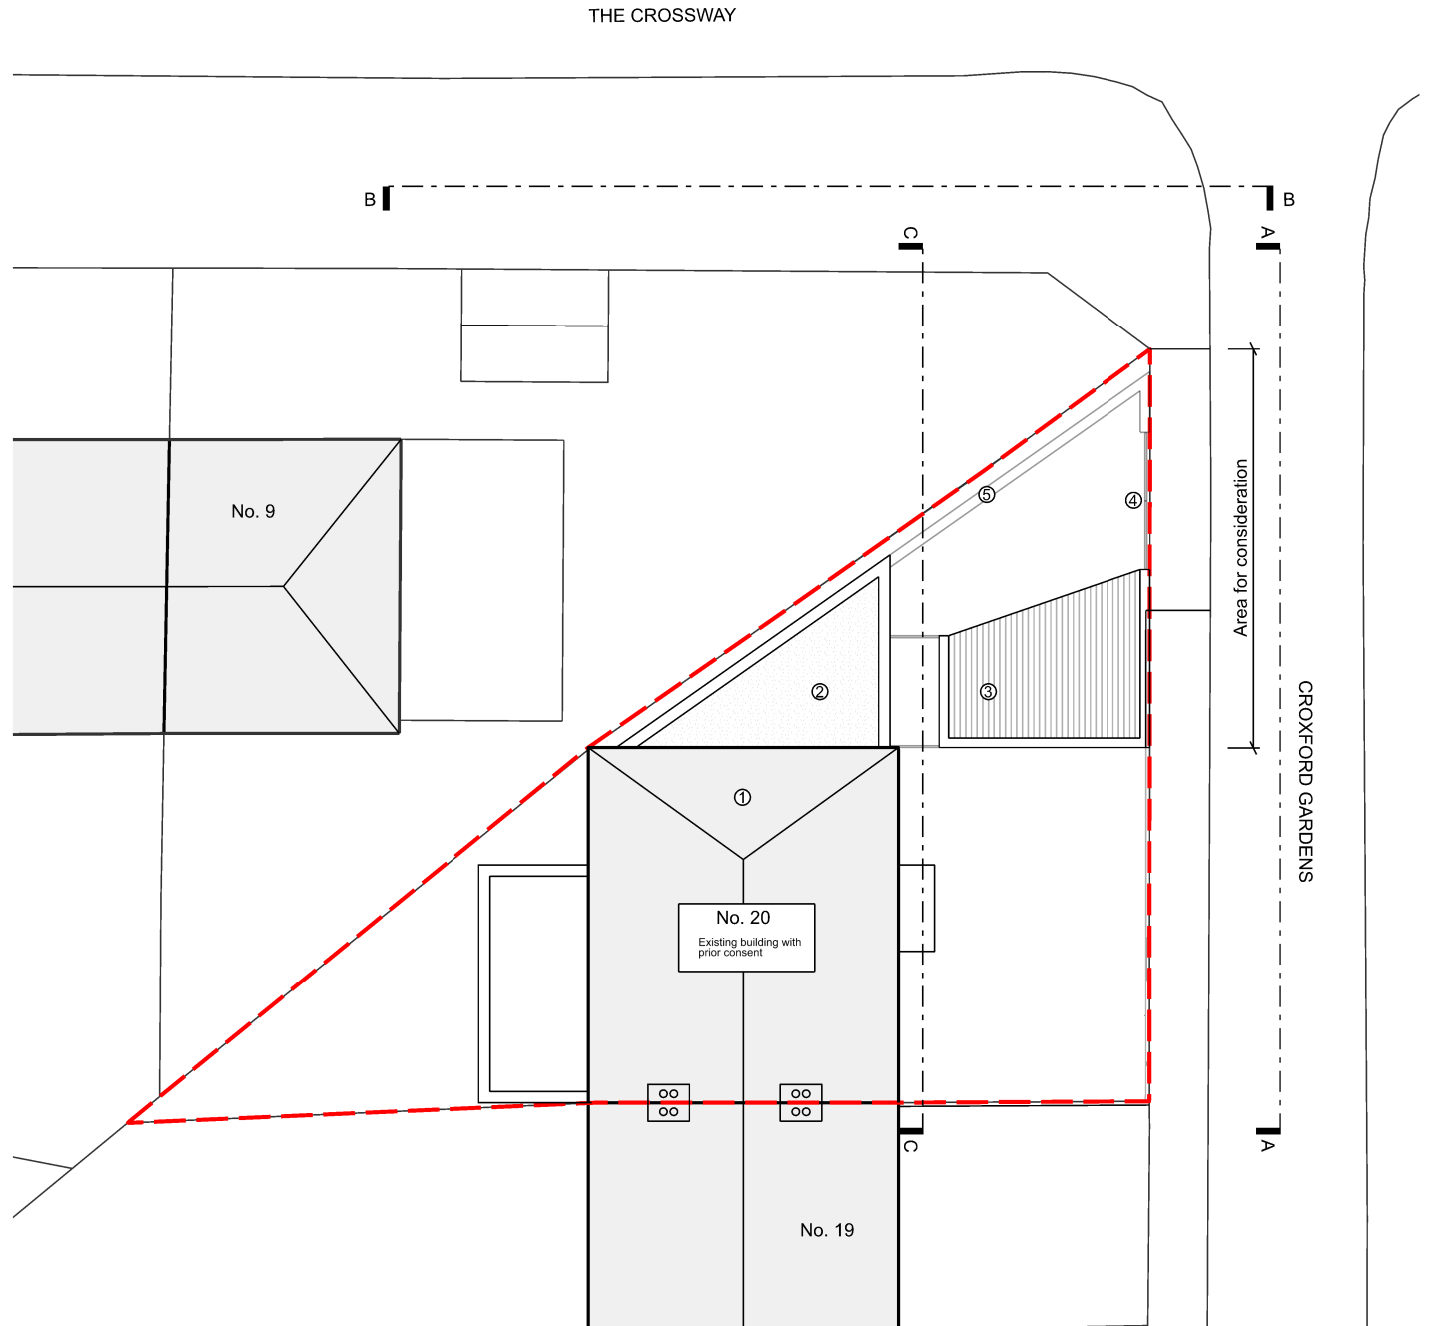

AS BUILT SITE PLAN

01 OS PLAN
1:1250

02 AS BUILT SITE PLAN
1:200

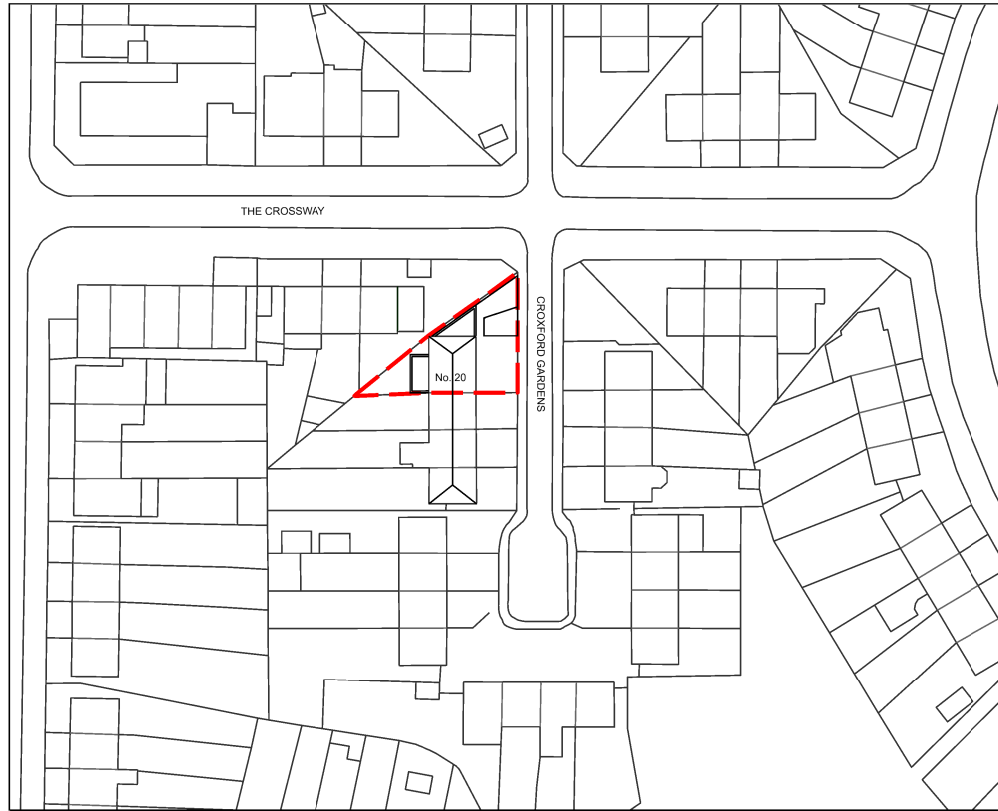

KEY PLAN

NOTES

- ① Consented development
- ② Storage Room
- ③ External Covered Storage Area
- ④ Pedestrian gates
- ⑤ Garden wall

REV.	NOTES	DATE
P00	RETROSPECTIVE PLANNING	07.12.23

TITLE
GROUND FLOOR PLAN

DRAWING NO. 030-SP00
REVISION P00

DATE 07.12.23
SCALE VARIES

Tikari Works
Studio 4 6-8 Cole St.
studio@tikari.co.uk
London SE1 4YH
020 300 52406

PROJECT
20 CROXFORD GARDENS

STATUS
PLANNING