




01 PRE-EXISTING FIRST FLOOR PLAN
1:200



01 AS BUILT - FIRST FLOOR PLAN
1:100

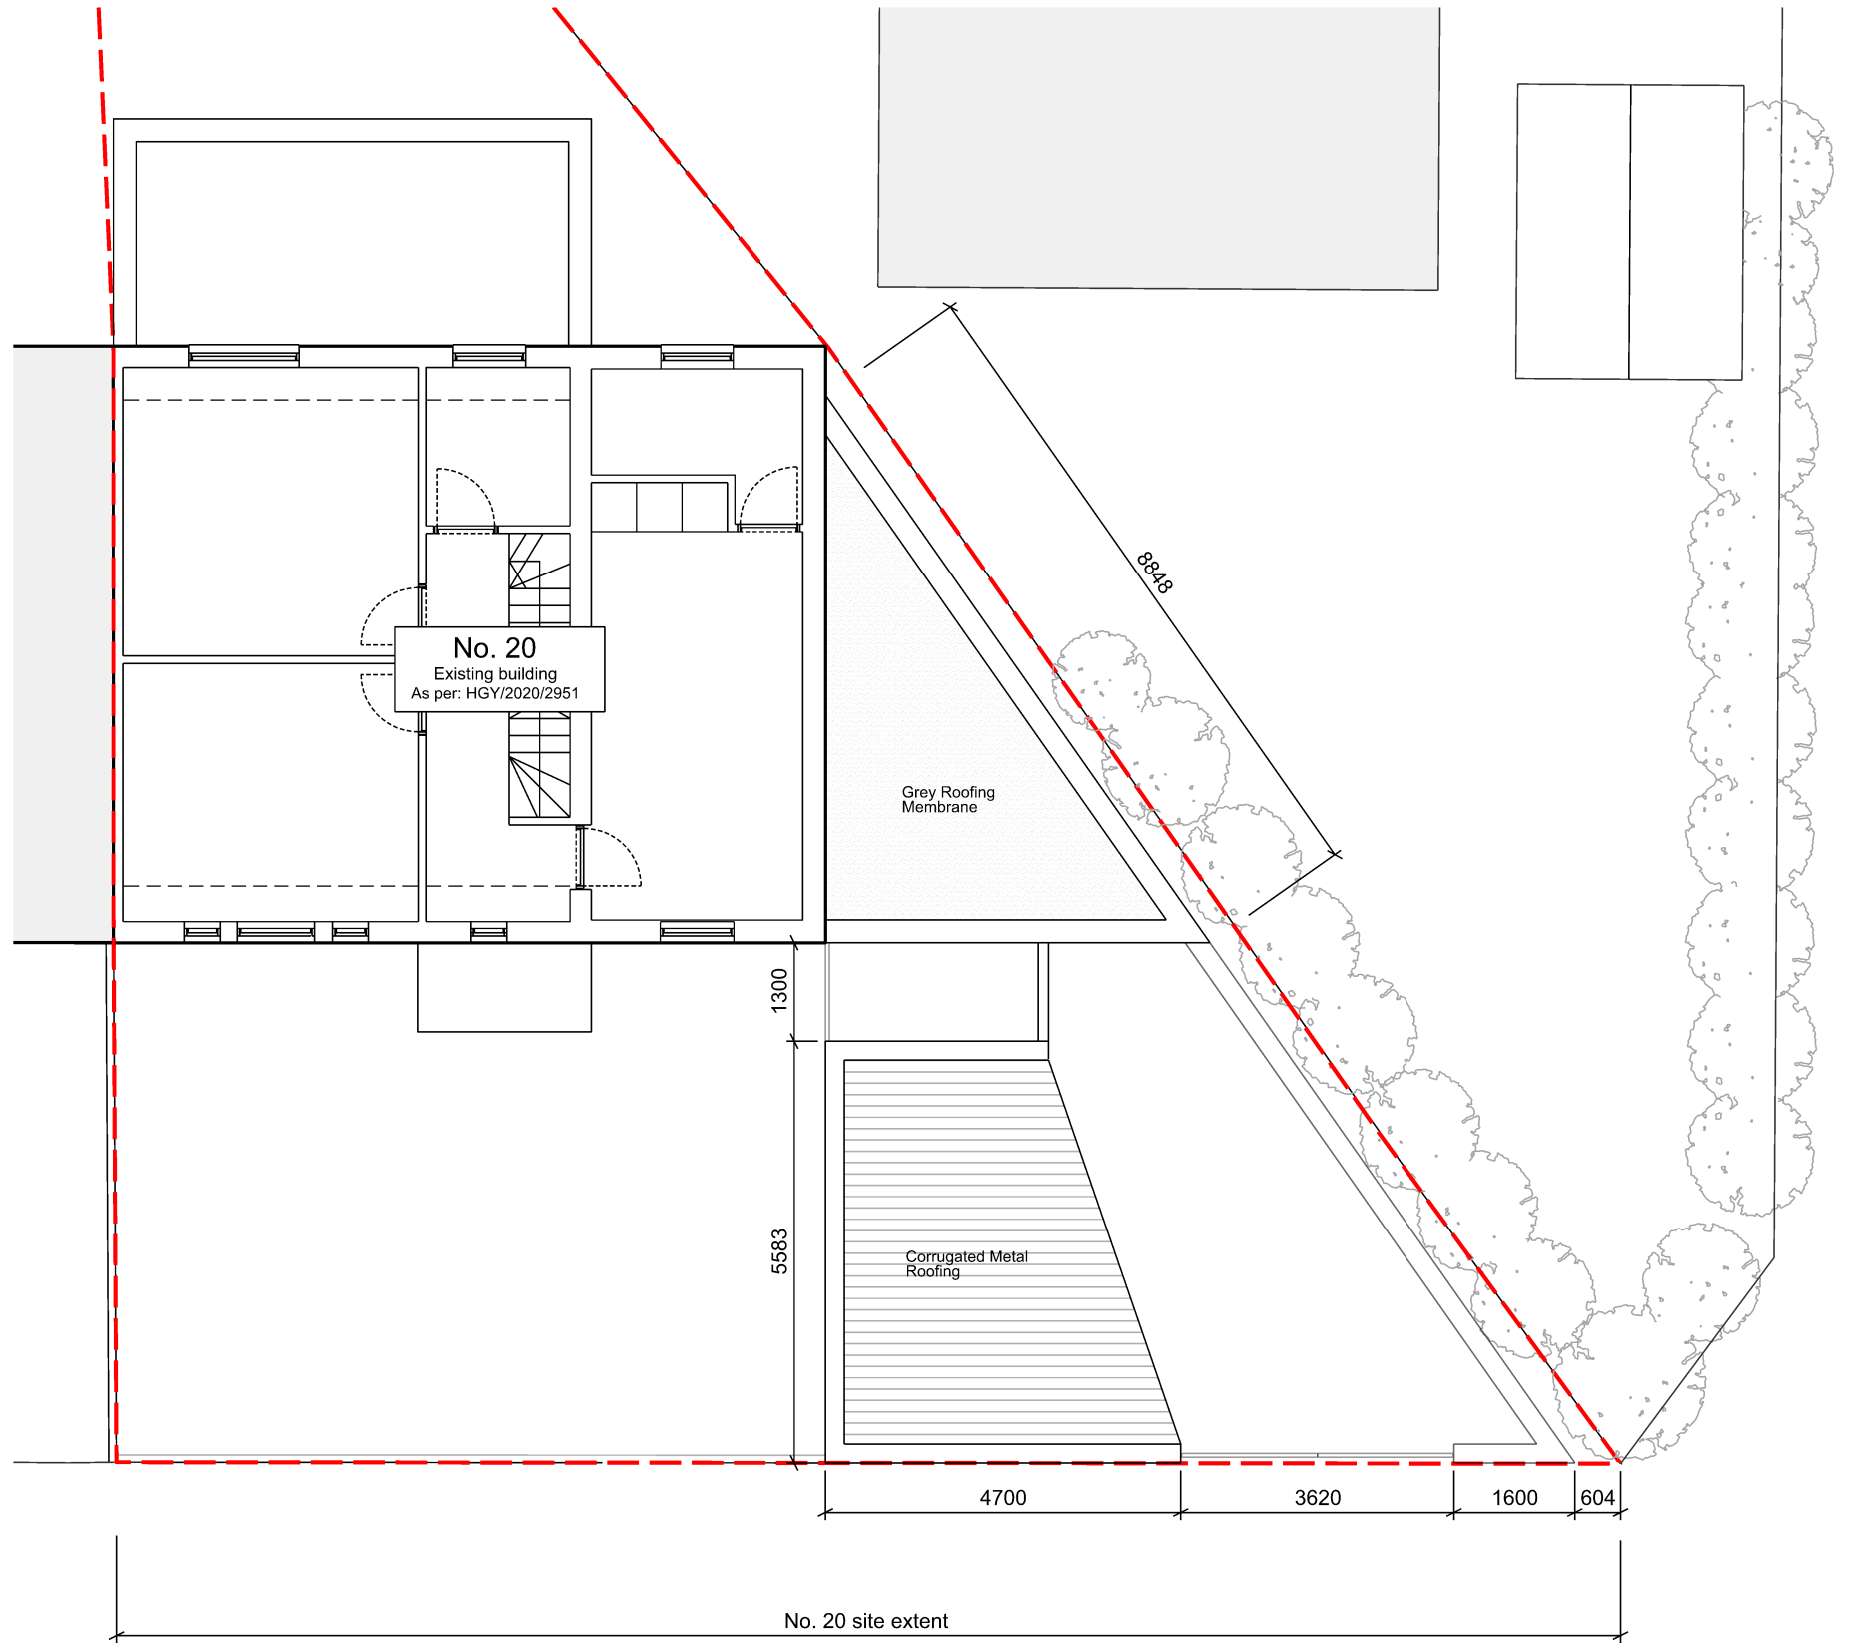

KEY PLAN

NOTES

REV.	NOTES	DATE
P00	RETROSPECTIVE PLANNING	07.12.23
P01	RETROSPECTIVE PLANNING	03.01.24

TITLE
AS BUILT FIRST FLOOR /
ROOF PLAN

DRAWING NO. 030-PP01
REVISION P01

DATE 07.12.23
SCALE @ A3

Tikari Works
Studio 4 6-8 Cole St.
studio@tikari.co.uk
London SE1 4YH
020 300 52406

PROJECT
20 CROXFORD GARDENS

STATUS
PLANNING