



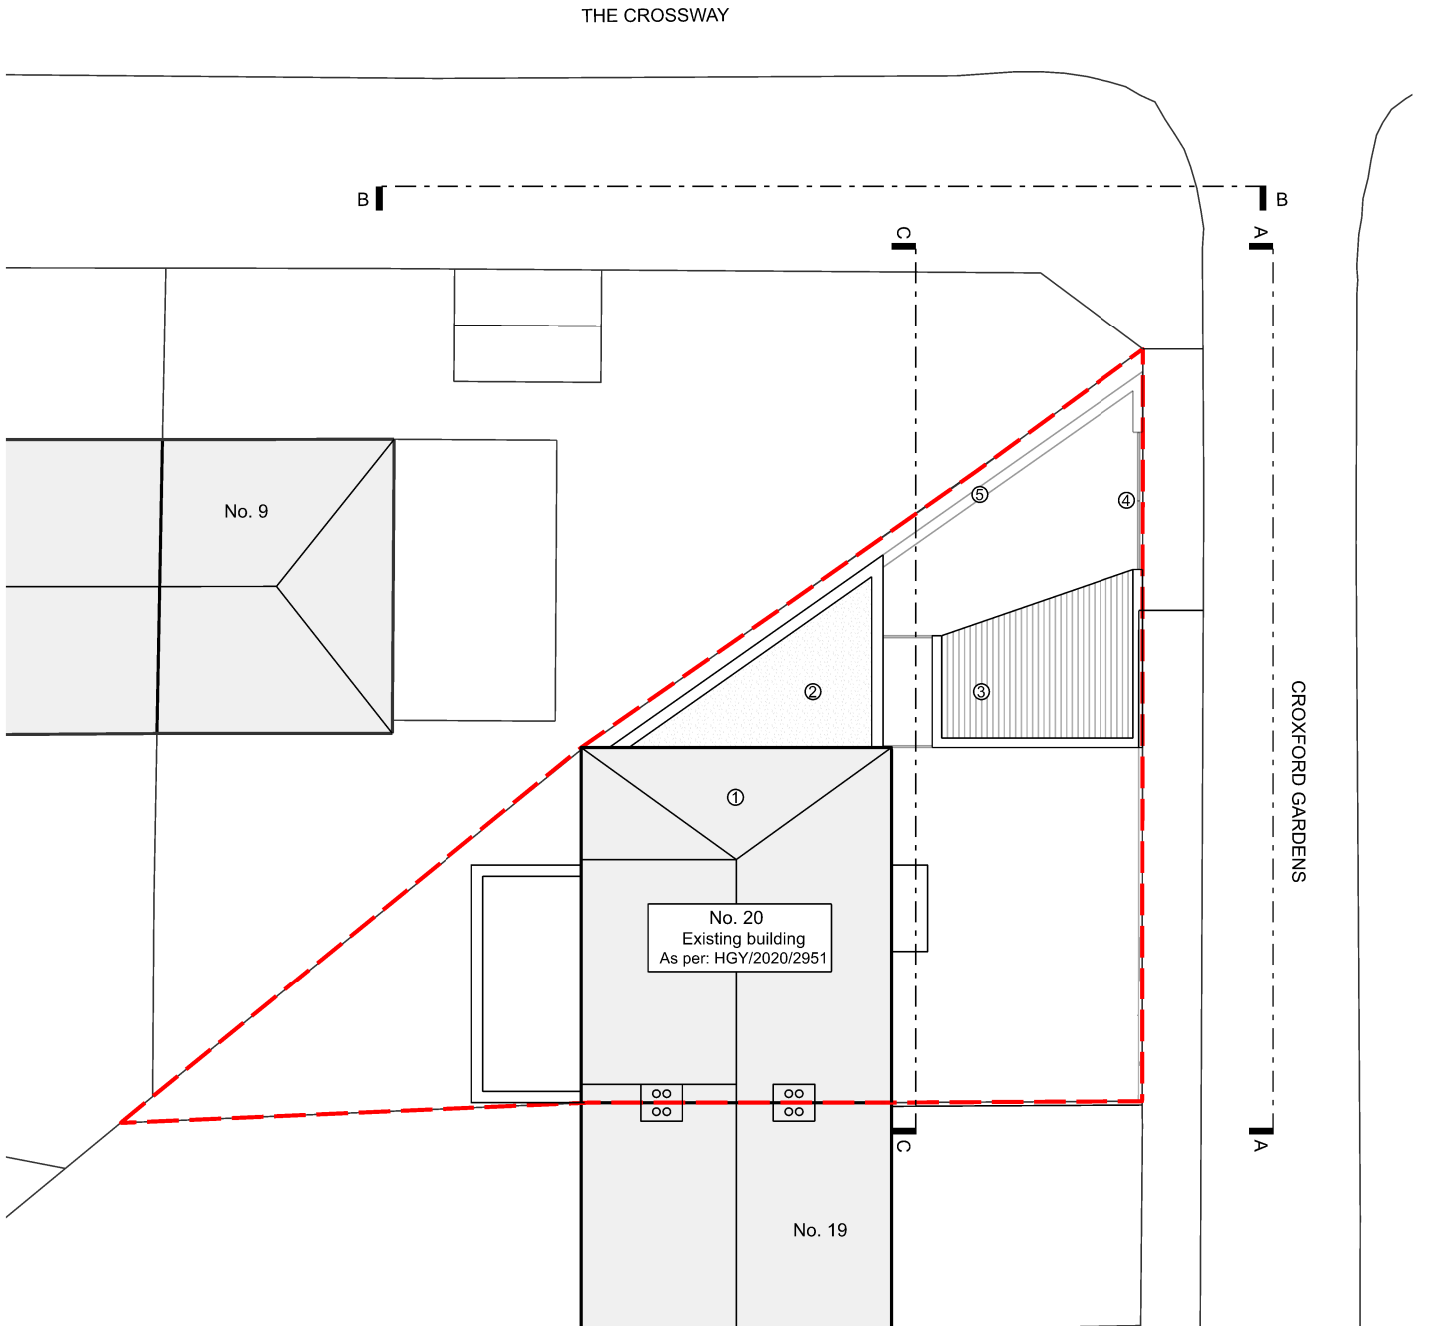

01 AS BUILT LOCATION PLAN
1:1250

02 AS BUILT SITE PLAN
1:200

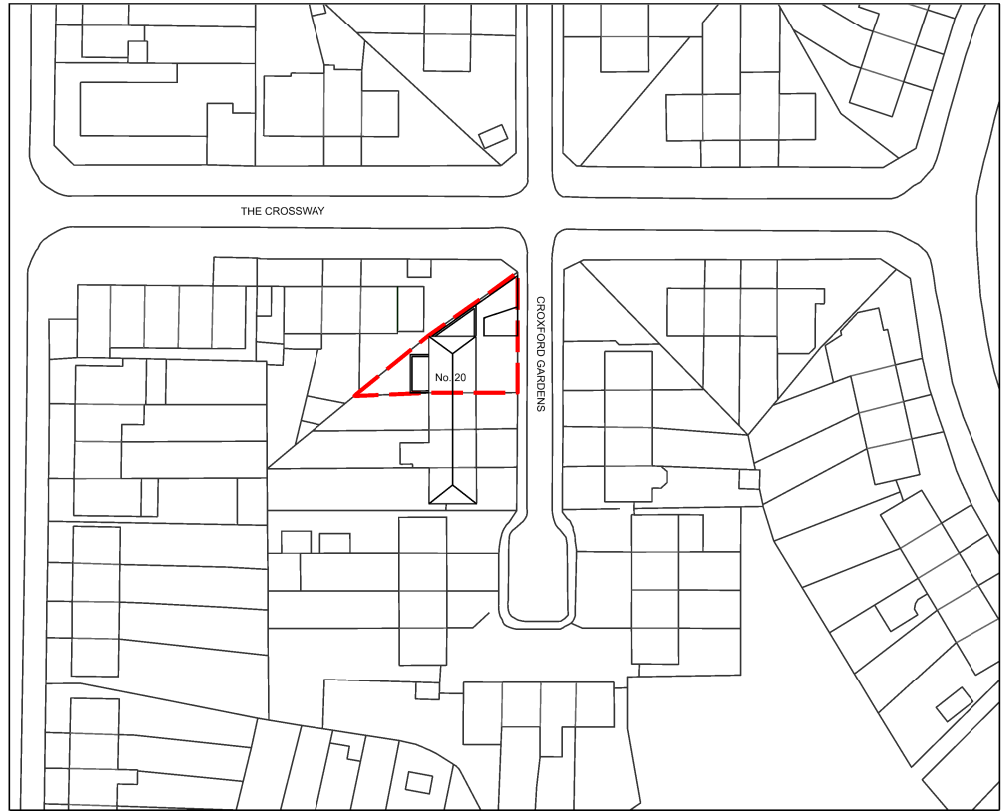

KEY PLAN

NOTES

- ① Consented development
- ② Storage Room
- ③ External Covered Storage Area
- ④ Pedestrian gates
- ⑤ Garden wall

REV.	NOTES	DATE
P00	RETROSPECTIVE PLANNING	07.12.23

TITLE
AS BUILT SITE +
LOCATION PLANS

DRAWING NO.
030-SP01

REVISION
P00

DATE
07.12.23

SCALE
VARIES

Tikari Works
Studio 4 6-8 Cole St.
studio@tikari.co.uk
London SE1 4YH
020 300 52406

PROJECT
20 CROXFORD GARDENS

STATUS
PLANNING