



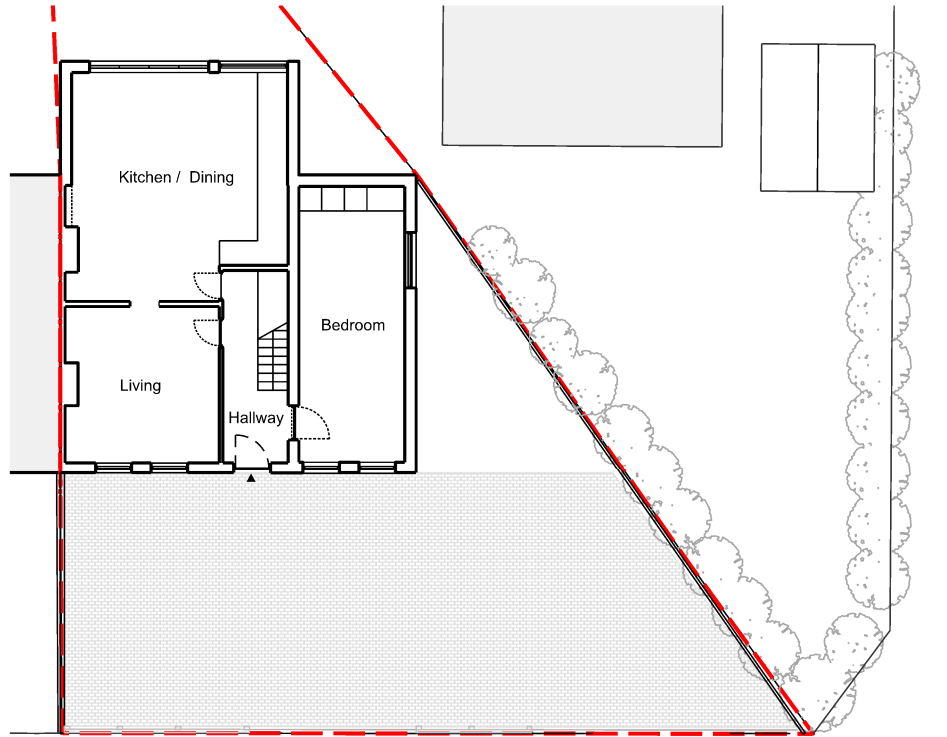

01 PRE-EXISTING GROUND FLOOR PLAN
1:200

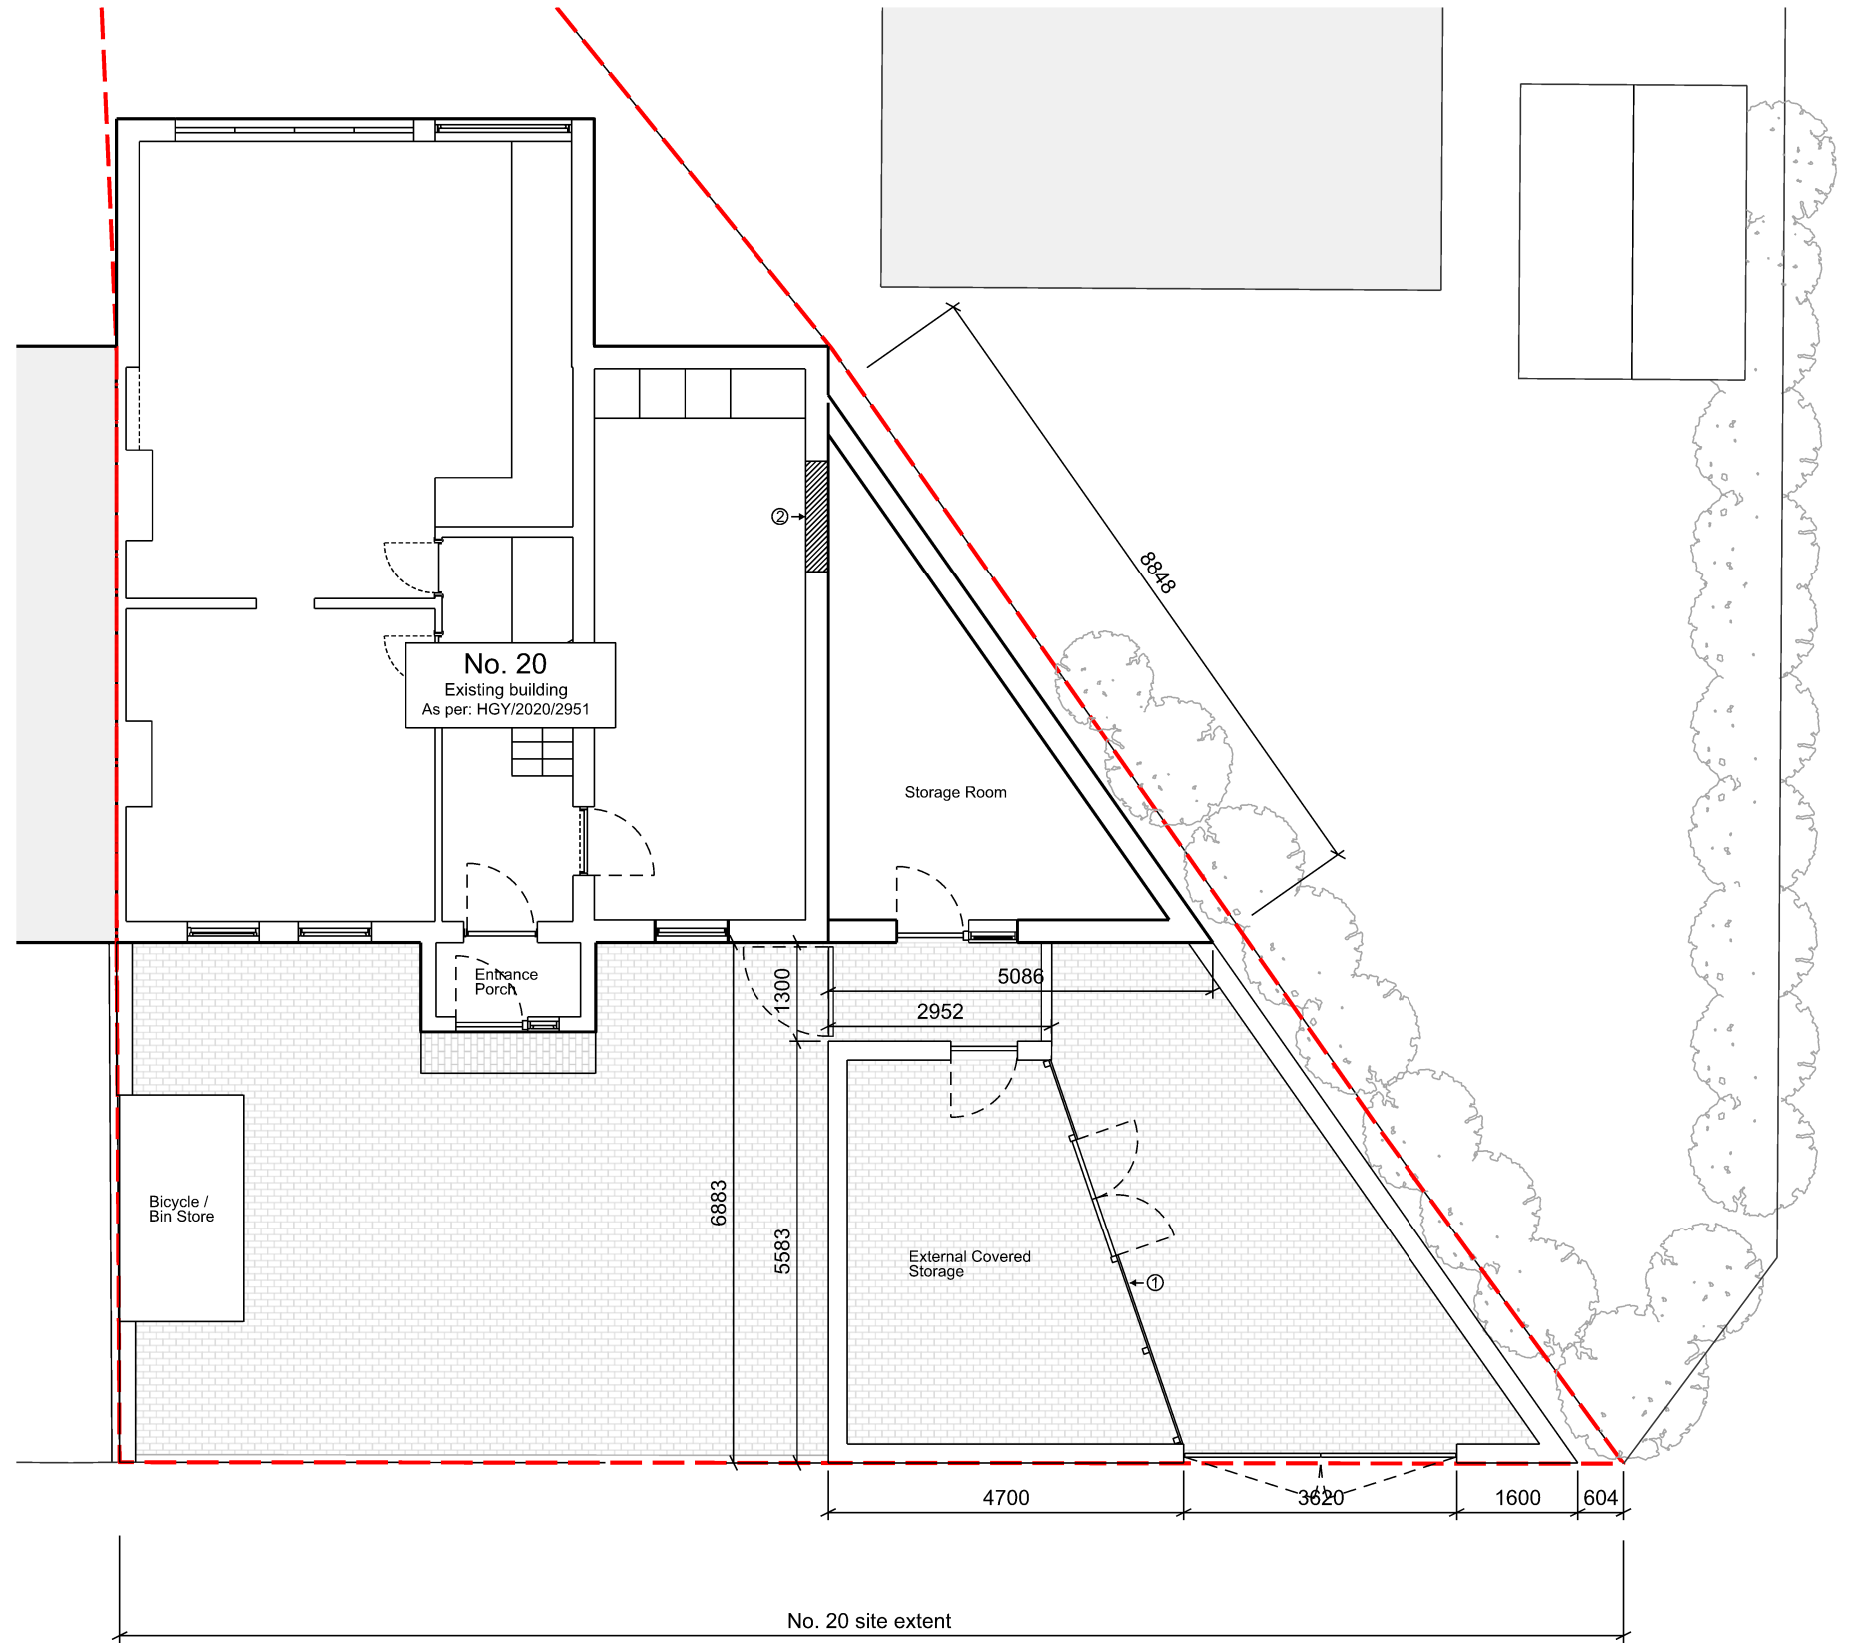

01 AS BUILT - GROUND FLOOR PLAN
1:100



KEY PLAN

NOTES

- ① Plywood partition wall with double doors
- ② Existing window infilled

REV.	NOTES	DATE
P00	RETROSPECTIVE PLANNING	07.12.23
P01	RETROSPECTIVE PLANNING	03.01.24

TITLE
AS BUILT GROUND
FLOOR PLAN

DRAWING NO. 030-PP00 REVISION P01

DATE 07.12.23 SCALE @ A3

Tikari Works
Studio 4 6-8 Cole St. London SE1 4YH
studio@tikari.co.uk 020 300 52406

PROJECT
20 CROXFORD GARDENS

STATUS
PLANNING