


01 AS BUILT ELEVATION- NORTH B-B
1:200



02 AS BUILT ELEVATION- EAST A-A
1:200

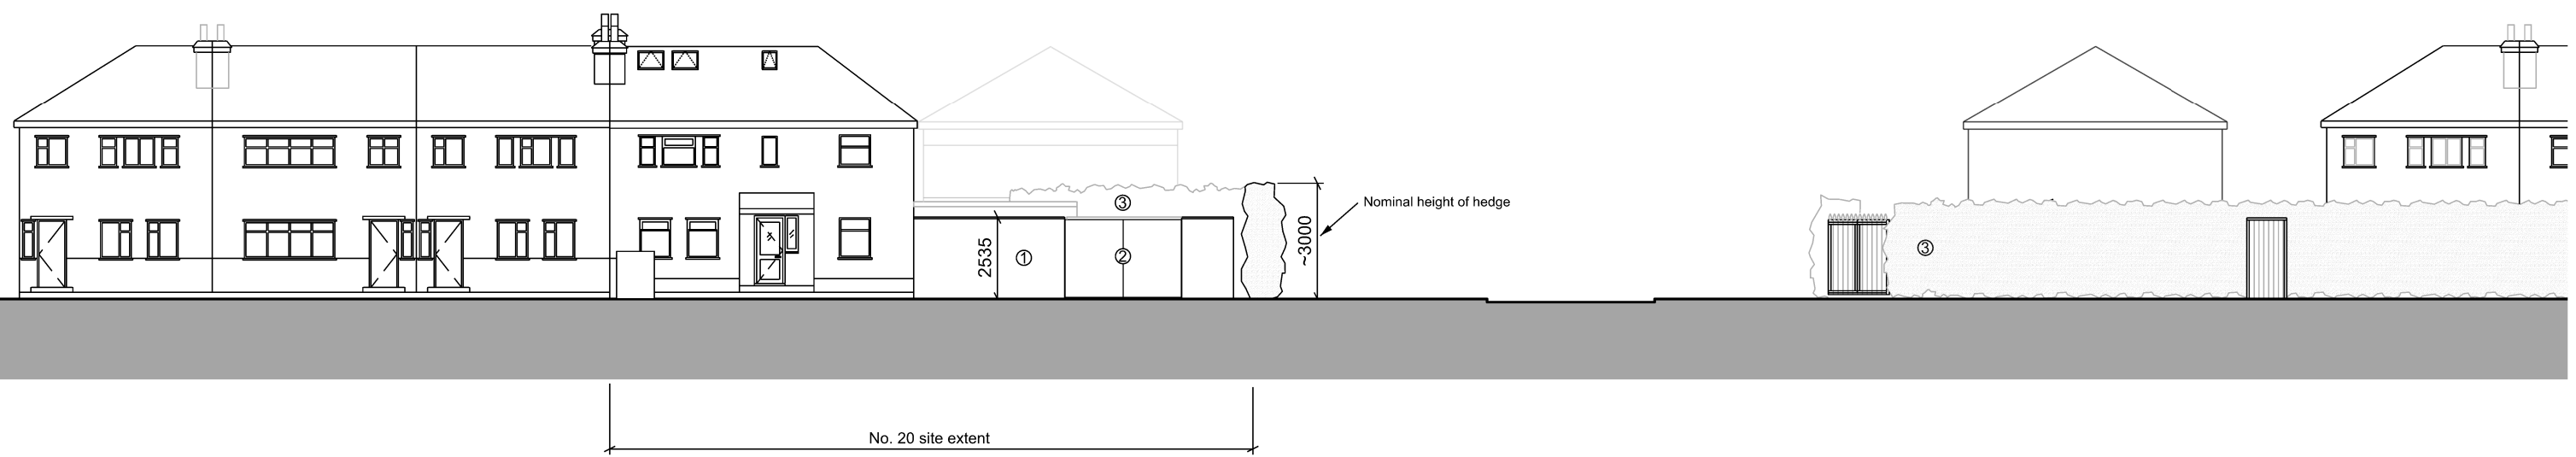

KEY PLAN

NOTES

- ① White render to match existing
- ② Pedestrian access gates
- ③ Mature ~3m boundary hedge

REV.	NOTES	DATE
P00	RETROSPECTIVE PLANNING	07.12.23
P01	RETROSPECTIVE PLANNING	03.01.24

TITLE
AS BUILT NORTH +
EAST ELEVATIONS

DRAWING NO.
030-PE110

REVISION
P01

DATE
03.01.24

SCALE
1:200 @ A3

Tikari Works
Studio 4 6-8 Cole St.
studio@tikari.co.uk
London SE1 4YH
020 300 52406

PROJECT
20 CROXFORD GARDENS

STATUS
PLANNING