


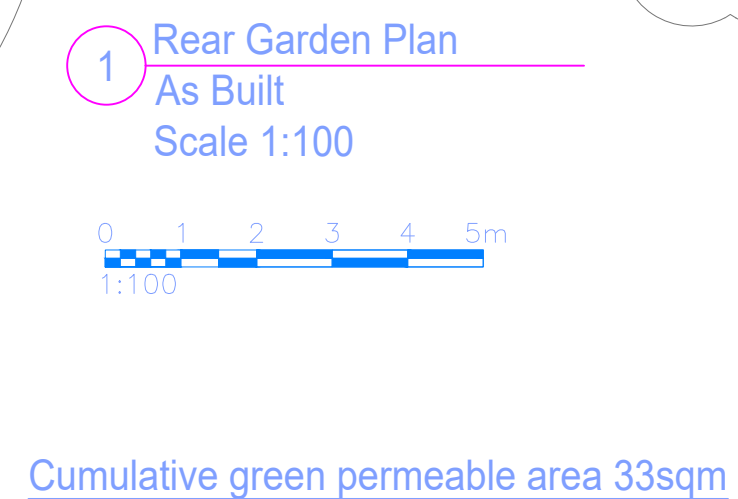

GAMUT
BUILDING SOLUTIONS

GAMUT BUILDING SOLUTIONS
21 Ford Close
London, E3 5LZ
T: 0208 0013 515 M: 074 032 44 240
info@GamutBS.co.uk
www.GamutBS.co.uk

CLIENT: Siobhan McMillan

SITE: 1A The Avenue LONDON, N10 2QE			
TITLE: Rear Garden Plan As Built			
SCALE AT A2: 1:100	DATE: Aug 2023	DRAWN: MP	CHECKED: -
PROJECT NO: 00523	DRAWING NO: PL401	REVISION: C	