


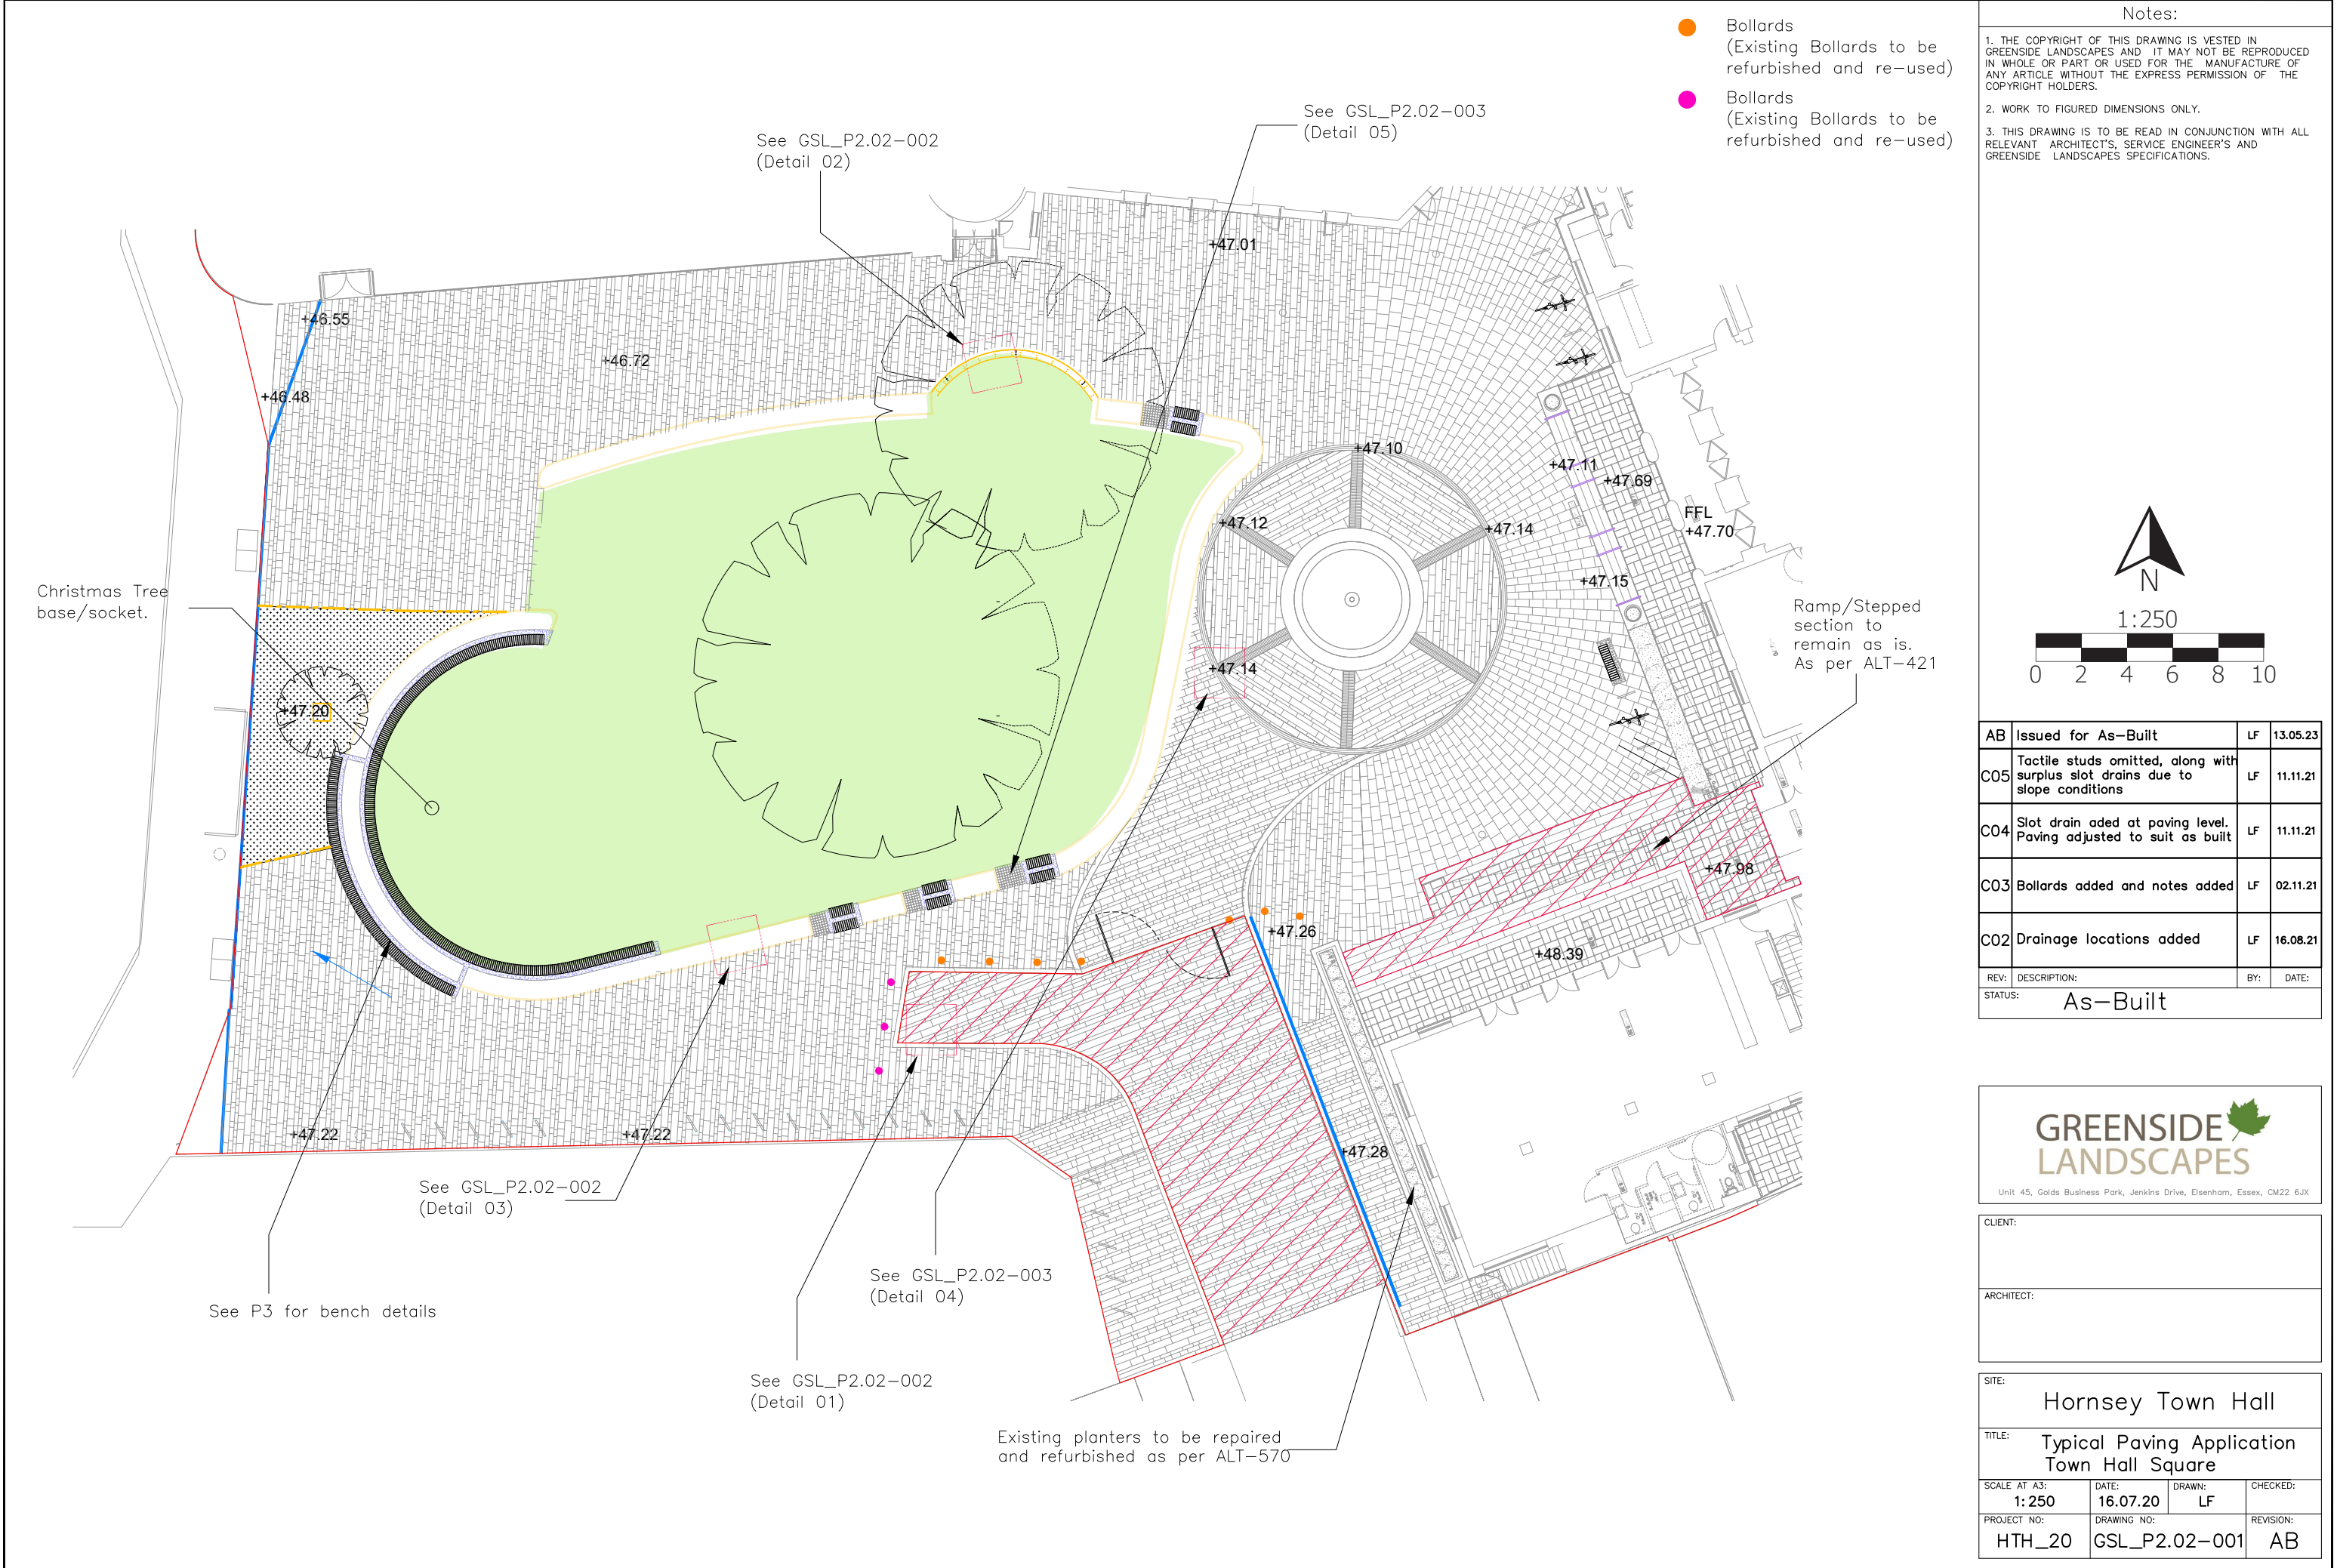


Notes:

1. THE COPYRIGHT OF THIS DRAWING IS VESTED IN GREENSIDE LANDSCAPES AND IT MAY NOT BE REPRODUCED IN WHOLE OR PART OR USED FOR THE MANUFACTURE OF ANY ARTICLE WITHOUT THE EXPRESS PERMISSION OF THE COPYRIGHT HOLDERS.

2. WORK TO FIGURED DIMENSIONS ONLY.

3. THIS DRAWING IS TO BE READ IN CONJUNCTION WITH ALL RELEVANT ARCHITECT'S, SERVICE ENGINEER'S AND GREENSIDE LANDSCAPES SPECIFICATIONS.

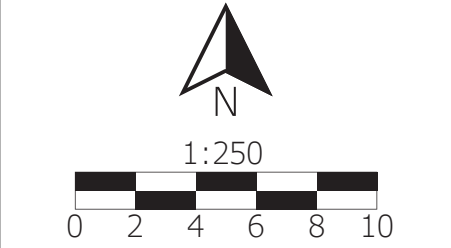

AB	Issued for As-Built	LF	13.05.23
C05	Tactile studs omitted, along with surplus slot drains due to slope conditions	LF	11.11.21
C04	Slot drain added at paving level. Paving adjusted to suit as built	LF	11.11.21
C03	Bollards added and notes added	LF	02.11.21
C02	Drainage locations added	LF	16.08.21
REV:	DESCRIPTION:	BY:	DATE:
STATUS:	As-Built		

GREENSIDE LANDSCAPES

Unit 45, Golds Business Park, Jenkins Drive, Elsenham, Essex, CM22 6JX

CLIENT:

ARCHITECT:

SITE: Hornsey Town Hall

TITLE: Typical Paving Application Town Hall Square

SCALE AT A3: 1:250	DATE: 16.07.20	DRAWN: LF	CHECKED:
PROJECT NO: HTH_20	DRAWING NO: GSL_P2.02-001	REVISION: AB	