


1

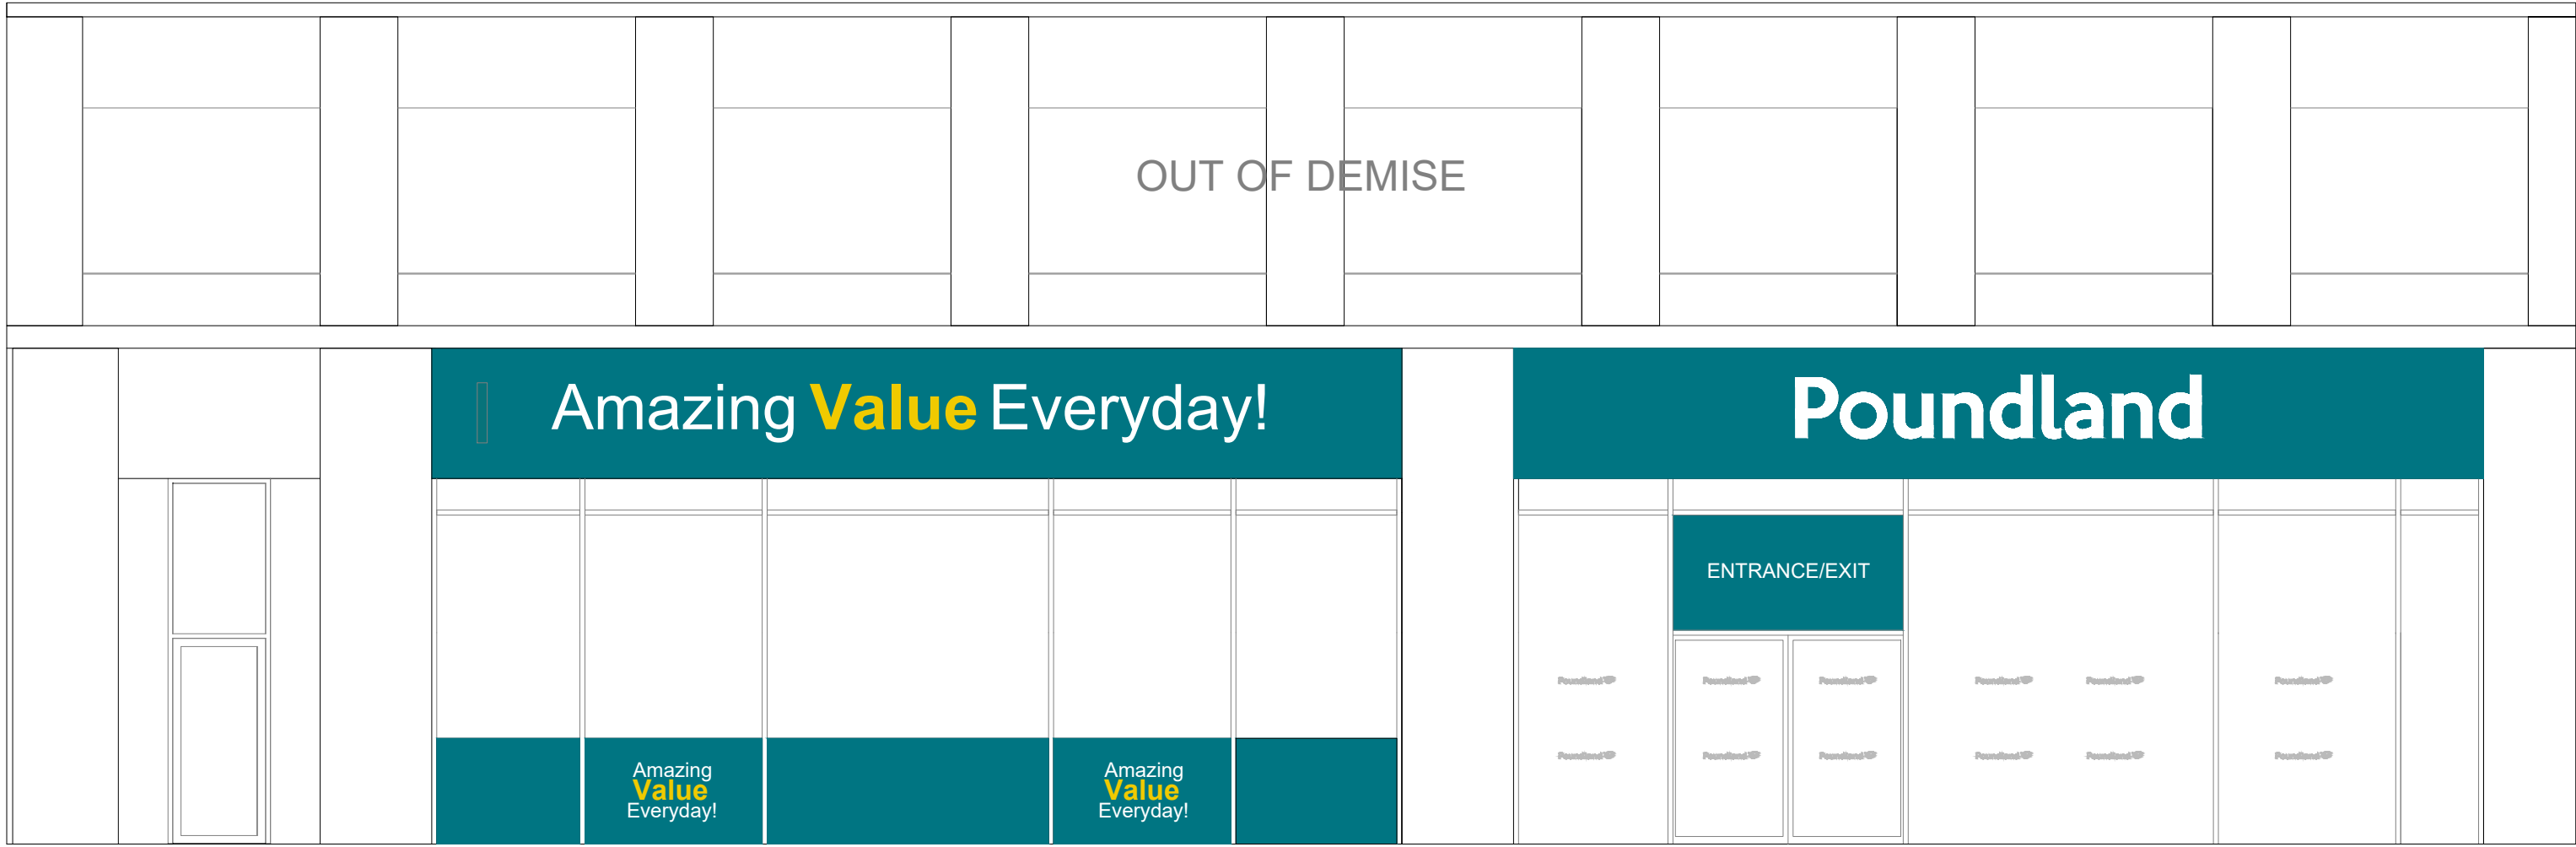

01 EXISTING FRONT ELEVATION  
Scale 1:100

RAG RATING

AMBER

|          |                    |          |
|----------|--------------------|----------|
|          |                    |          |
|          |                    |          |
|          | As Built           | 02/01/24 |
| A        | Signage Amendments | 19/09/23 |
| -        | Initial Issue      | 14/11/22 |
| Revision | Amendment          | Date     |

Cheltenham Suite 5  
Centrix@Keys  
Keys Business Village  
Hednesford  
Staffordshire  
WS12 2HA  
T: 01543 275101  
F: 01543 458278  
E: design@hlpuktd.net  
W: www.hlpuktd.net



**Poundland**  
Pattison House, Midland Road,  
Walsall, West Midlands, WS1 3TX  
TEL 0121 526 8395. FAX 0121 568 7382.

Store  
44-46 High Road,  
Wood Green,  
London  
N22 6BX

Drawing Title  
Existing Front Elevation

|                |                 |          |            |
|----------------|-----------------|----------|------------|
| Drawing Number | HLP / 1761 / 03 | Revision | Paper Size |
|                |                 |          | A1         |

|       |          |       |
|-------|----------|-------|
| Drawn | Date     | Scale |
| TC    | Oct 2022 | 1:100 |

