



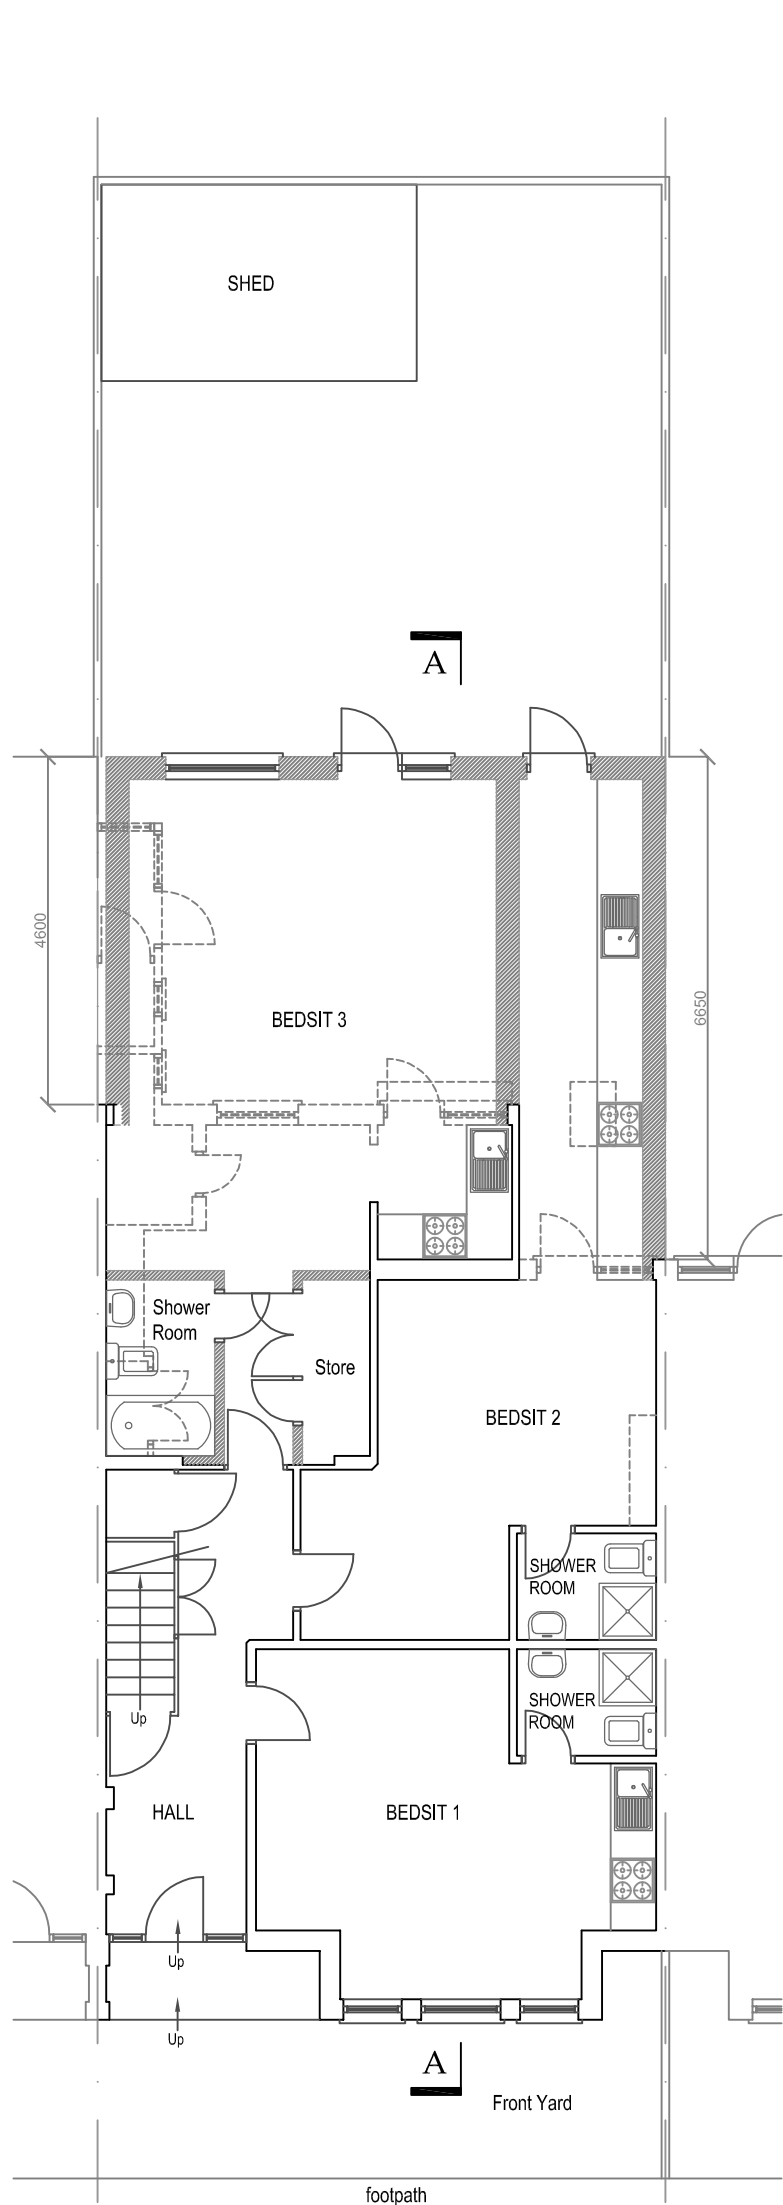

AS-BUILT GROUND FLOOR PLAN

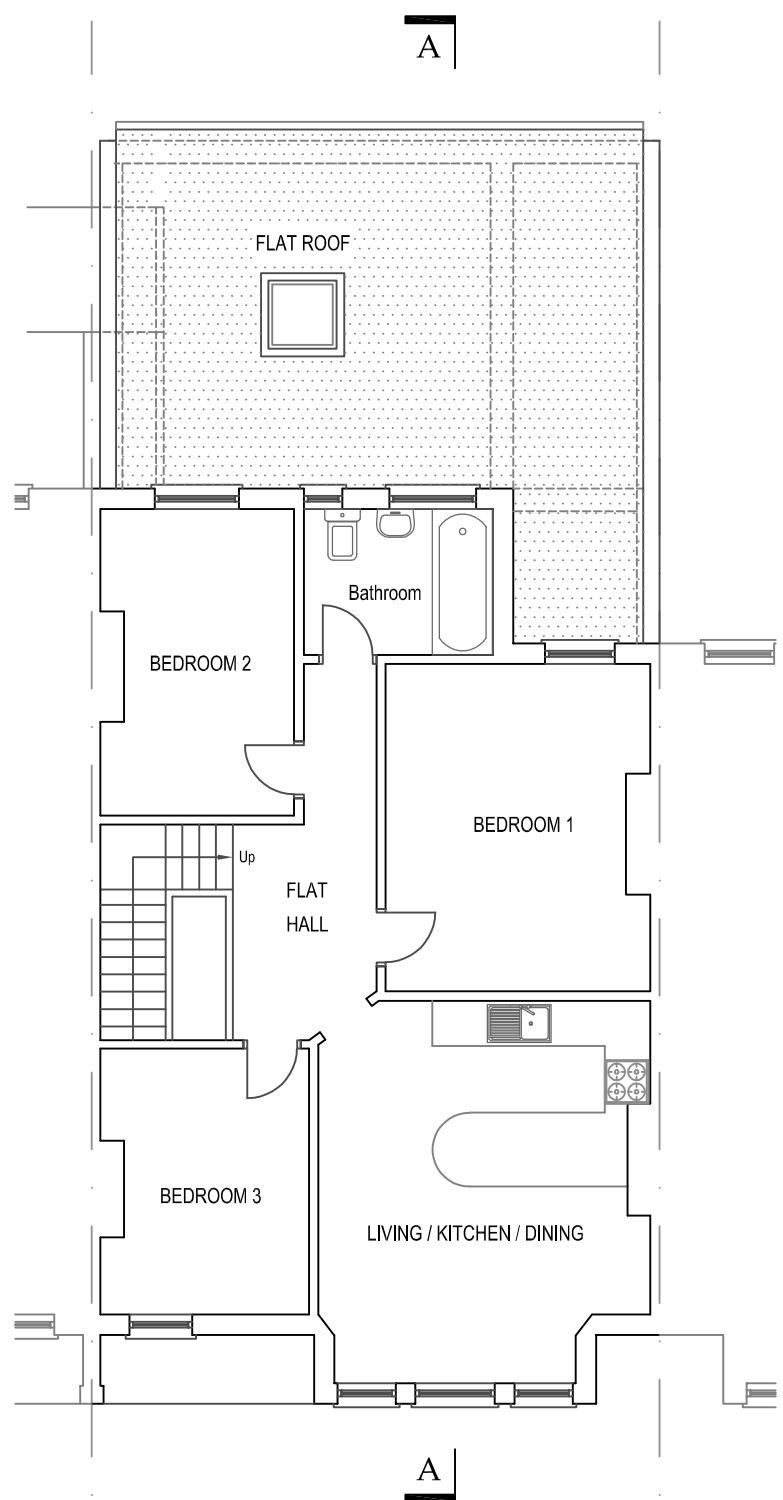

AS-BUILT FIRST FLOOR / ROOF PLAN

Project Retention of As Built 4.6m Single Storey Rear Extension At 17 Whitley Road, Tottenham, London, N17 6RJ	Sheet Title As-Built Floor Plans	Notes	Drawn by	RB	 RIBO ASSOCIATES LTD Architectural Consultants 51 Hassocks Road, Streatham Vale, London SW16 5HA Tel: 020 8617 9182 / 07946 872 604 E: ribo.arch@gmail.com	Drawing No.
			Scale	1:100 @ A3		8 of
	Revisions	Do not scale these drawings. Any discrepancies noted are to be reported to RIBO Associates Ltd immediately	Date	Oct 2023		
			Job No.	17WR/P2		