


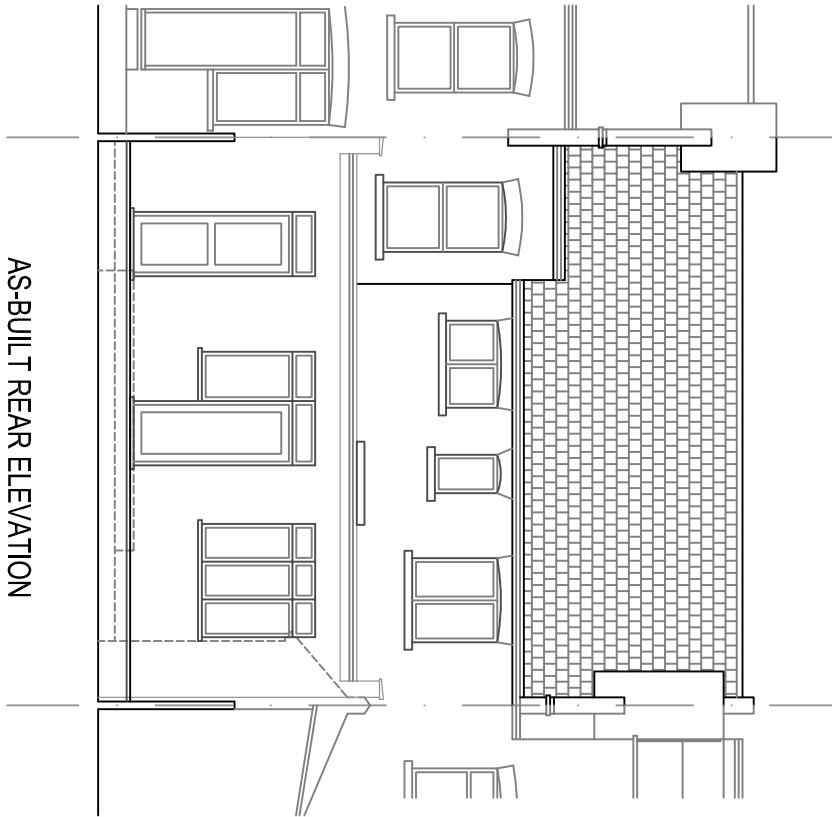


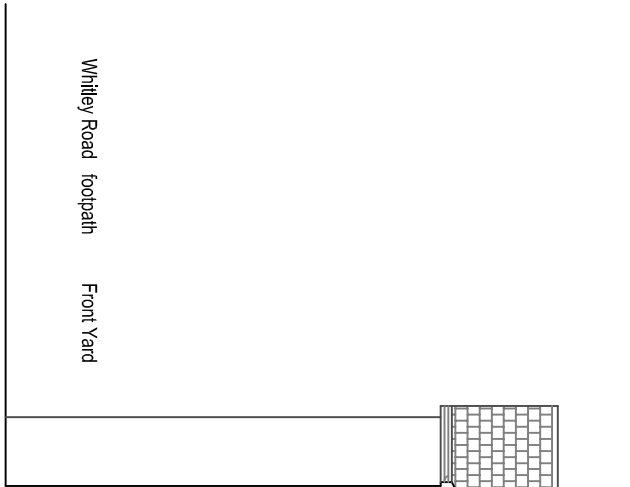

AS-BUILT REAR ELEVATION

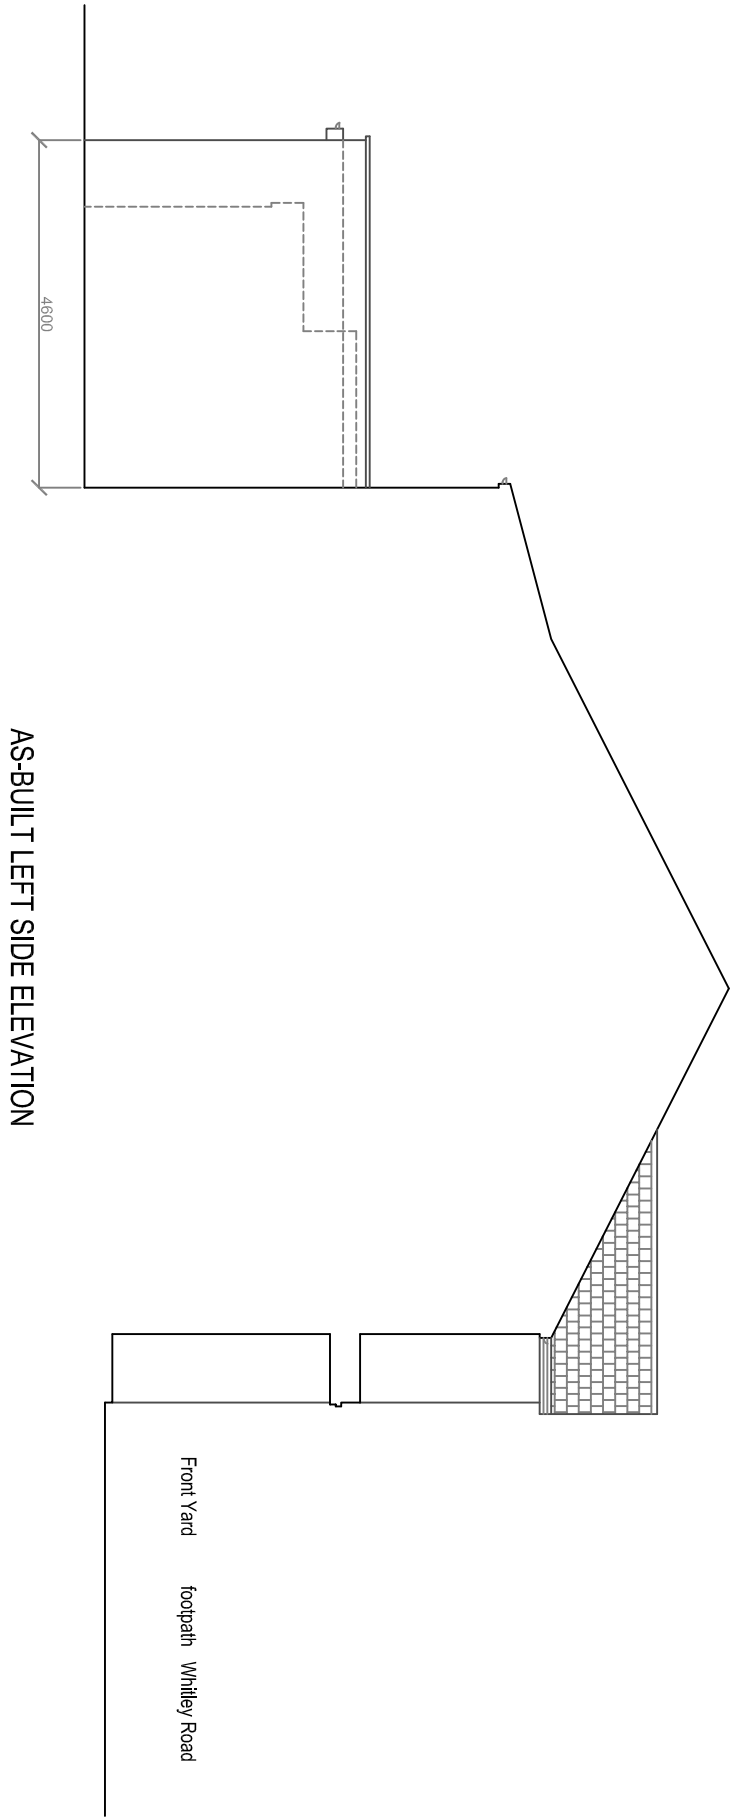

AS-BUILT RIGHT SIDE ELEVATION

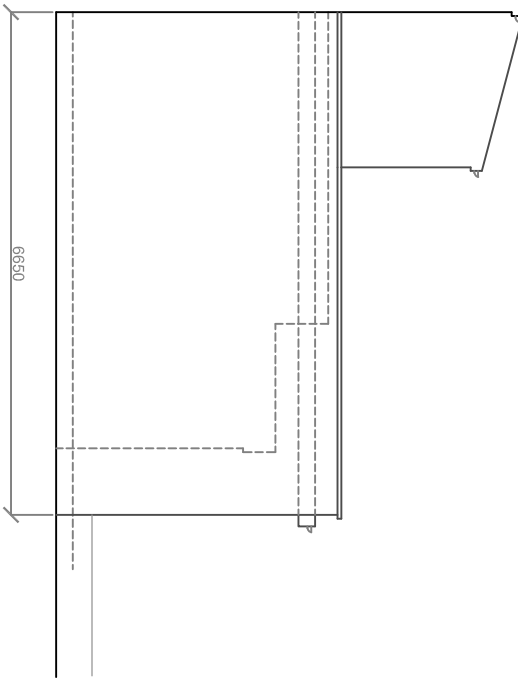

AS-BUILT LEFT SIDE ELEVATION



Project
Retention of As Built 4.6m
Single Storey Rear Extension
At 17 Whitley Road,
Tottenham, London, N17 6RJ

Sheet Title
As-Built Rear Elevation &
Side Elevations

Revisions

Notes

Do not scale these drawings. Any
discrepancies noted are to be reported to
RIBO Associates Ltd immediately

Drawn by	RB
Scale	1:100 @ A3
Date	Oct 2023
Job No.	17WR/P2



RIBO ASSOCIATES LTD
Architectural Consultants
51 Hassocks Road, Streatham Vale,
London SW16 5HA
Tel: 020 8617 9182 / 07946 872 604
E: ribo.arch@gmail.com

Drawing No.

9

of