



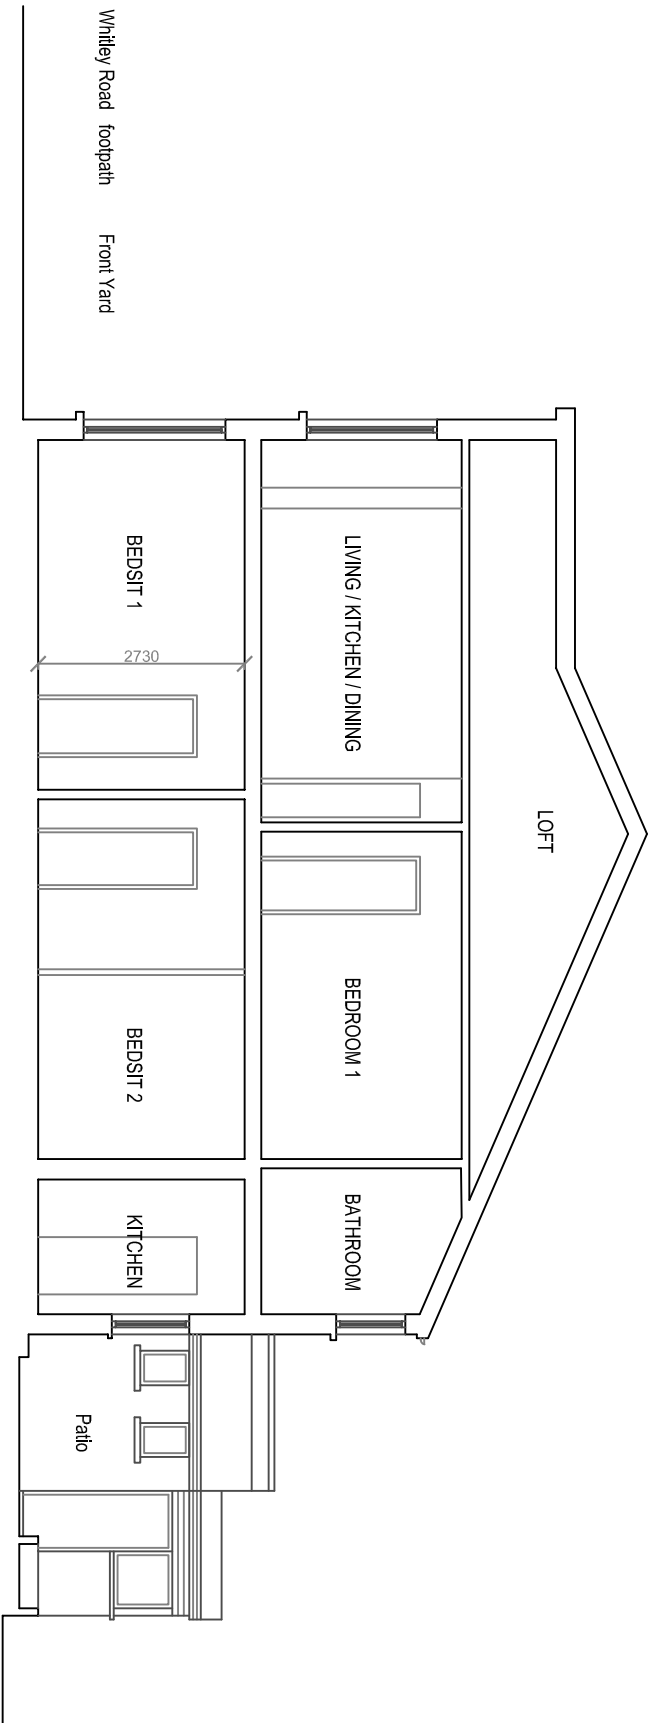

PREVIOUSLY EXISTING SECTION A-A

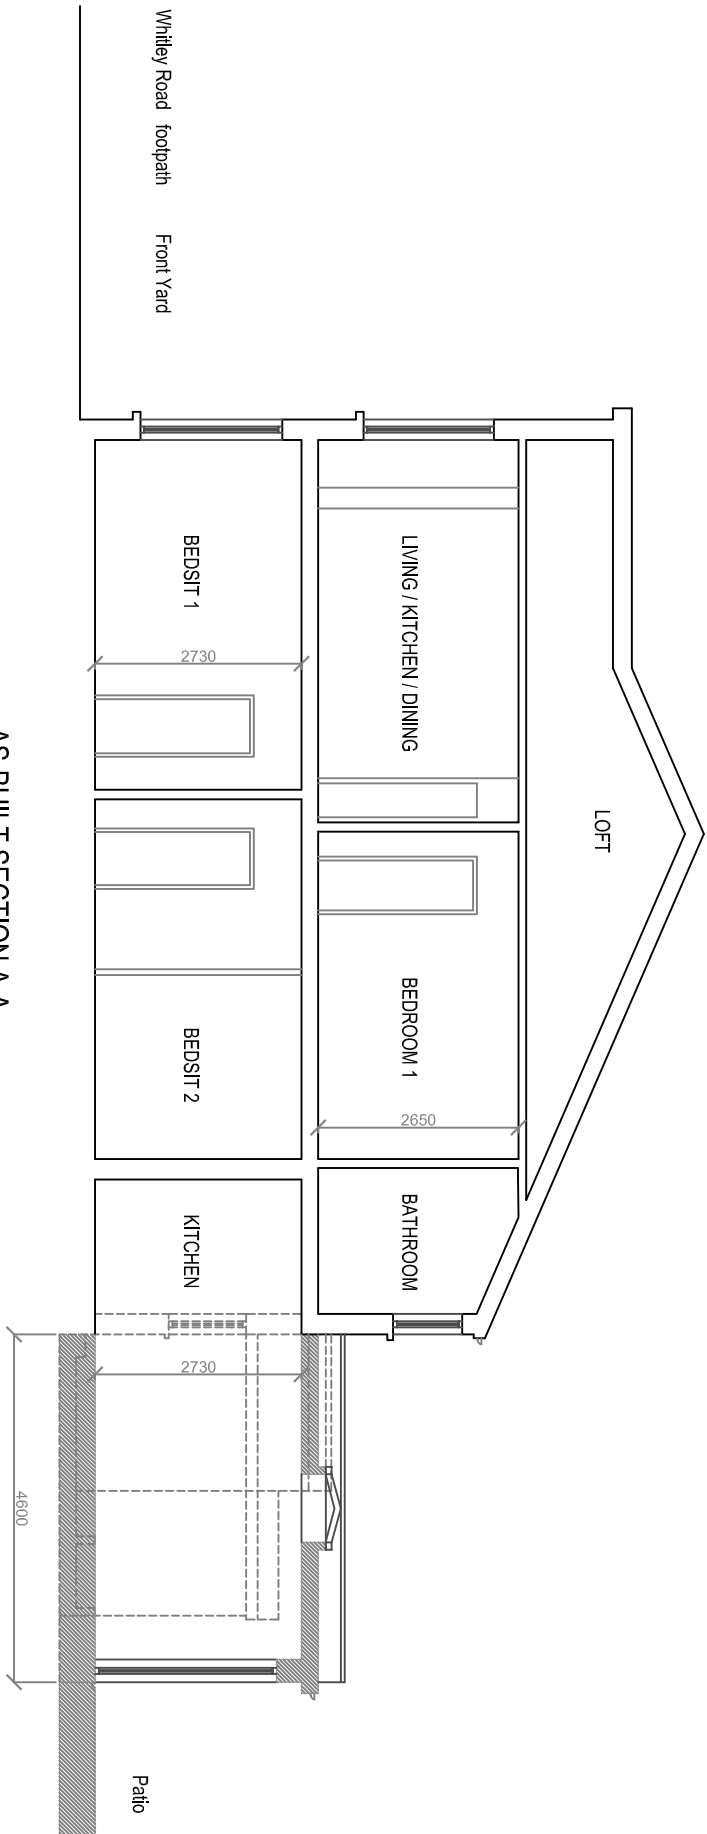

AS-BUILT SECTION A-A

Project Retention of As Built 4.6m Single Storey Rear Extension At 17 Whitley Road, Tottenham, London, N17 6RJ	Sheet Title	Notes	Drawn by	RB	RIBO ASSOCIATES LTD Architectural Consultants 51 Hassocks Road, Streatham Vale, London SW16 5HA Tel: 020 8617 9182 / 07946 872 604 E: ribo.arch@gmail.com	Drawing No.
	Previously Existing & As-Built Section A-A		Scale	1:100 @ A3		10
	Revisions	Do not scale these drawings. Any discrepancies noted are to be reported to RIBO Associates Ltd immediately	Date	Oct 2023		of
			Job No.	17WR/P2		