
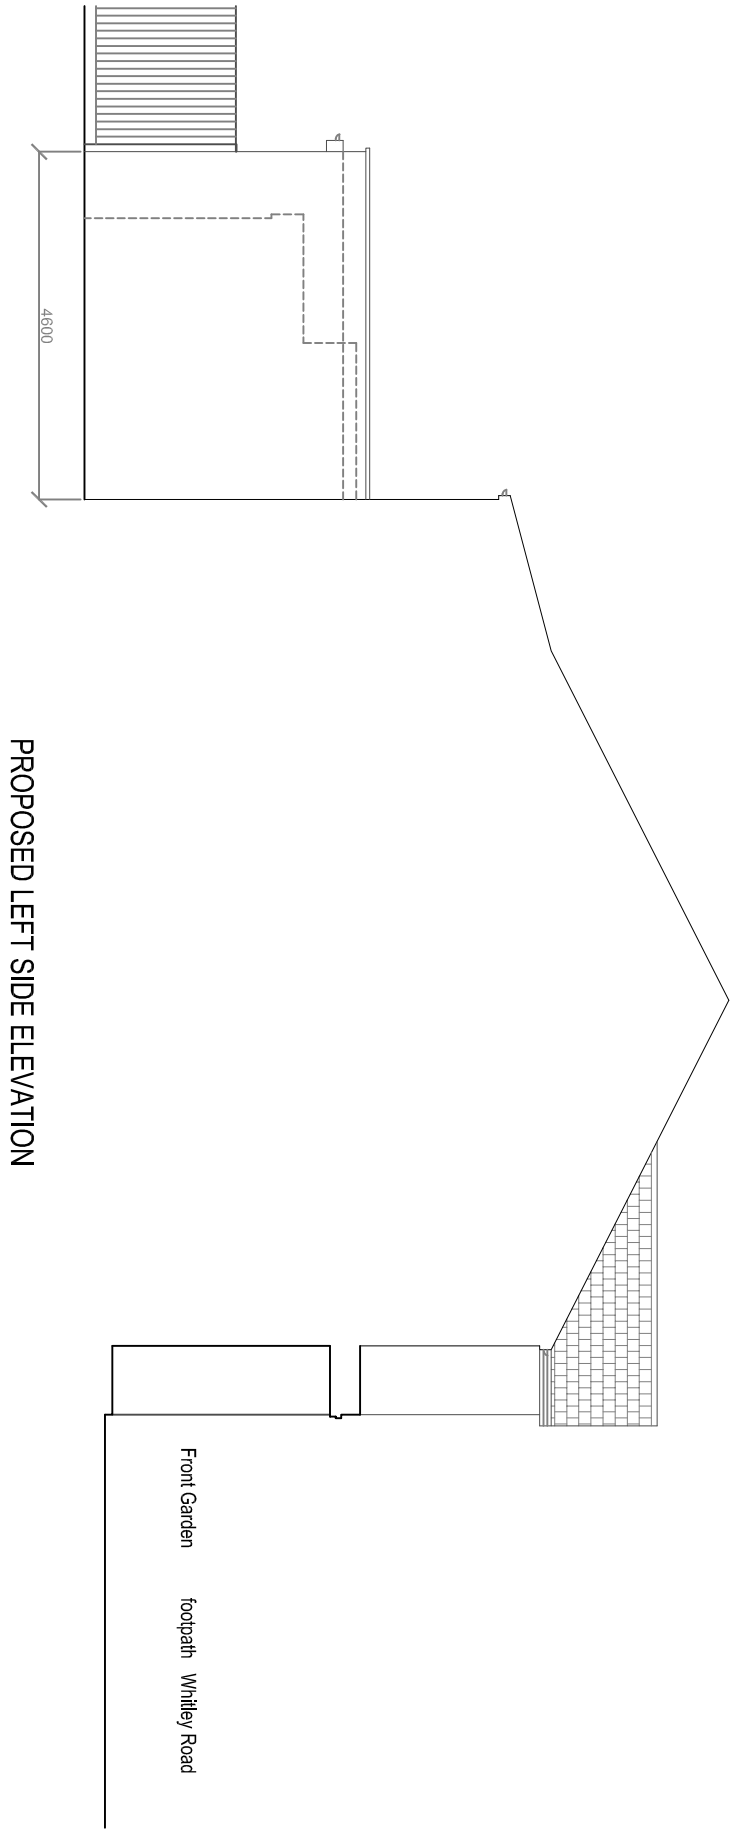
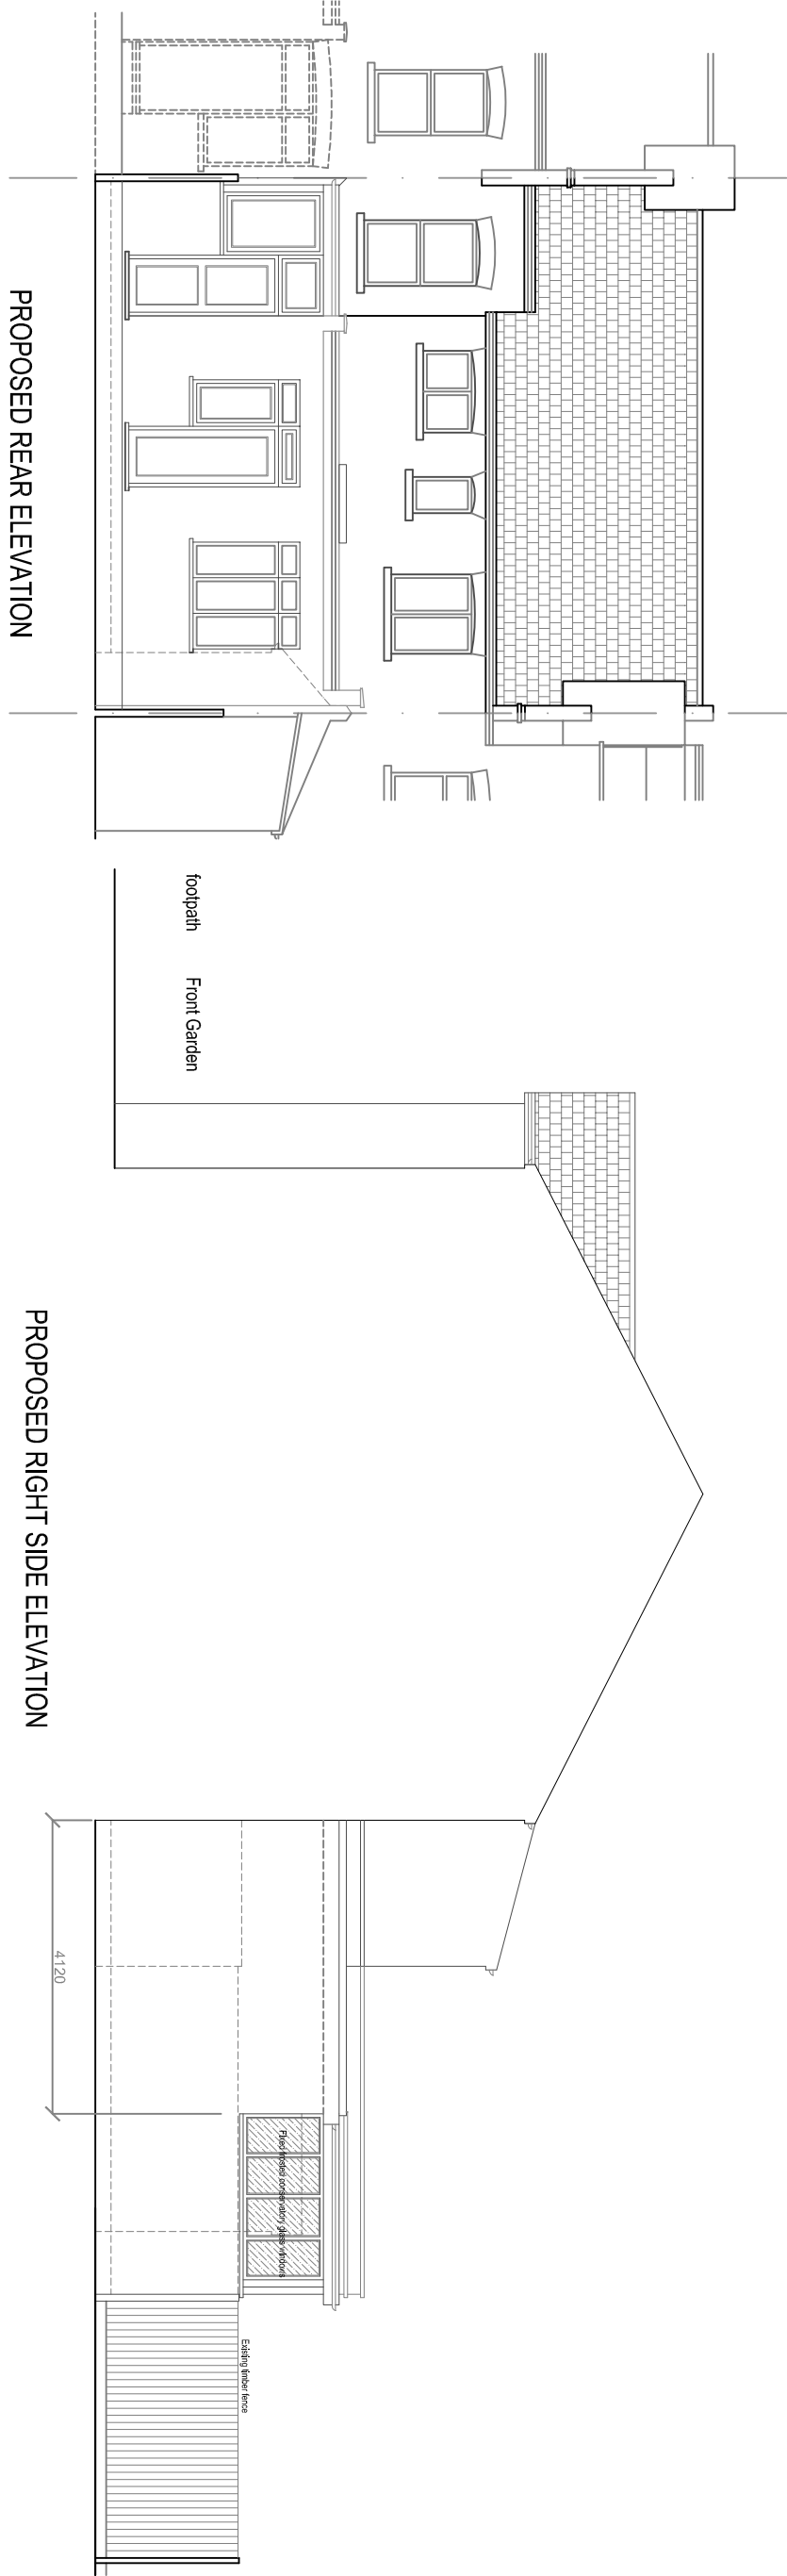


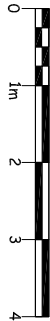

Project Retention of As Built 4.6m Single Storey Rear Extension At 17 Whitley Road, Tottenham, London, N17 6RJ	Sheet Title Proposed Rear Elevation & Side Elevations	Notes Do not scale these drawings. Any discrepancies noted are to be reported to RIBO Associates Ltd immediately	Drawn by RB	 RIBO ASSOCIATES LTD Architectural Consultants 51 Hassocks Road, Streatham Vale, London SW16 5HA Tel: 020 8617 9182 / 07946 872 604 E: ribo.arch@gmail.com	Drawing No. 12 of
	Revisions		Scale 1:100 @ A3		
			Date Oct 2023		
			Job No. 17WR/P2		