


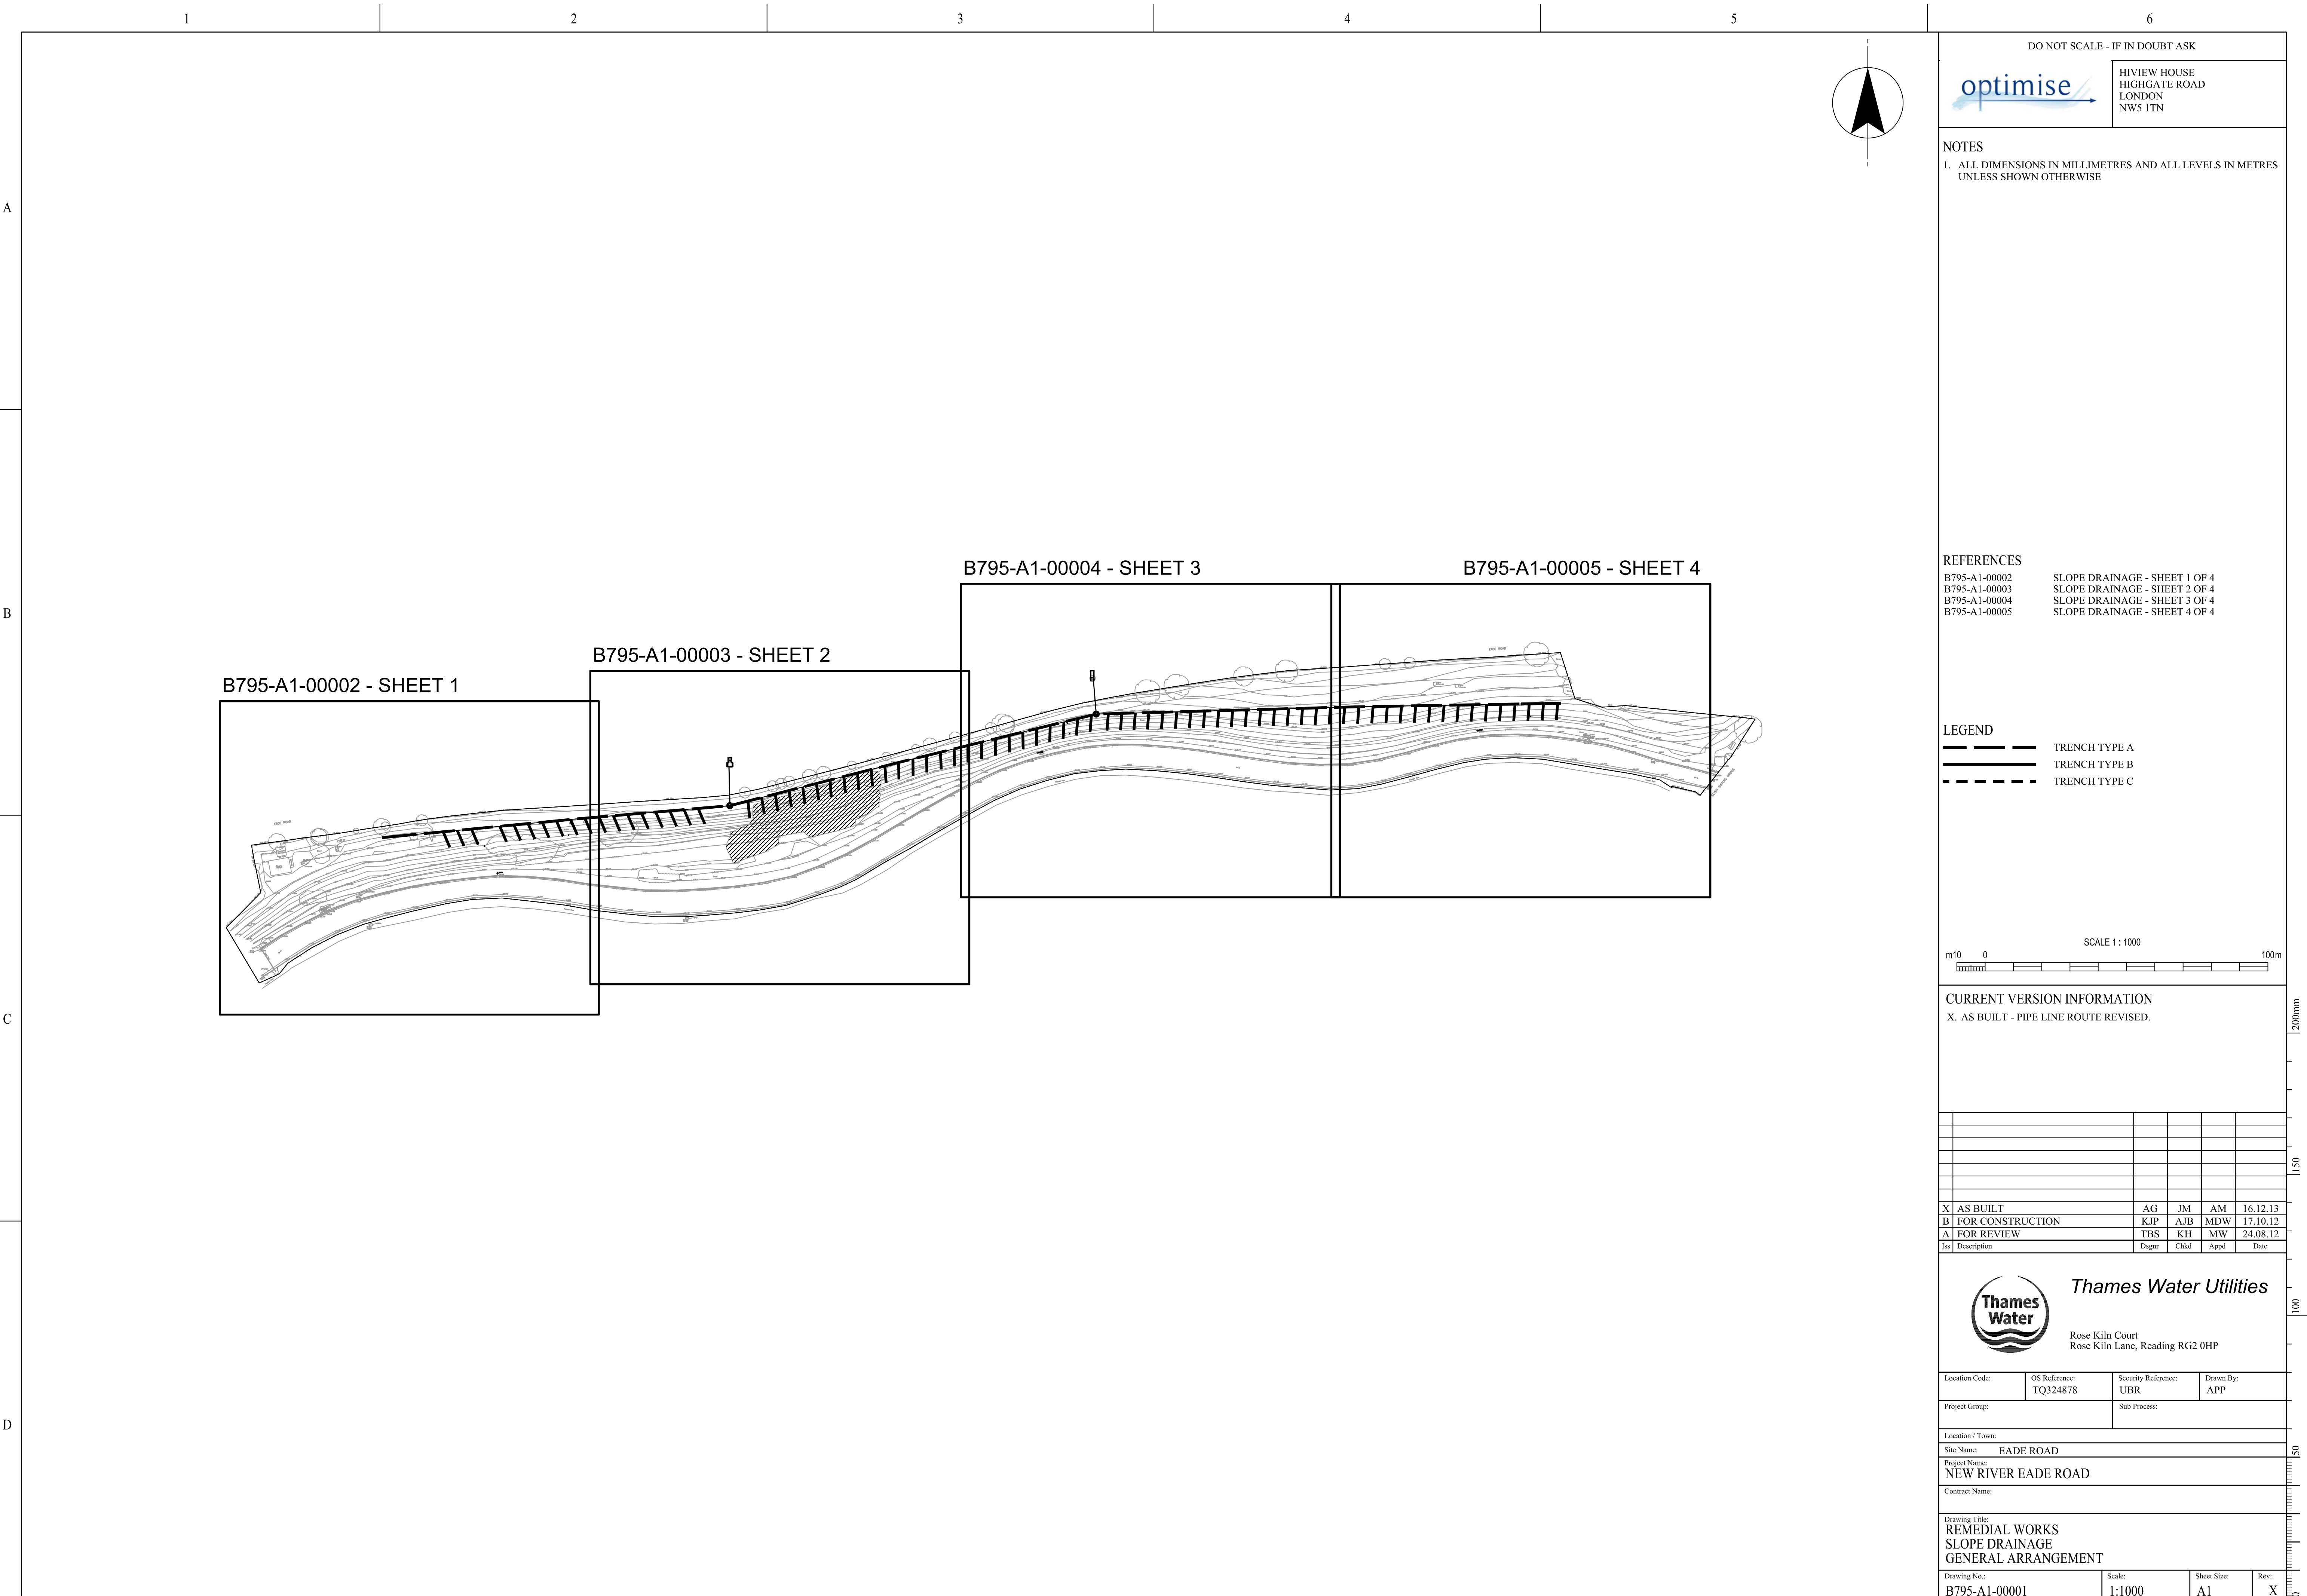

DO NOT SCALE - IF IN DOUBT ASK

HIVIEW HOUSE
HIGHGATE ROAD
LONDON
NW5 1TN

NOTES

1. ALL DIMENSIONS IN MILLIMETRES AND ALL LEVELS IN METRES
UNLESS SHOWN OTHERWISE

REFERENCES

B795-A1-00002
B795-A1-00003
B795-A1-00004
B795-A1-00005

SLOPE DRAINAGE - SHEET 1 OF 4
SLOPE DRAINAGE - SHEET 2 OF 4
SLOPE DRAINAGE - SHEET 3 OF 4
SLOPE DRAINAGE - SHEET 4 OF 4

LEGEND

TRENCH TYPE A

TRENCH TYPE B

TRENCH TYPE C

m1000

0

100m

SCALE 1: 1000

CURRENT VERSION INFORMATION

X. AS BUILT - PIPE LINE ROUTE REVISED.

X	AS BUILT	AG	JM	AM	16.12.13
B	FOR CONSTRUCTION	KJP	AJB	MDW	17.10.12
A	FOR REVIEW	TBS	KH	MW	24.08.12
Iss	Description	Dsgnr	Chkd	Appd	Date

Thames Water Utilities

Rose Kiln Court
Rose Kiln Lane, Reading RG2 0HP

Location Code:	OS Reference: TQ324878	Security Reference: UBR	Drawn By: APP
Project Group:	Sub Process:		
Location / Town:			
Site Name: EADE ROAD			
Project Name: NEW RIVER EADE ROAD			
Contract Name:			
Drawing Title: REMEDIAL WORKS SLOPE DRAINAGE GENERAL ARRANGEMENT			
Drawing No: B795-A1-00001	Scale: 1:1000	Sheet Size: A1	Rev: X