
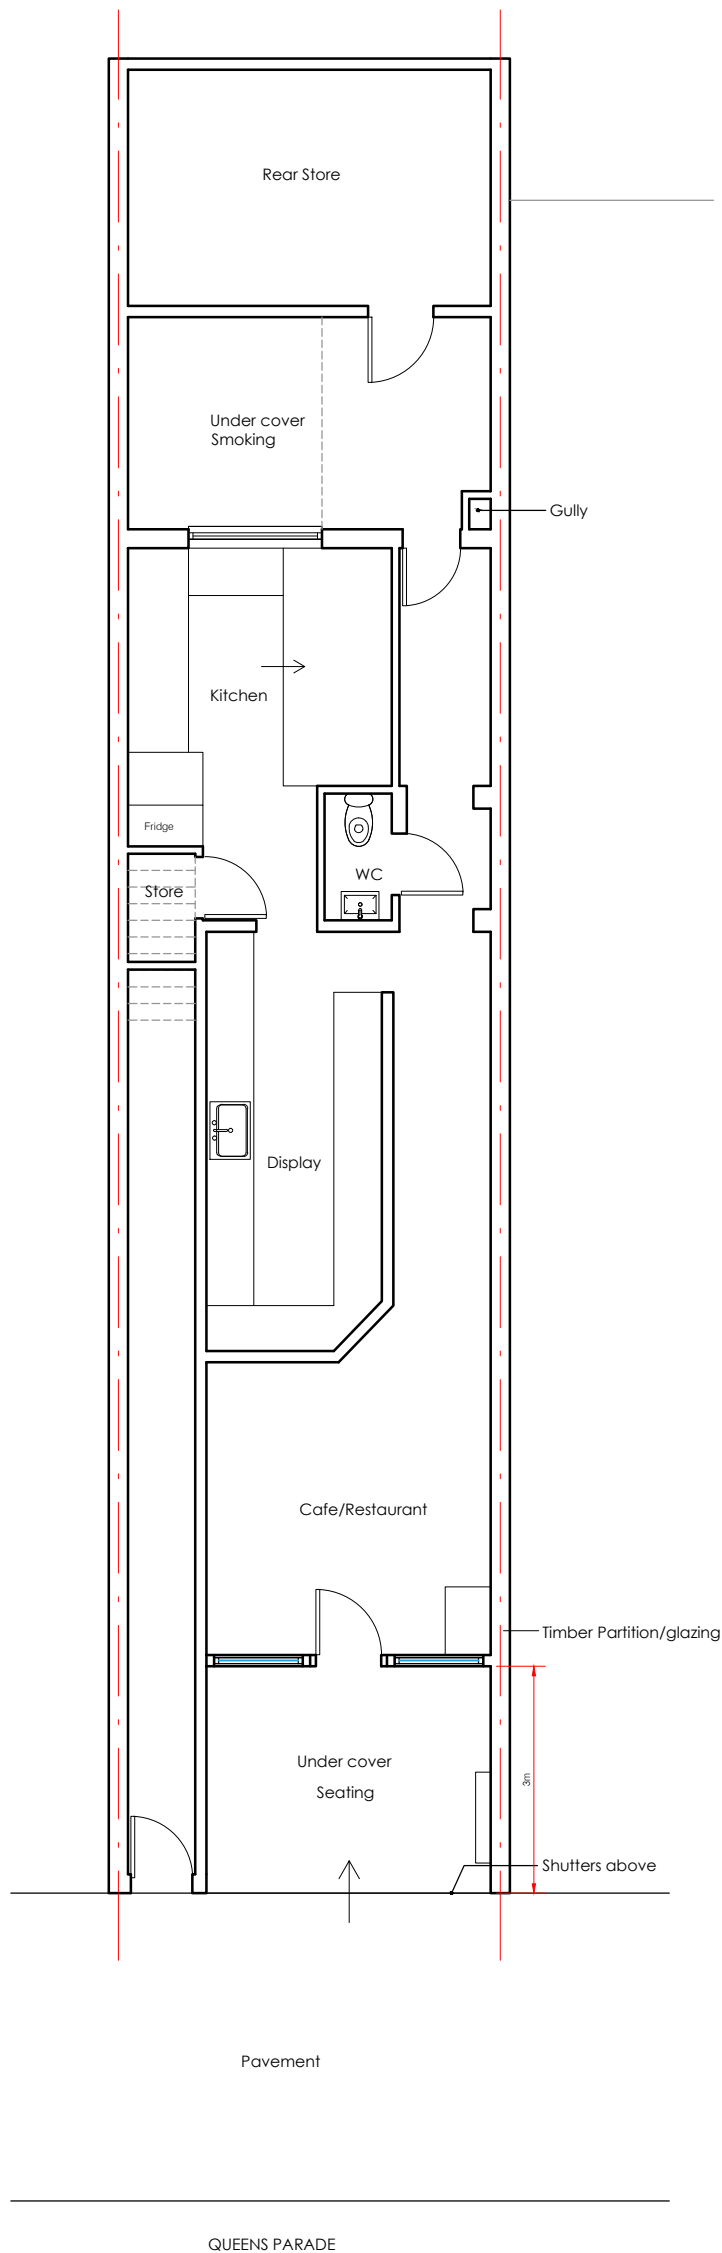
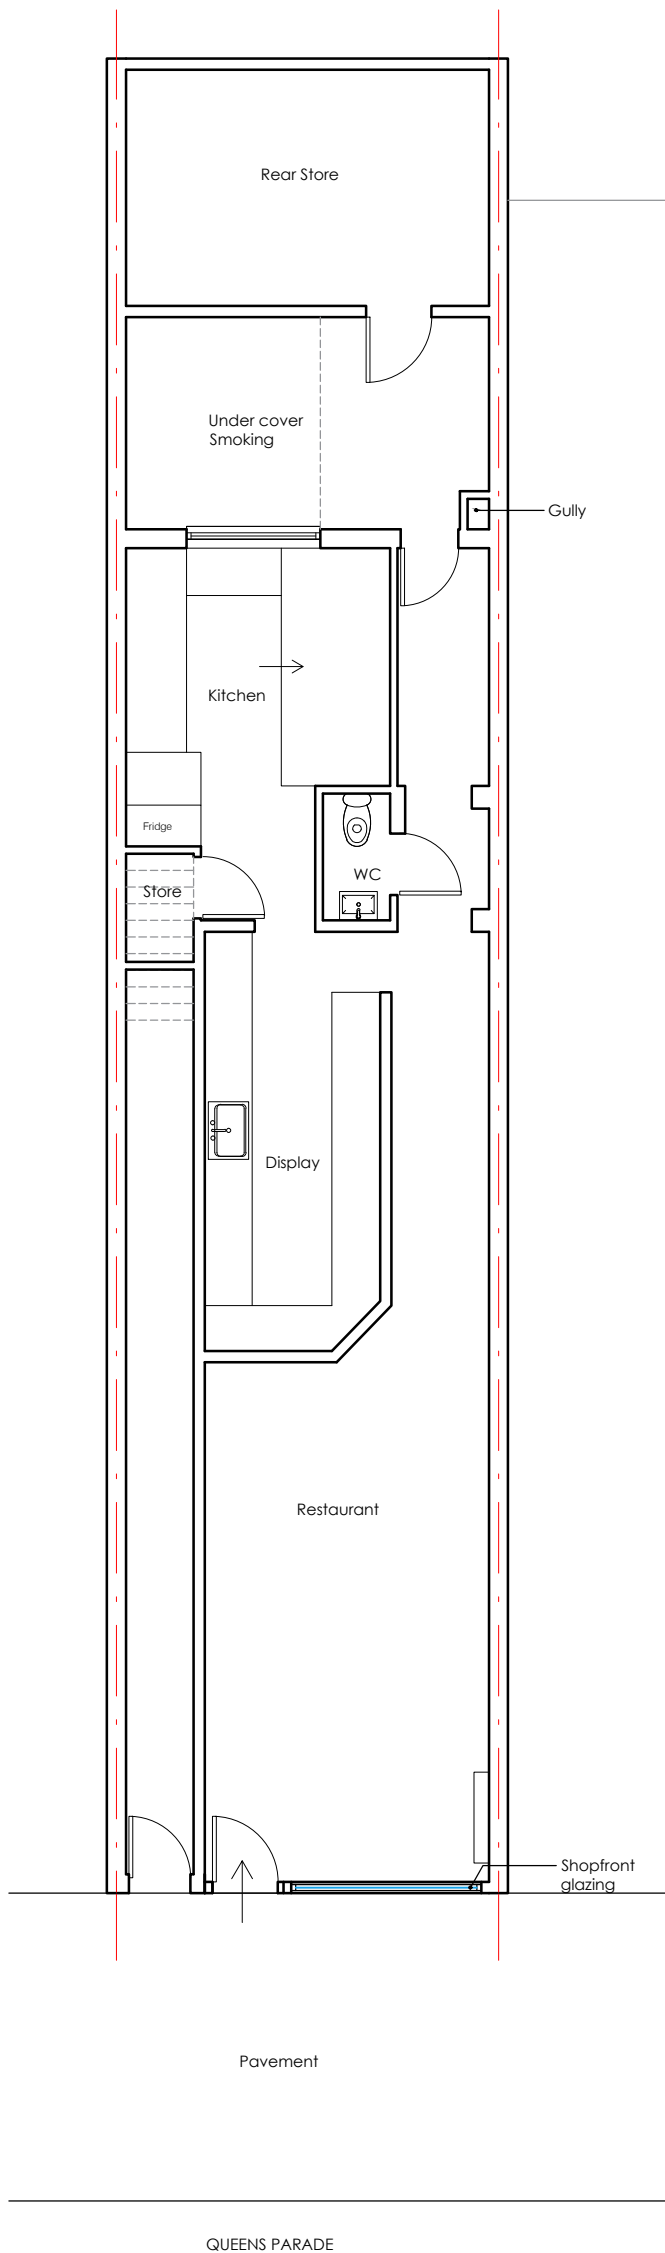


KEY:	
	EXISTING WALLS
	AS PROPOSED EXTERNAL WALLS
	AS PROPOSED WALLS
	SITE BOUNDARY

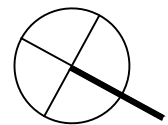

A: Plans as existing and as proposed indicated 28.05.2024

REV	DESCRIPTION	DATE
-----	-------------	------

JOB

3 Queens Parade
Haringey EN8 9DJ

CLIENT

Client: Andreas Mpletsas

DESCRIPTION

Ground Floor Plan
As Existing & As Proposed

DWG. No.	24639/01	REV	A
----------	----------	-----	---

Scale 1:100
0 2m 4m

DATE March 2024

DWG. BY PE CHECKED BY NS

Archi-Tone Ltd
Chartered Architects

130 East Barnet Road
New Barnet
Herts EN4 8RE
tel : 0208 447 0088
fax: 0208 441 7114
architoneltd@gmail.com

Ground floor Plan
As Existing /As before built

Ground floor Plan
As Proposed/As built