



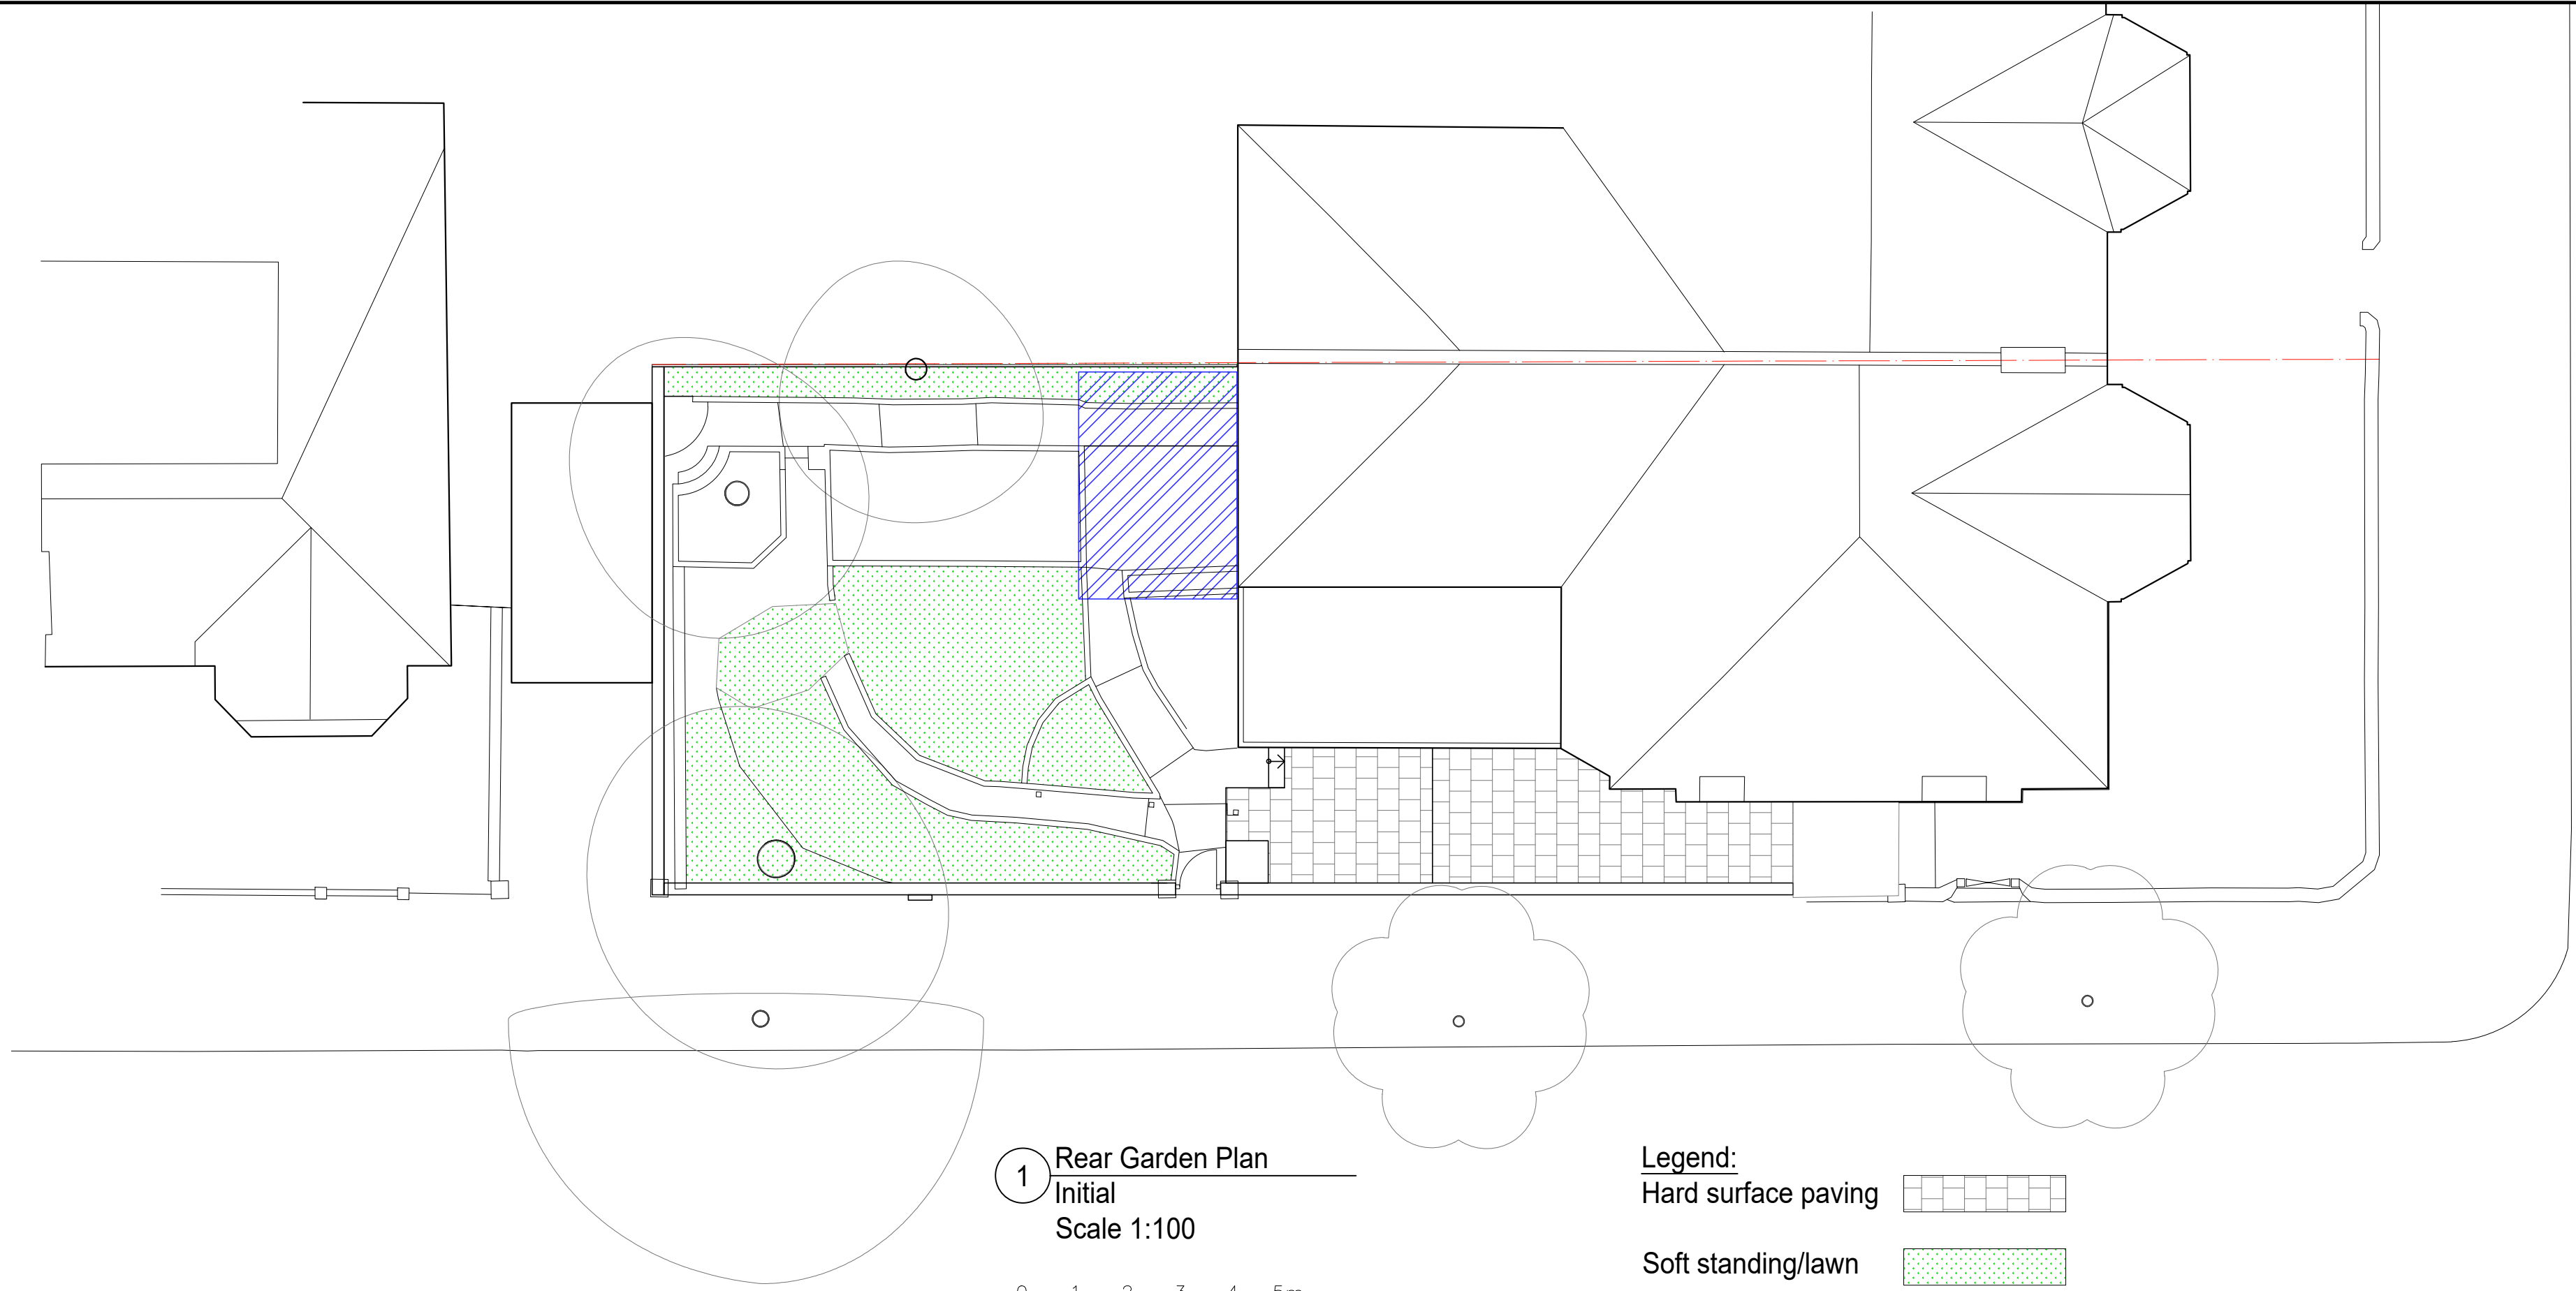


1 Rear Garden Plan
Initial
Scale 1:100

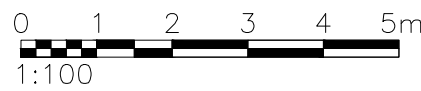


- Legend:
- Hard surface paving
 - Soft standing/lawn
 - Surface drainage fall
 - Pergola

Cumulative green permeable area 45sqm

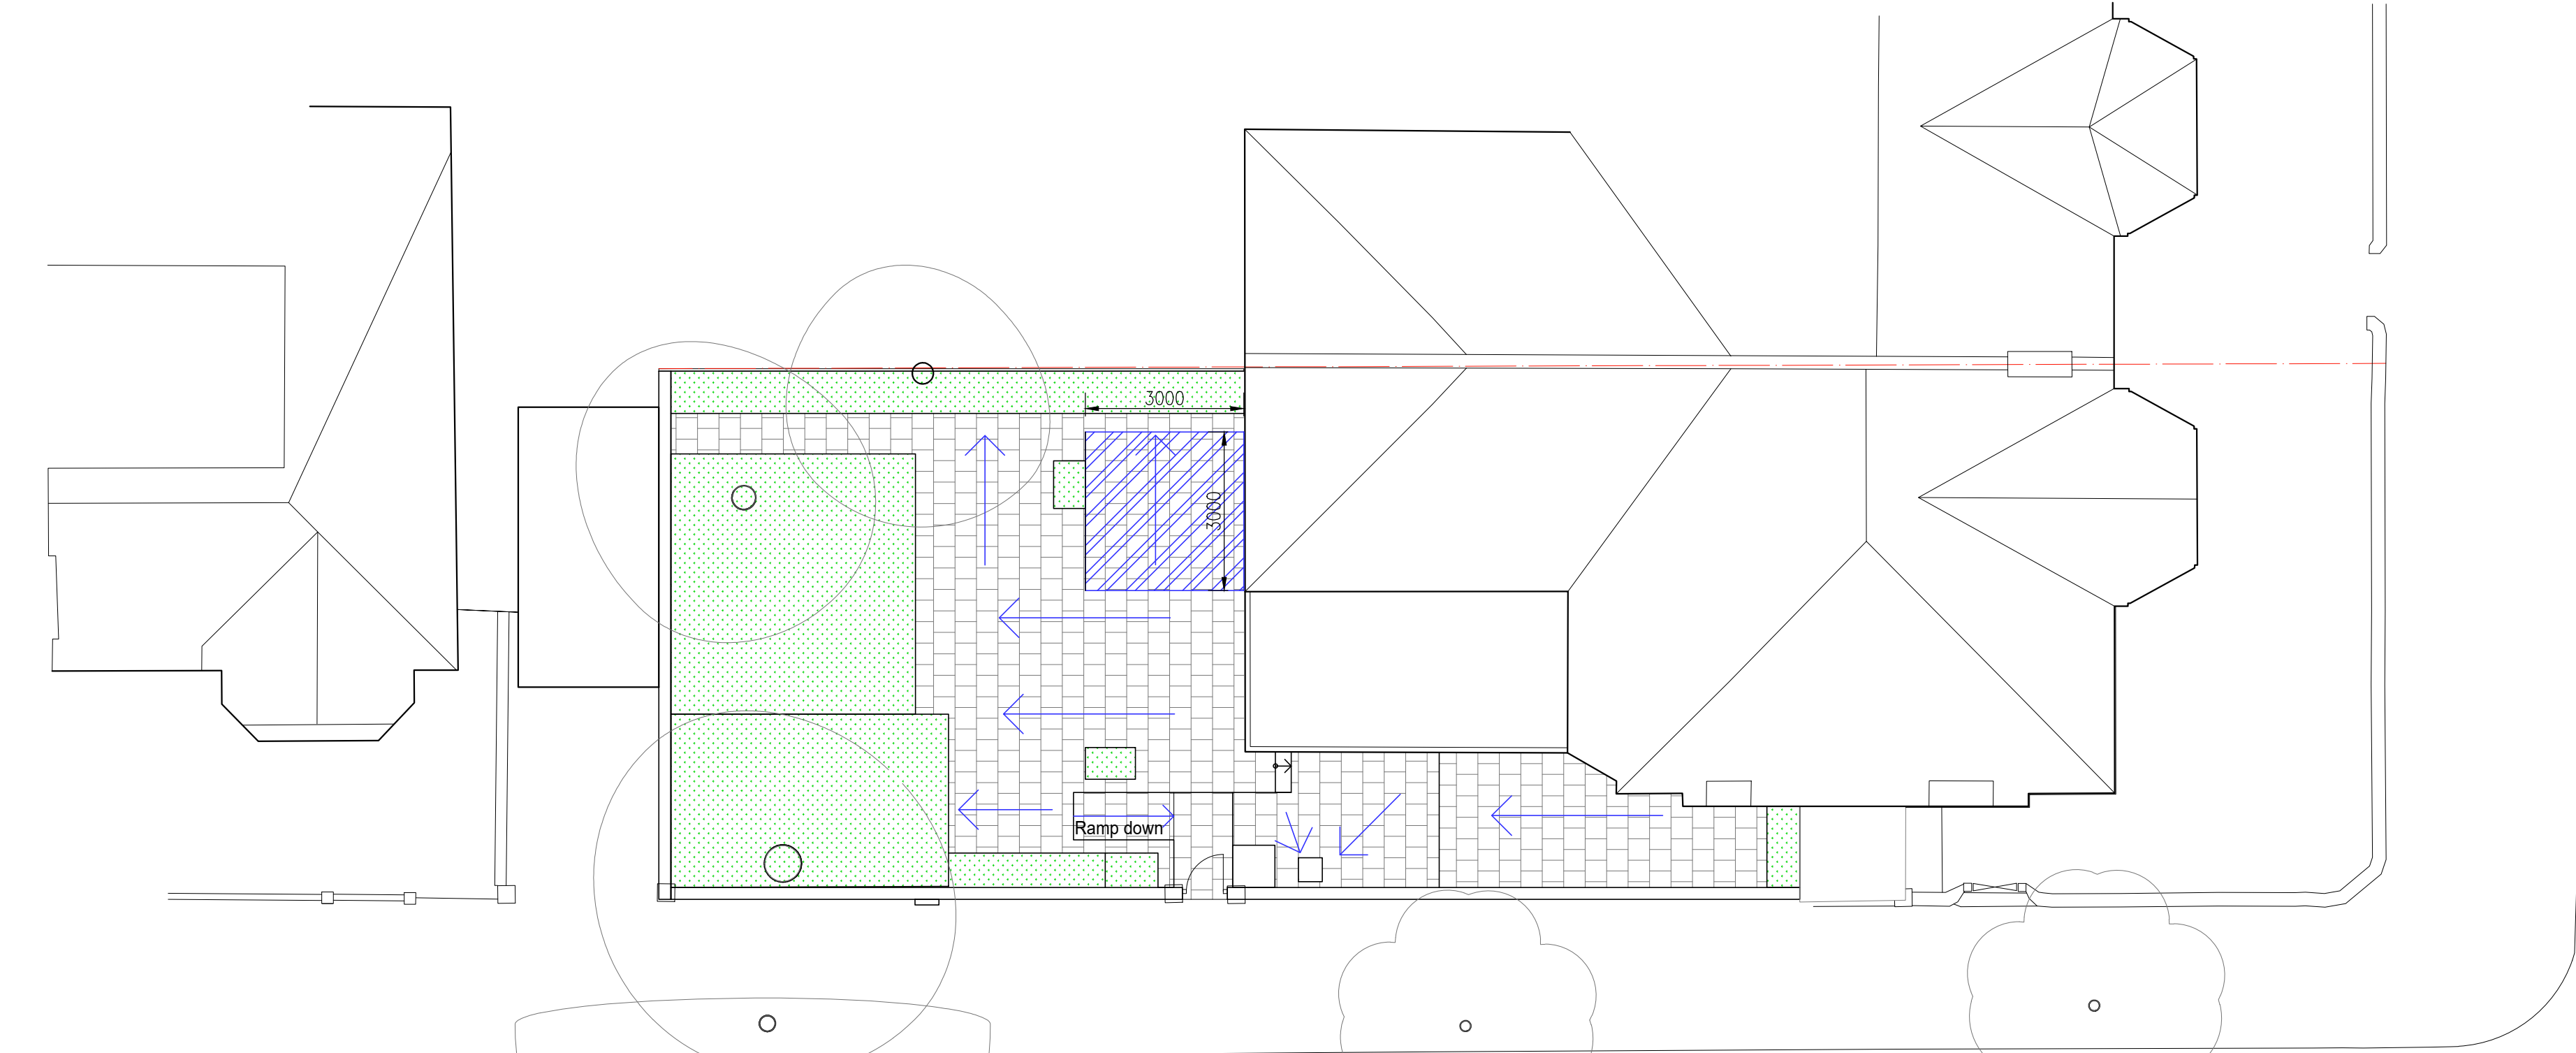

1 Rear Garden Plan
As Built
Scale 1:100

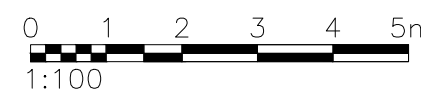

- Legend:
- Hard surface paving
 - Soft standing/lawn
 - Surface drainage fall
 - Pergola


Cumulative green permeable area 53sqm

Notes:

1. THE COPYRIGHT OF THIS DRAWING IS VESTED IN GAMUT BUILDING

D	General	MP	04/06/24
C	General	MP	16/05/24
B	Ex Pergola	MP	04/03/24
A	First Issue	MP	04/03/24
REV:	DESCRIPTION:	BY:	DATE:

STATUS: Planning Issue

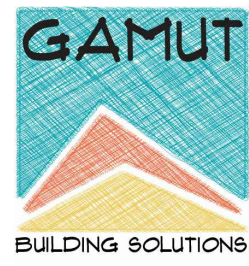

GAMUT Building Solutions
The Lightbox, Unit 1.57
111 Power Road, London, W4 5PY
T: 0208 0013 515 M: 074 032 44 240
info@GamutBS.co.uk
www.GamutBS.co.uk

CLIENT: Siobhan McMillan

SITE: 1A Dukes Avenue
LONDON, N10 2QE

TITLE: Existing and Proposed
Site and Garden Plans

SCALE AT A1: 1:100	DATE: March 2024	DRAWN: MP	CHECKED: -
PROJECT NO: 00523	DRAWING NO: PL402	REVISION:	D