


ELEVATION 01 - SECTION 1
SCALE 1:50 @ A1




ELEVATION 01 - SECTION 2
SCALE 1:50 @ A1

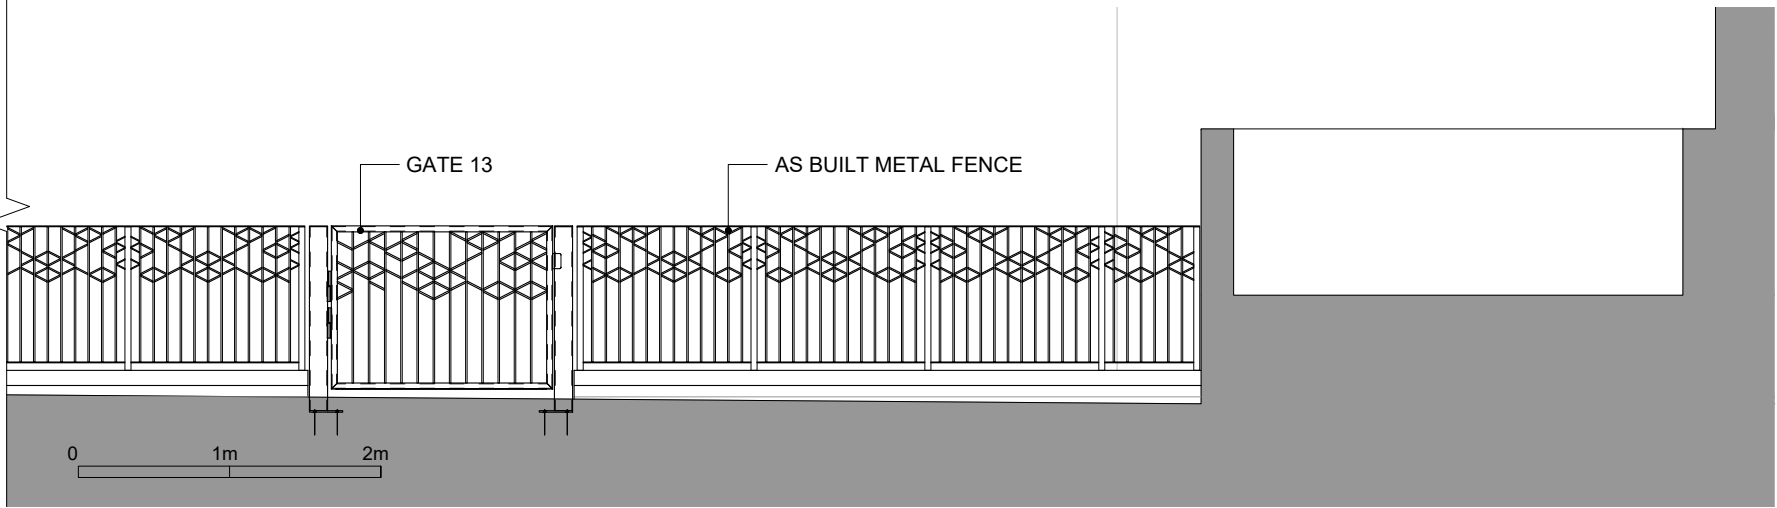


VIEW A



VIEW B

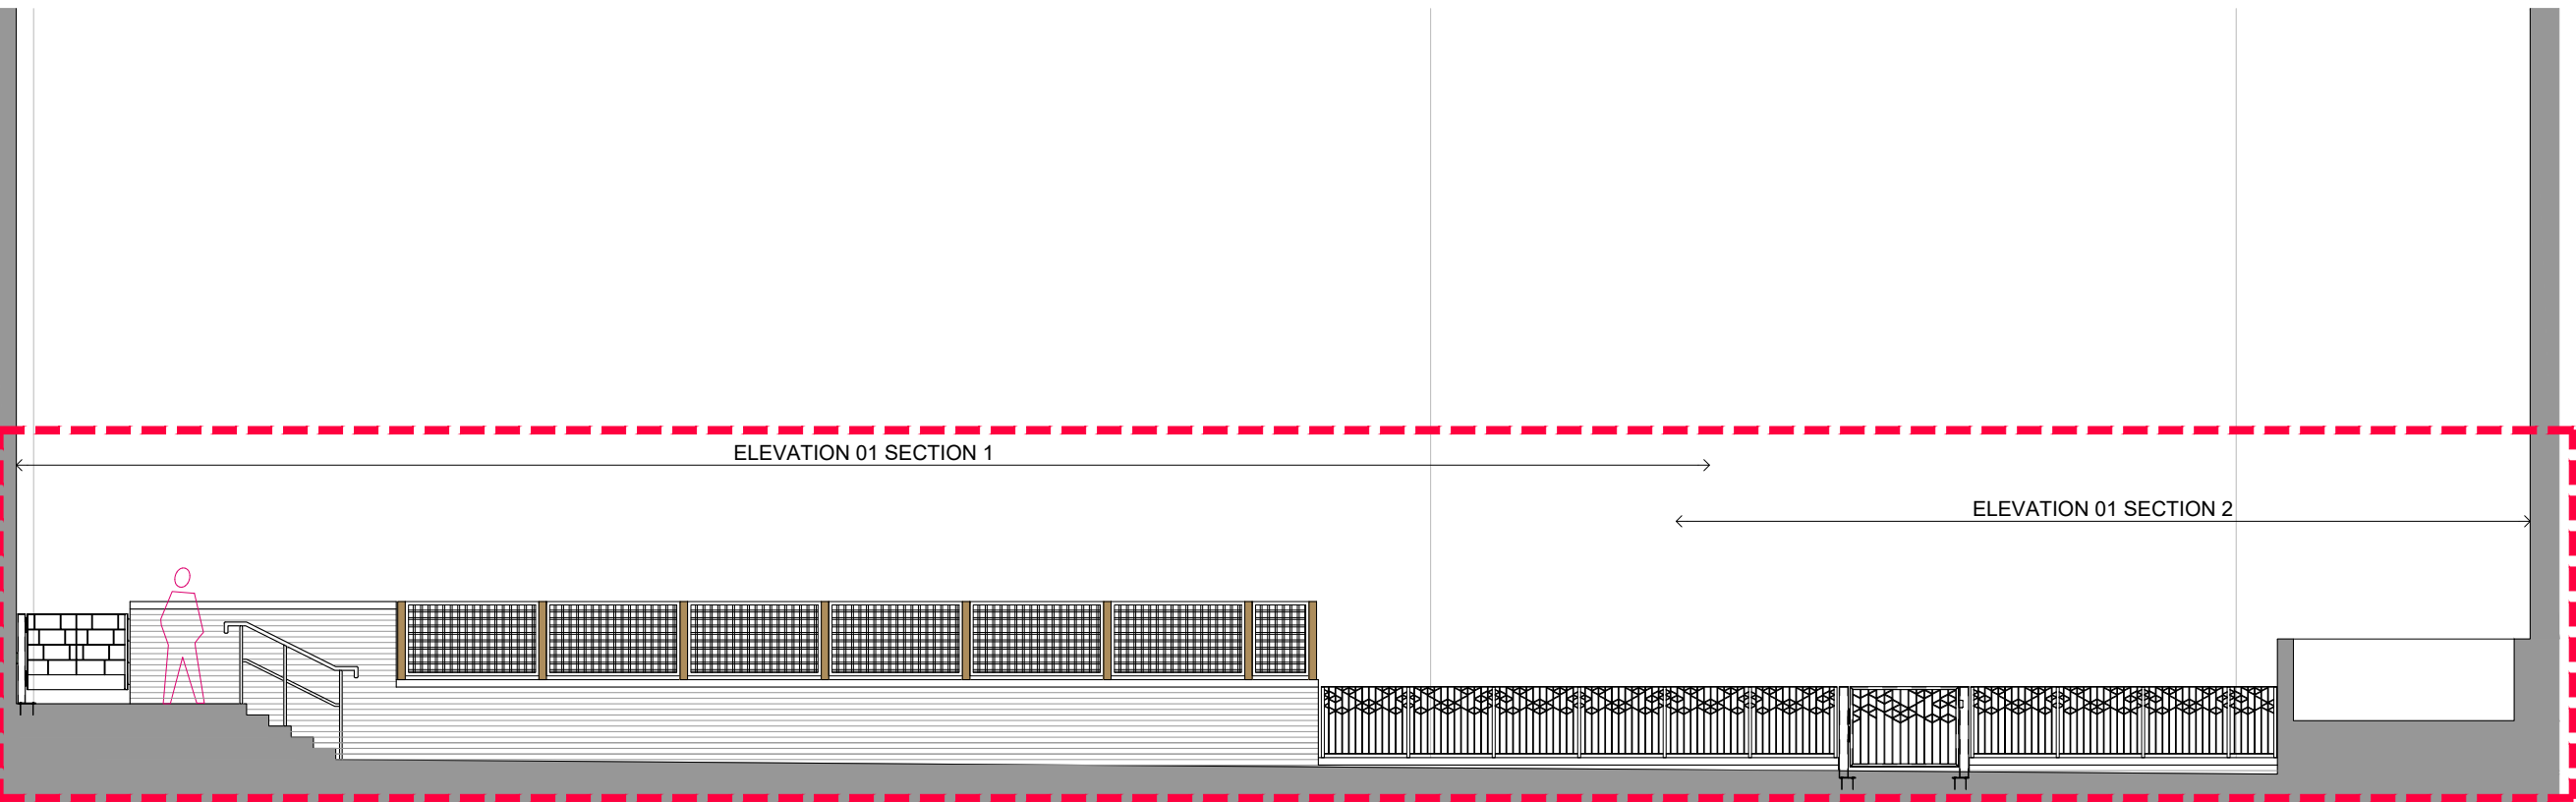

ELEVATION 01
SCALE 1:100 @ A1

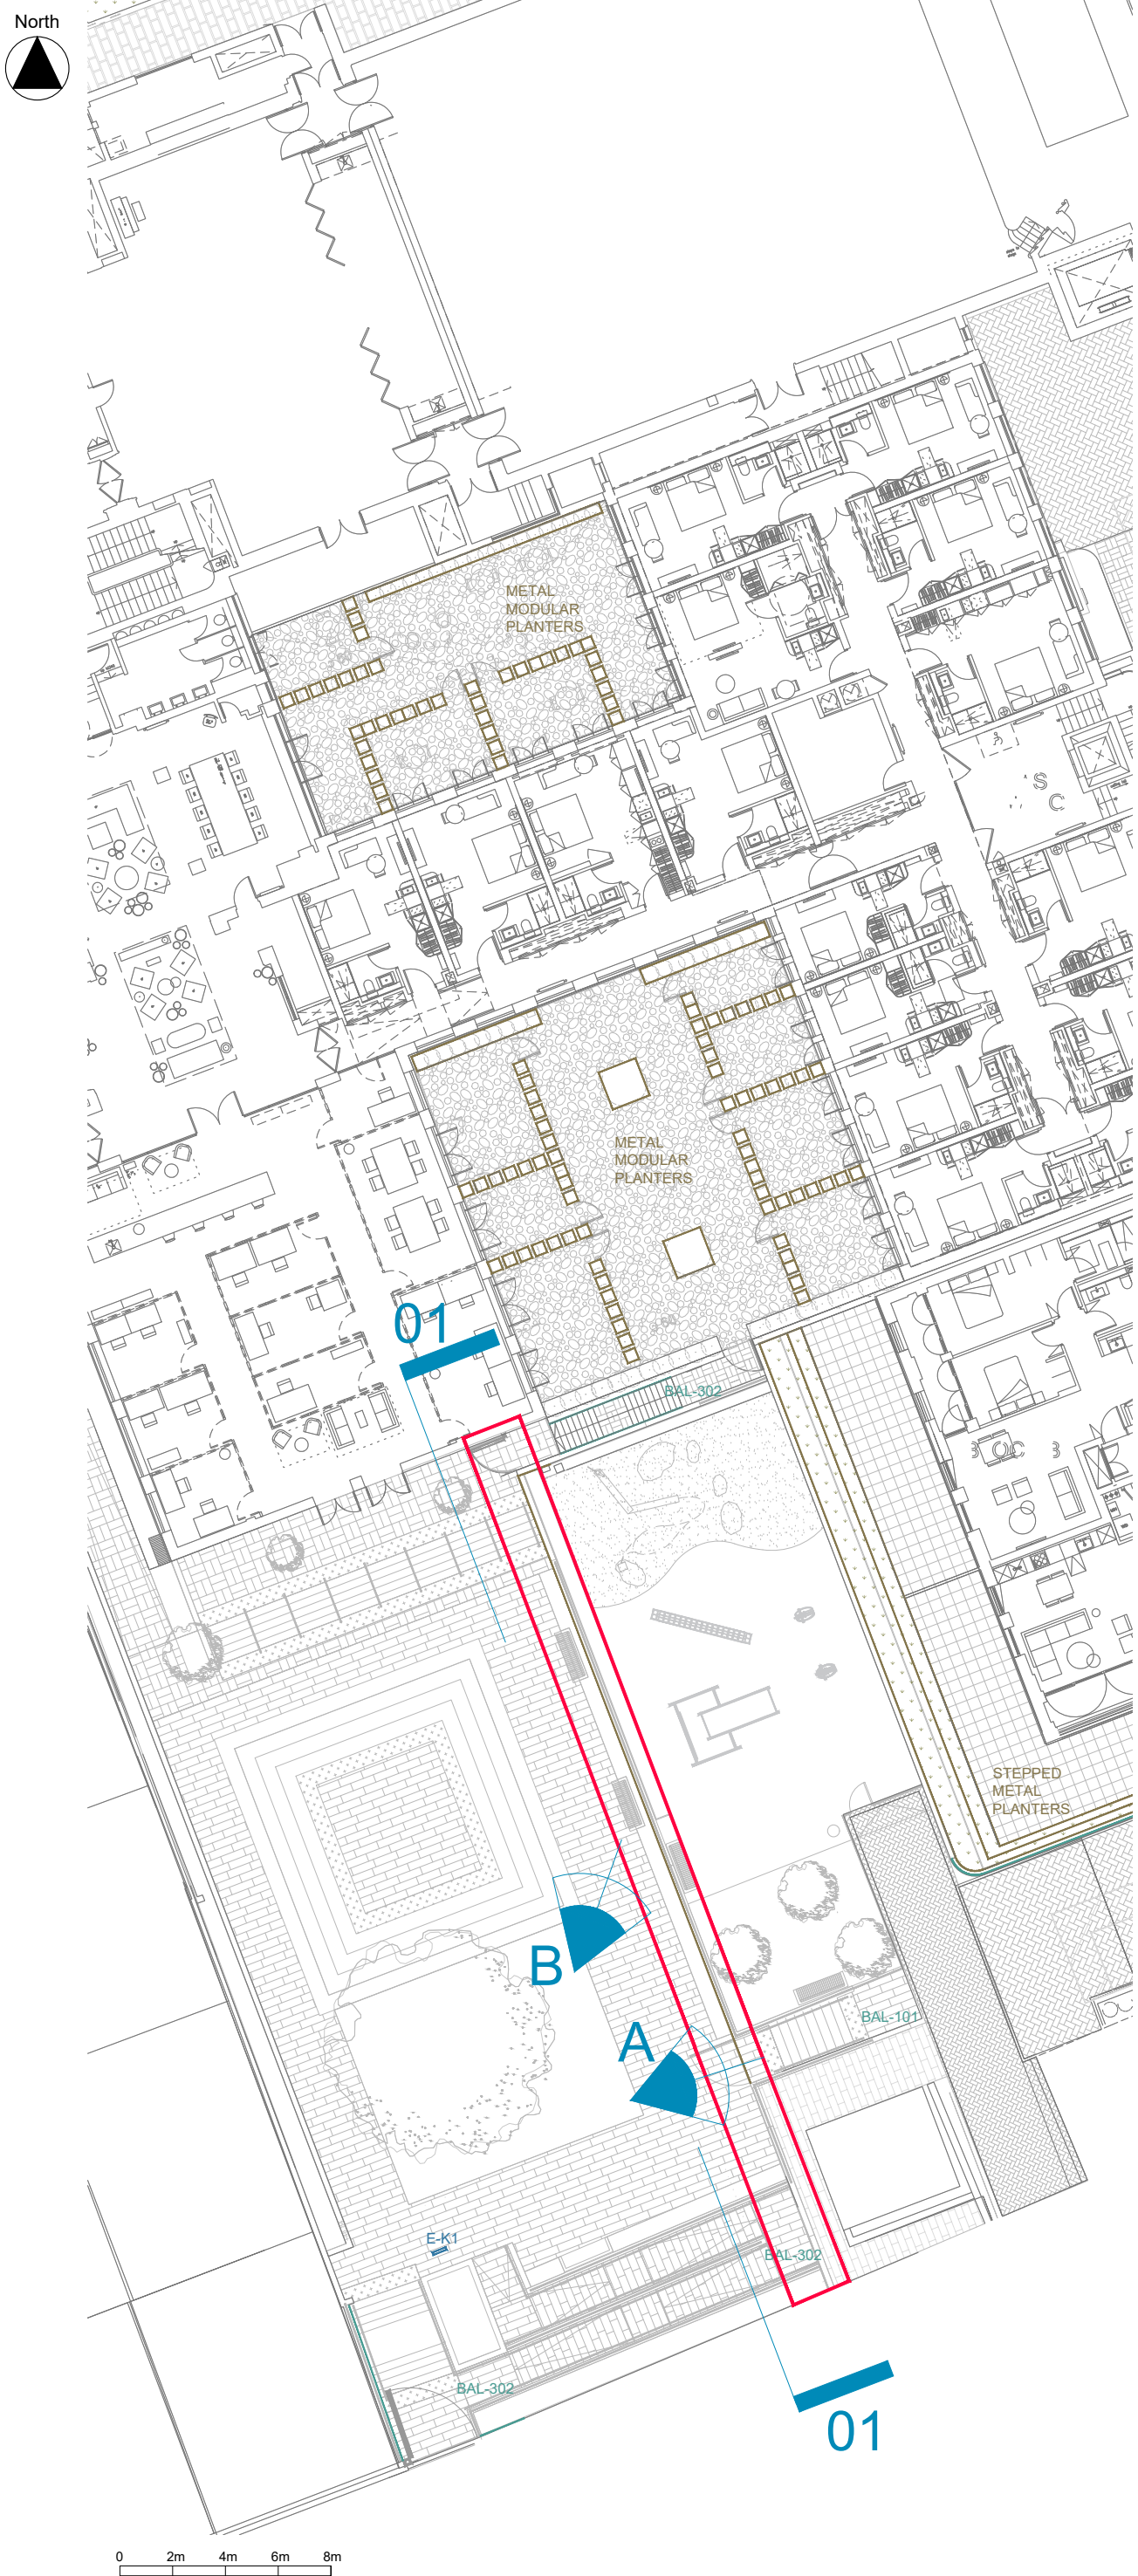

KEY PLAN
SCALE 1: 250 @ A1

© Longlane Architects Ltd
No part of this drawing may be reproduced without written consent.
All contractors must visit site and be responsible for taking and checking all dimensions relating to this work.
Do not scale from this drawing.

REVISION NOTES
A 03.02.2025 PS ISSUED FOR PLANNING

Ardmore GROUP
ARDMORE CONSTRUCTION LTD
6 WHARF STUDIOS,
28 WHARF ROAD,
LONDON, N1 7GR
TEL: 0209-344 0300
www.ardmoregroup.co.uk

Longlane Architects
5 Tanner Street
London, SE1 3LE
office@longlanearchitects.co.uk

PLANNING

PROJECT
HORNSEY TOWN HALL
TOWN HALL

DRAWING TITLE
PLAYGROUND WALL
EXISTING - AS BUILT

SCALE
1:100 @ A1

DRAWING NUMBER
3670-KDS-TH-ZZ-DR-A-90-1012

A