



Ardmore Construction Limited



Hornsey Town Hall

Planning Report – Gates

January 2025



Contents

Photographic Report of External Gates	3
1. Gate 1 – Town Hall Vehicle Gate	3
2. Gate 2 – Town Hall emergency escape and annex cycle store access	4
3. Gate 3 – Library access	5
4. Gate 4 – Car park access gate (north)	6
5. Gate 5 – Car park access gate (south)	7
6. Gate 6 – Mews Entrance	8
7. Gate 7 – Omitted	9
8. Gate 8 – Town Hall Gardens to hotel courtyard	10
9. Gate 9 – Town Hall Gardens to hotel courtyard	11
10. Gate 10 – UKPN access to substation	12
11. Gate 11 – Access road at the rear of block A	13
12. Gate 12 – Access road at the rear of block A	14
13. Gate 13 – Access from block B access road to Town Hall Gardens	15
14. Gate 14 – Access to rear of Annex	16
15. Gate 15 – Within hotel courtyards	17
16. Gate 16-18 – Omitted	18
17. Gate 19 – Fire Escape from Annex	19

Photographic Report of External Gates

Refer to Longlane Drawing C4-001 – Landscape Furniture Plan


1. Gate 1 – Town Hall Vehicle Gate

Drawing:

- 7414-10-009

Location:

- Town Hall Square

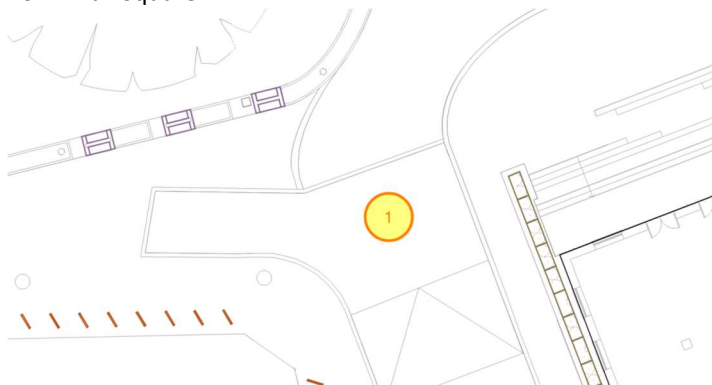






Finish:

- RAL 7016 – anthracite grey

Photograph:



ANY AUTOMATION, MAG LOCK OR CLOSER TO BE SUPPLIED BY OTHERS

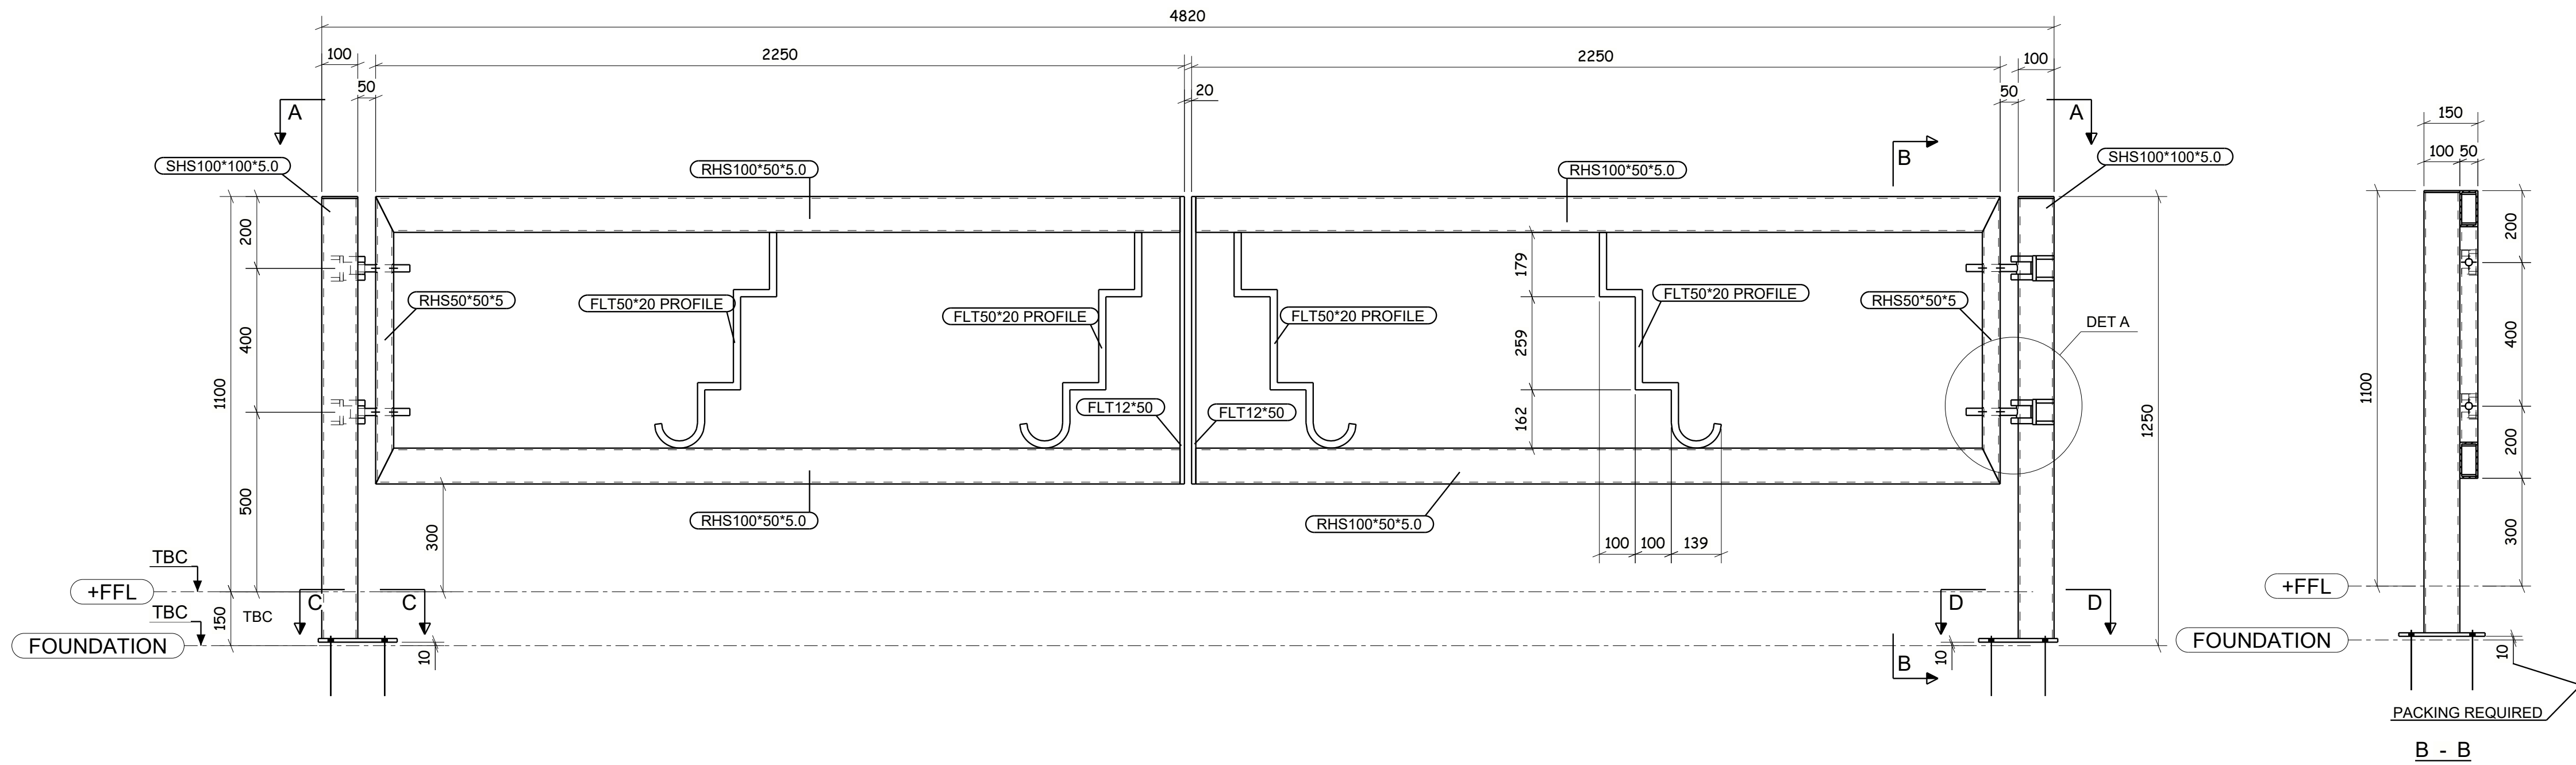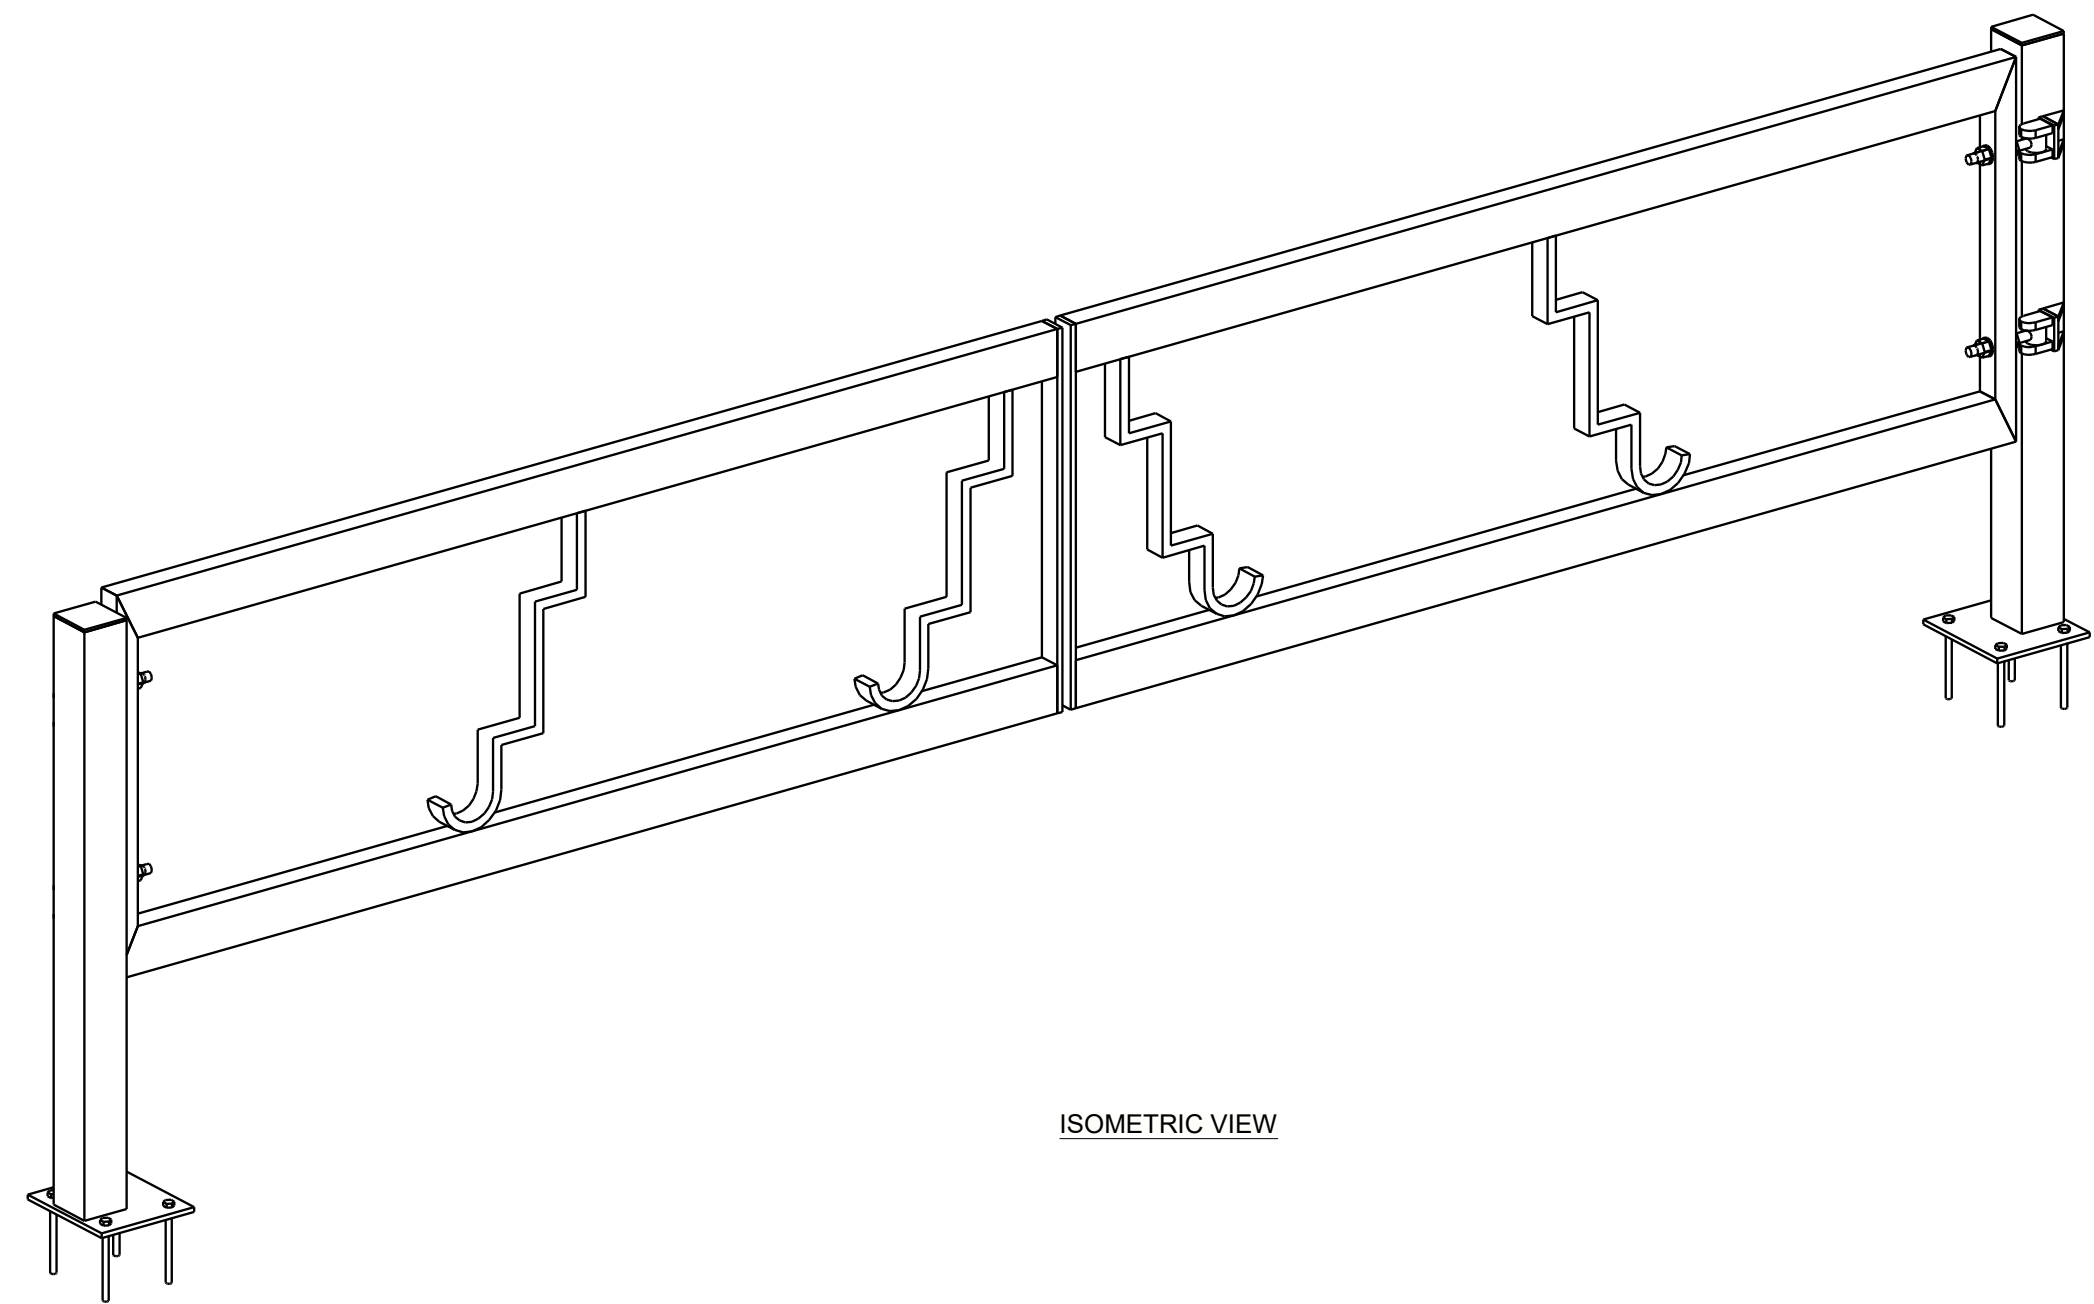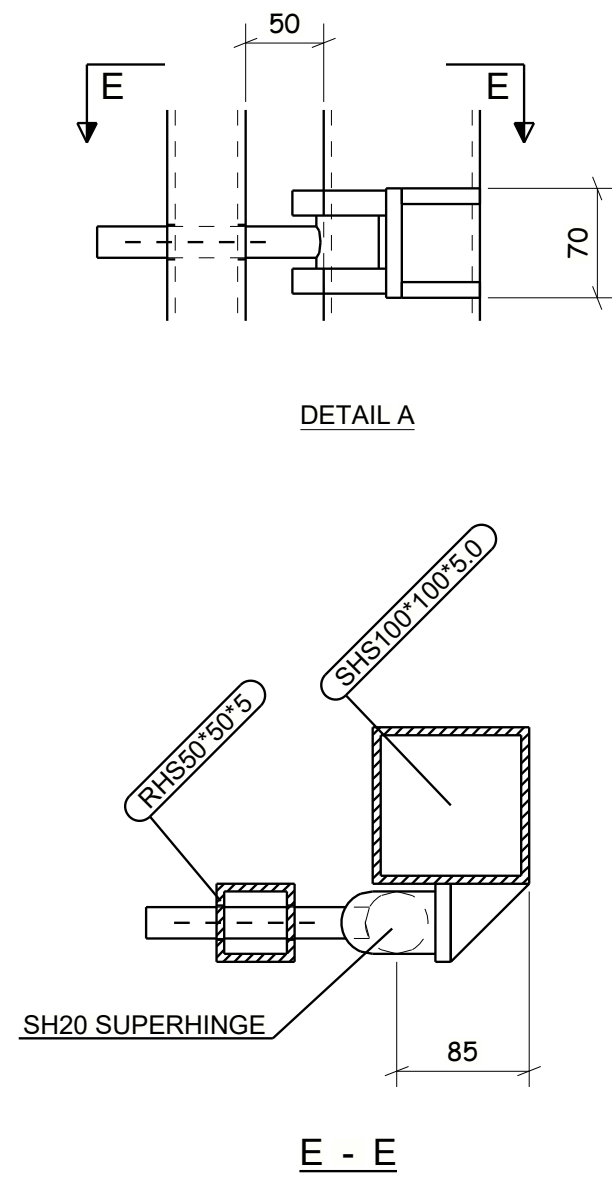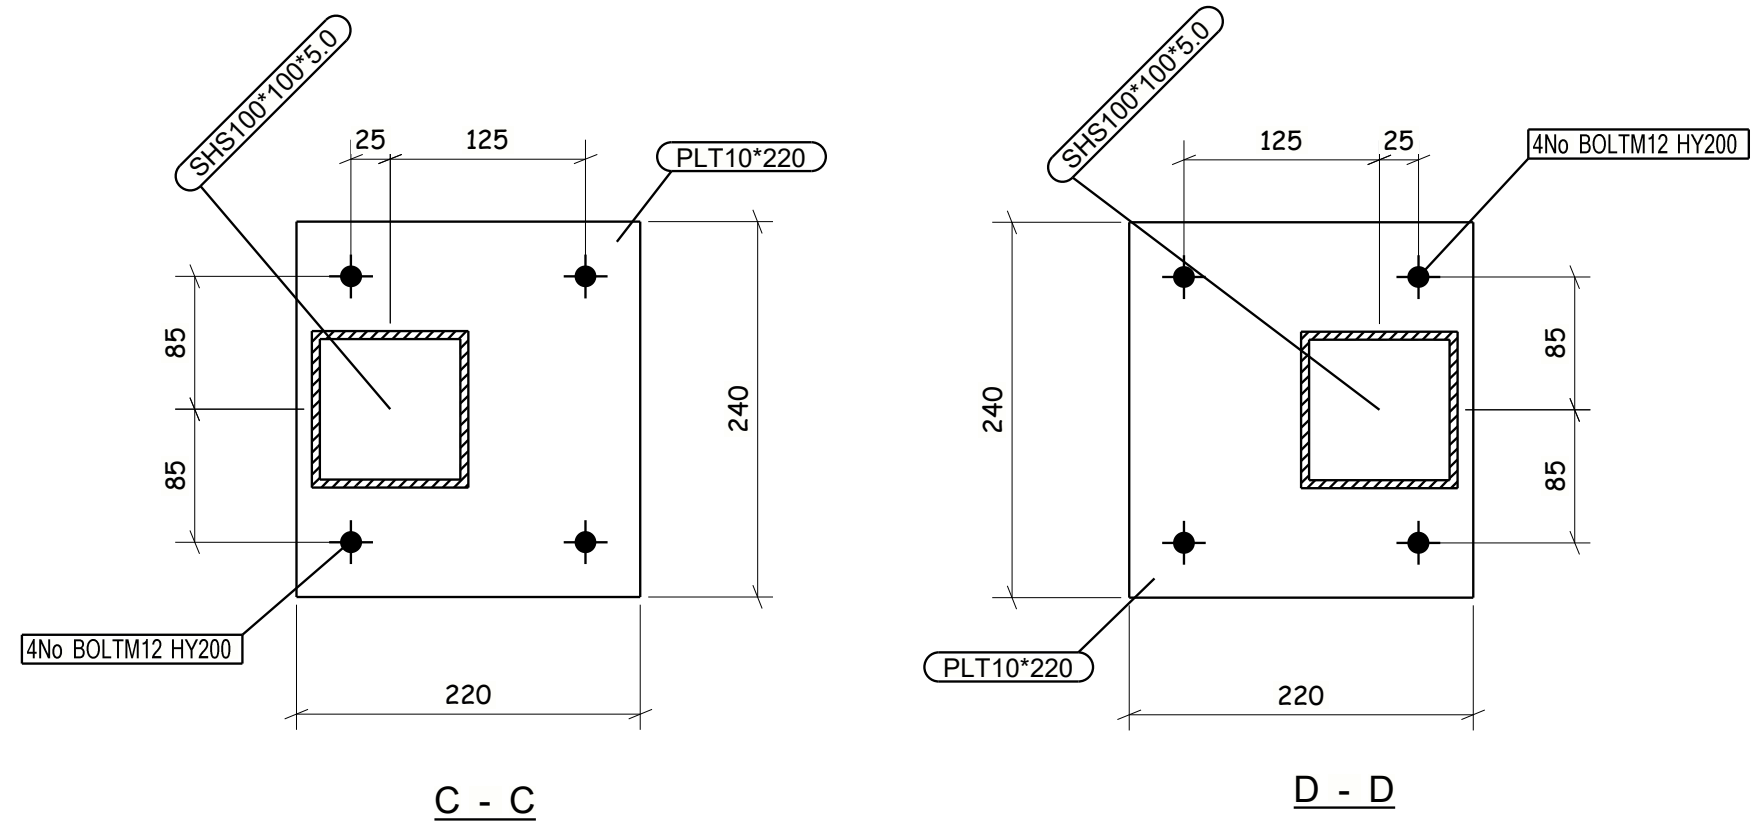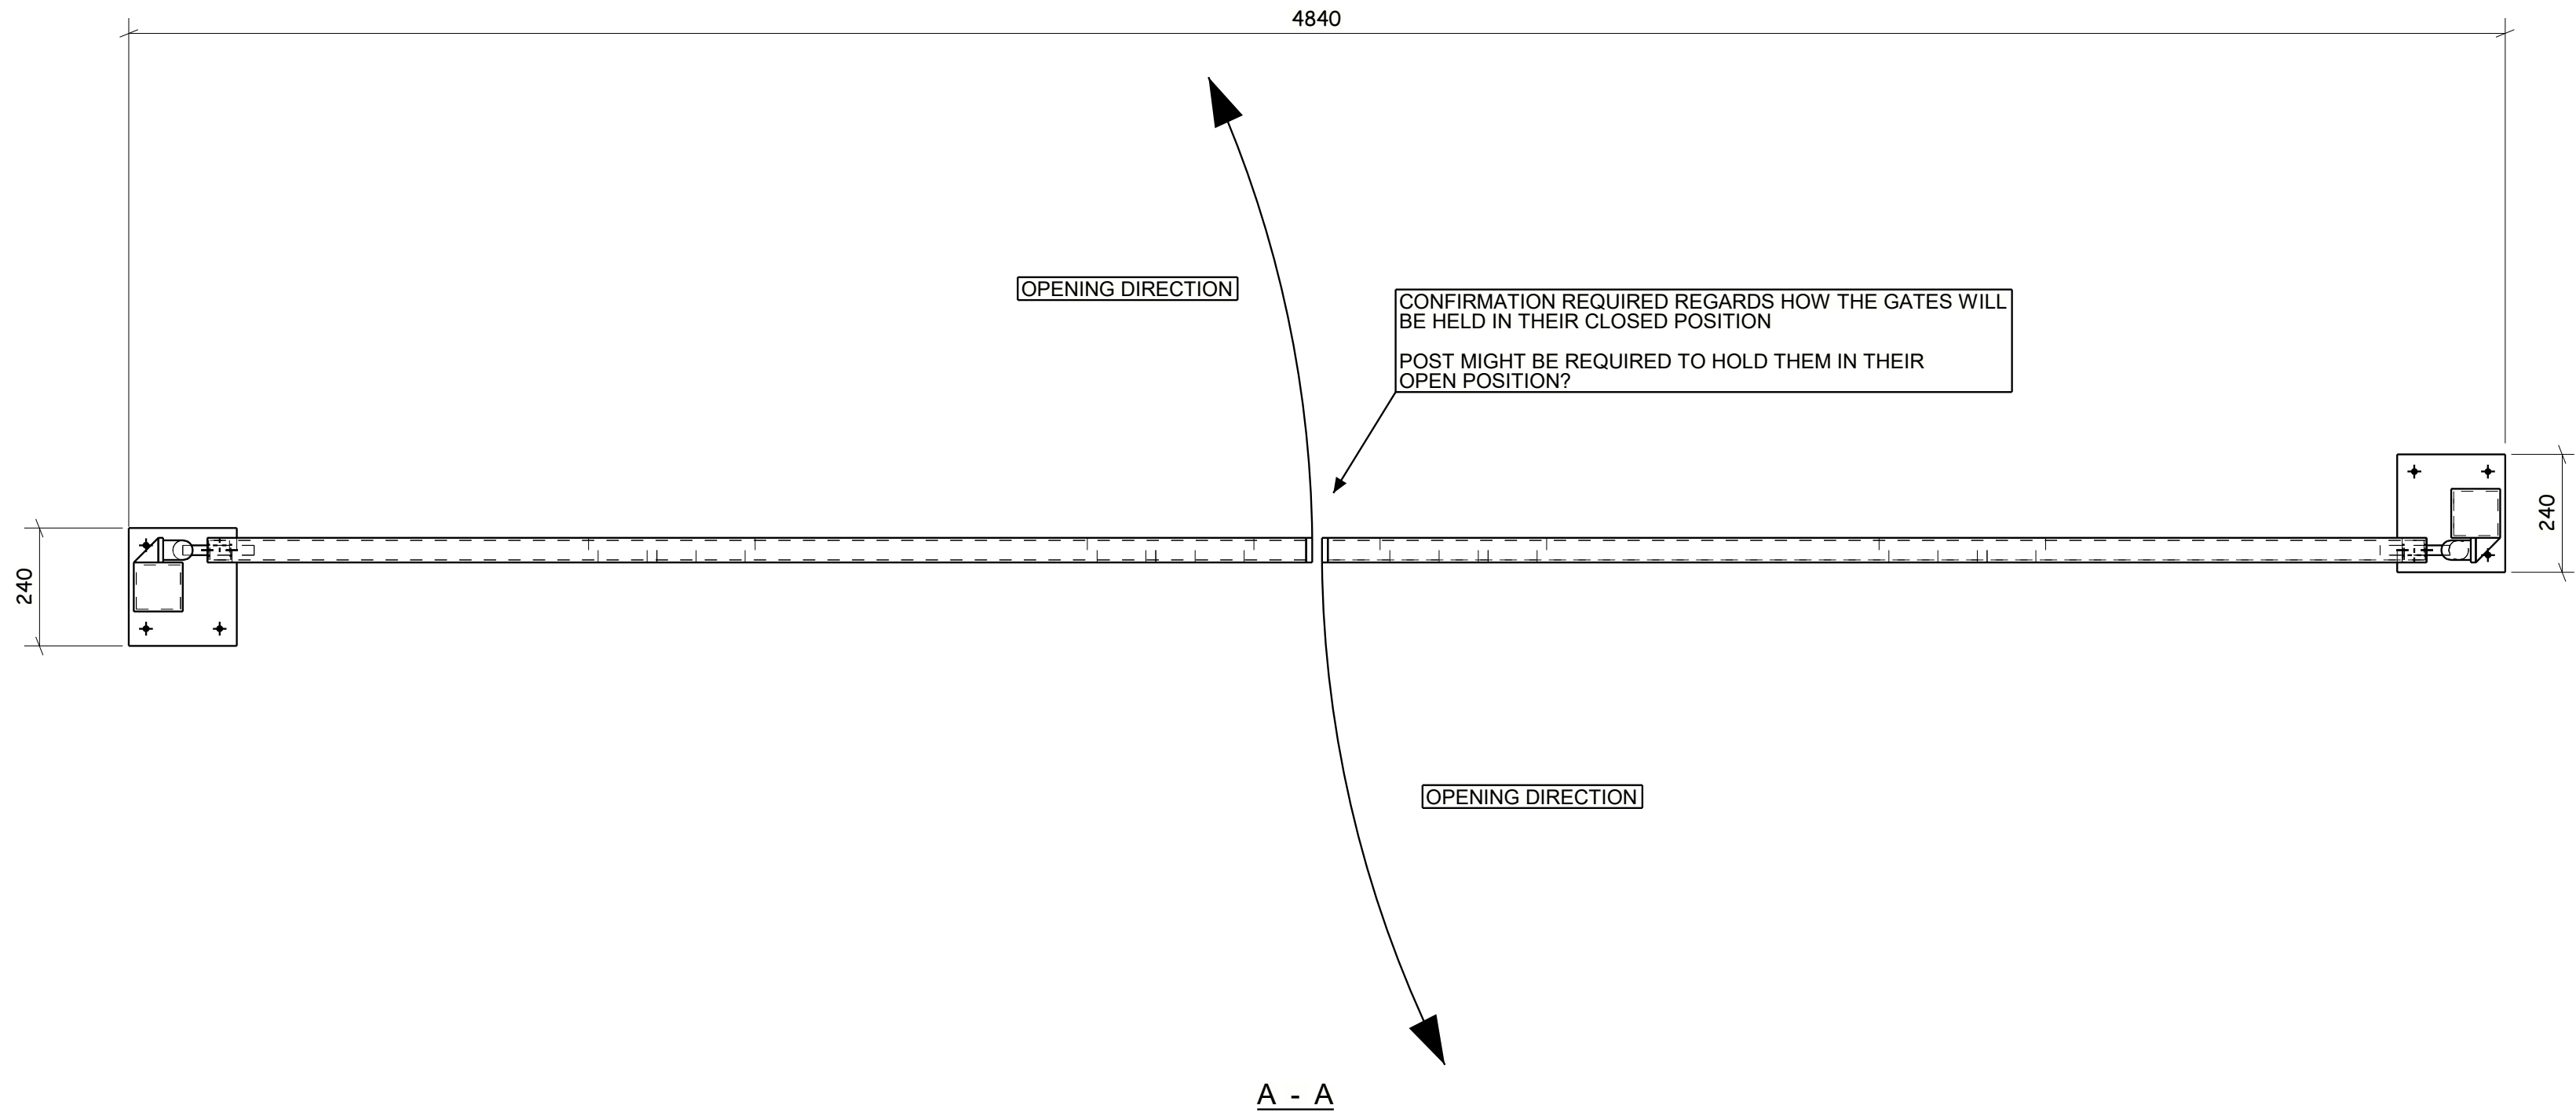

NOTE:
MAIN POST TO BE SHS100*100*5.0
BOTTOM & TOP RAIL TO BE RHS100*50*5.0
GATE SIDE RAIL TO BE RHS50*50*5.0
HINGE TO BE SUPERHINGE SH20
GATE PROFILE TO BE FLT50*20
FINISH RAL7022 GLOSS (TBC)

C01	ISSUED FOR COMMENT	15.06.2022
REV MARK	REVISION DESCRIPTION	REVISION DATE
DRAWING TITLE	GATE 1 TOWN HALL SQUARE VEHICULAR BARRIER GATE	
CONTRACT	HORNSEY TOWN HALL	
MODELLED BY	LT	DATE 13.06.2022
CONTRACT NO	SEL1142	SCALE 1:5 1:12.5 1:15
DRAWING No	7414-10-009	REVISION No. C01


2. Gate 2 – Town Hall emergency escape and annex cycle store access

Drawing:

- 3670-KDS-TH-ZZ-DR-A-90-1050

Location:

- Town Hall emergency escape and annex cycle store access

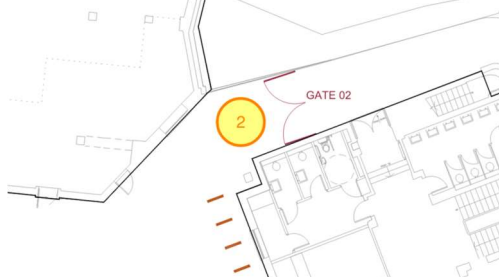


Finish:

- RAL 7016 – anthracite grey

Photograph:

Shown for context only, gate design to change to remove mesh as per drawing



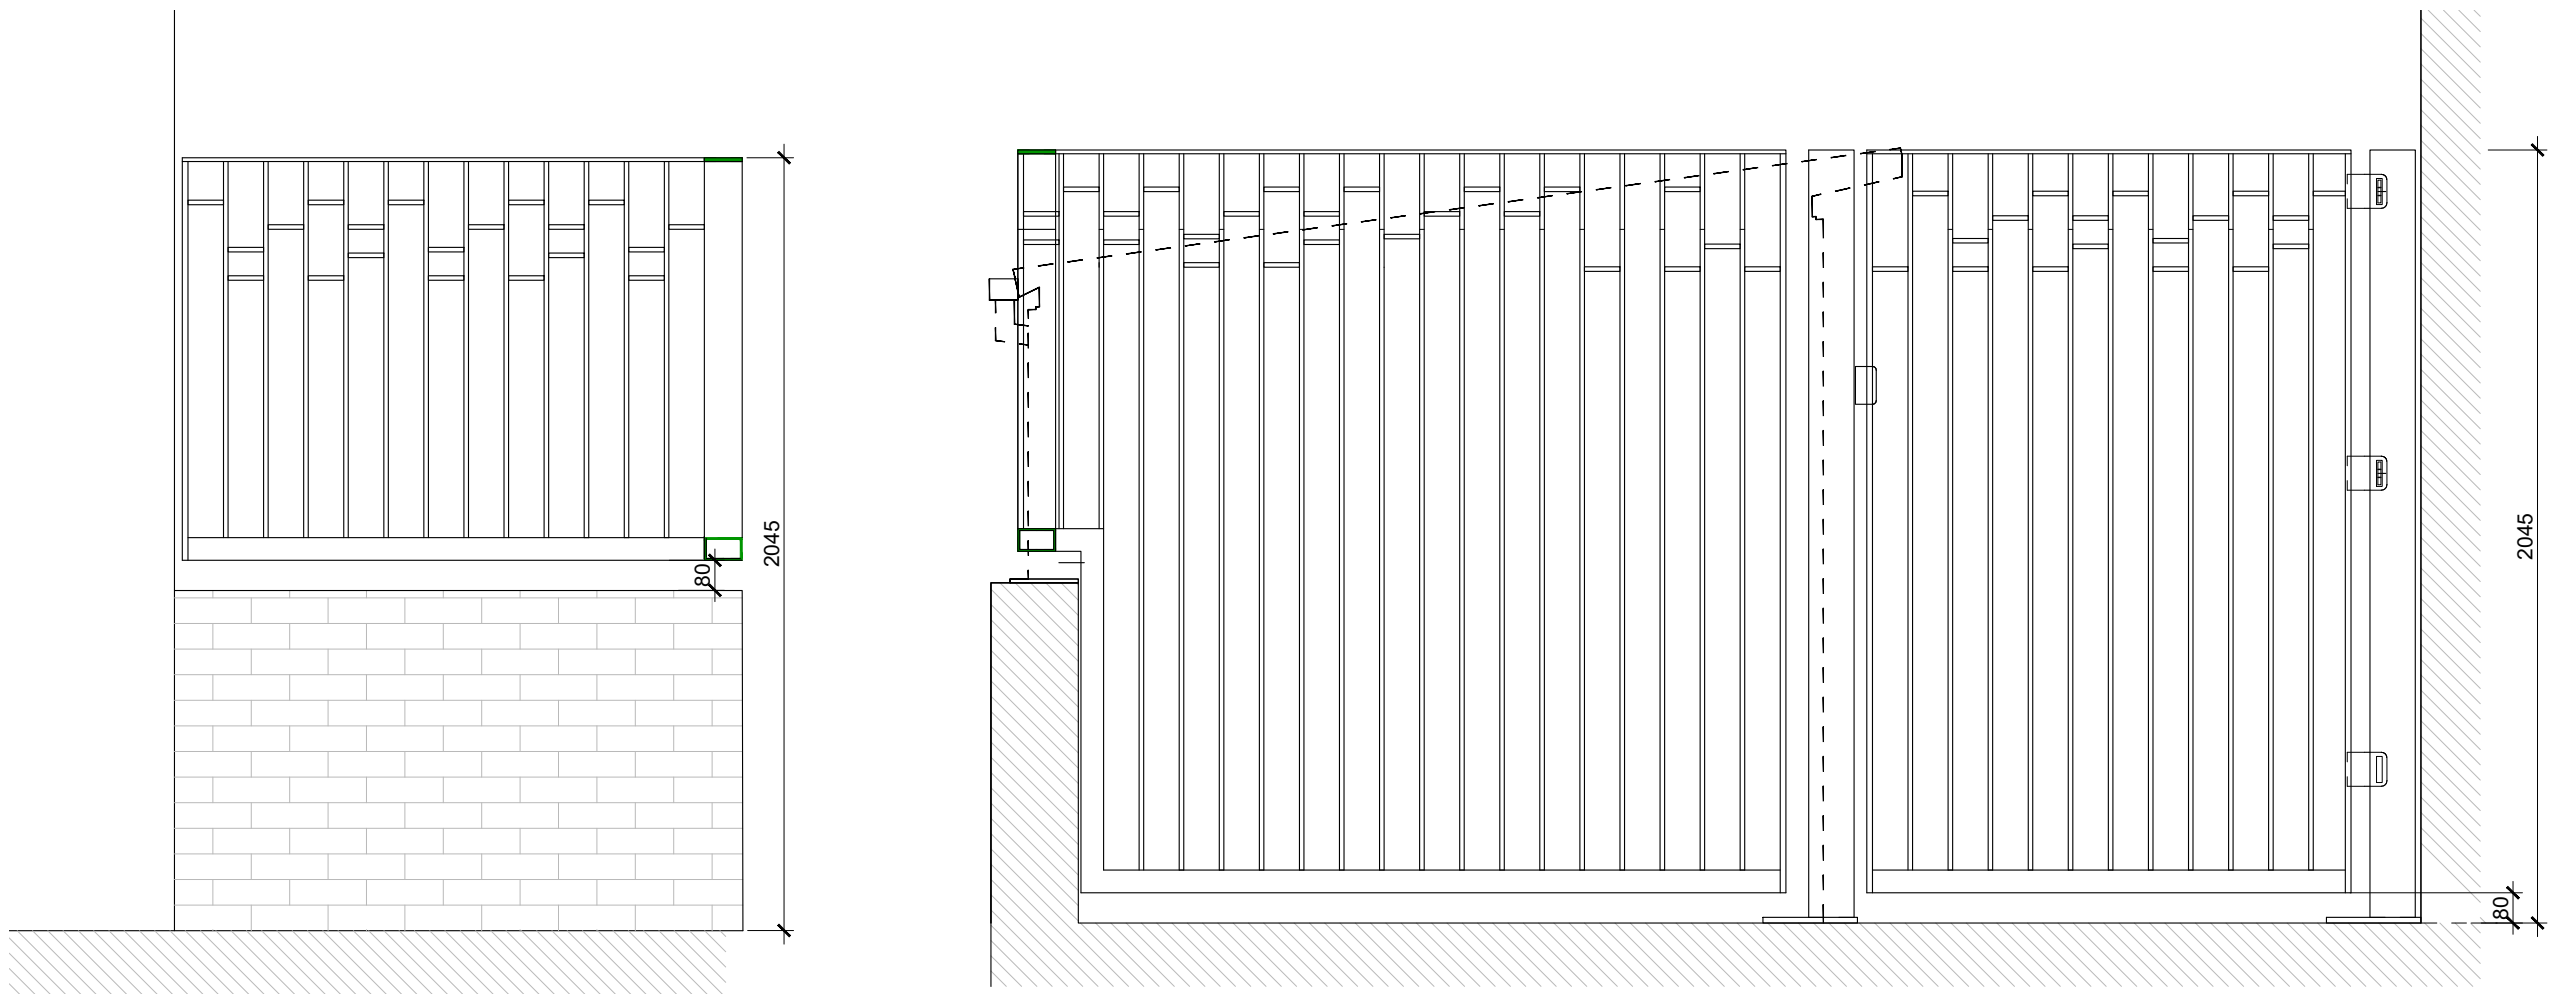


GATE DESIGN CARRIED THROUGH
TO DWARF WALL


B-B GATE/FENCE ELEVATION

ACCESS CONTROL GATE - POWDER
COATED STEEL. RHS OPENING
ONLY FOR ESCAPE AND ACCESS TO
BICYCLE STORAGE


A-A GATE/FENCE ELEVATION

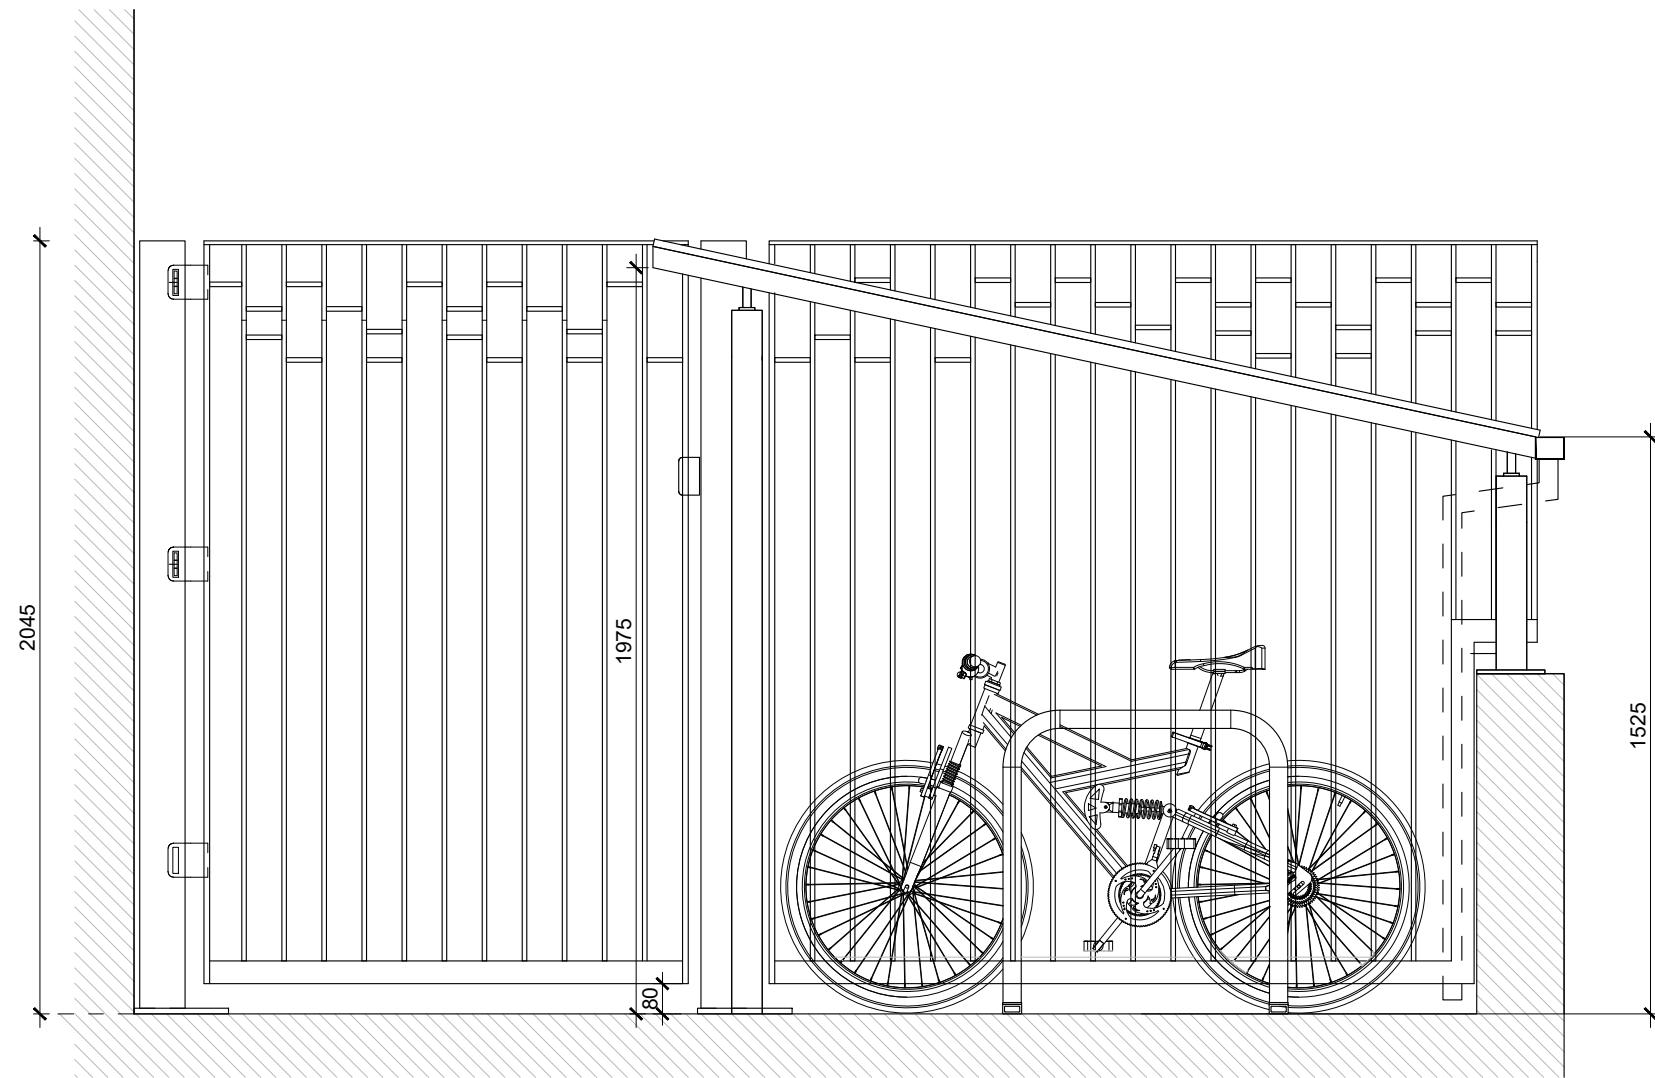

C-C CYCLE STORE SECTION

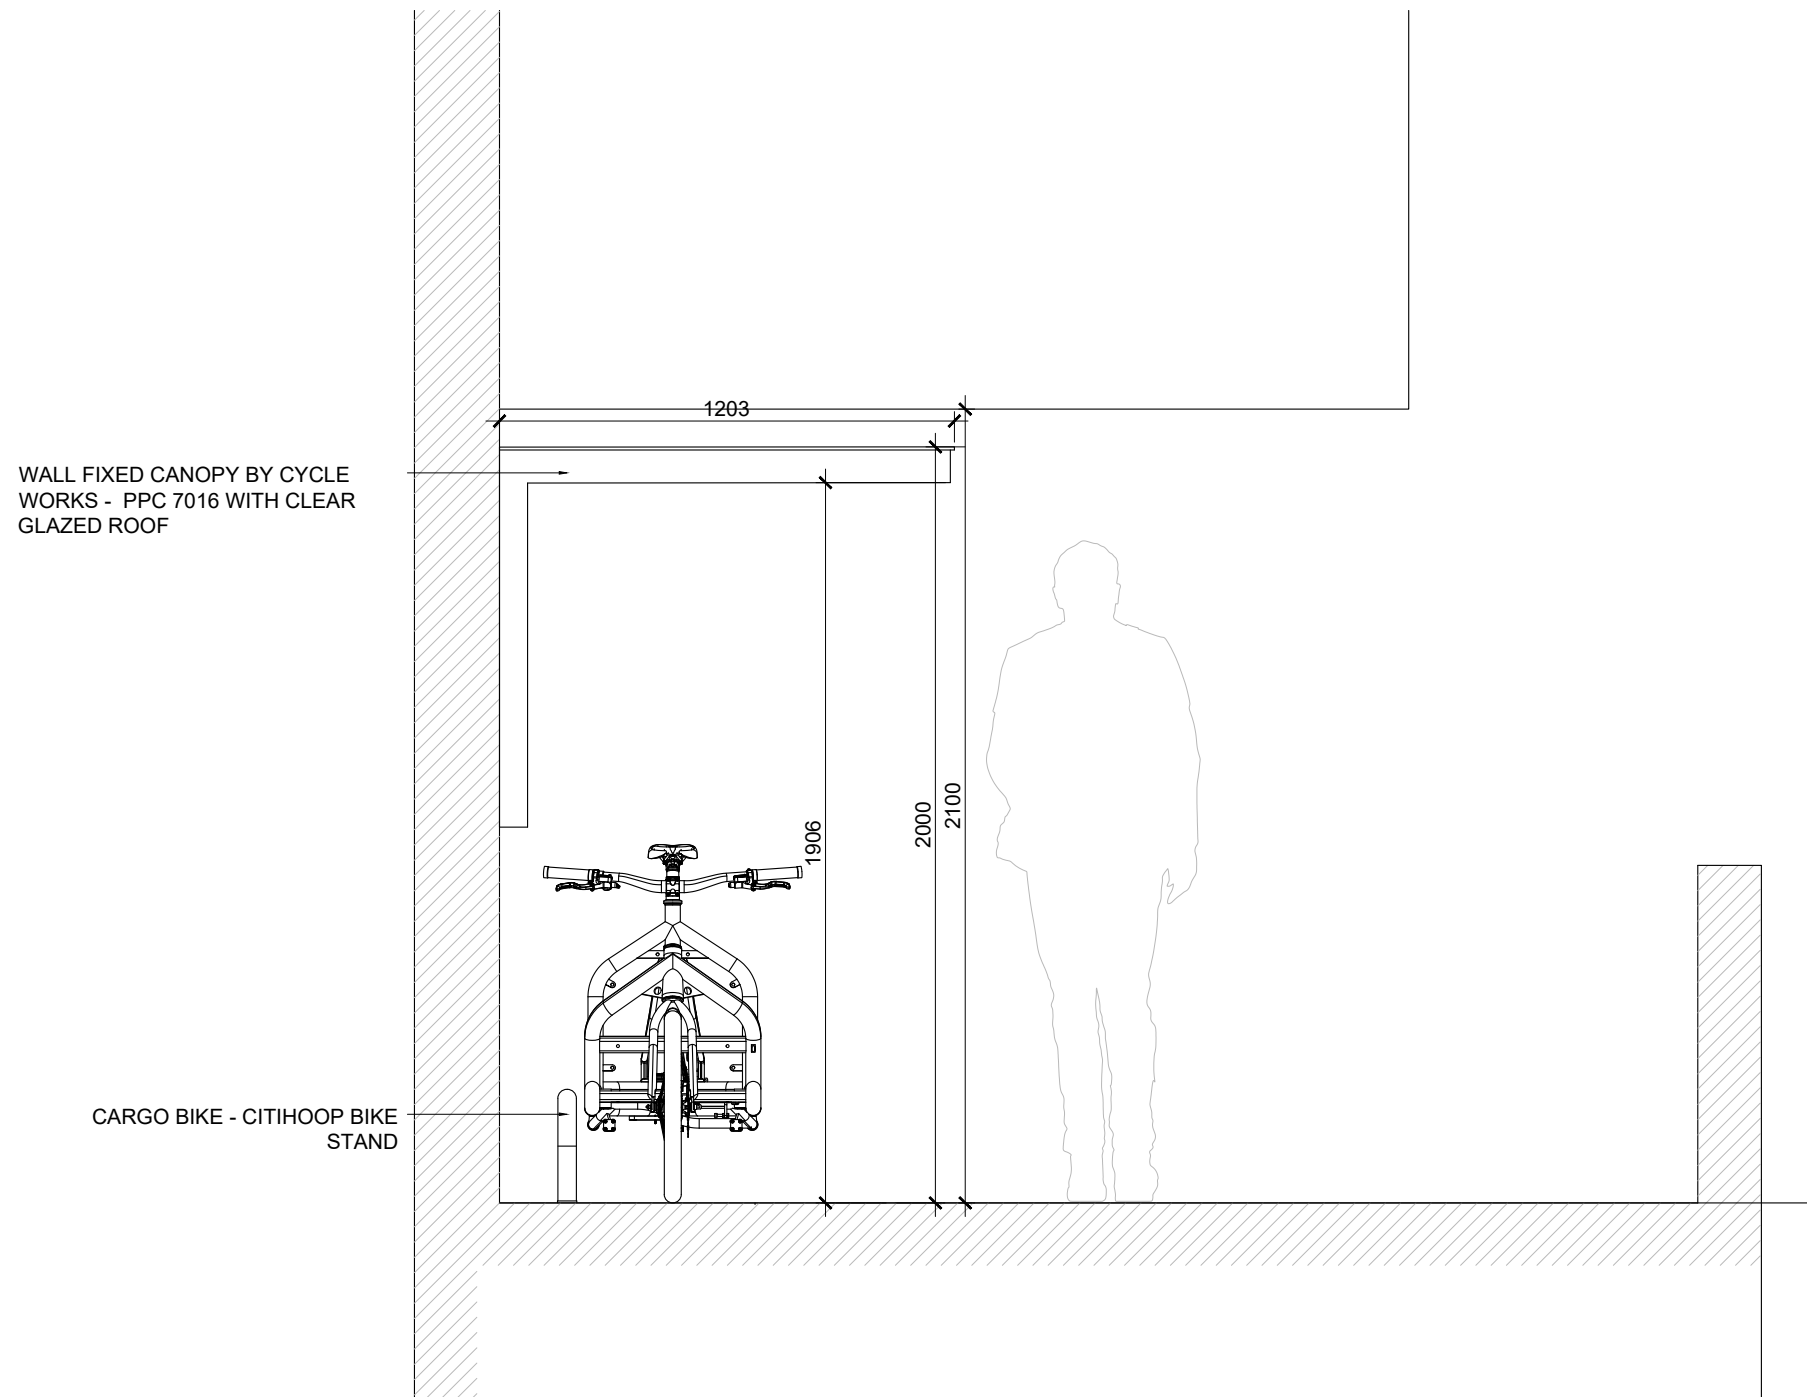

D-D CYCLE STORE SECITON

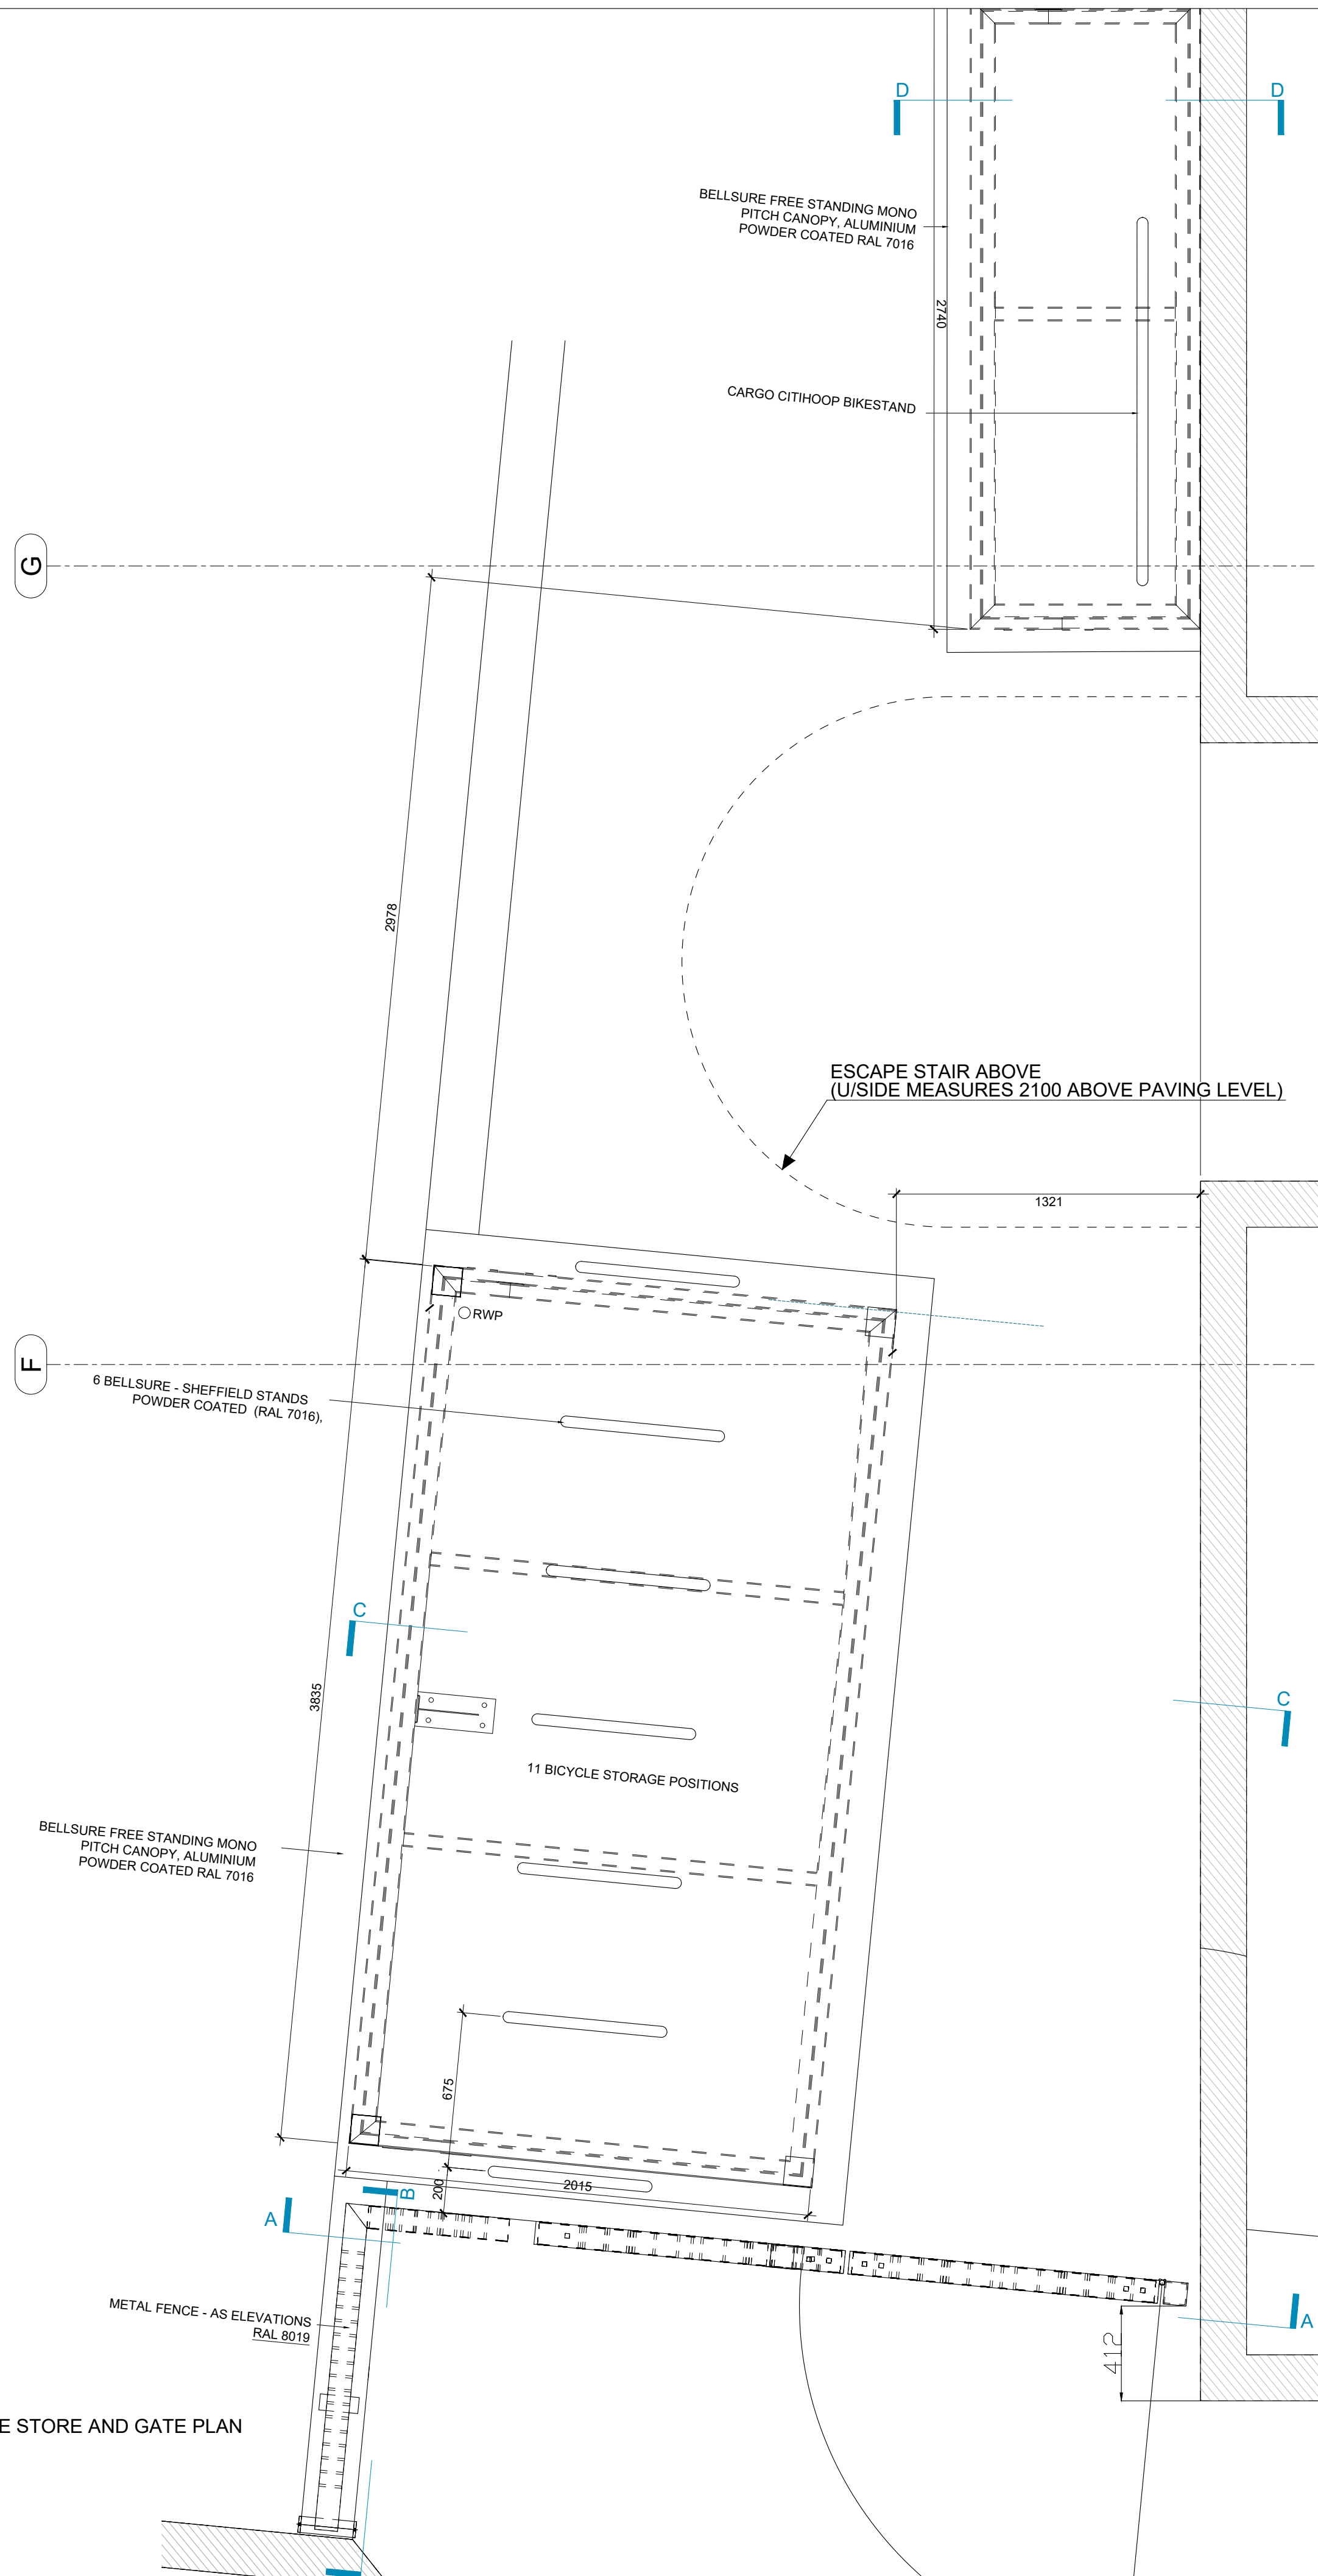

CYCLE STORE AND GATE PLAN

© Longlane Architects Ltd
No part of this drawing may be reproduced without written consent.
All contractors must visit site and be responsible for taking and checking all
dimensions relating to this work.
Do not scale from this drawing.

REVISION NOTES

AB	15.07.24	RB	FINAL CONSTRUCTION ISSUE
FC	31.01.25	PS	GATE UPDATED TO MATCH AS BUILT STATUS. FINAL CONSTRUCTION ISSUE



ARDMORE CONSTRUCTION LTD
6 WHARF STUDIOS,
28 WHARF ROAD,
LONDON, N1 7GR
TEL: 0208-344 0300
www.ardmoregroup.co.uk



Longlane Architects
5 Tanner Street
London, SE1 3LE
office@longlanearchitects.co.uk

FINAL CONSTRUCTION

PROJECT
HORNSEY TOWN HALL
TOWN HALL

DRAWING TITLE
AFFORDABLE CYCLE STORAGE
AND GATE

SCALE
1:20 @ A1

DRAWING NUMBER
3670-KDS-TH-ZZ-DR-A-90-1050

FC


3. Gate 3 – Library access

Drawing:

- 7414-10-008

Location:

- Town Hall Gardens, access to library

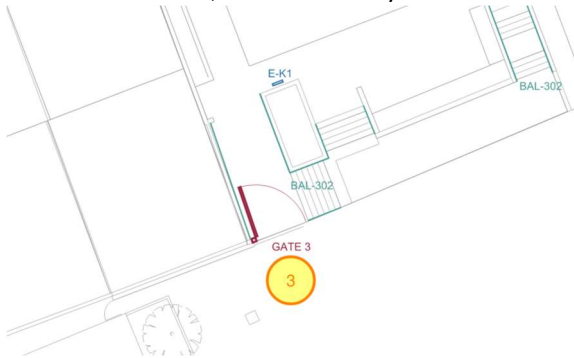


Finish:






- RAL 7016 – anthracite grey

Photograph:

Shown for context only, gate design to change to remove mesh as per drawing

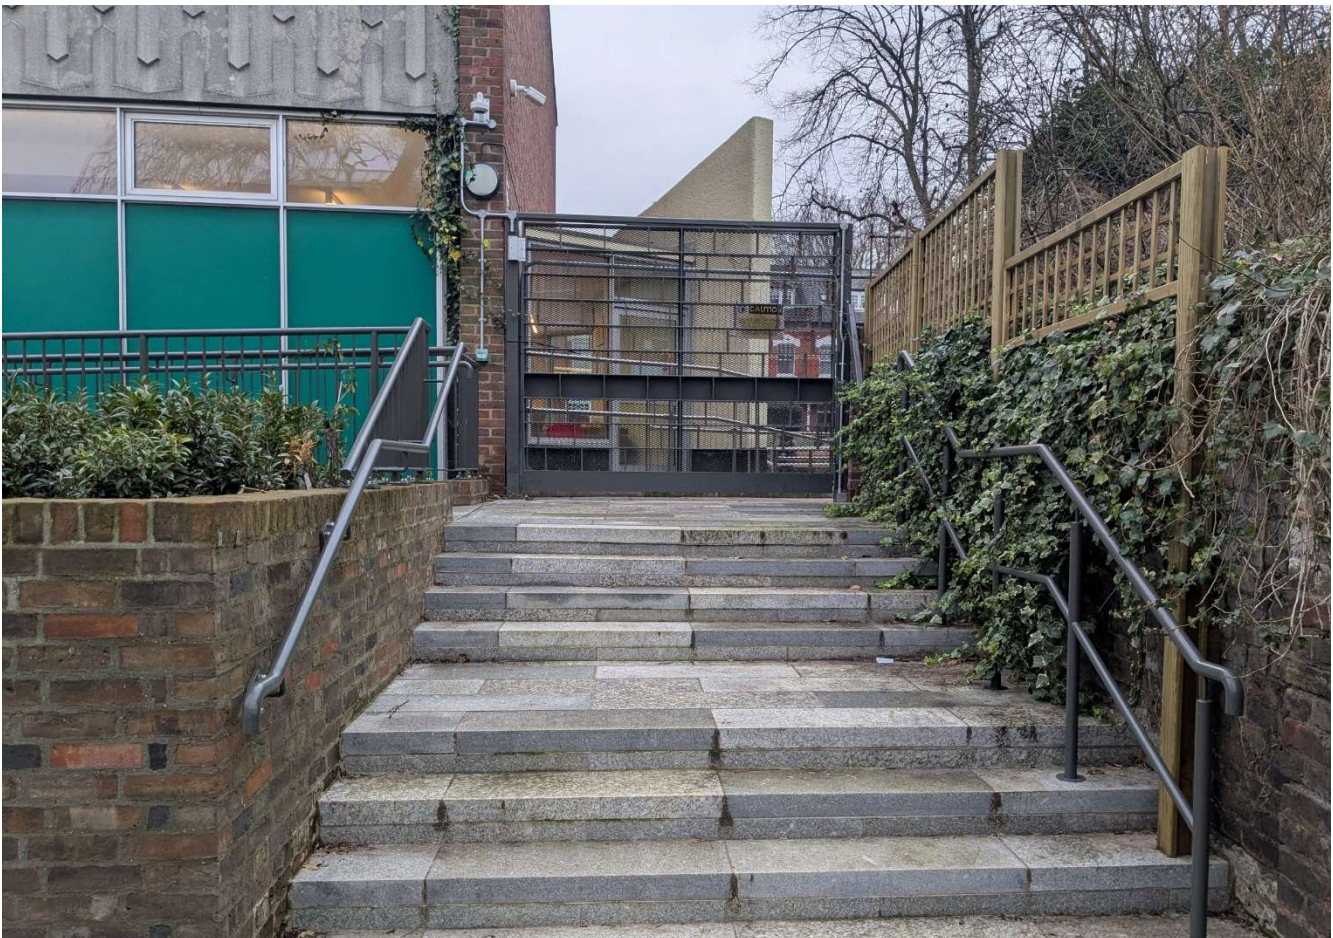

ANY AUTOMATION, MAG LOCK OR CLOSER TO BE SUPPLIED BY OTHERS

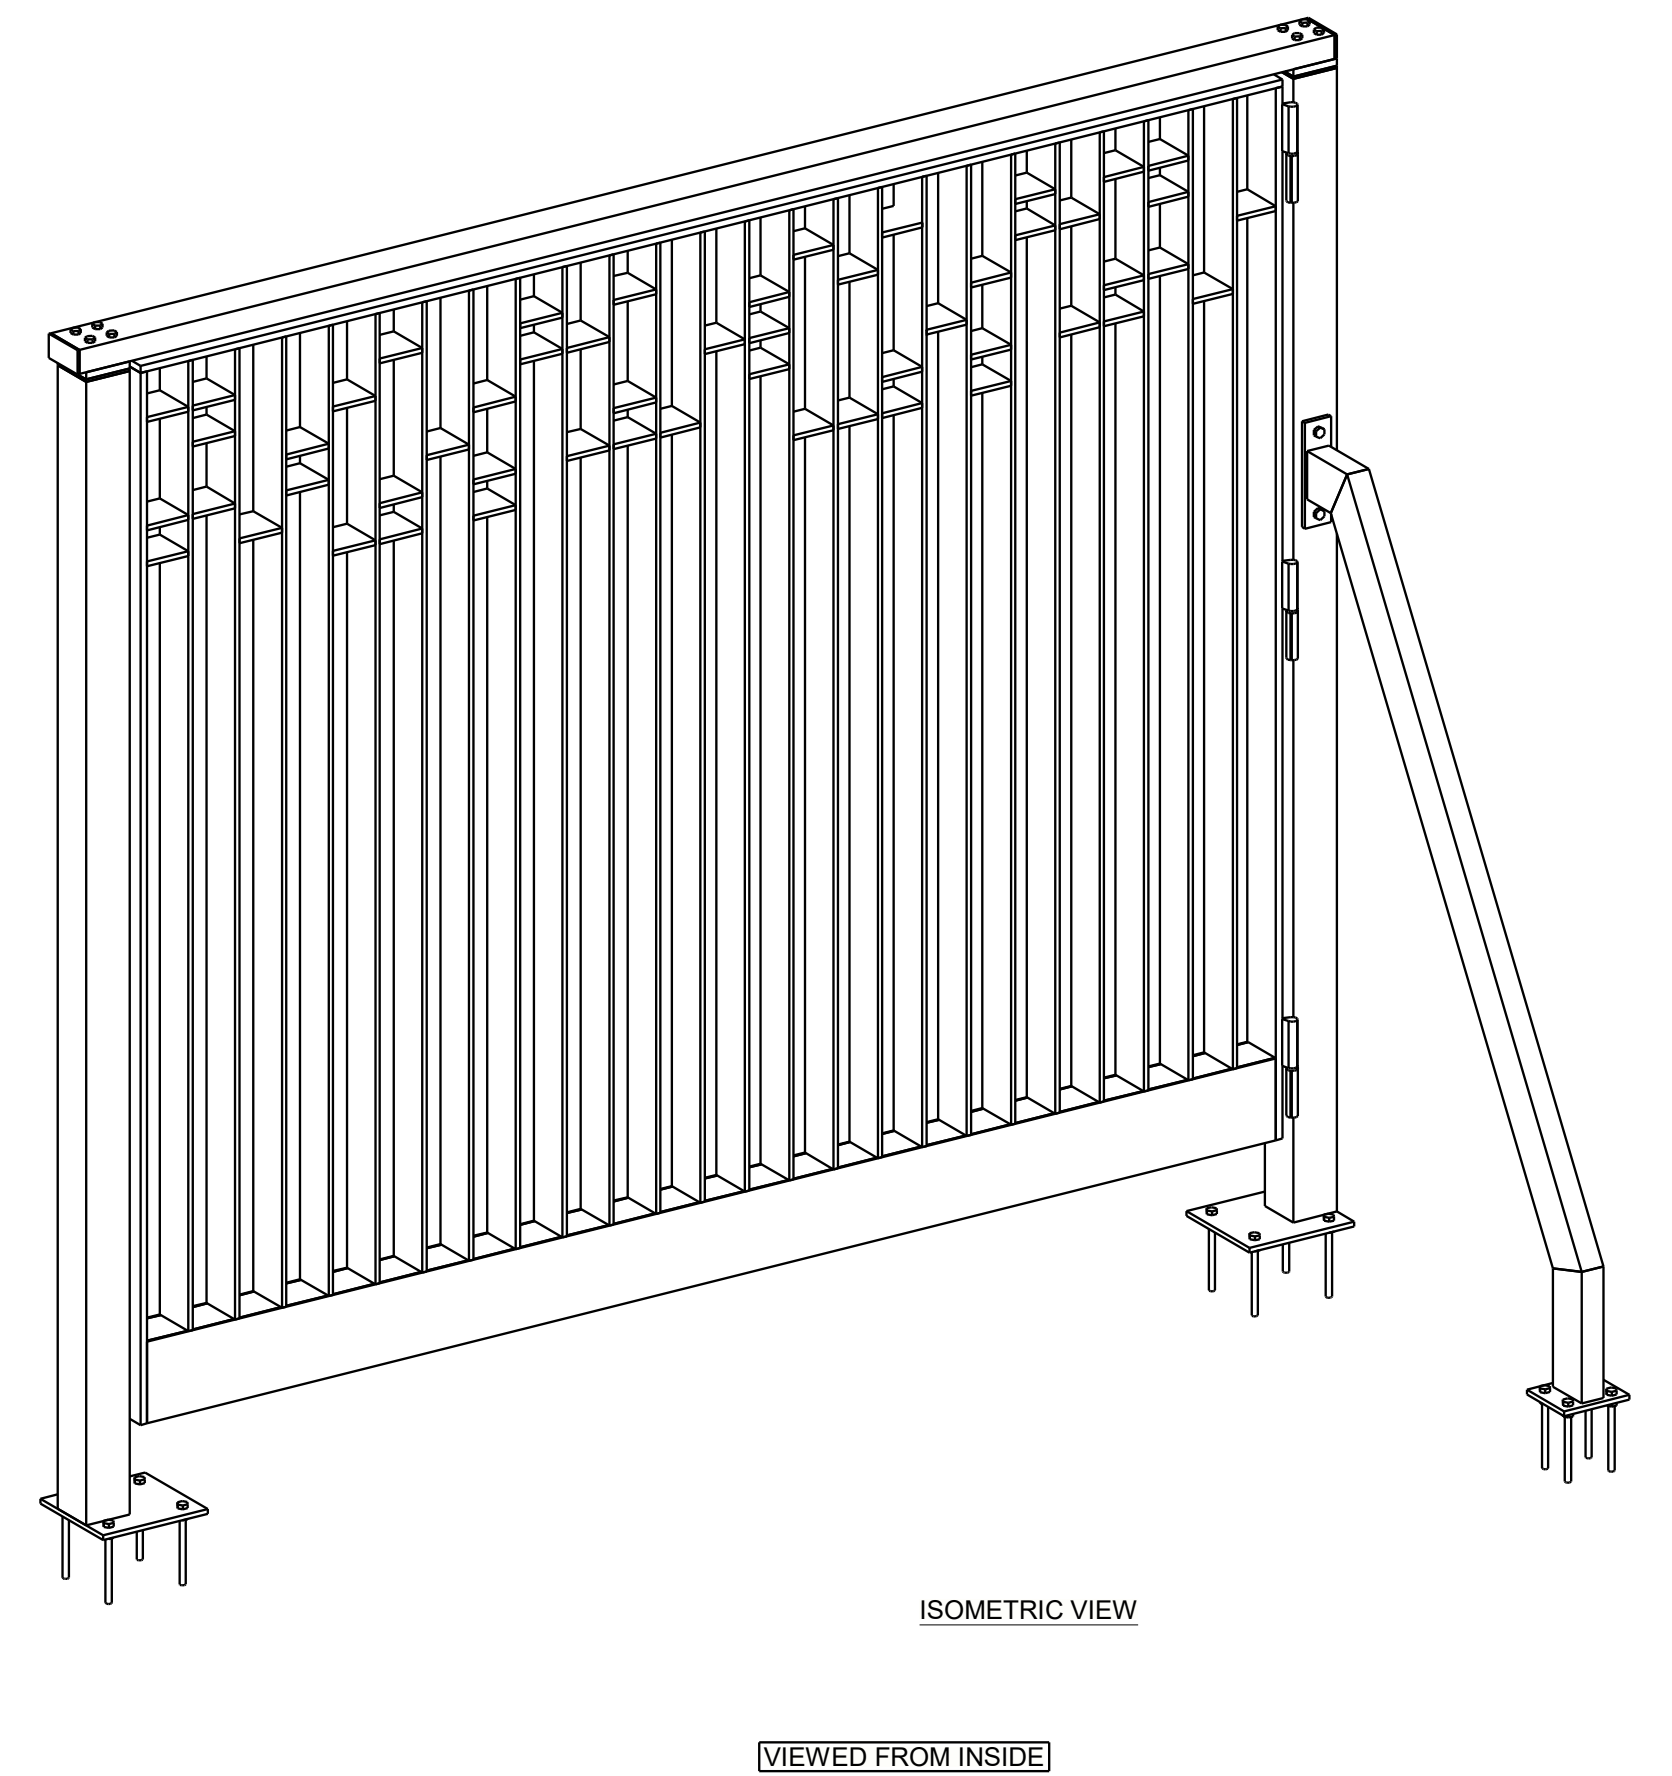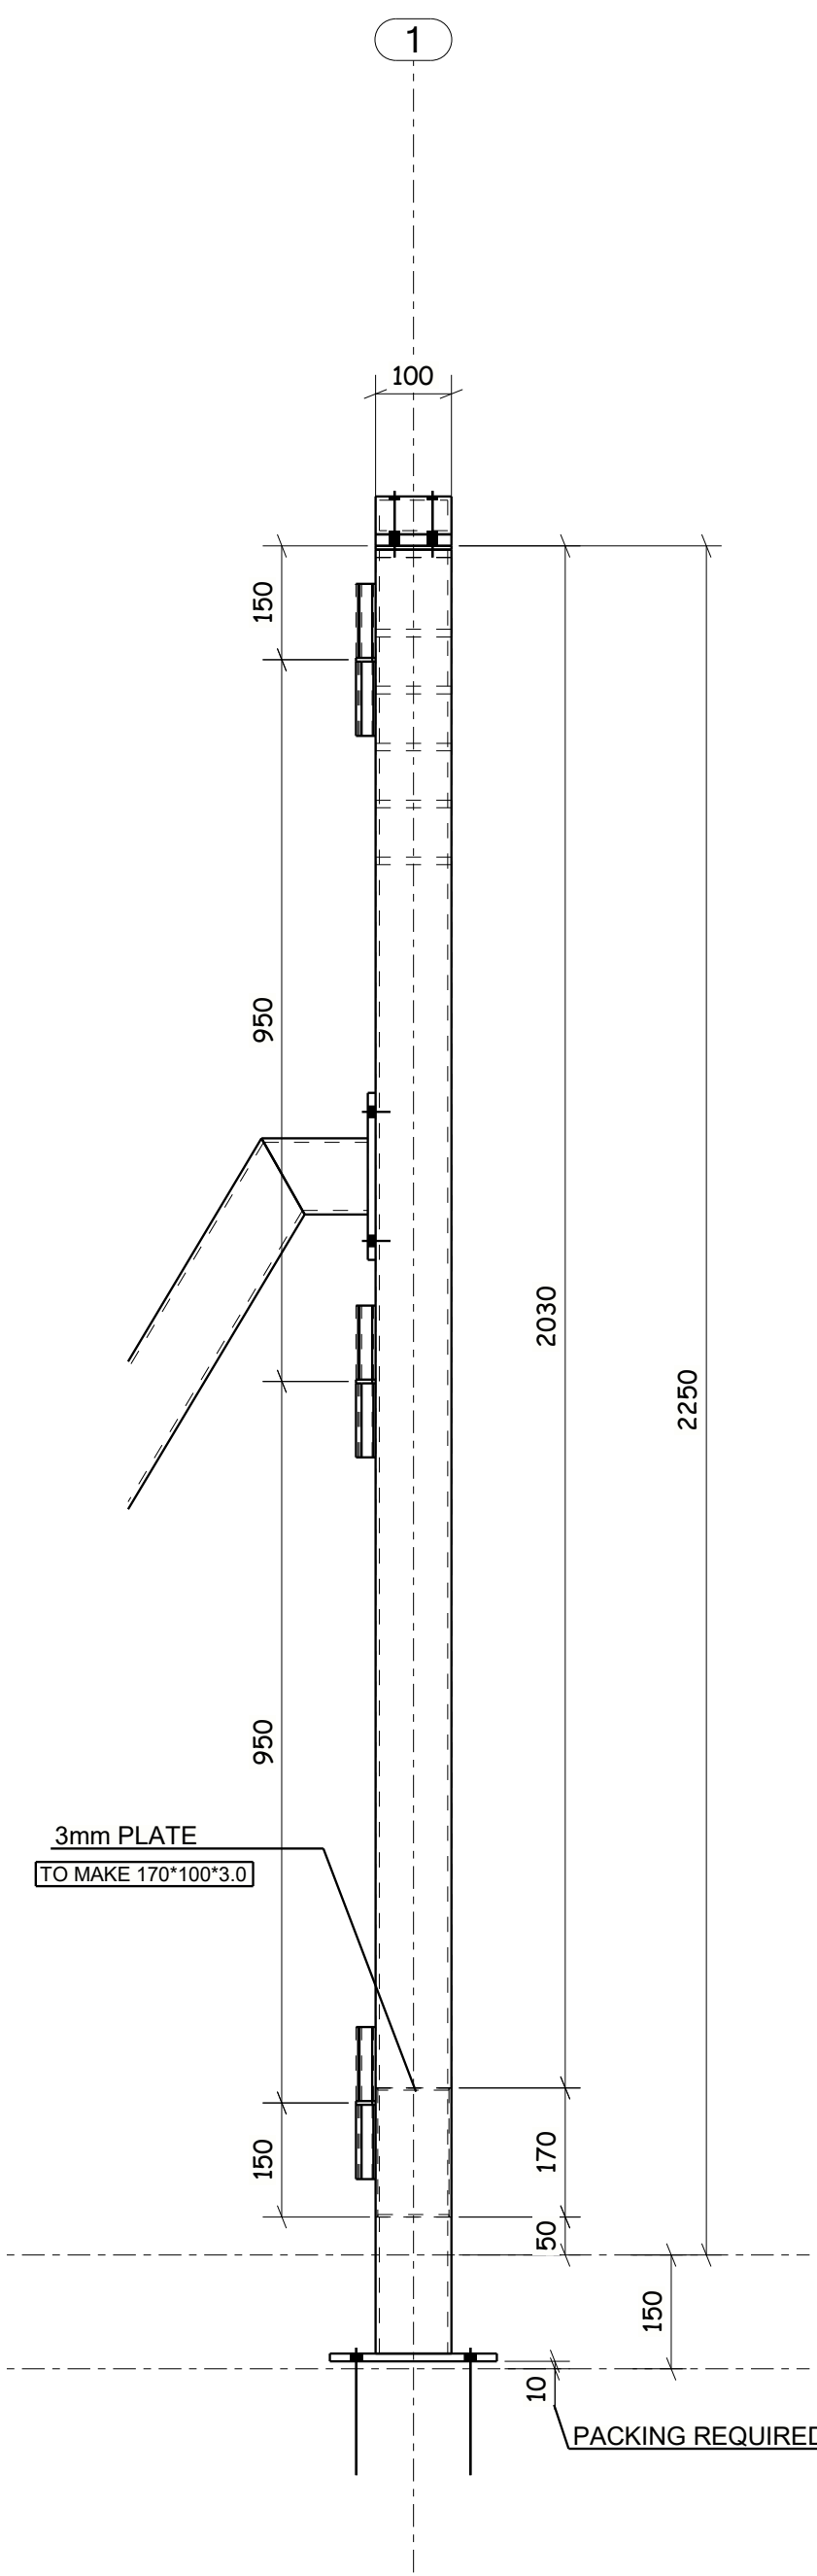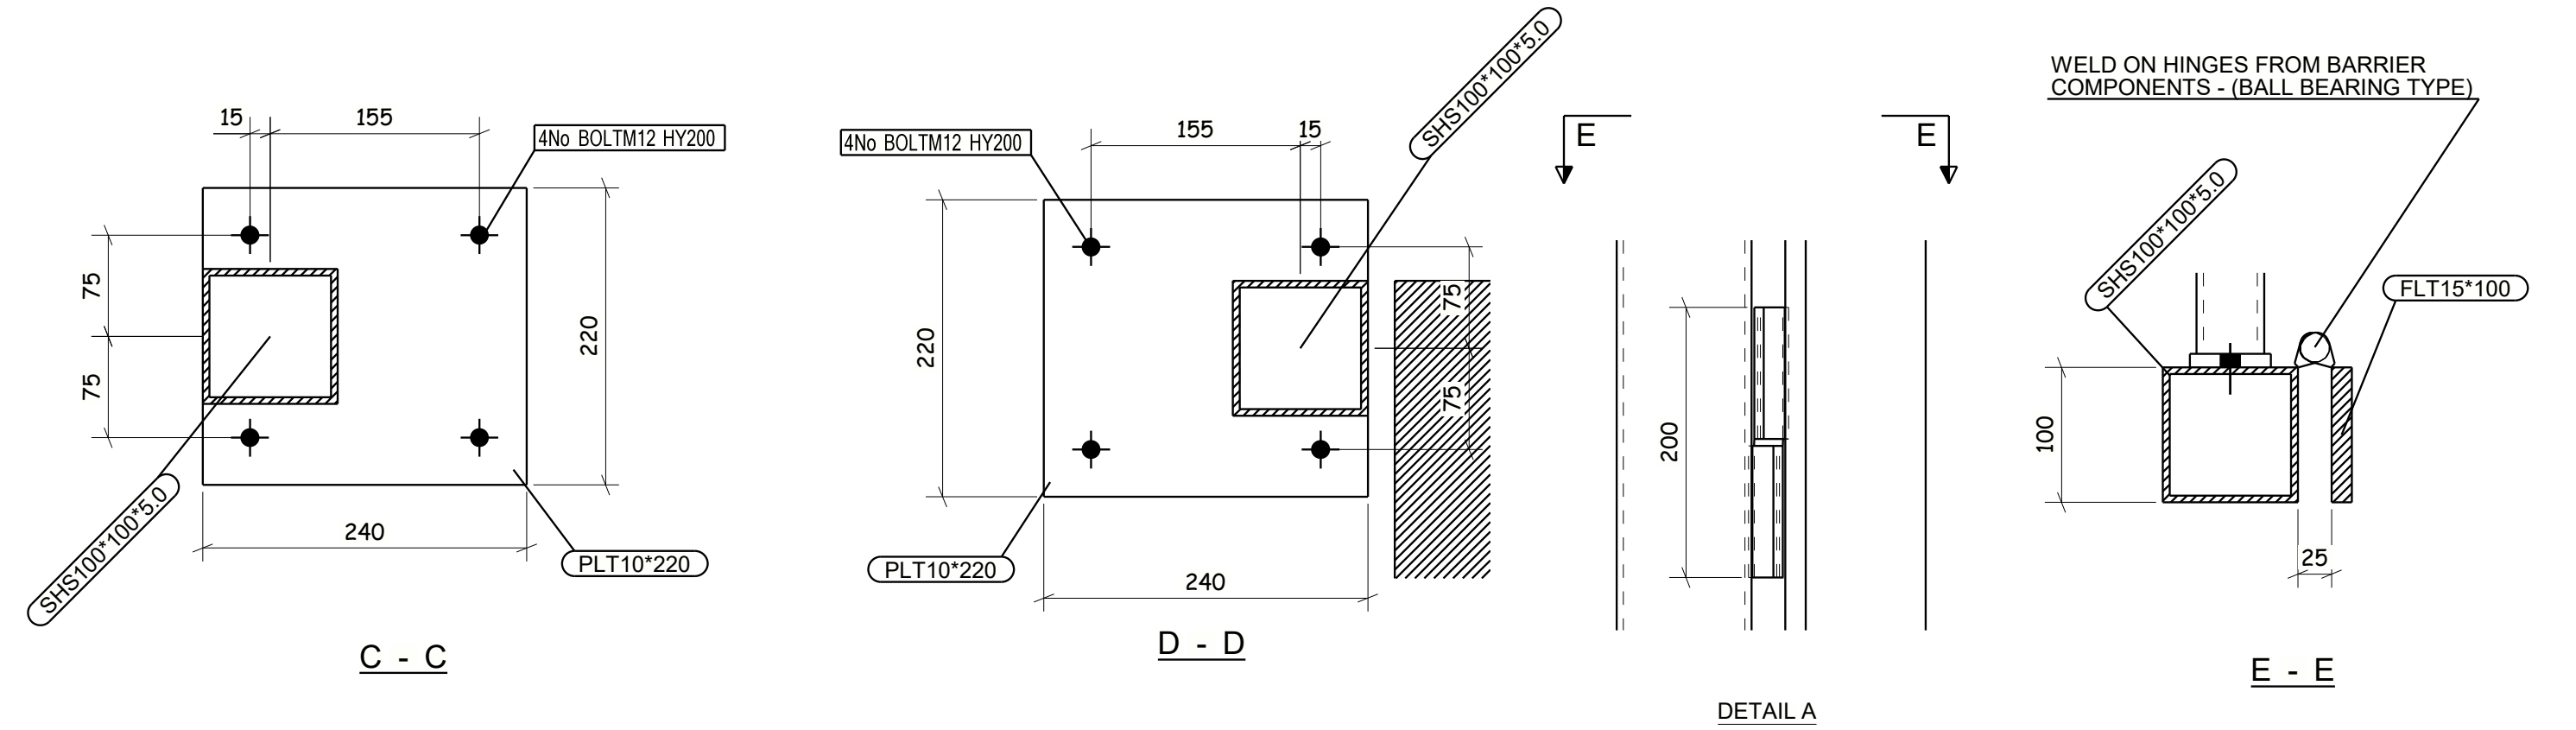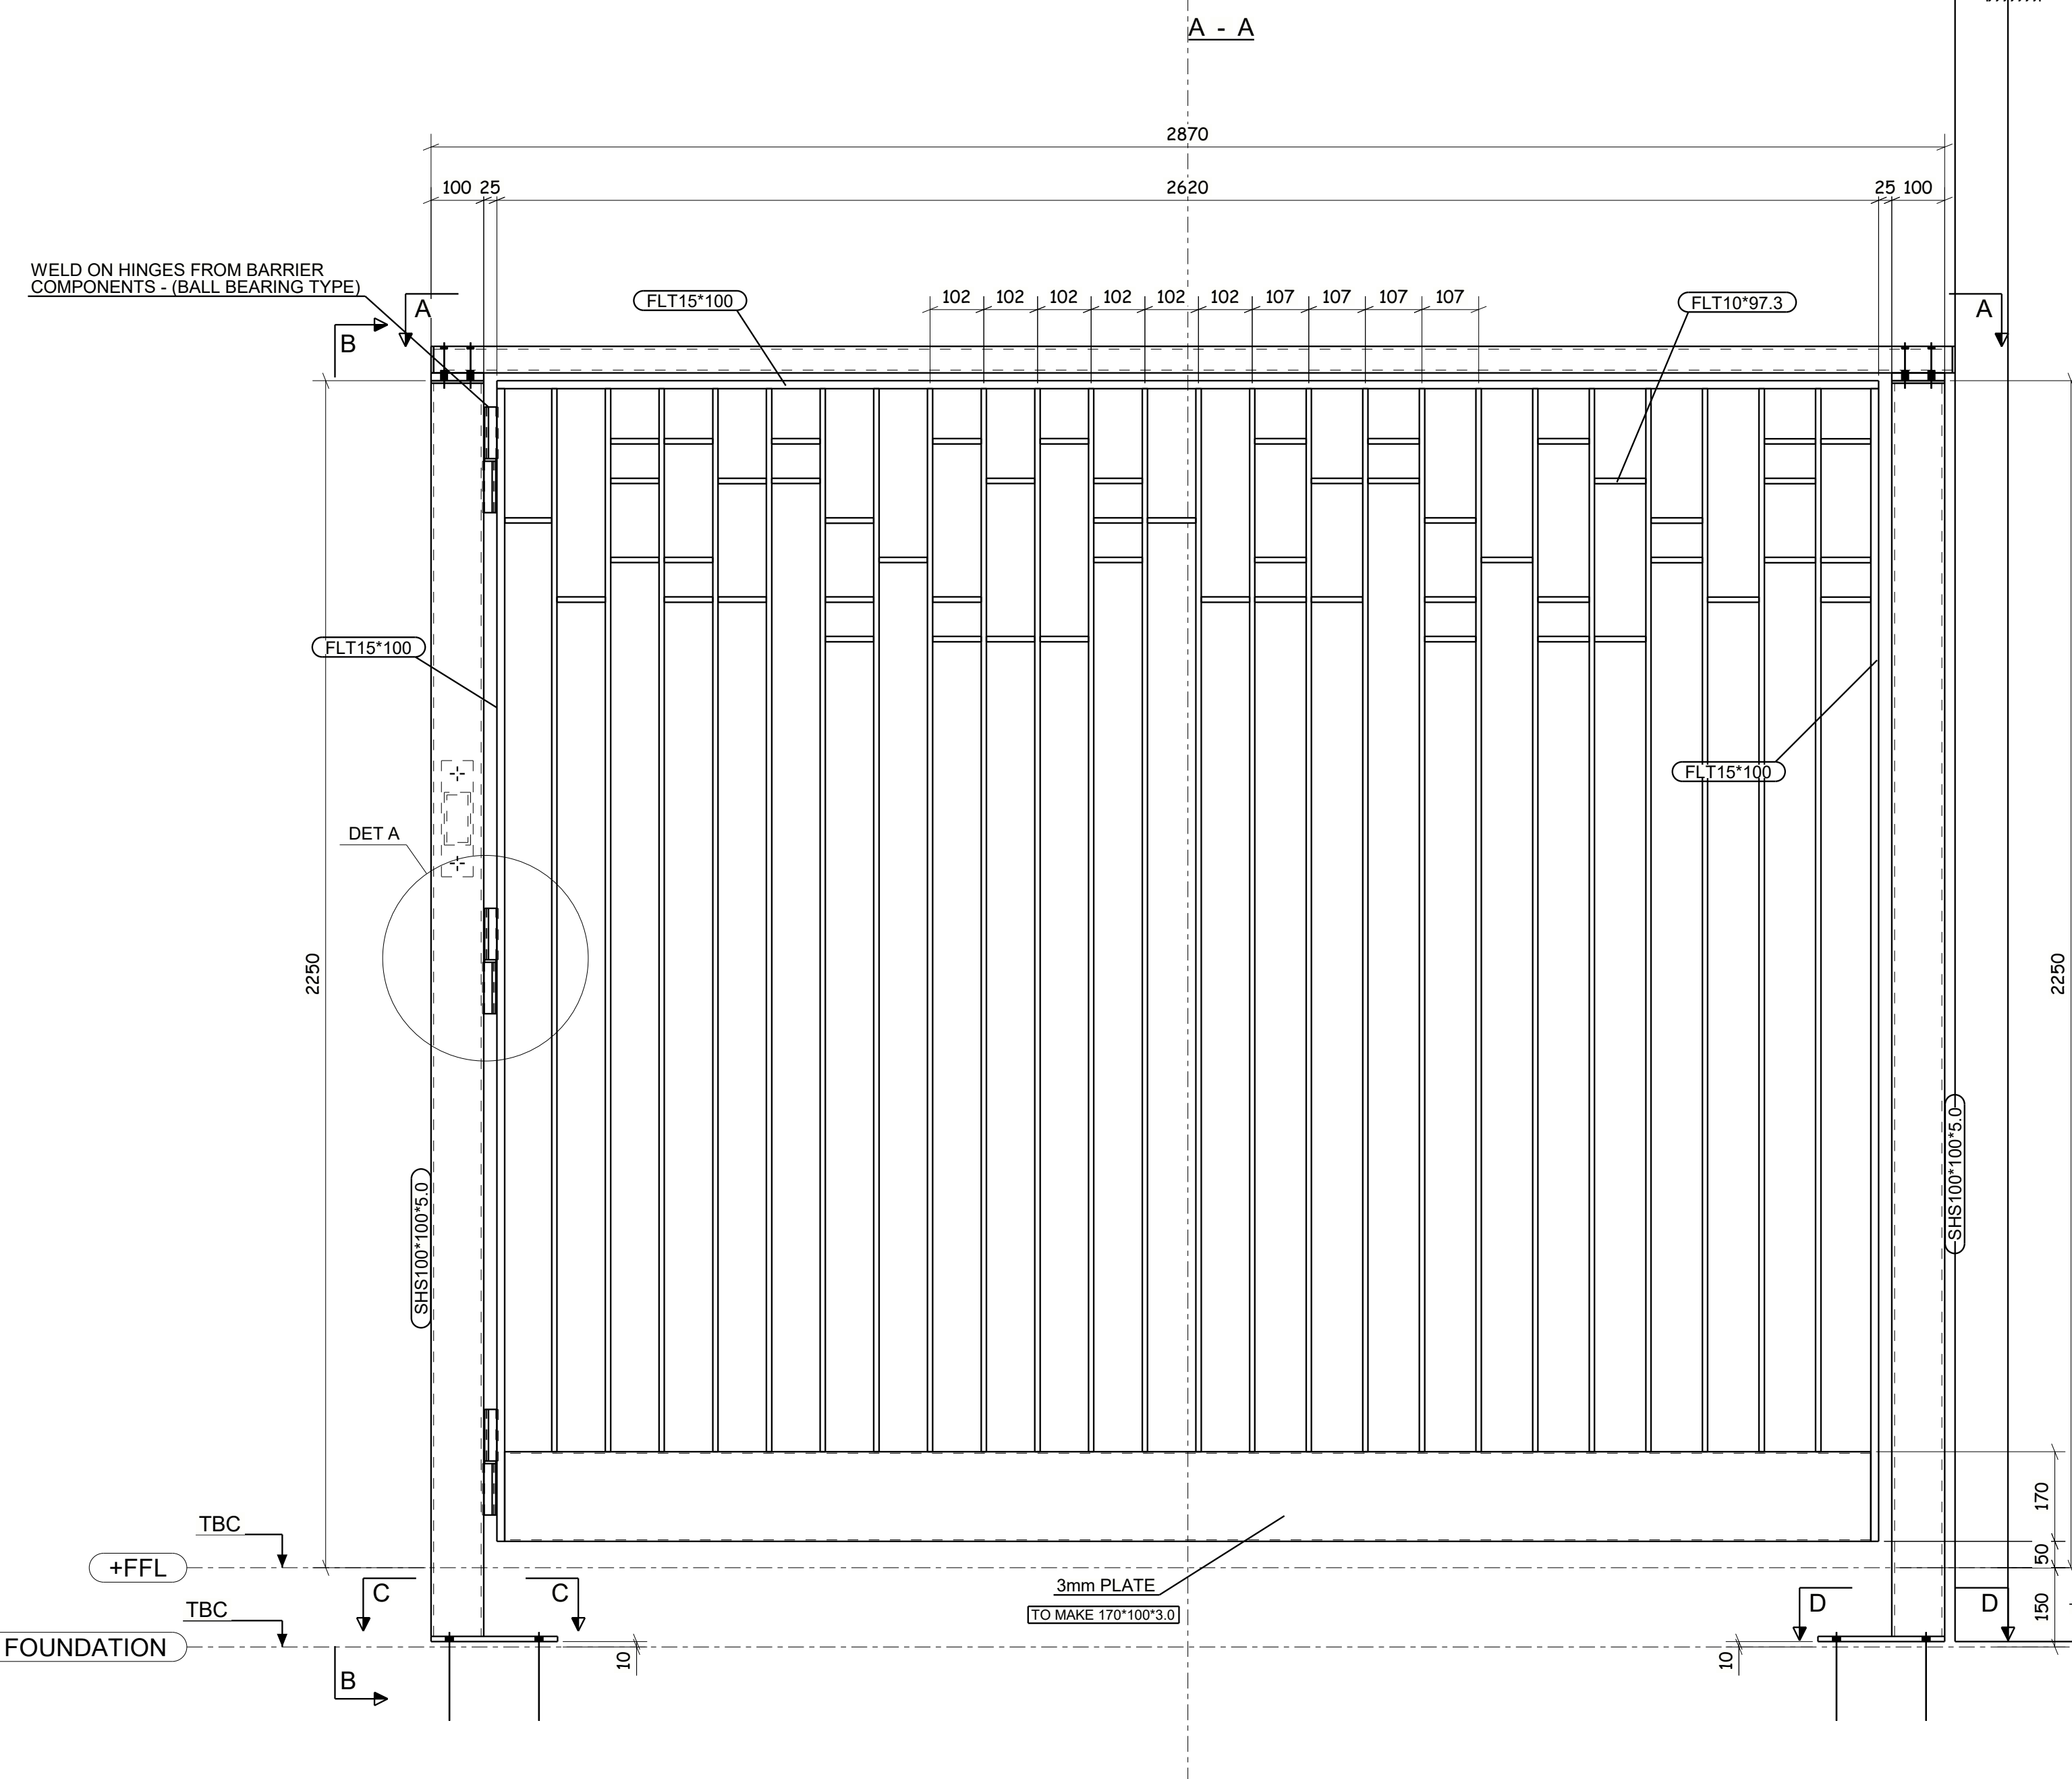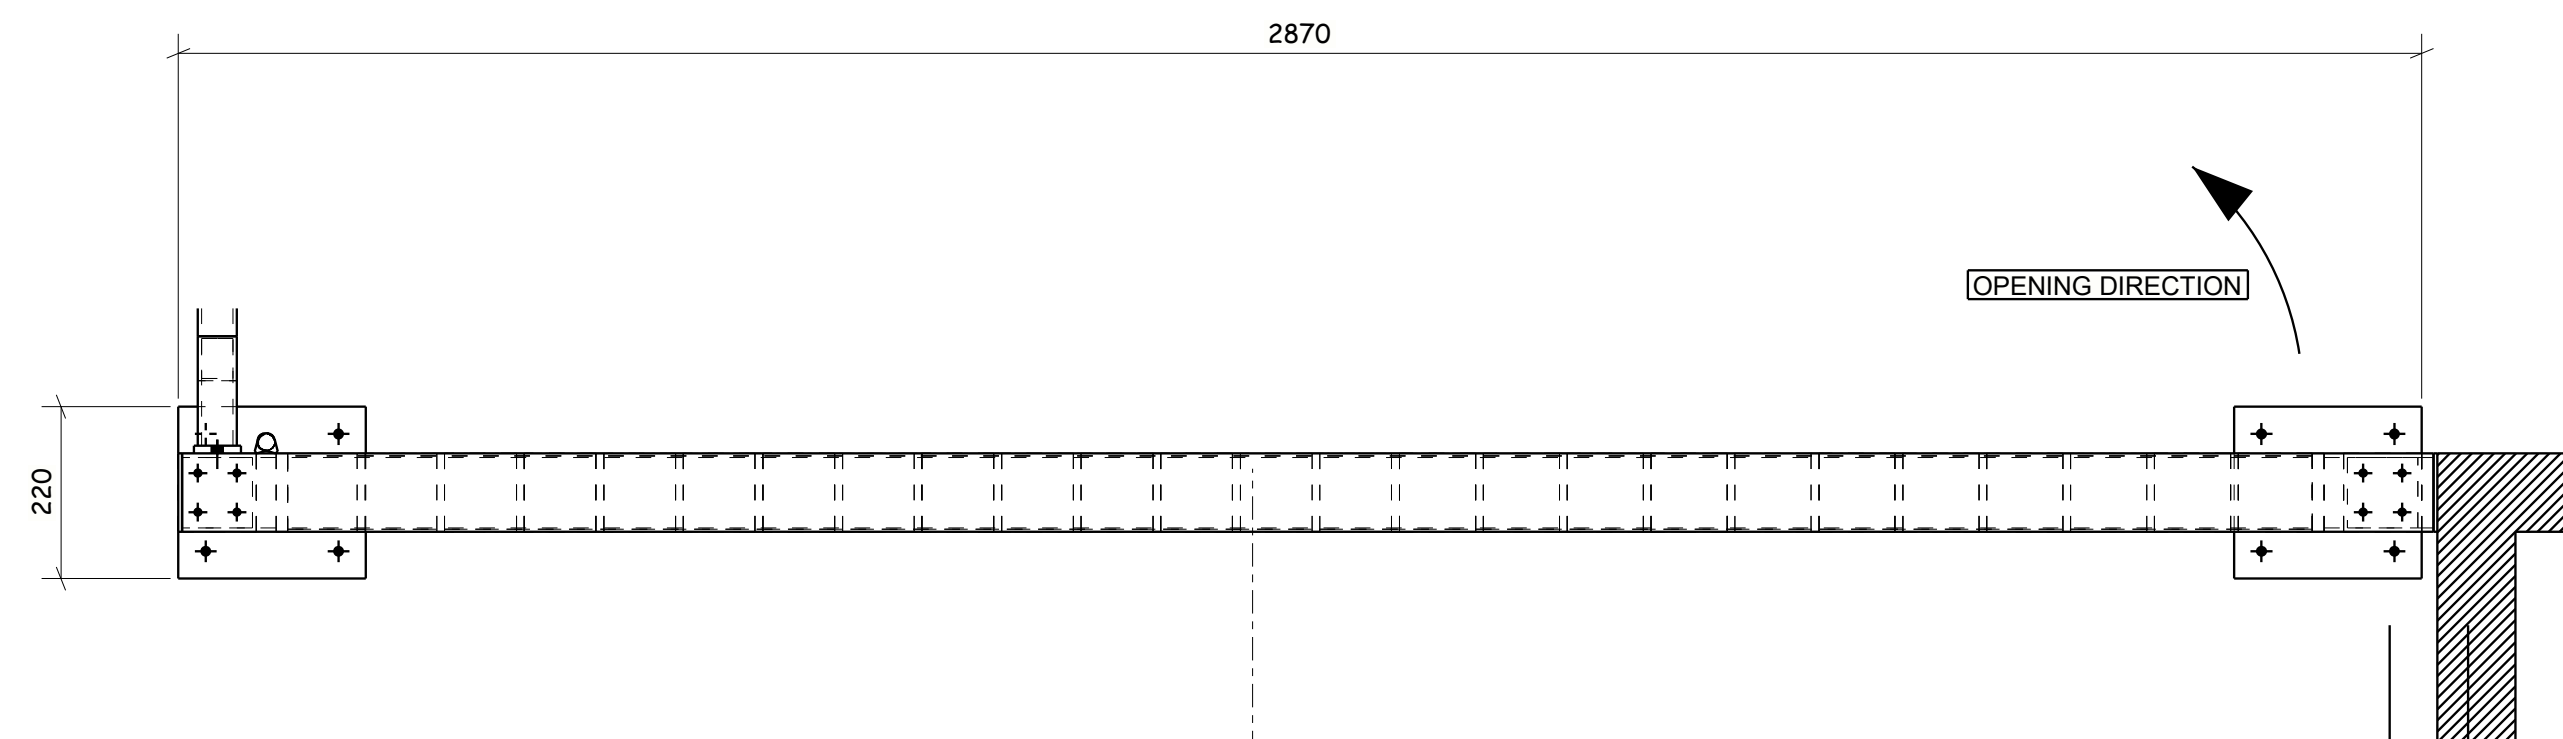

NOTE:
MAIN POST TO BE SHS100*100*5.0
BOTTOM RAIL 3mm PLATE TO MAKE 170*100*3.0
GATE FRAME TO BE FLT100*15
WELD ON HINGES FROM BARRIER COMPONENTS - (BALL BEARING TYPE)
GATE INFILLS TO BE FLT100*10
FINISH RAL7022 GLOSS

C03	PATTERN REVISED TO MATCH GATE 6	30.01.2025
C02	PART MARKS ADDED	11.07.2022
C01	ISSUED FOR COMMENT	15.06.2022
REV MARK	REVISION DESCRIPTION	REVISION DATE
ARDMORE		
DRAWING TITLE	GATE 3 TOWN HALL GARDEN	
CONTRACT	HORNSEY TOWN HALL	
MODELLED BY	LT	DATE 13.06.2022
CONTRACT NO	SEL1142	SCALE 1:5 1:10 1:15
DRAWING No	7414-10-008	REVISION No. C03


4. Gate 4 – Car park access gate (north)

Drawing:

- 202819-003-[G] 100

Location:

- North end of access road between block A and block B

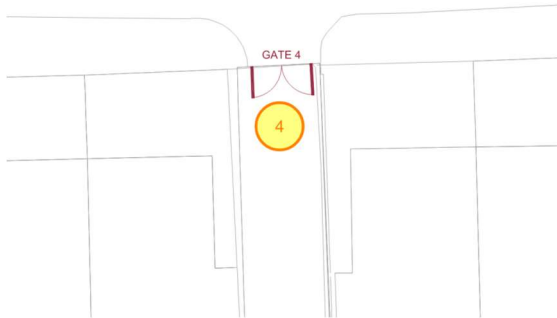


Finish:

- RAL 7016 – anthracite grey

Photograph:



PROJECTION

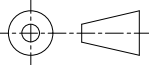

IF IN DOUBT ASK




GENERAL NOTES

1. THE COPYRIGHT OF THIS DRAWING IS RESERVED BY SWANN ENGINEERING GROUP LTD. IT IS ISSUED ON CONDITION THAT IT IS NOT COPIED, REPRODUCED OR DISCLOSED TO A THIRD PARTY, EITHER WHOLLY OR IN PART WITHOUT THE CONSENT IN WRITING OF THE COMPANY.
2. DO NOT SCALE DRAWING. USE WRITTEN DIMENSIONS ONLY.
3. USE THE CURRENT REVISION OF ALL REFERENCED INFORMATION.
4. REFER TO CONTRACT SPECIFIC NOTES BELOW.

CONTRACT SPECIFIC NOTES

1. ALL DIMENSIONS IN MILLIMETRES U.N.O.
2. ALL STEEL TO BE GRADE S275JR TO BS EN 10025 U.N.O. CHS TO BE GRADE S275JOH TO BS EN 10210 U.N.O.
3. UNLESS STATED ALL GEOMETRIC TOLERANCES ARE TO BS EN 1090-2.
4. ALL WELDS TO BE IN ACCORDANCE WITH SEG WELD PROCEDURE SEG3. U.N.O. WELDING SHALL BE UNDERTAKEN IN ACCORDANCE WITH THE REQUIREMENTS OR BS EN 3834 U.N.O.
5. ALL STEEL TO BE HOT DIP GALVANISED TO BS EN 1461 U.N.O.
6. ALL ERECTION MARKS TO BE HARD STAMPED AND CLEARLY VISIBLE.

Pattern Detail
SPOT WELDED UNDERSIDE

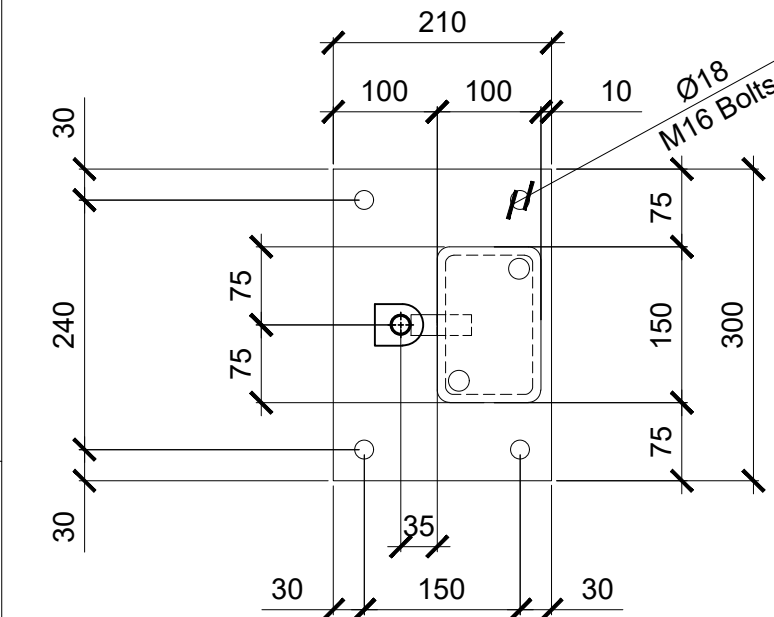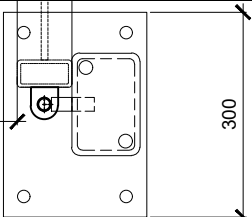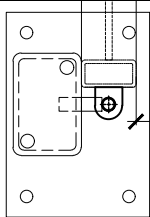

Gate Frame - 80x40x5 RHS
Posts - 100x100x8 SHS
Vertical Infills - 10x10 SQ BAR
Hori. Infills - 10x10 SQ BAR
Base Plates - 300x300x15

All welds 6mm CFW unless noted otherwise

Weight Big Leaf - 121Kg (approx.)
Weight Small Leaf - 70Kg (approx.)

E	29.09.21	SM	RAMS ADDED
D	24.09.21	AT	WIDTHS AMENDED
C	29.07.21	AT	HINGES AND INFILLS REVISED
B	15.07.21	AT	SECTIONS REVISED TO REDUCE WEIGHT
A	06.07.21	AT	INITIAL ISSUE
REV	DATE	BY	MODIFICATION



SWANN ENGINEERING GROUP LTD
SPRINGWOOD INDUSTRIAL ESTATE
BRAINTREE
ESSEX CM7 2YN

TELEPHONE: 01376 320100
FACSIMILIE: 01376 347995
WEBSITE: www.swanngrouppltd.com

TITLE:	GATE 4 NORTH ENTRANCE		
PROJECT:	HORNSEY TOWN HALL		
MATERIAL:	MS	MARK NUMBER:	
FINISH:	PPC RAL 7022	DRAWN:	AT
DATE:	06.07.21	CHECKED:	MC
SCALE:	NTS	SHEET No:	1
JOB No:	202819_003		

DRG. No: [G] 100

REV: E


5. Gate 5 – Car park access gate (south)

Drawing:

- 7414-03-001

Location:

- South end of access road between block A and block B

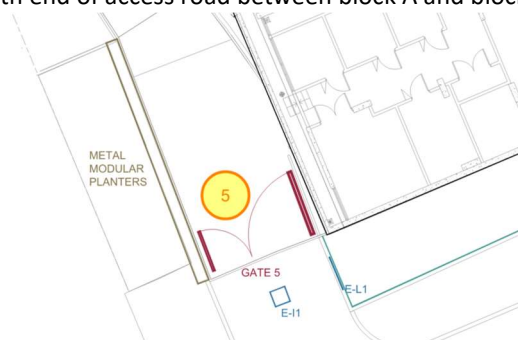

Finish:

- RAL 7016 – anthracite grey

Photograph:



6. Gate 6 – Mews Entrance

Drawing:

- 7414-10-003

Location:


- Mews entrance gate






Finish:

- RAL 7016 – anthracite grey

Photograph:

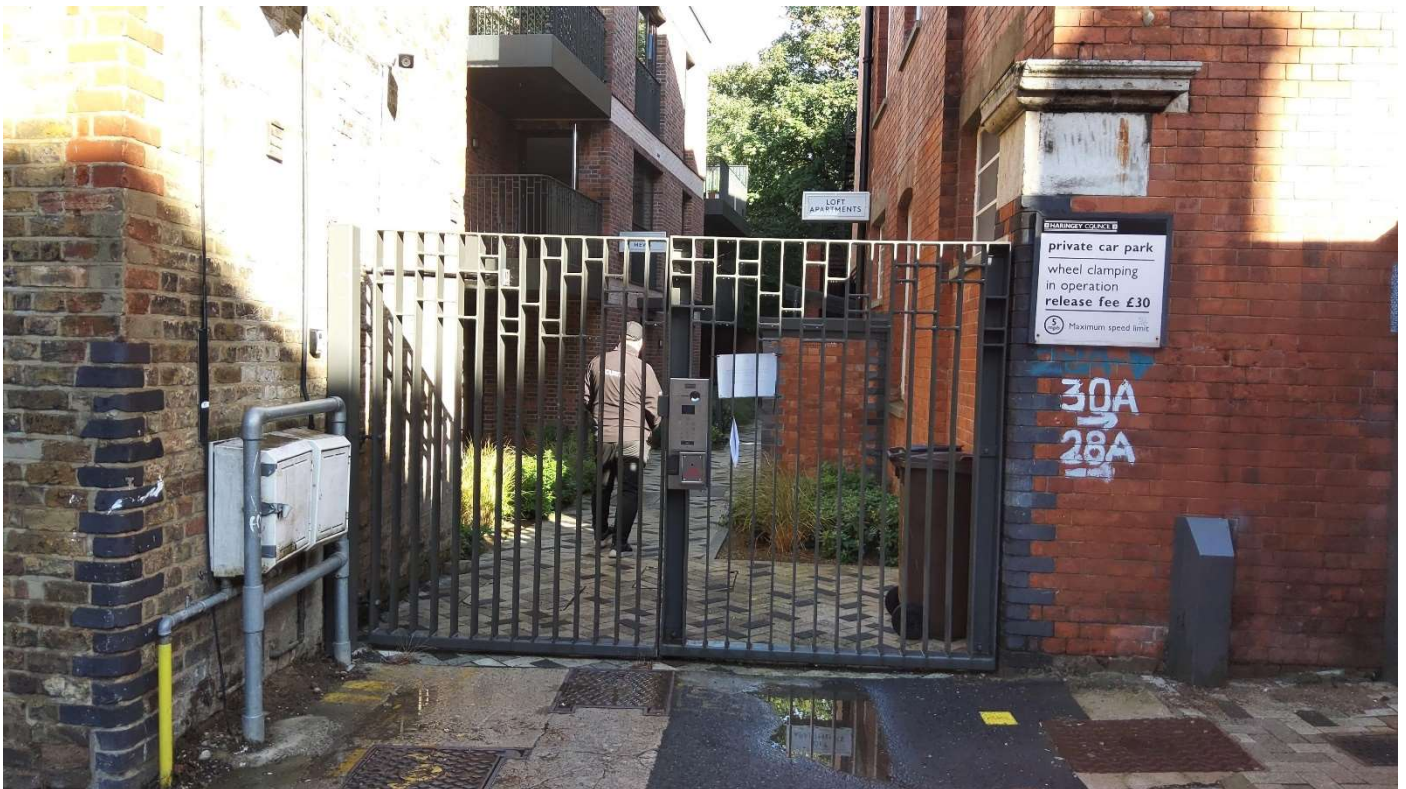

[ANY AUTOMATION, MAG LOCK OR CLOSER TO BE SUPPLIED BY OTHERS]

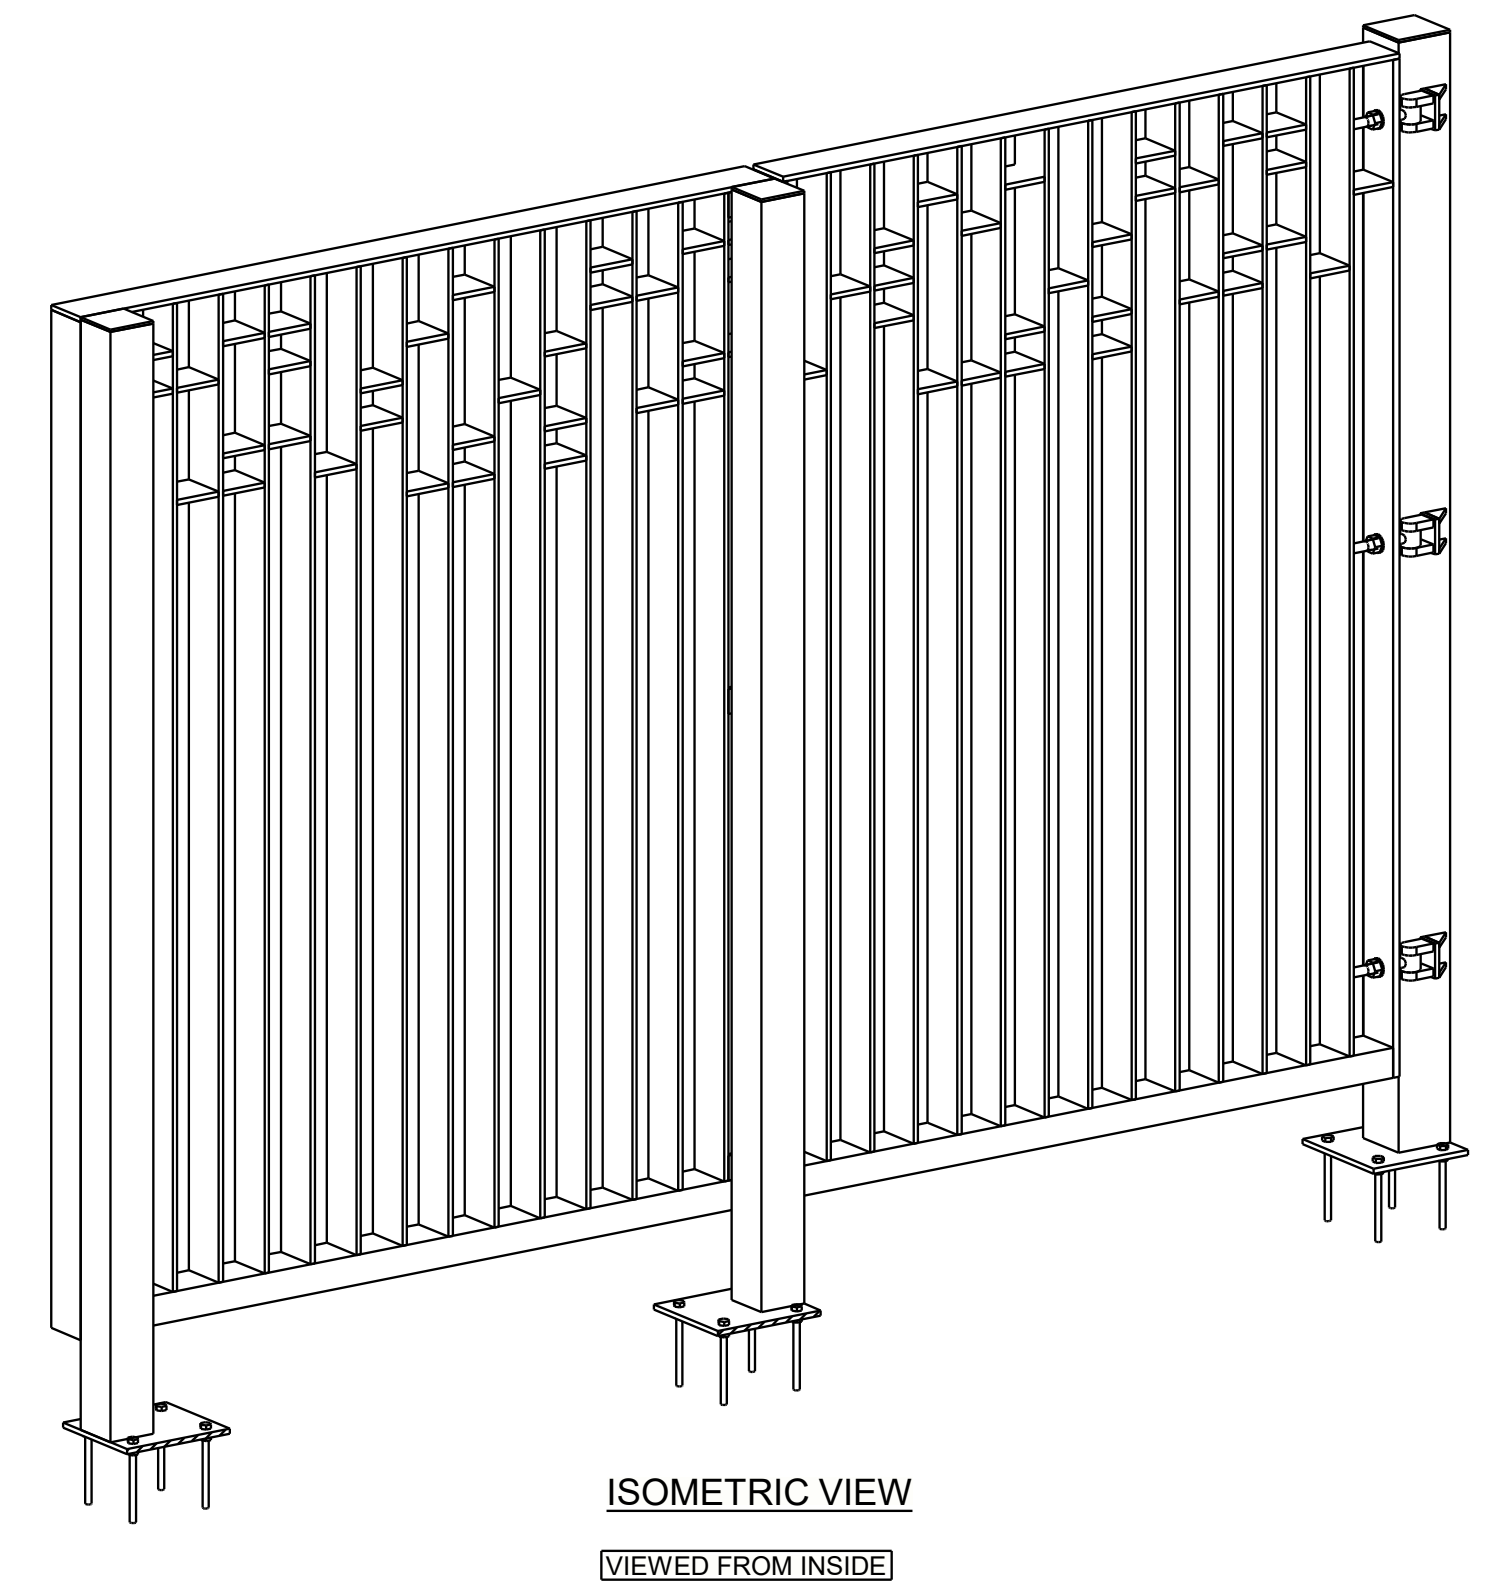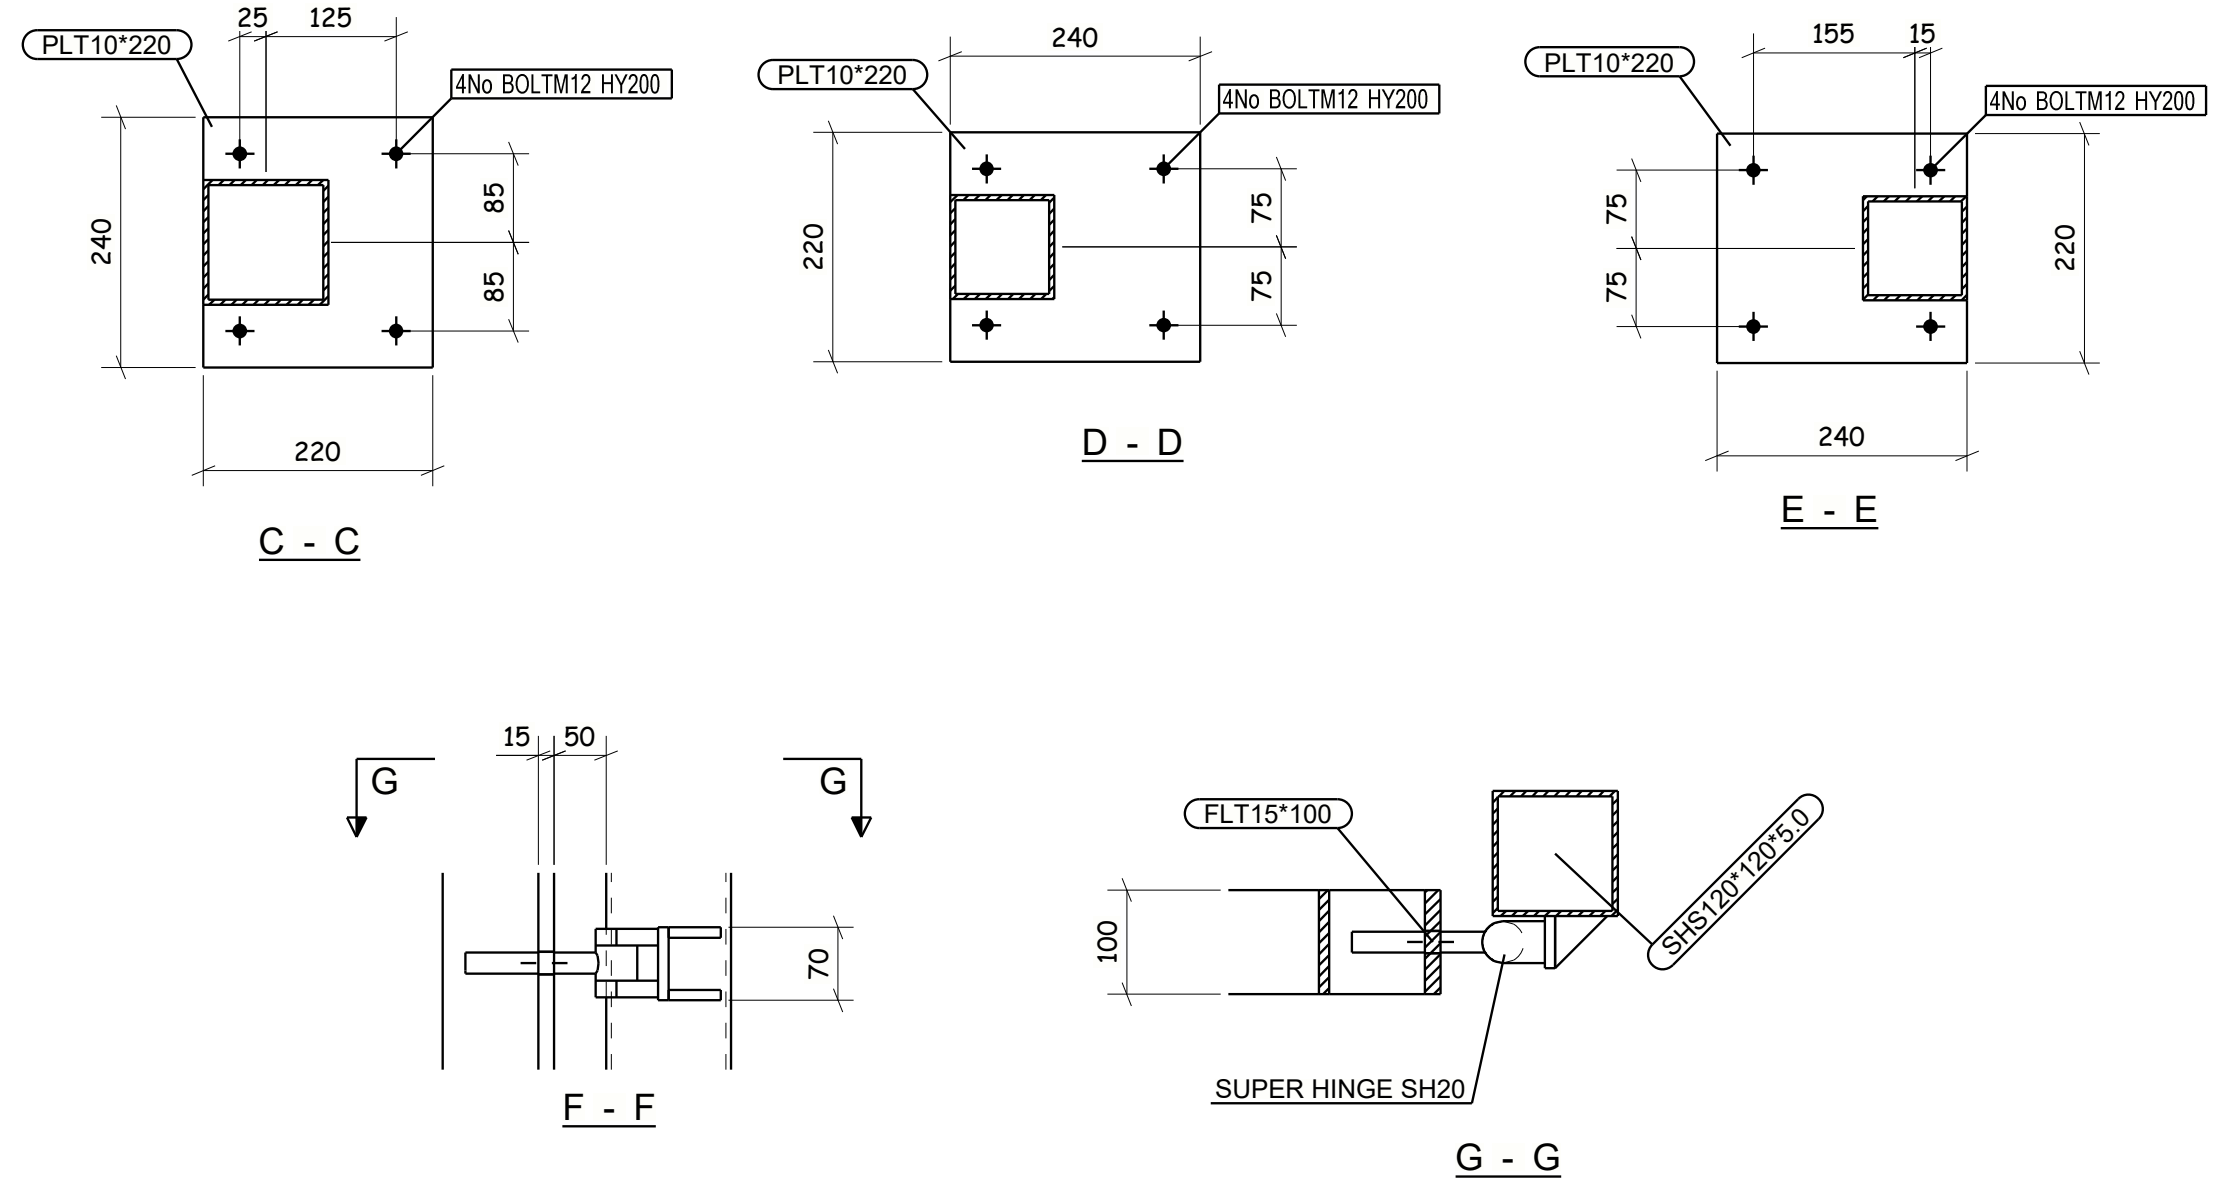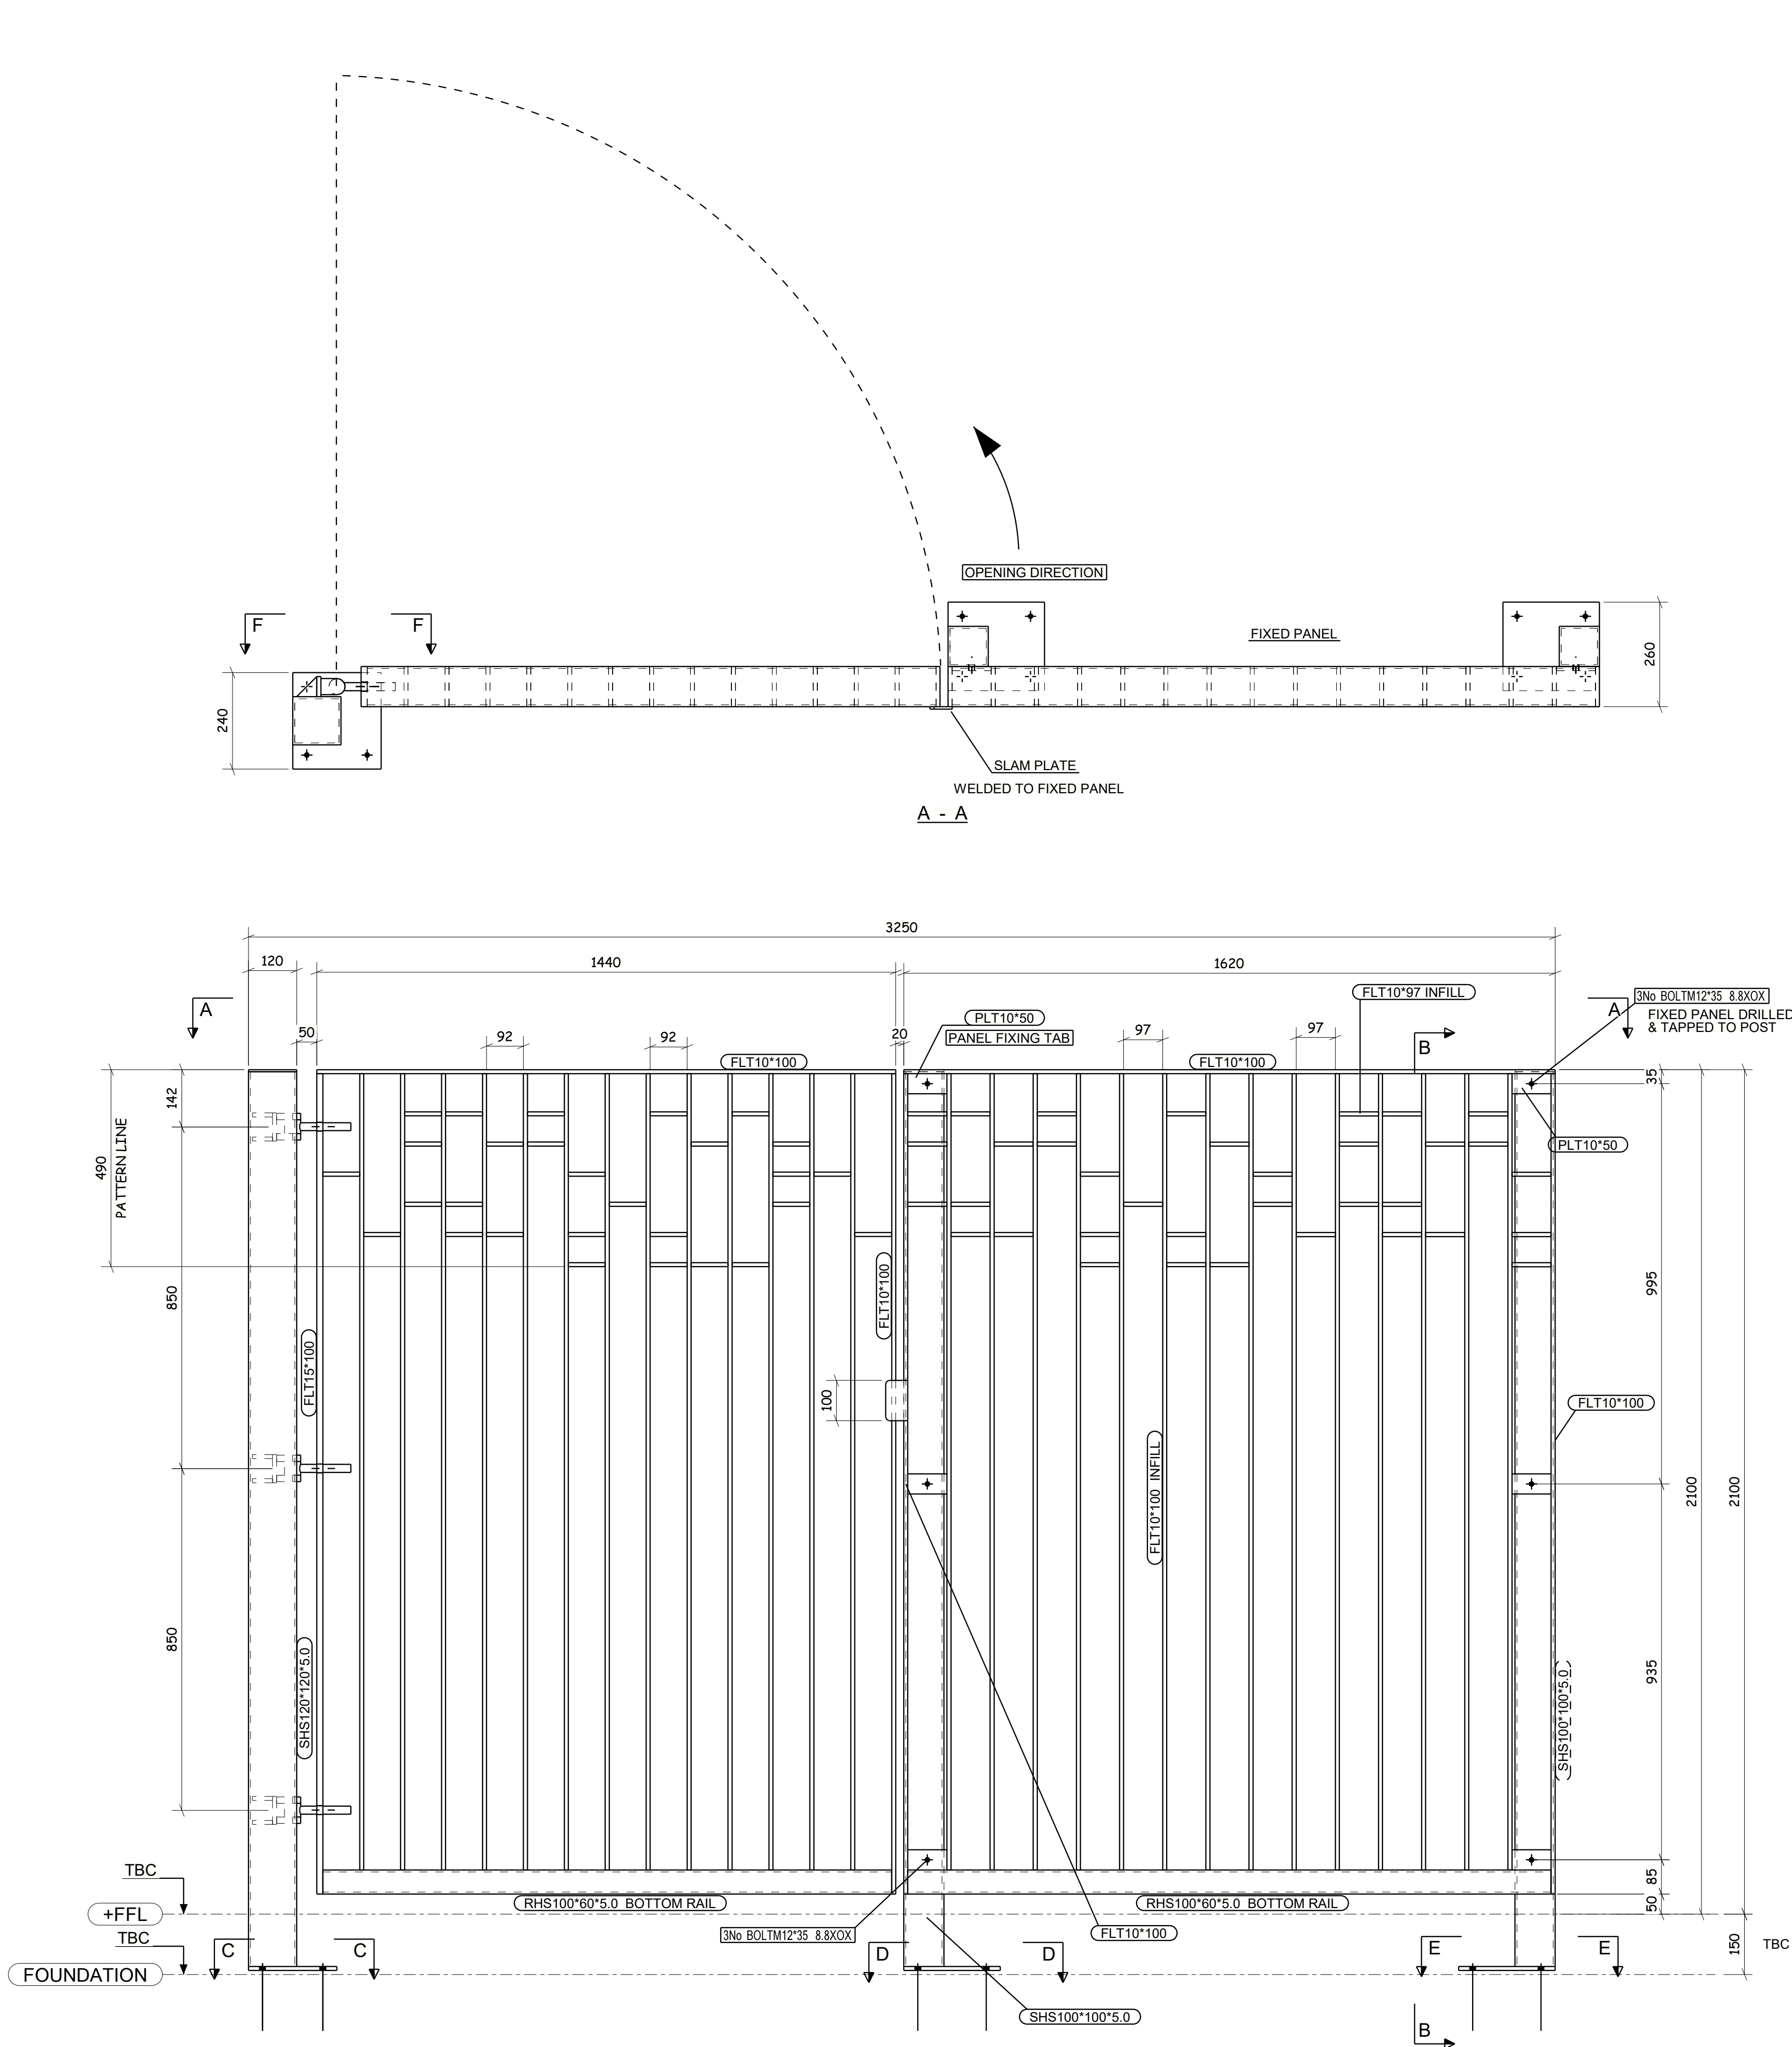

NOTE:
MAIN POST TO BE SHS100*100*5.0
BOTTOM RAIL RHS100*60*5.0
GATE FRAME TO BE FLT100*10
HINGE PLATE TO BE FLT100*15
GATE INFILLS TO BE FLT100*10
HINGE TO BE SUPERHINGE SH20
FINISH RAL7022 GLOSS (TBC)

[POST BOX UNITS & INTERCOMES SHOWN ON ARCHITECT DRAWING SUPPLIED BY OTHERS]

C01	ISSUED FOR COMMENT	09.06.2022
REV MARK	REVISION DESCRIPTION	REVISION DATE
SKYLINE Engineering (South East) Ltd Unit 10, 11, 12, 2235, 22		



7. Gate 7 – Omitted


8. Gate 8 – Town Hall Gardens to hotel courtyard

Drawing:

- 7414-10-005

Location:


- Town Hall Gardens to steps leading to hotel courtyard

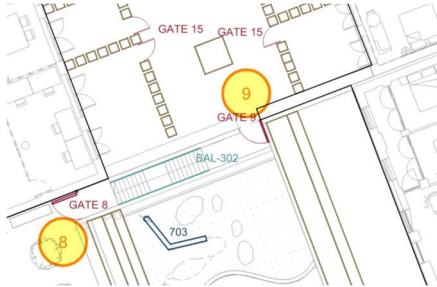







Finish:

- RAL 7016 – anthracite grey

Photograph:

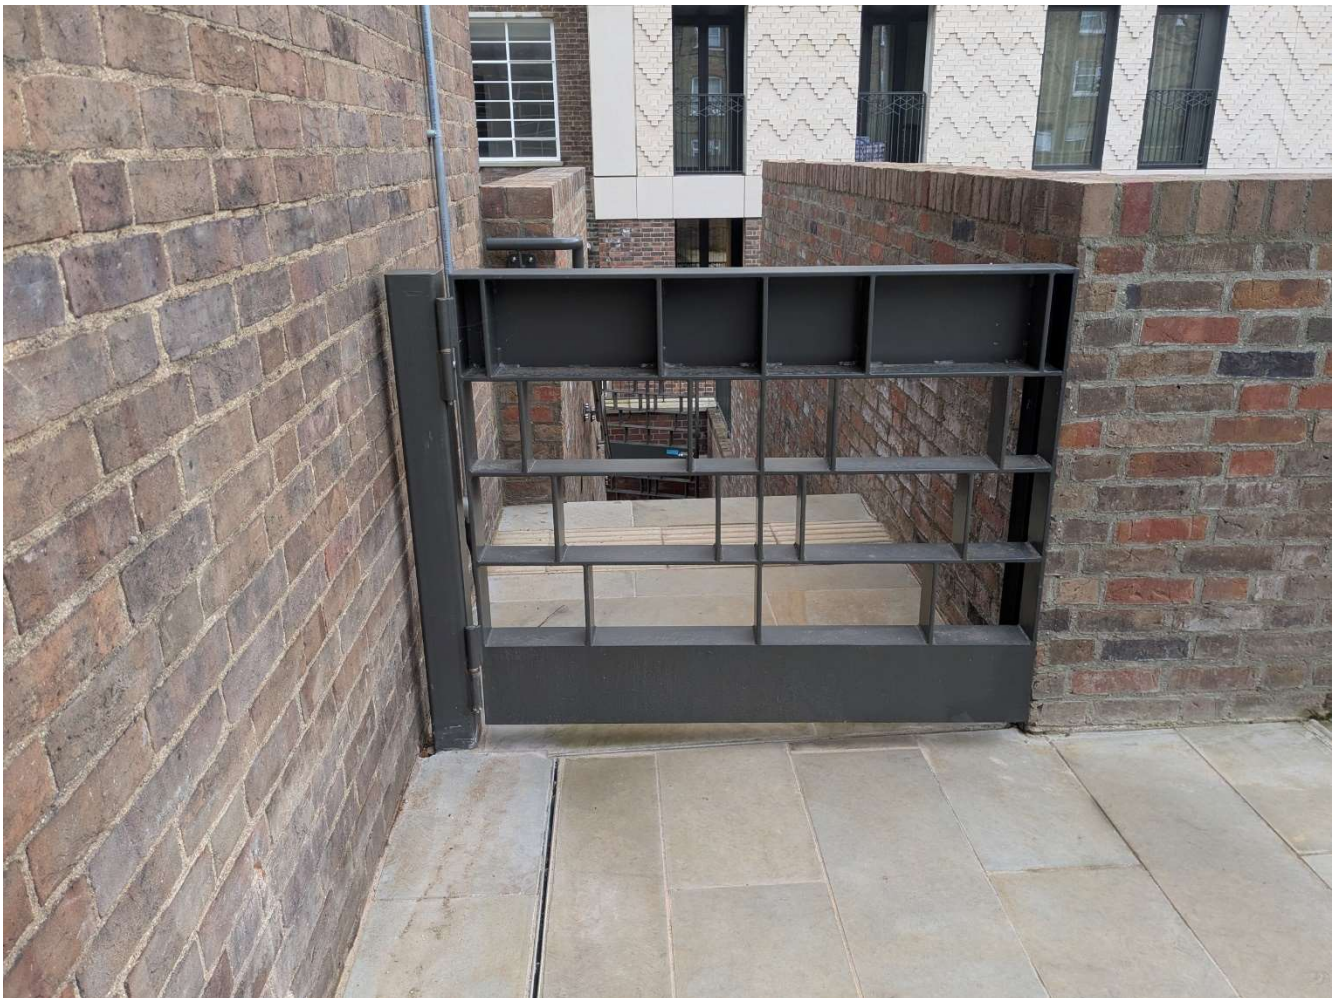

ANY AUTOMATION, MAG LOCK OR CLOSER TO BE SUPPLIED BY OTHERS

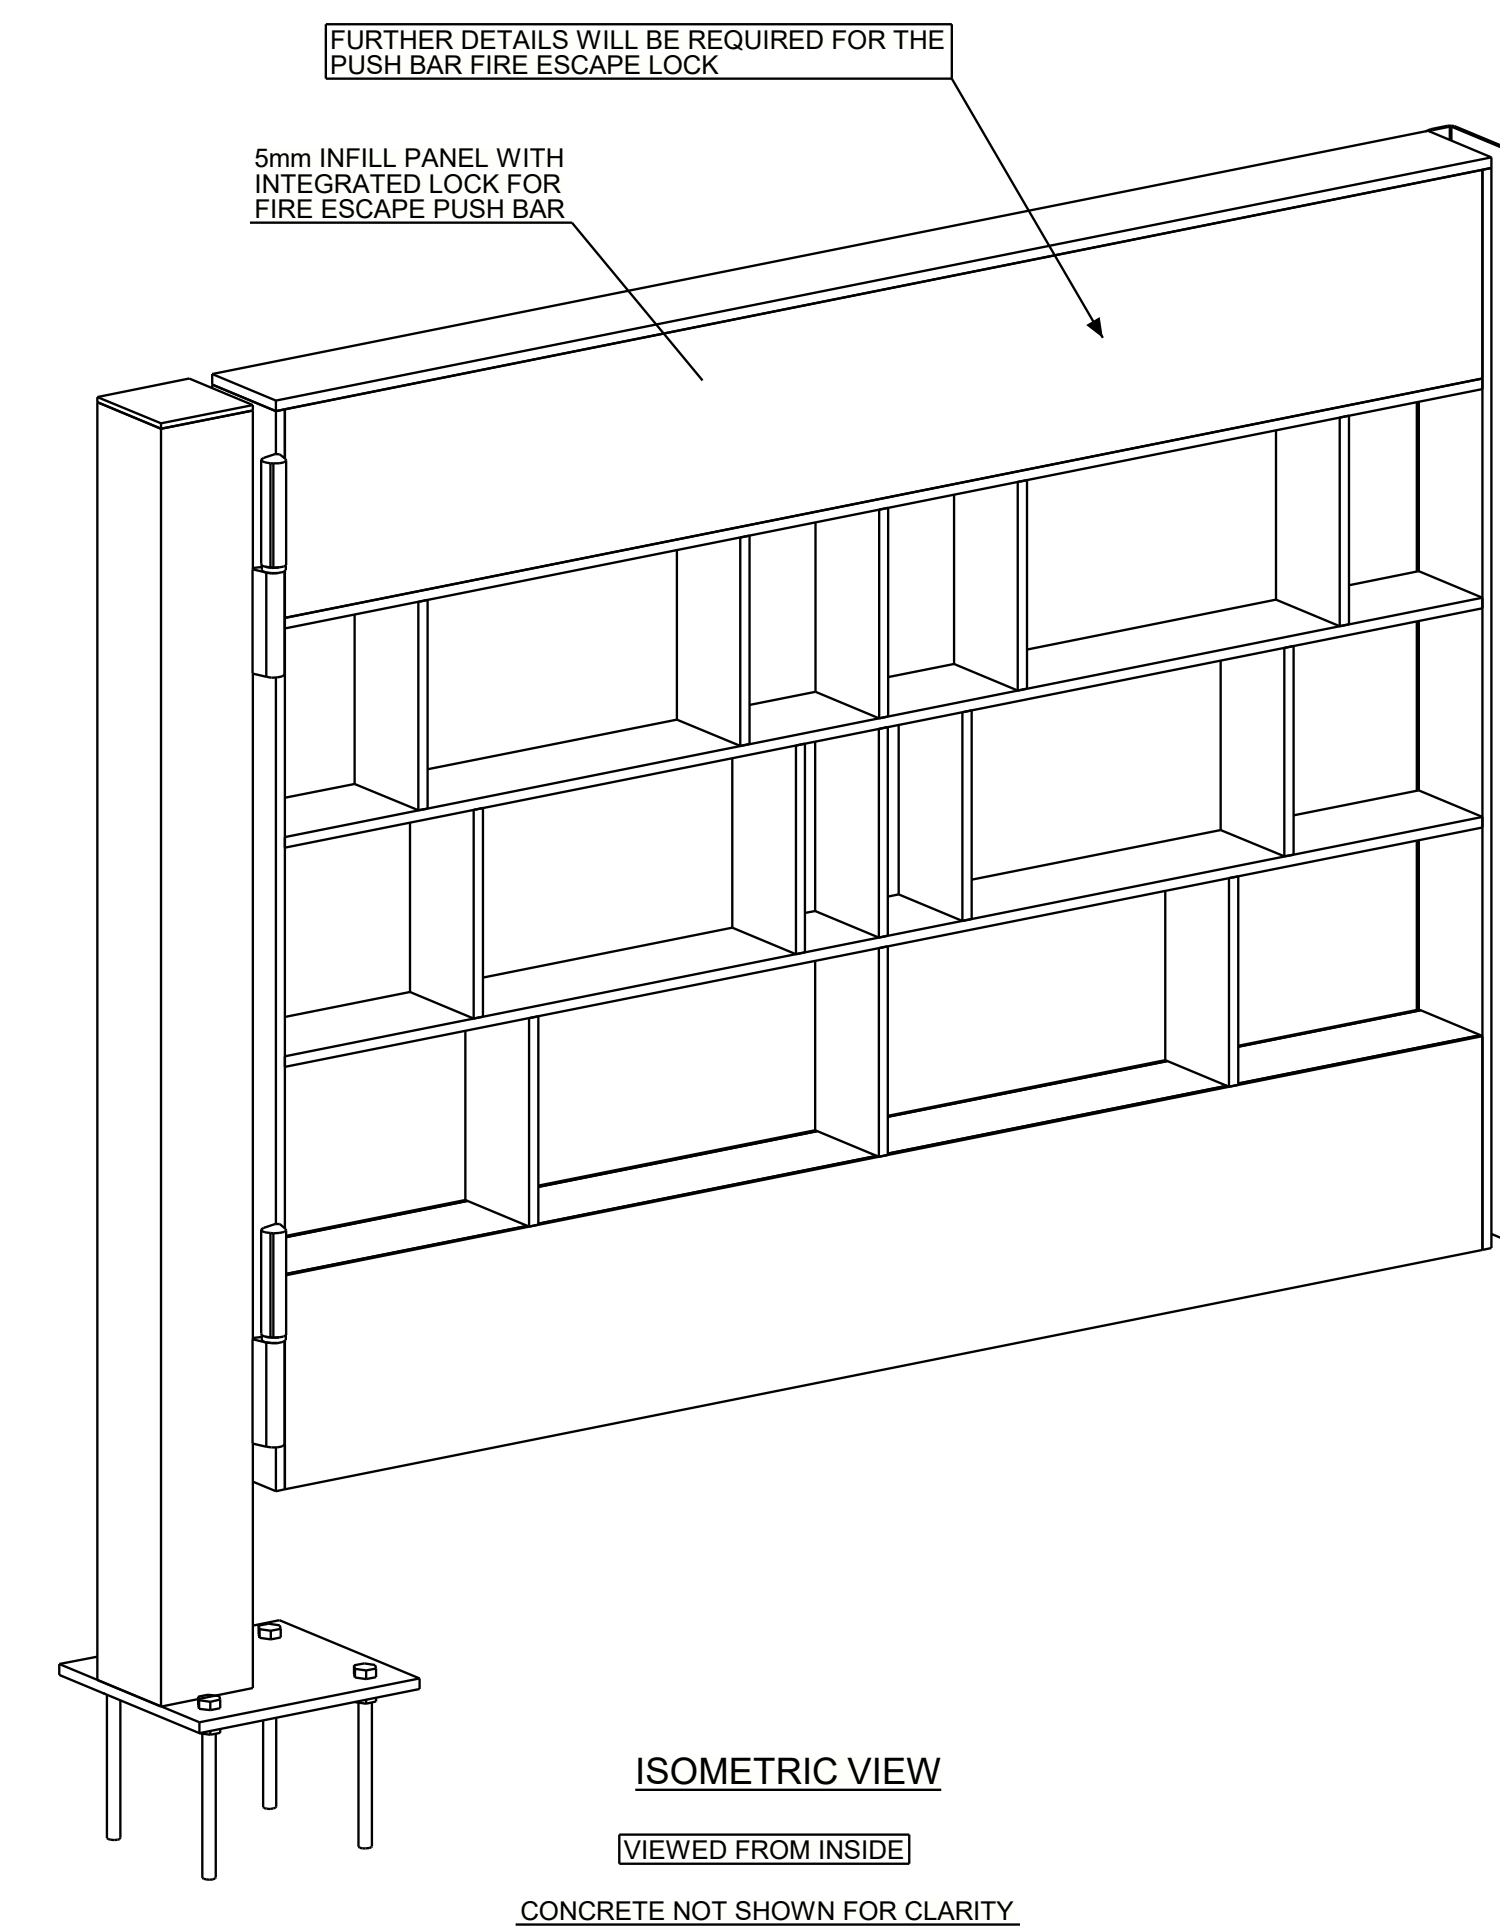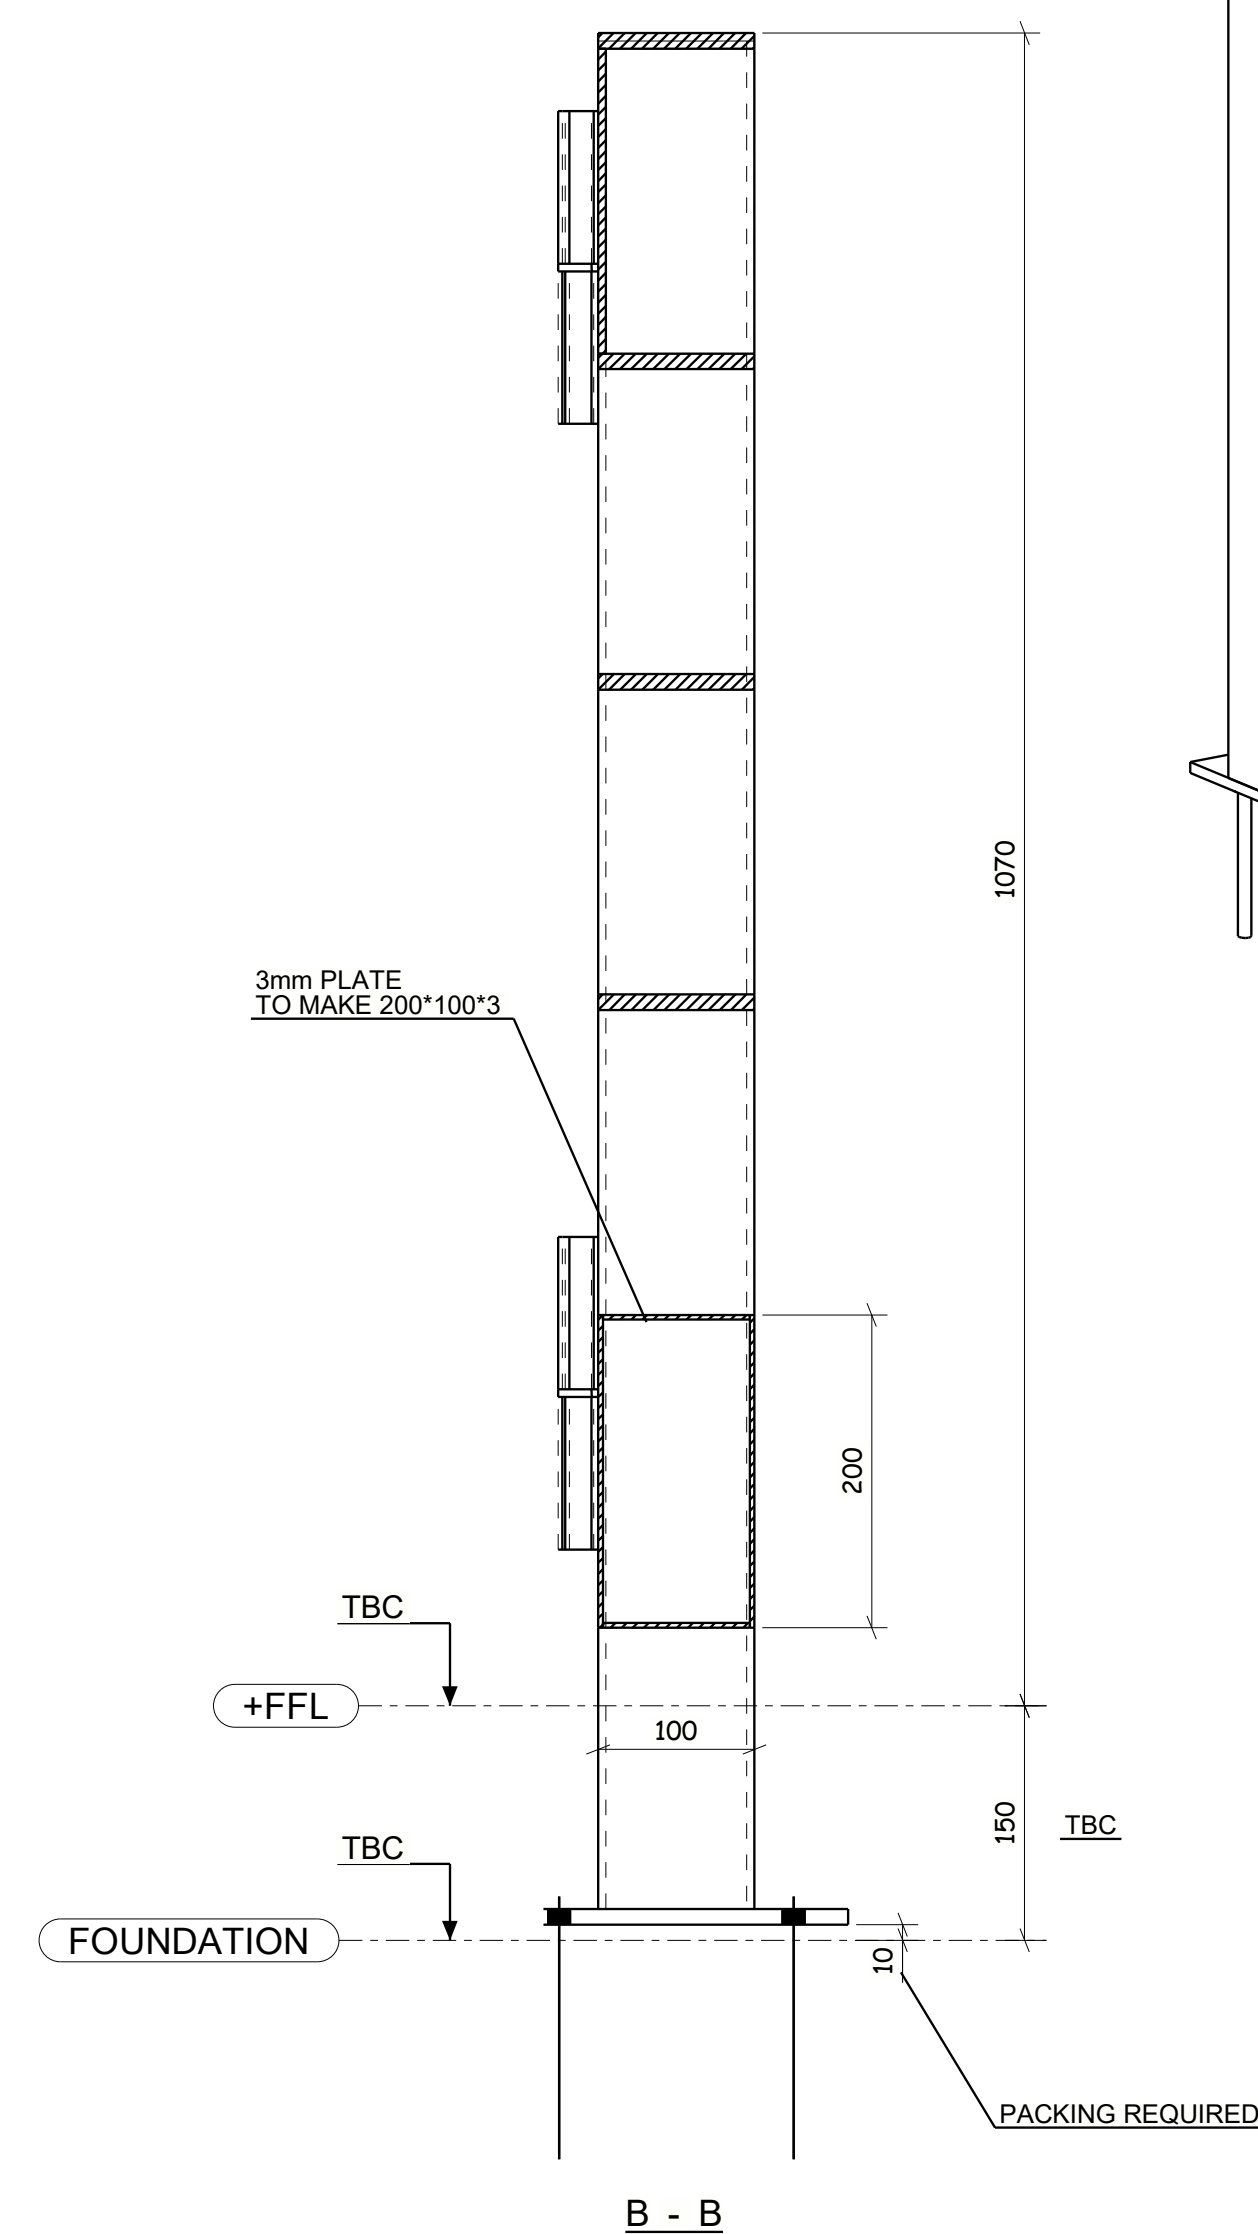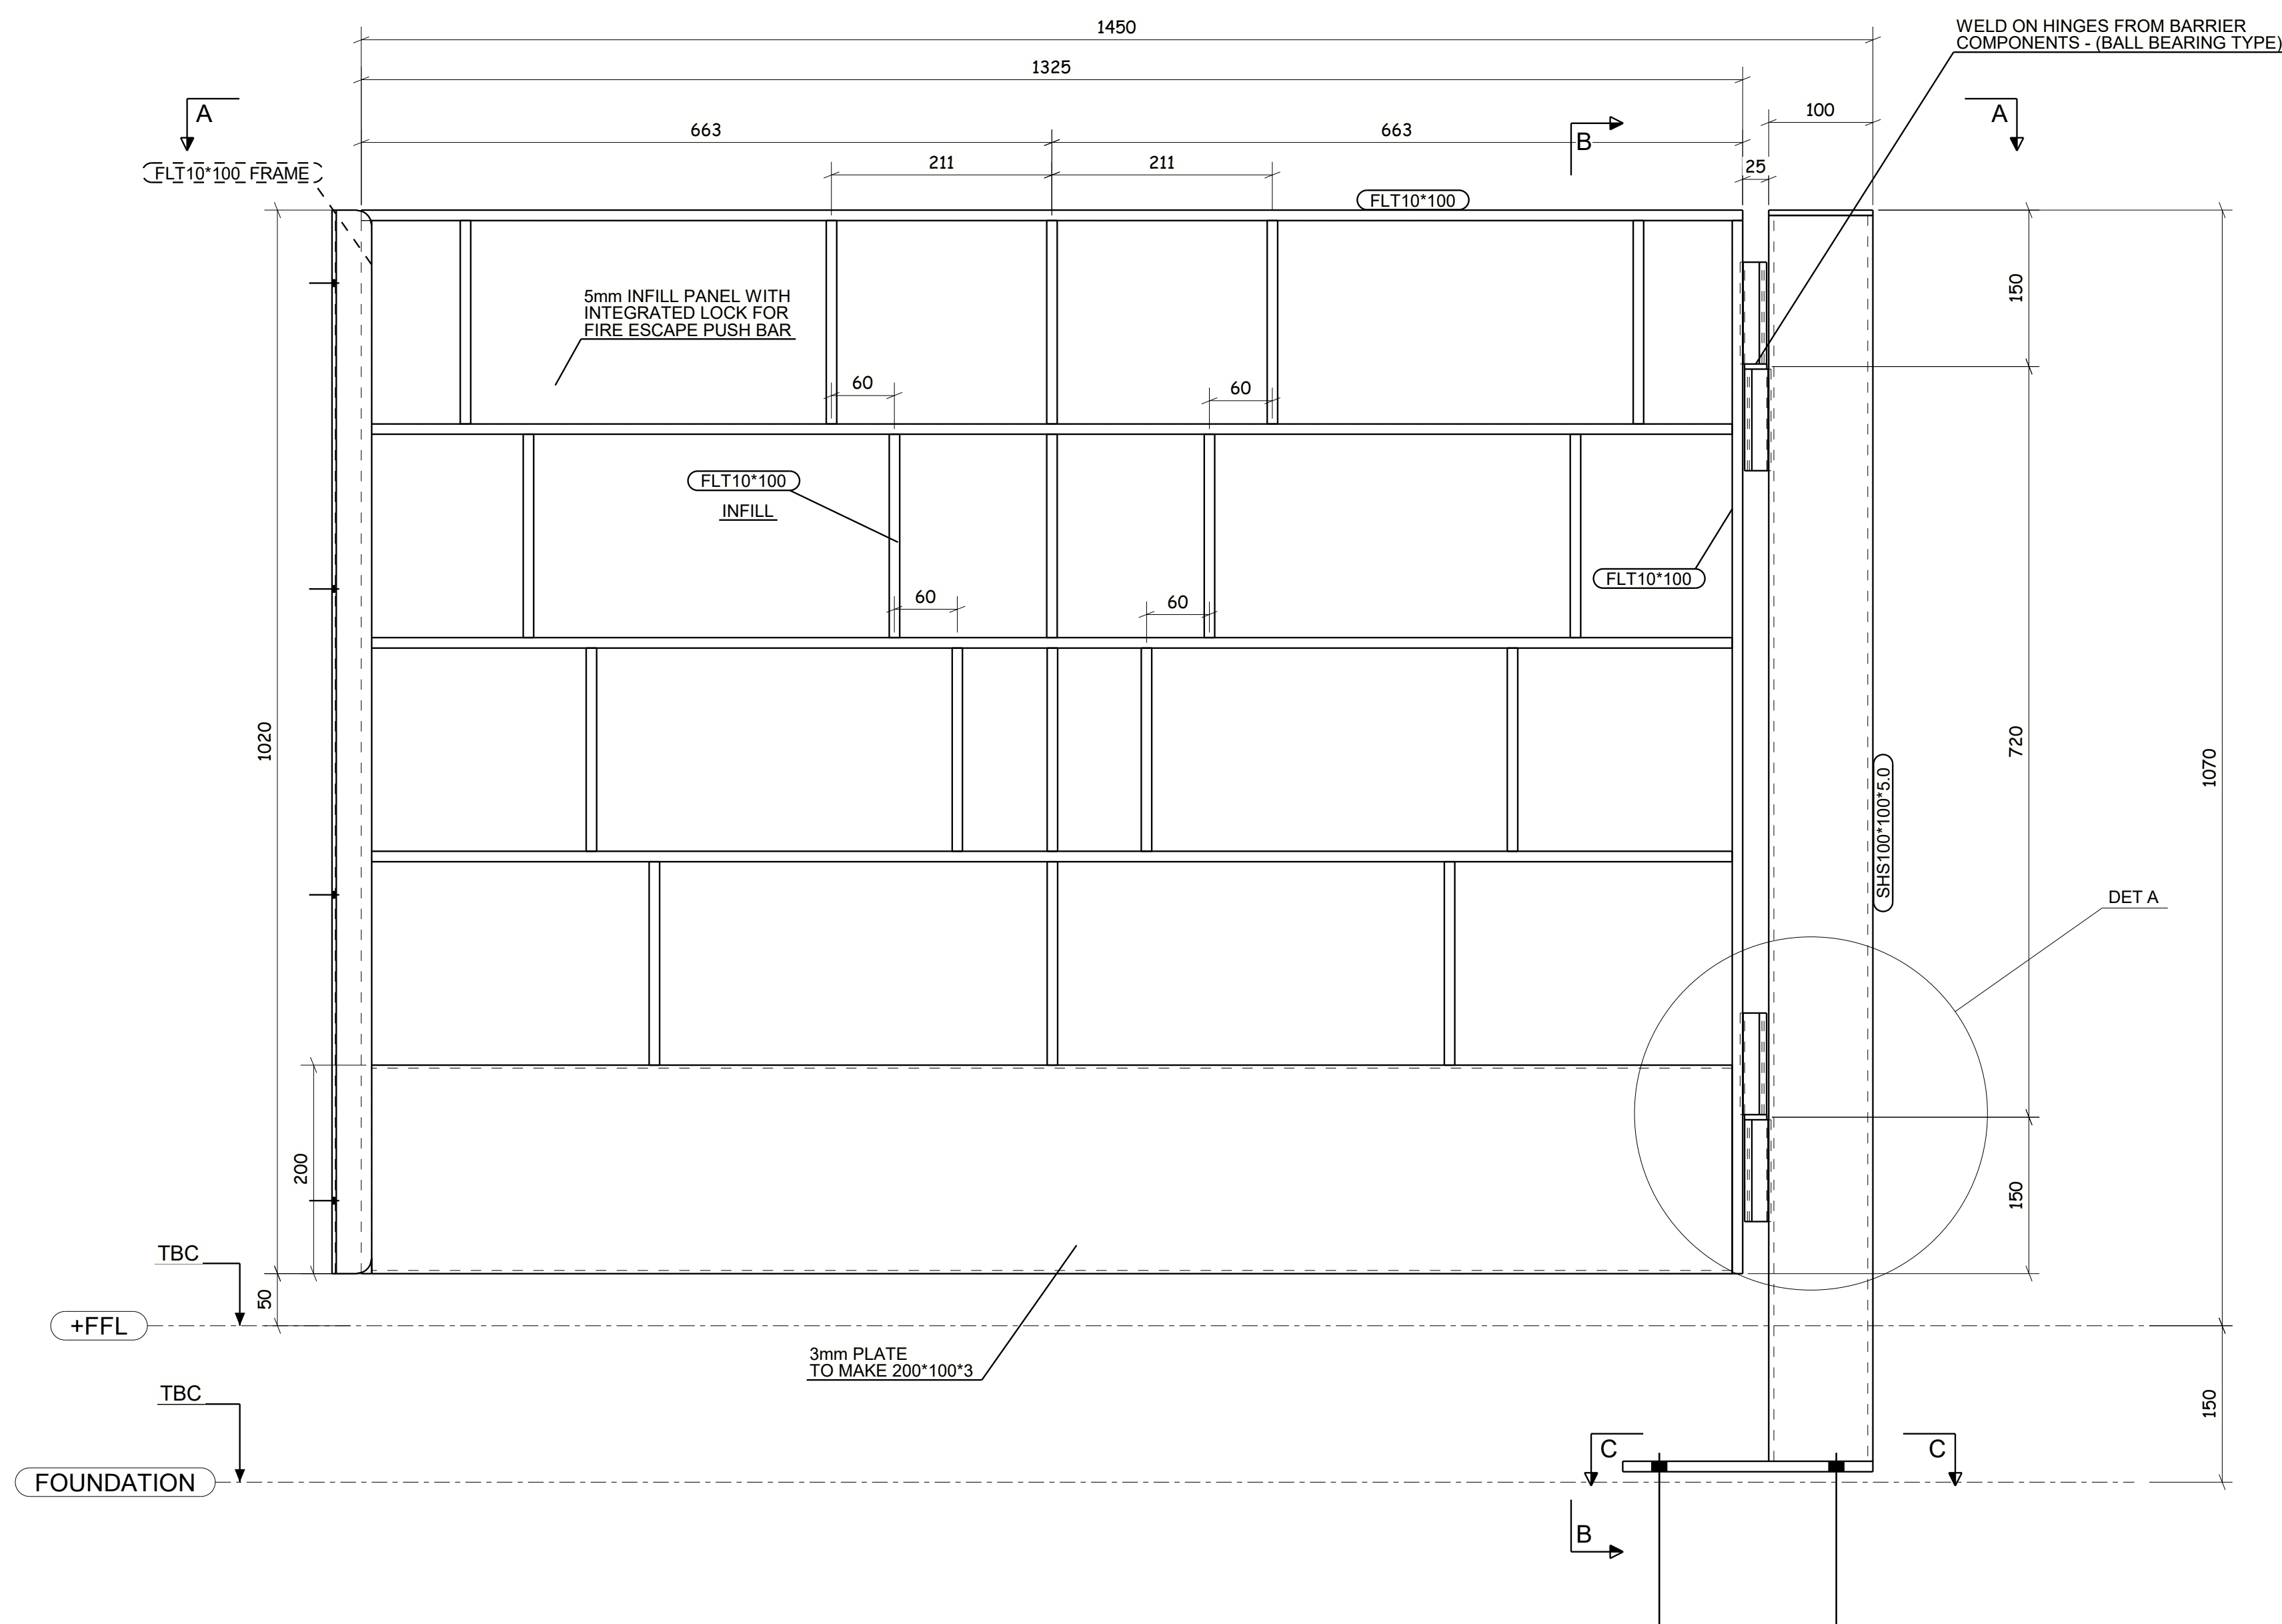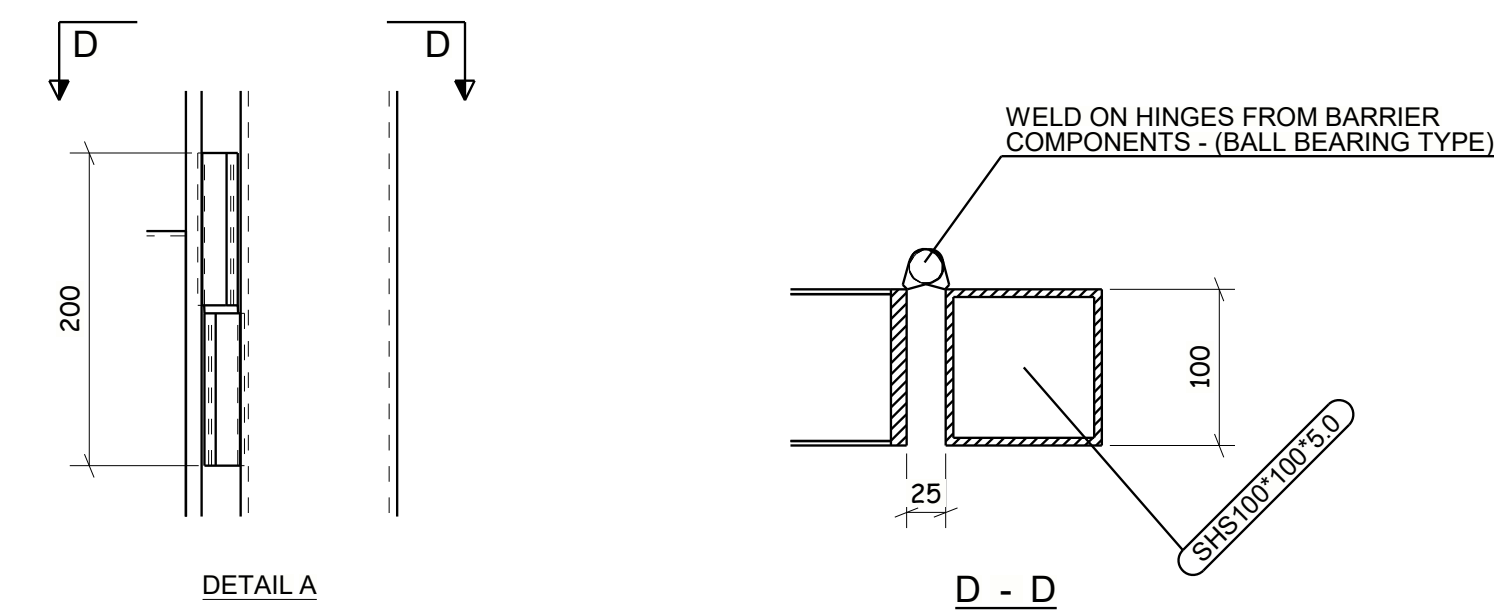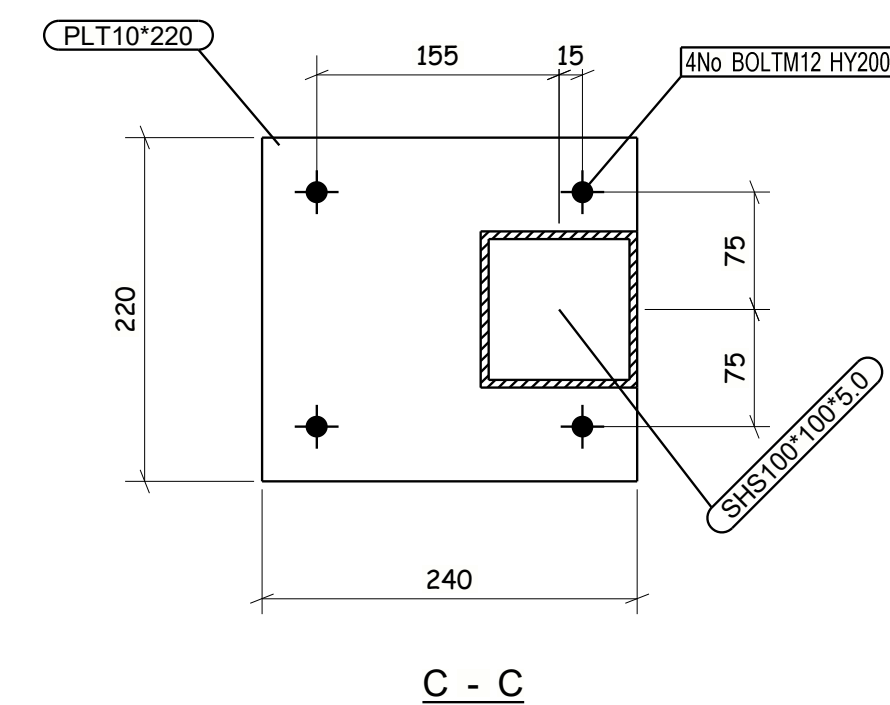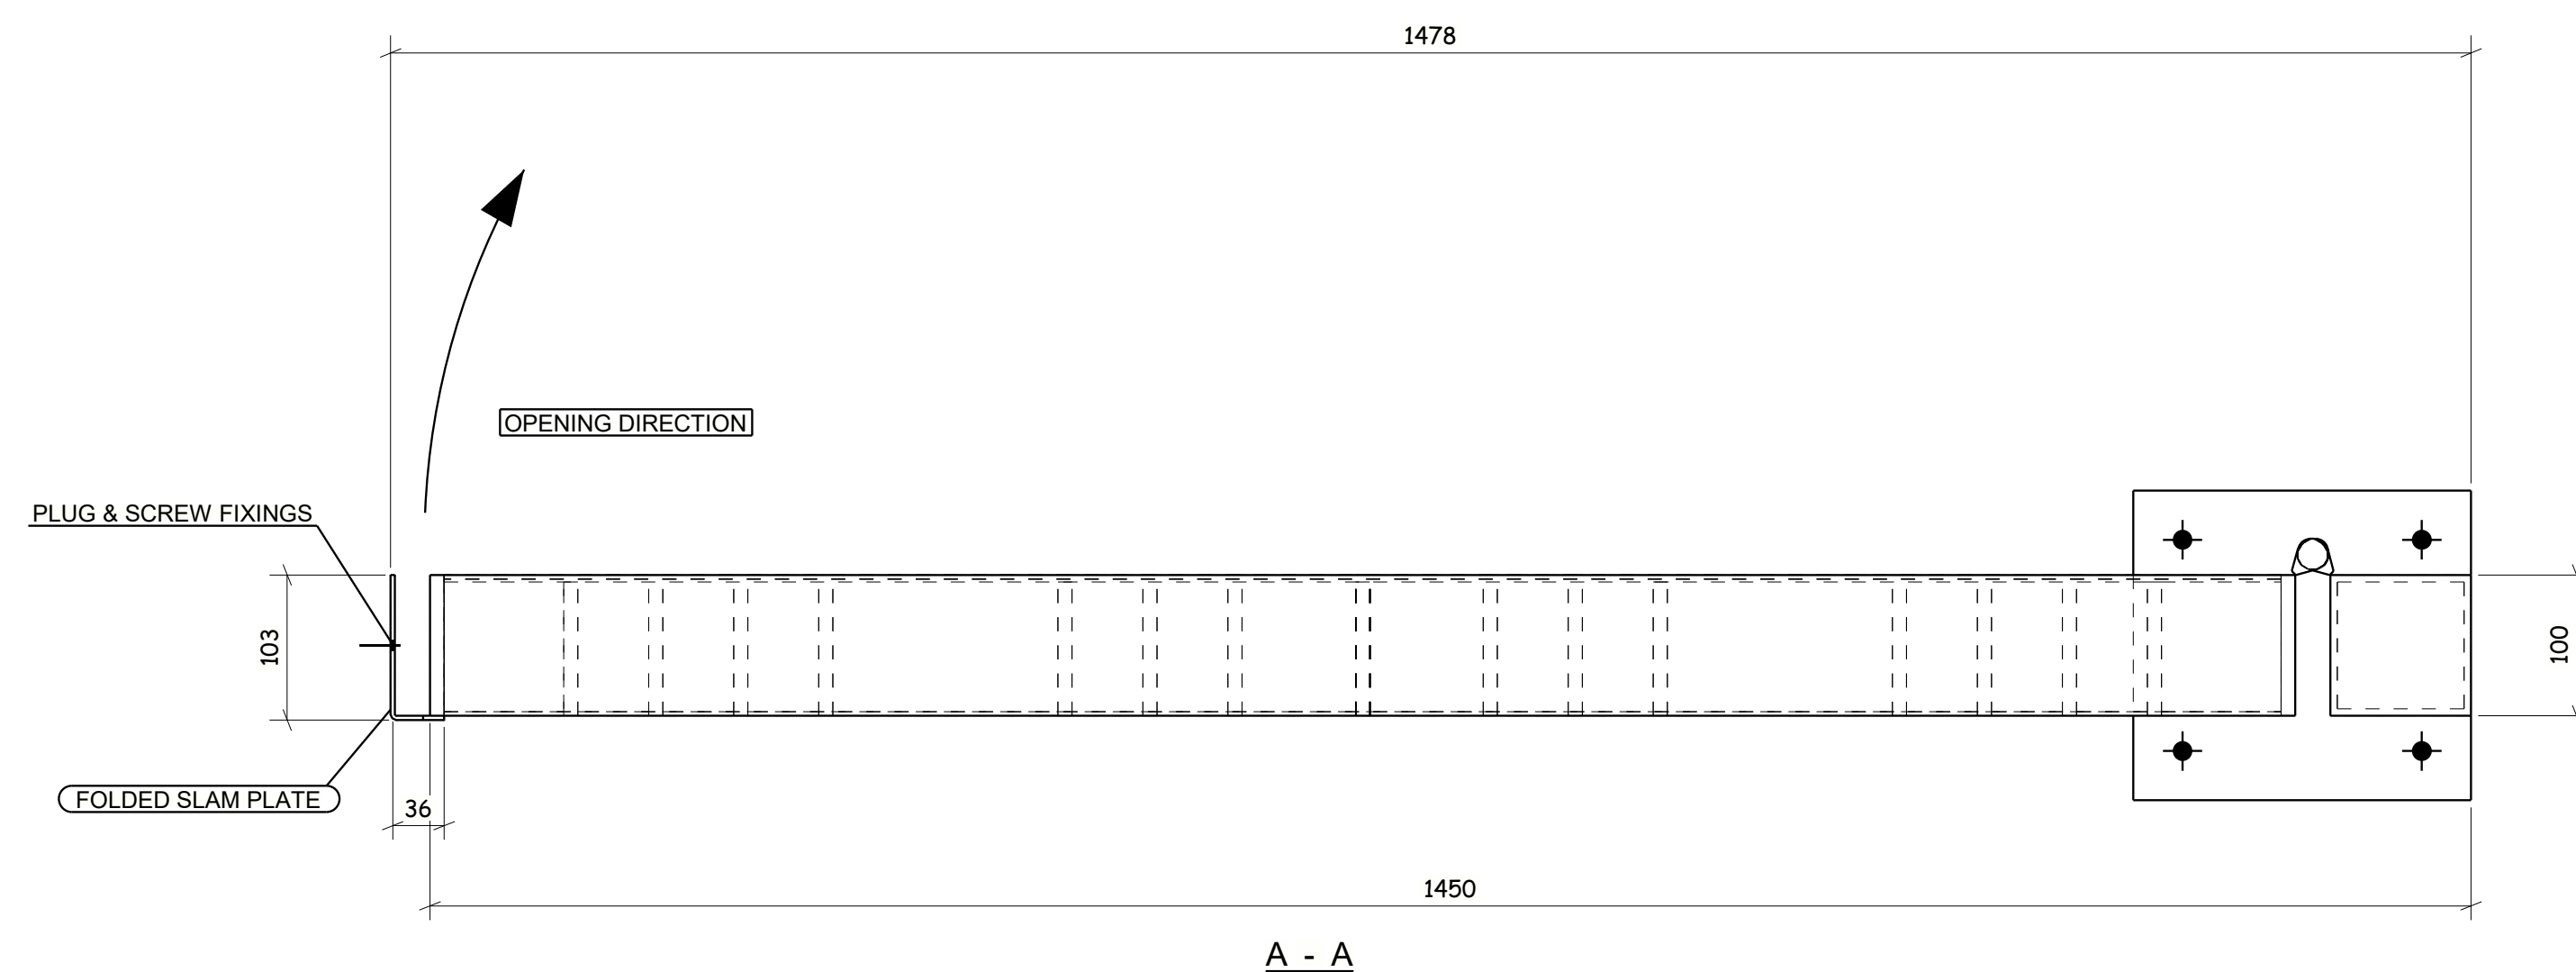

NOTE:

MAIN POST TO BE SHS100*100*5.0

BOTTOM RAIL 3mm PLATE TO MAKE 200*100*3

GATE FRAME TO BE FLT100*10

WELD ON HINGES FROM BARRIER COMPONENTS - (BALL BEARING TYPE)

WELD IN DEAD LOCK

FH BRUNDLES (CODE 05SD60)

GATE INFILLS TO BE FLT100*10

FINISH RAL7022 GLOSS (TBC)

C01	ISSUED FOR COMMENT	15.06.2022
REV MARK	REVISION DESCRIPTION	REVISION DATE
		
DRAWING TITLE	GATE 8 LOW LEVEL HOTEL FIRE ESCAPE	
CONTRACT	HORNSEY TOWN HALL	
MODELLED BY	LT	DATE 10.06.2022
CONTRACT NO	SEL1142	SCALE 1:5 1:7
DRAWING No	7414-10-005	REVISION No. C01


9. Gate 9 – Town Hall Gardens to hotel courtyard

Drawing:

- 7414-10-006

Location:


- Town Hall Gardens at base of steps into hotel courtyard

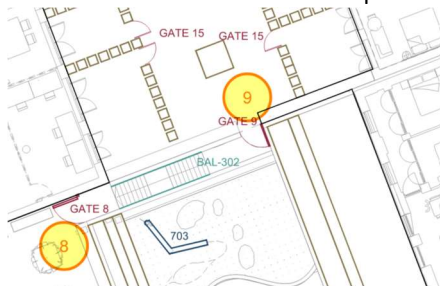




Finish:

- RAL 7016 – anthracite grey

Photograph:

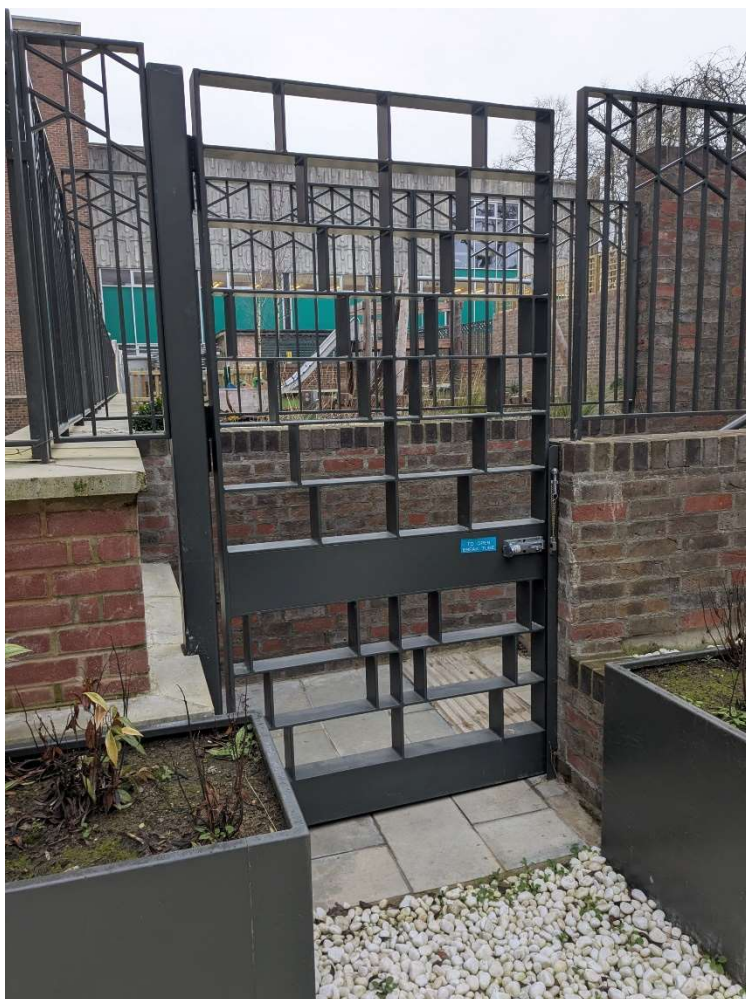

EMERGENCY PUSH BAR LOCK SUPPLIED AND INSTALLED BY OTHERS

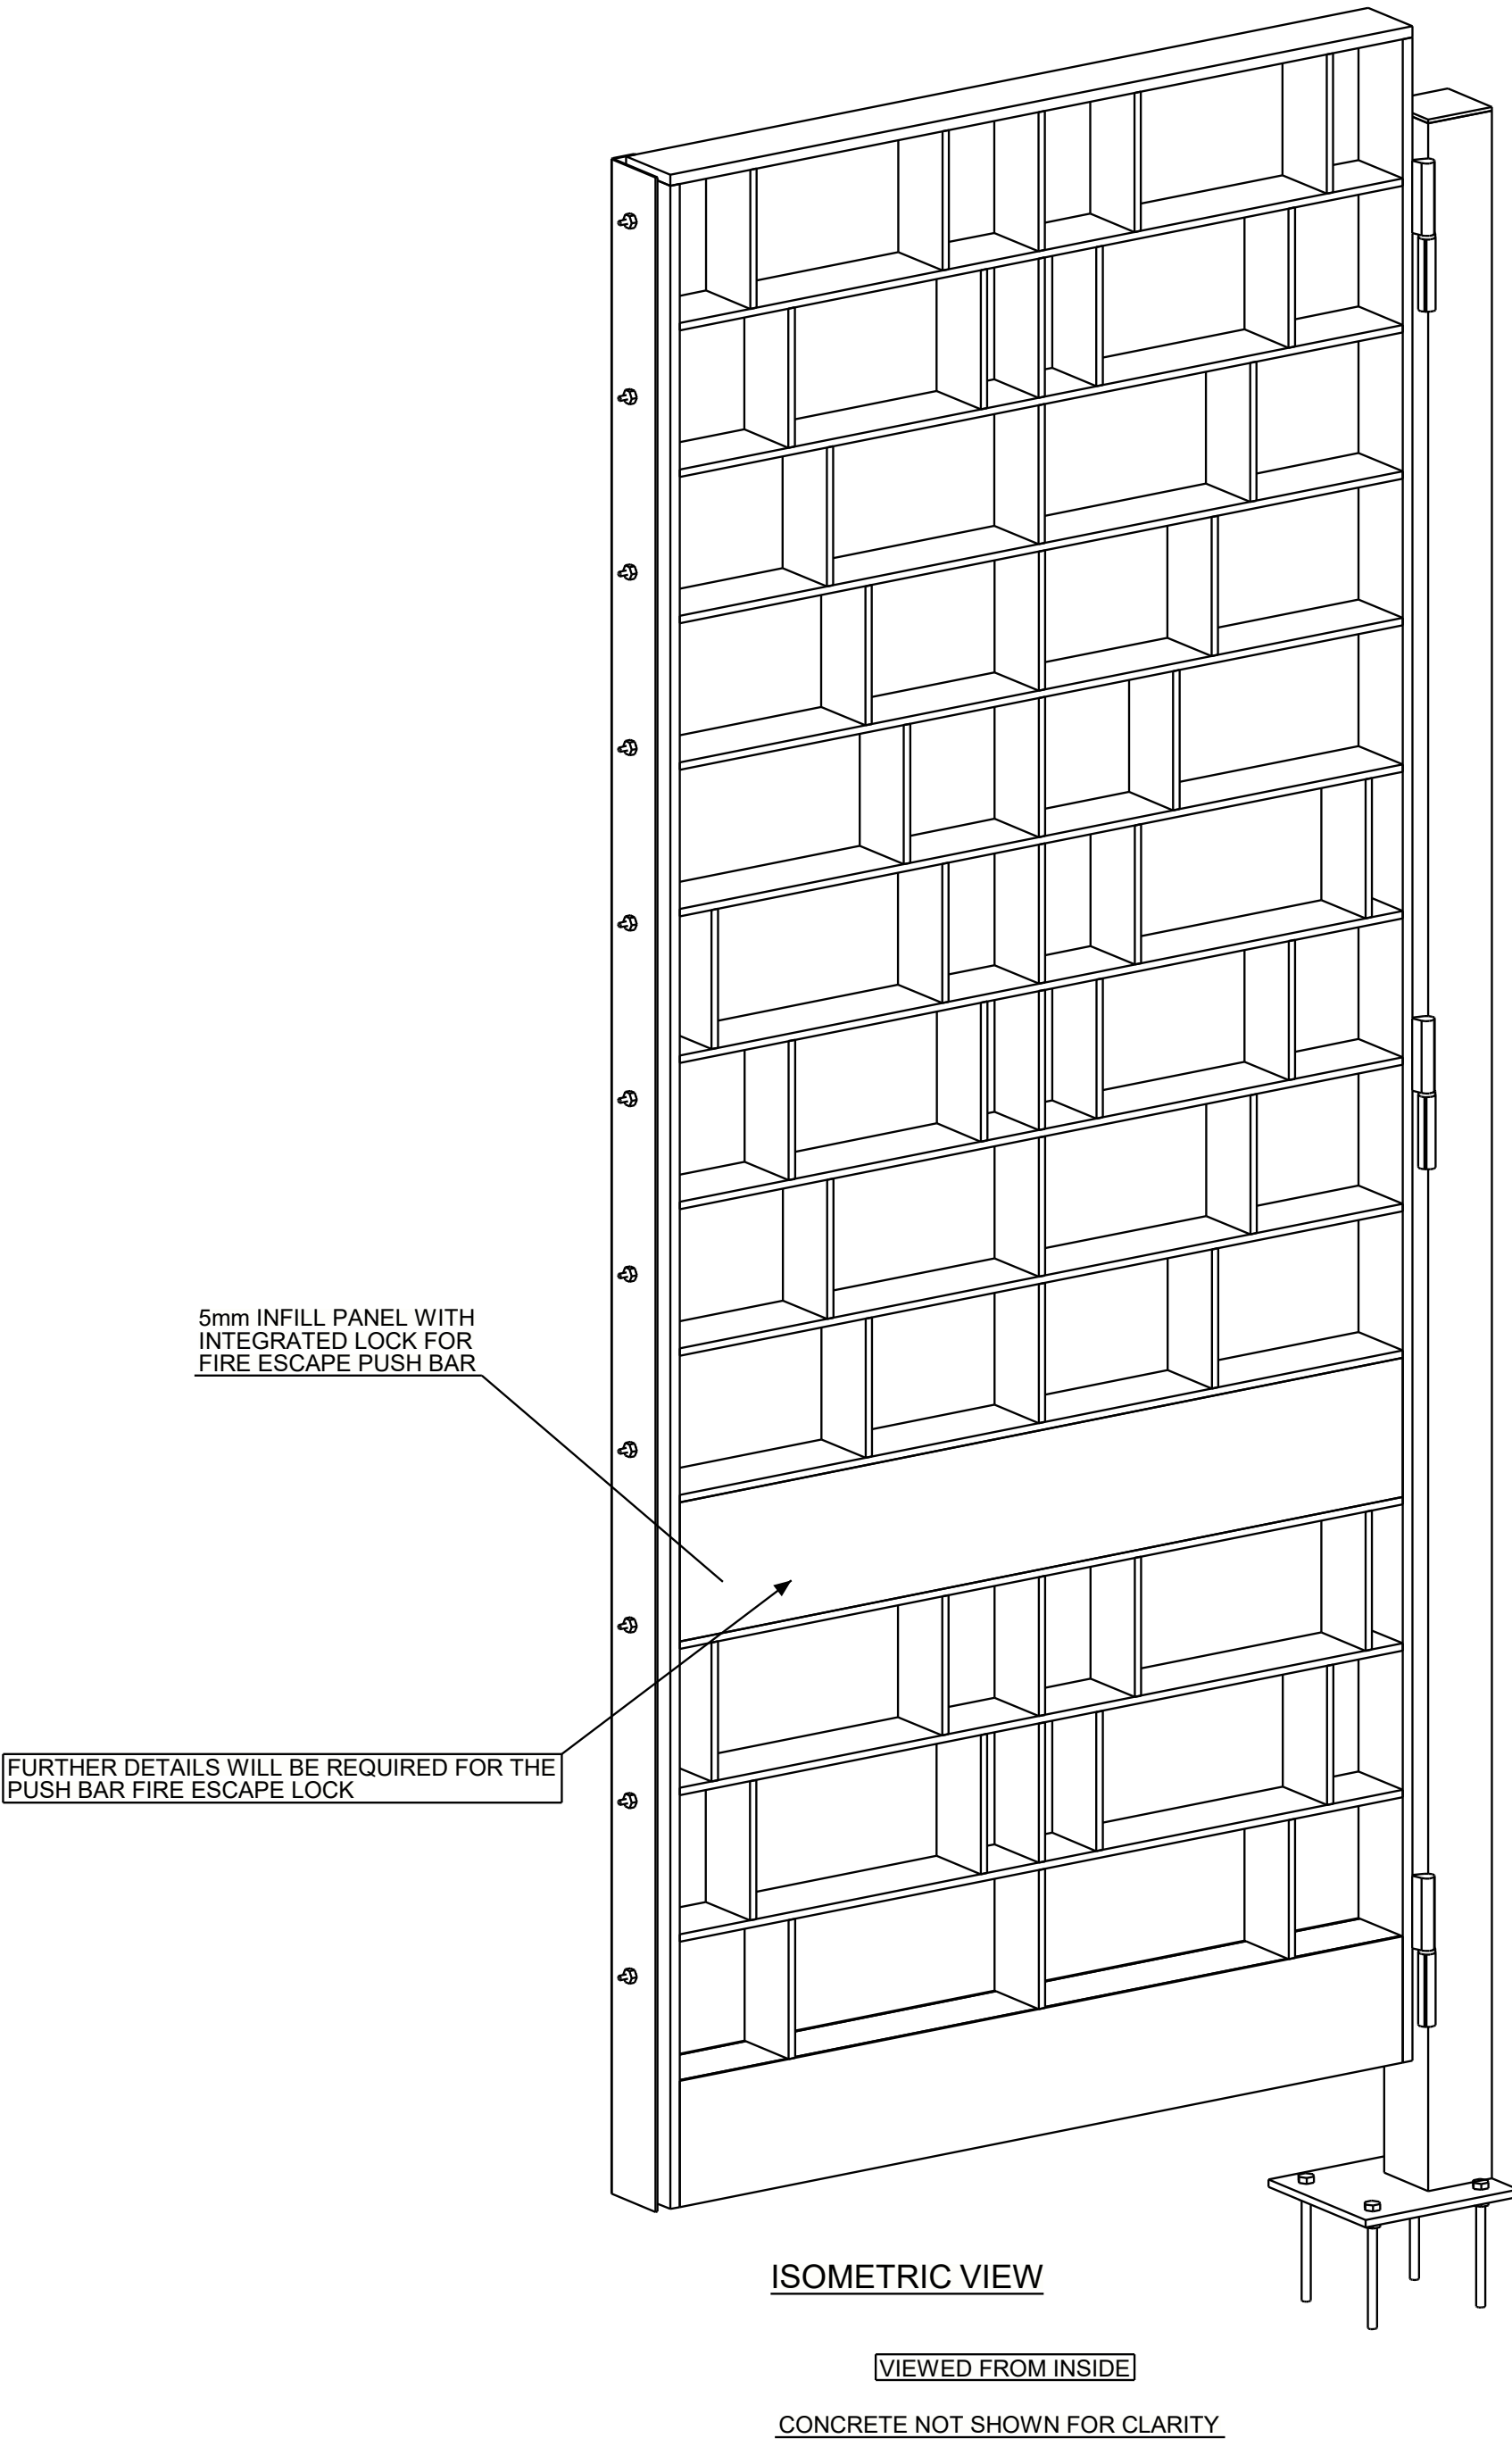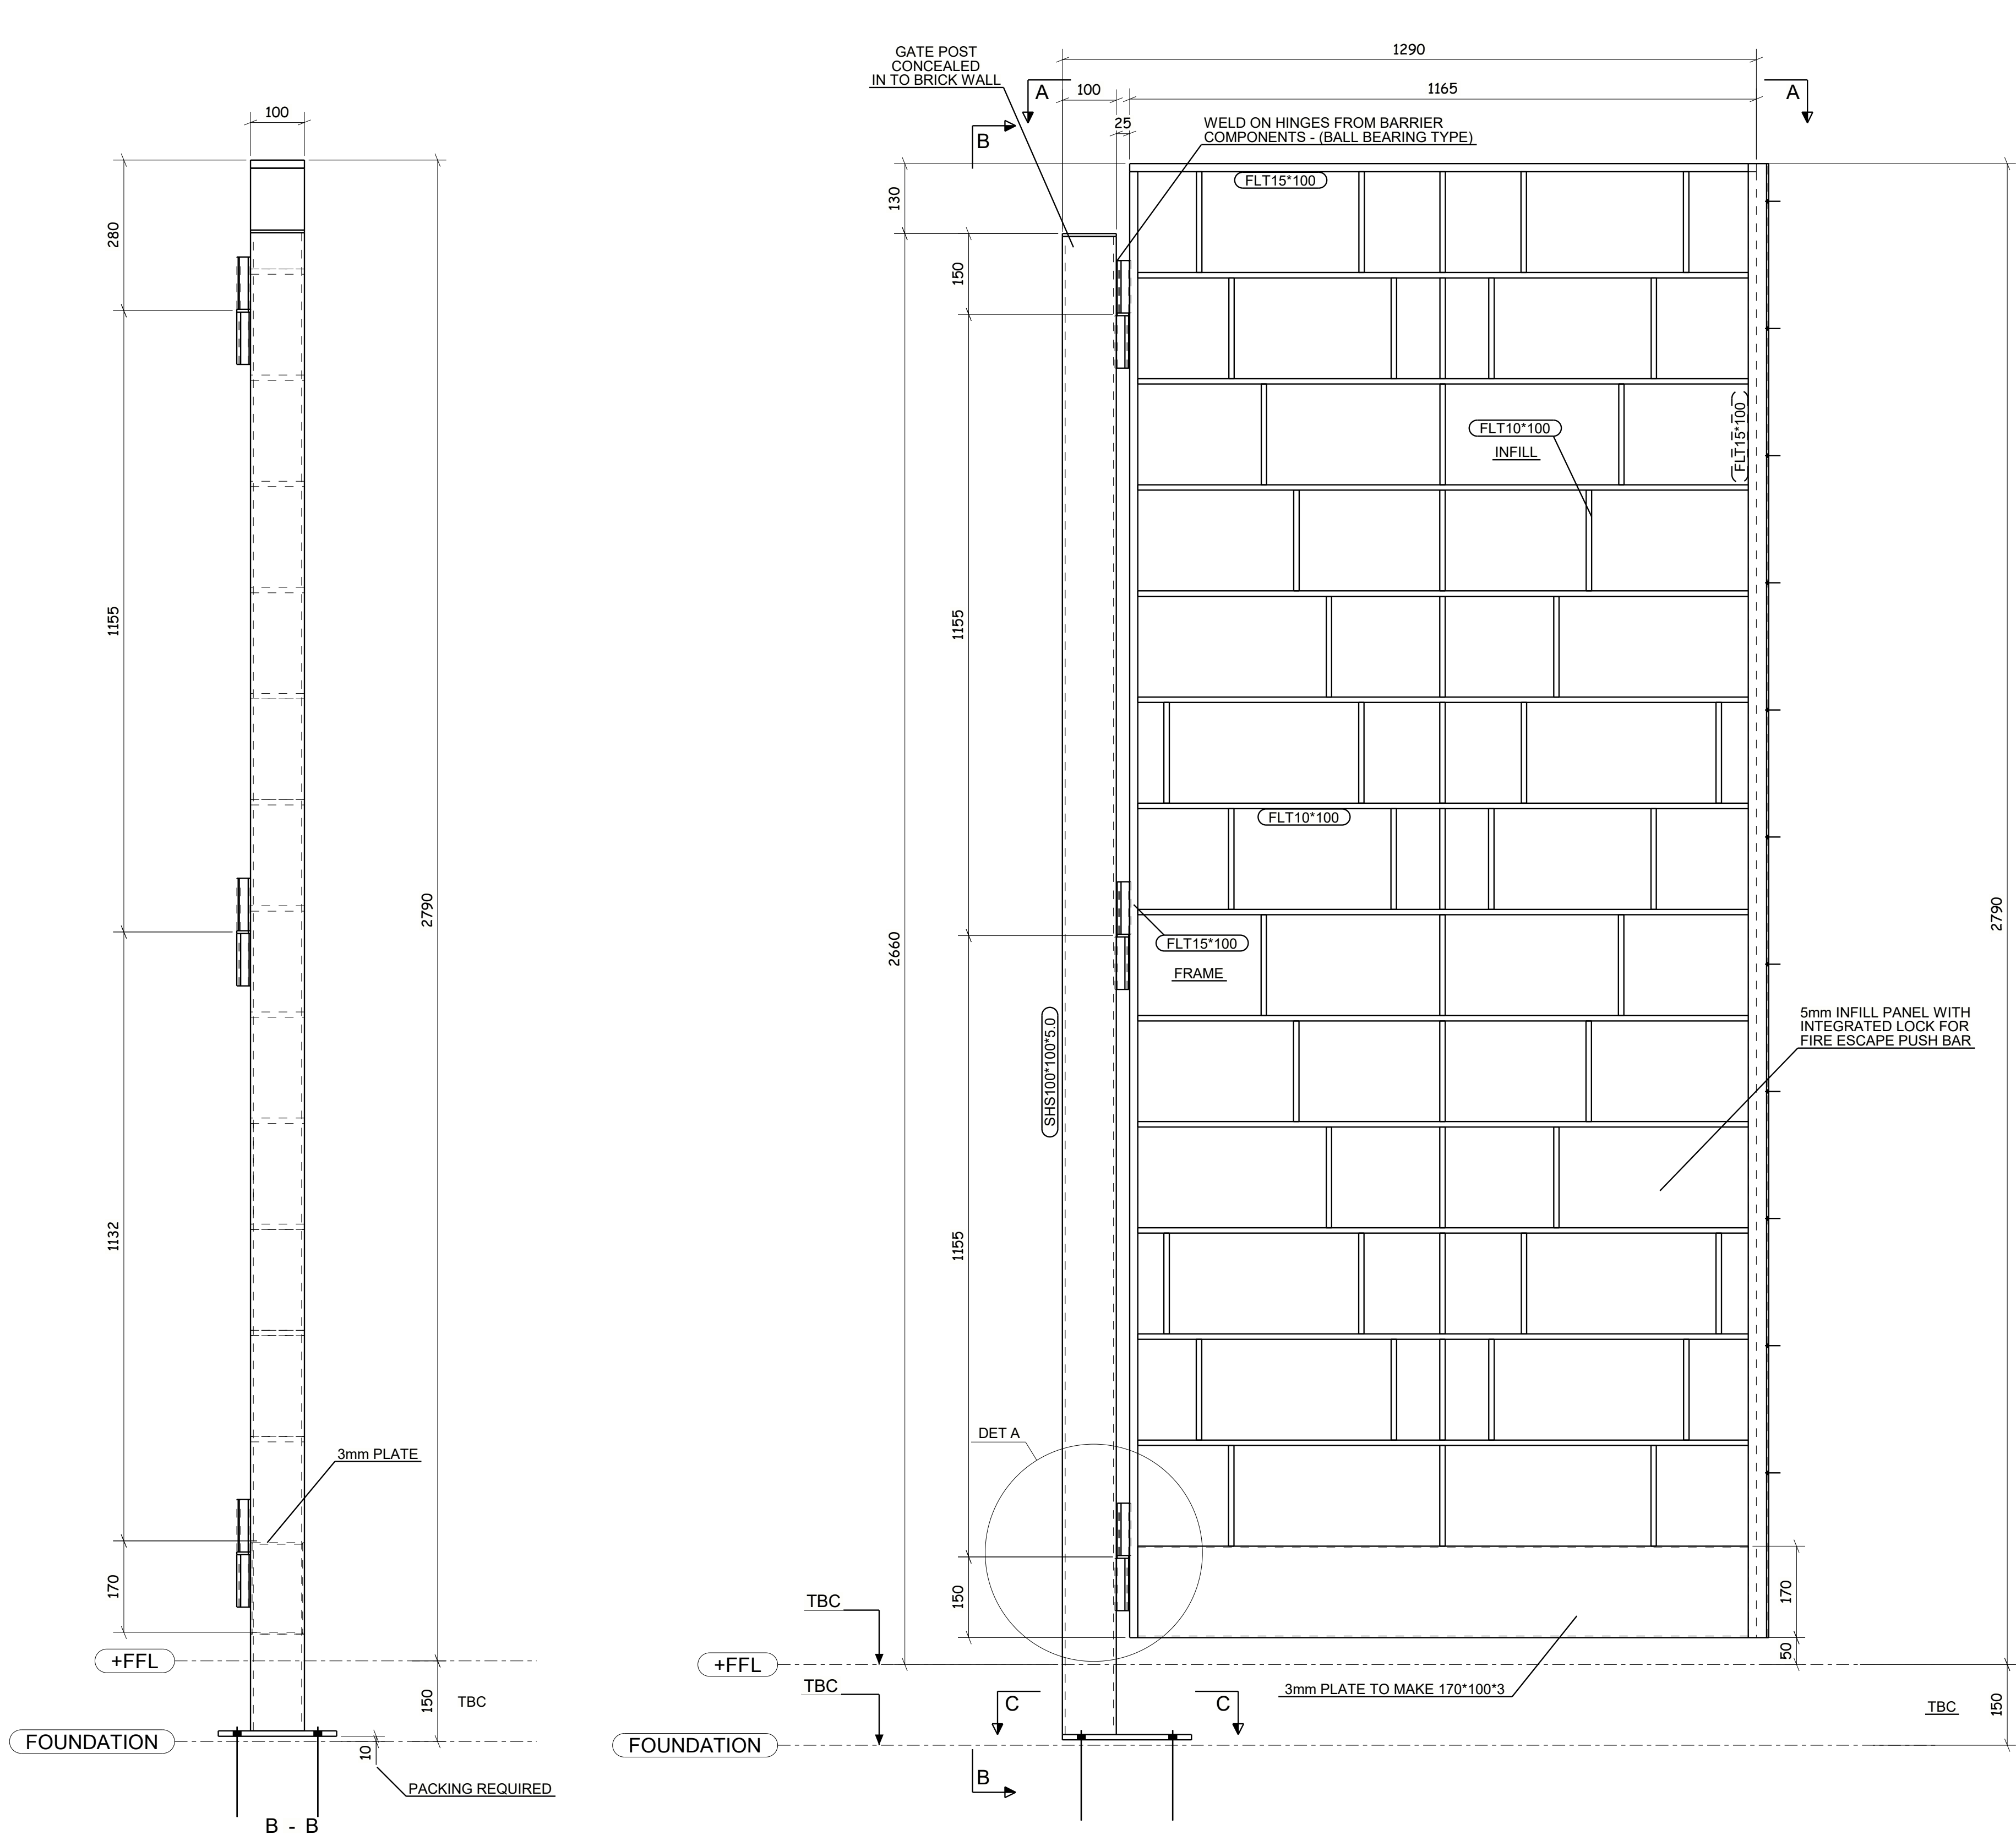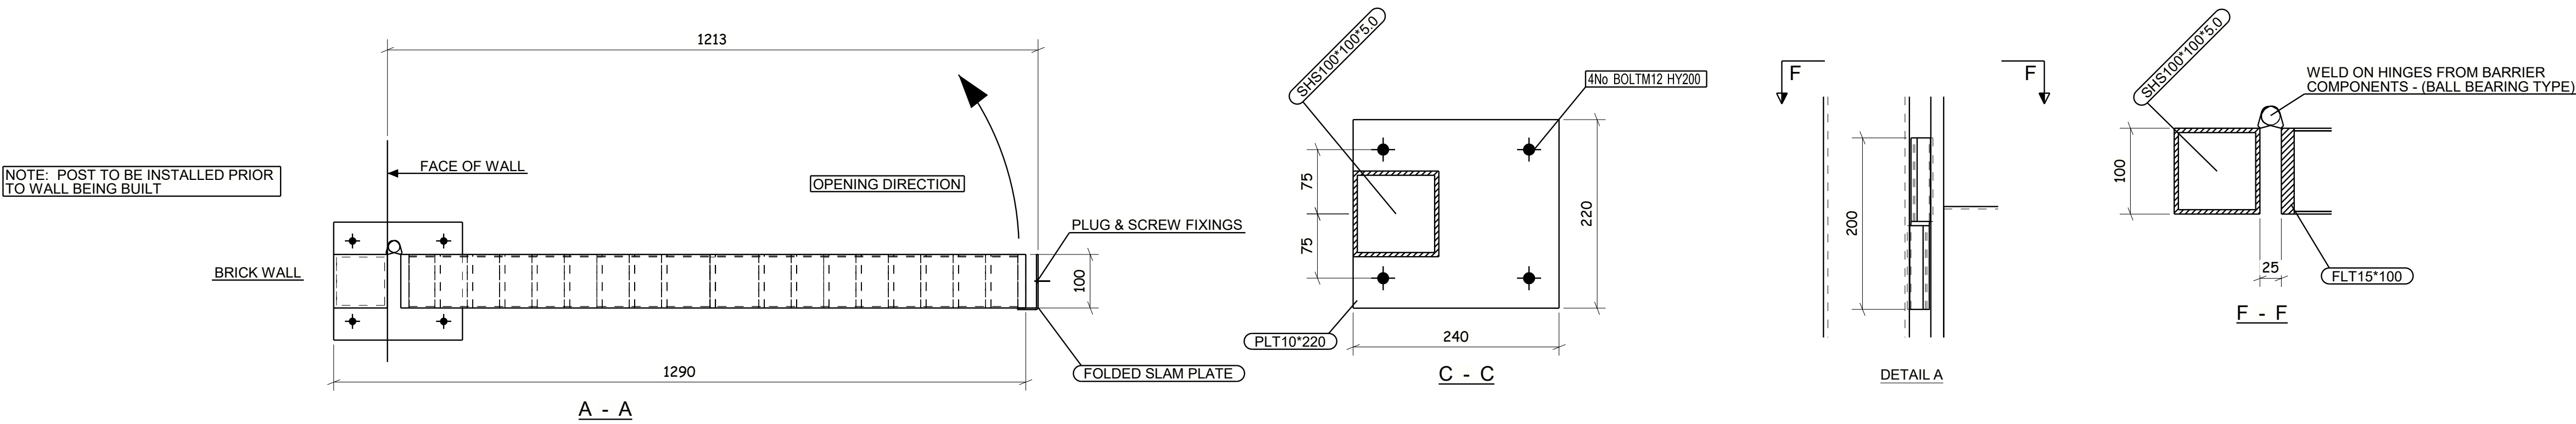

NOTE:

MAIN POST TO BE SHS100*100*5.0

BOTTOM RAIL 3mm PLATE TO MAKE 170*100*3

GATE FRAME TO BE FLT100*15

WELD ON HINGES FROM BARRIER COMPONENTS - (BALL BEARING TYPE)

GATE INFILLS TO BE FLT100*10

WELD IN DEAD LOCK FH BRUNDLES (CODE 05SD60)

FINISH RAL7022 GLOSS (TBC)

C01	ISSUED FOR COMMENT	15.06.2022
REV MARK	REVISION DESCRIPTION	REVISION DATE
		
DRAWING TITLE	GATE 9 FULL HEIGHT HOTEL FIRE ESCAPE	
CONTRACT	HORNSEY TOWN HALL	
MODELLER BY	LT	DATE 10.06.2022
CONTRACT NO	SEL1142	SCALE 1:5 1:8 1:9
DRAWING No	7414-10-006	REVISION No. C01

10. Gate 10 – UKPN access to substation

Drawing:

- 7414-08-003

Location:

- Access to the substation at the rear of block A







Finish:

- RAL 7016 – anthracite grey

Photograph:



NOTES:
GATE FRAME:
90 x 50 x 5 RHS
50 x 50 x 5 SHS
INFILL BARS:
20 x 12 FLAT BAR
POSTS:
120 x 120 x 8 SHS
FINISH = HOT ZINC SPRAYED & PPC RAL 7022

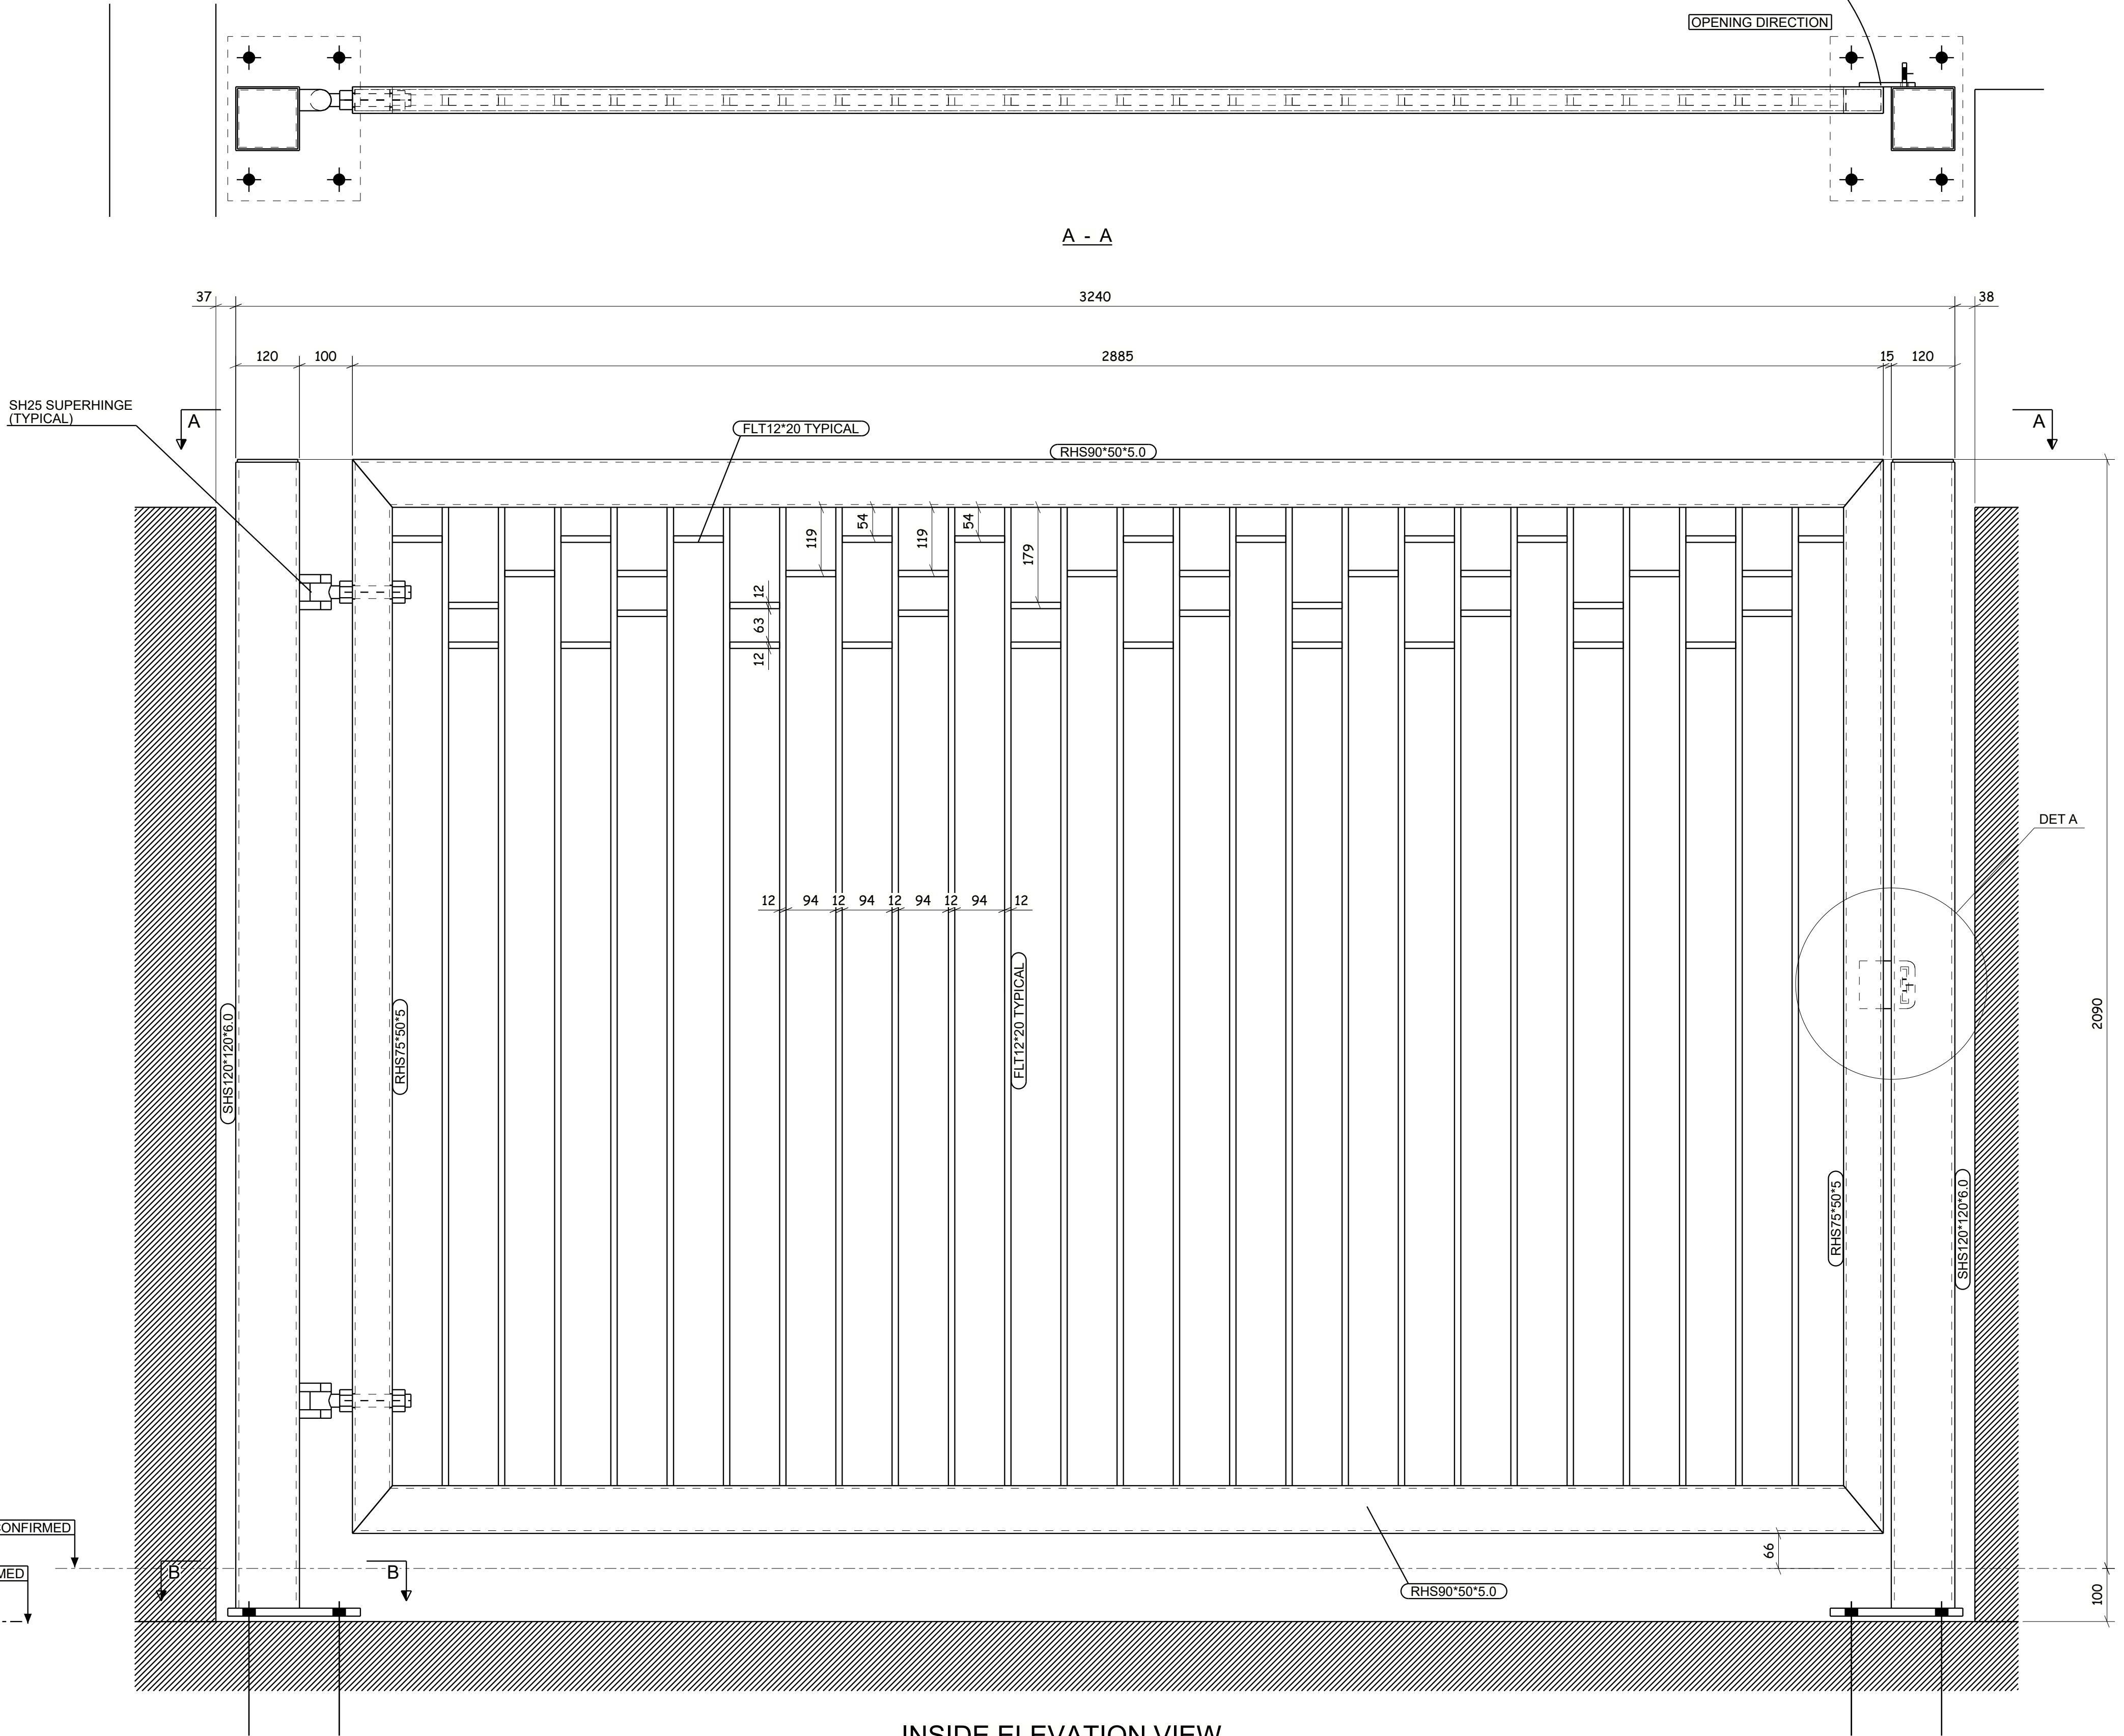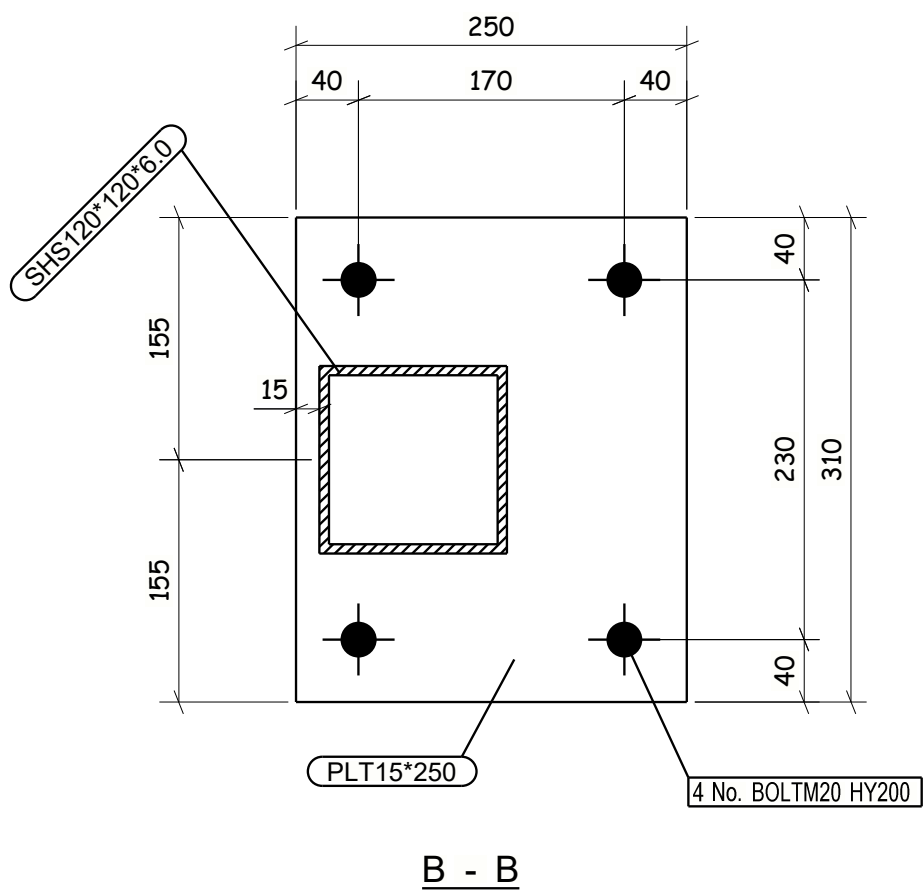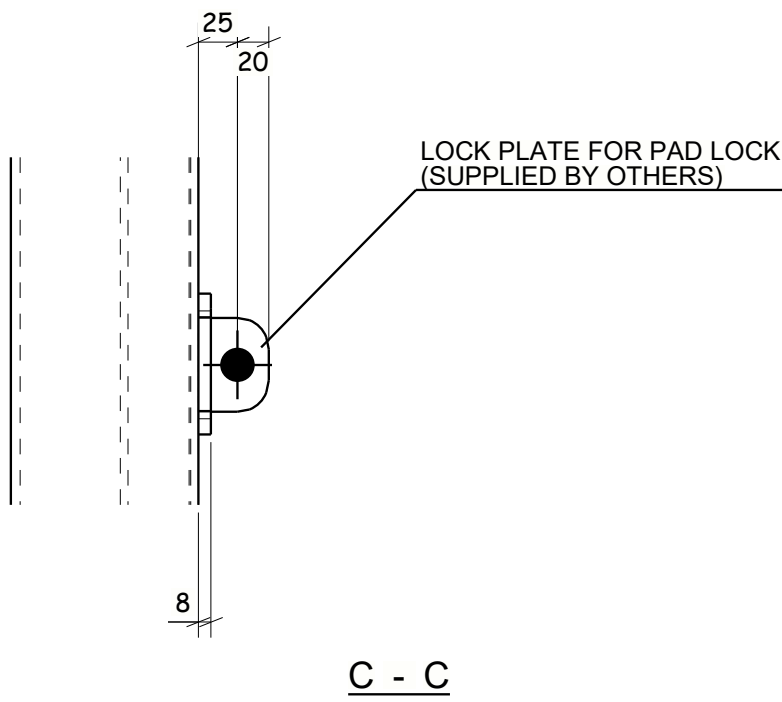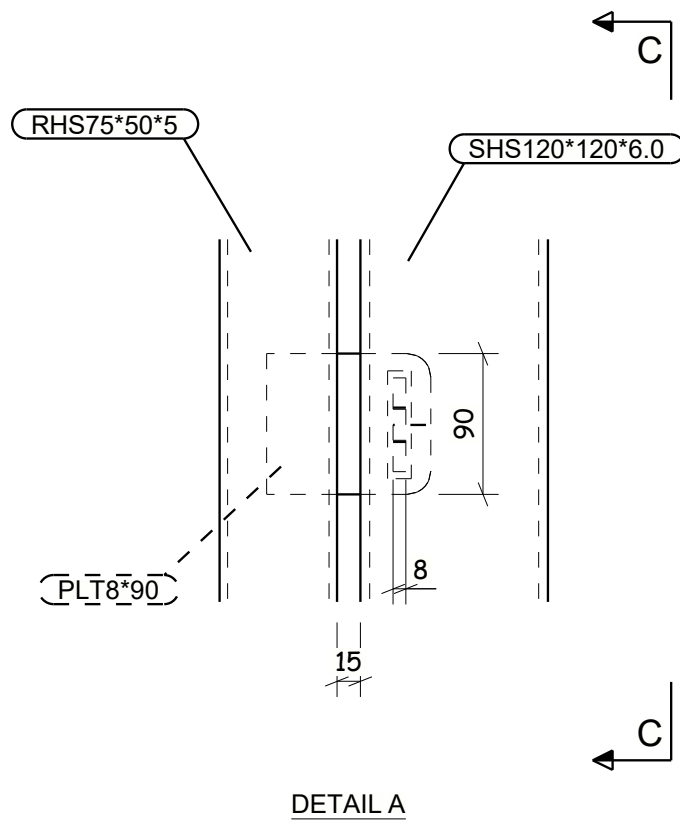

C03	ISSUED FOR CONSTRUCTION	28.06.2022
C02	GATE REVISED TO BECOME ONE LEAF	15.06.2022
C01	ISSUED FOR COMMENT	03.05.2022
REV MARK	REVISION DESCRIPTION	REVISION DATE
ARDMORE GROUP		
DRAWING TITLE	ENTRANCE GATE 10 DETAILS	
CONTRACT	HORNSEY - ENTRANCE GATES	
MODELLED BY	RJH	DATE 03.05.2022
CONTRACT NO	SEL1142	SCALE 1:5 1:7.5
DRAWING No	7414-08-003	REVISION No. C03


11. Gate 11 – Access road at the rear of block A

Drawing:

- 7414-08-002

Location:

- Rear of block A, access road

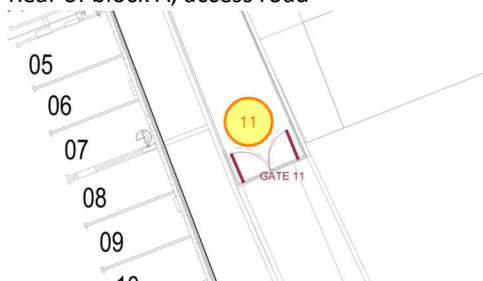





Finish:

- RAL 7016 – anthracite grey

Photograph:



NOTES:
GATE FRAME:
90 x 50 x 5 RHS
50 x 50 x 5 SHS
INFILL BARS:
20 x 12 FLAT BAR
POSTS:
120 x 120 x 8 SHS
FINISH = HOT ZINC SPRAYED & PPC RAL 7022

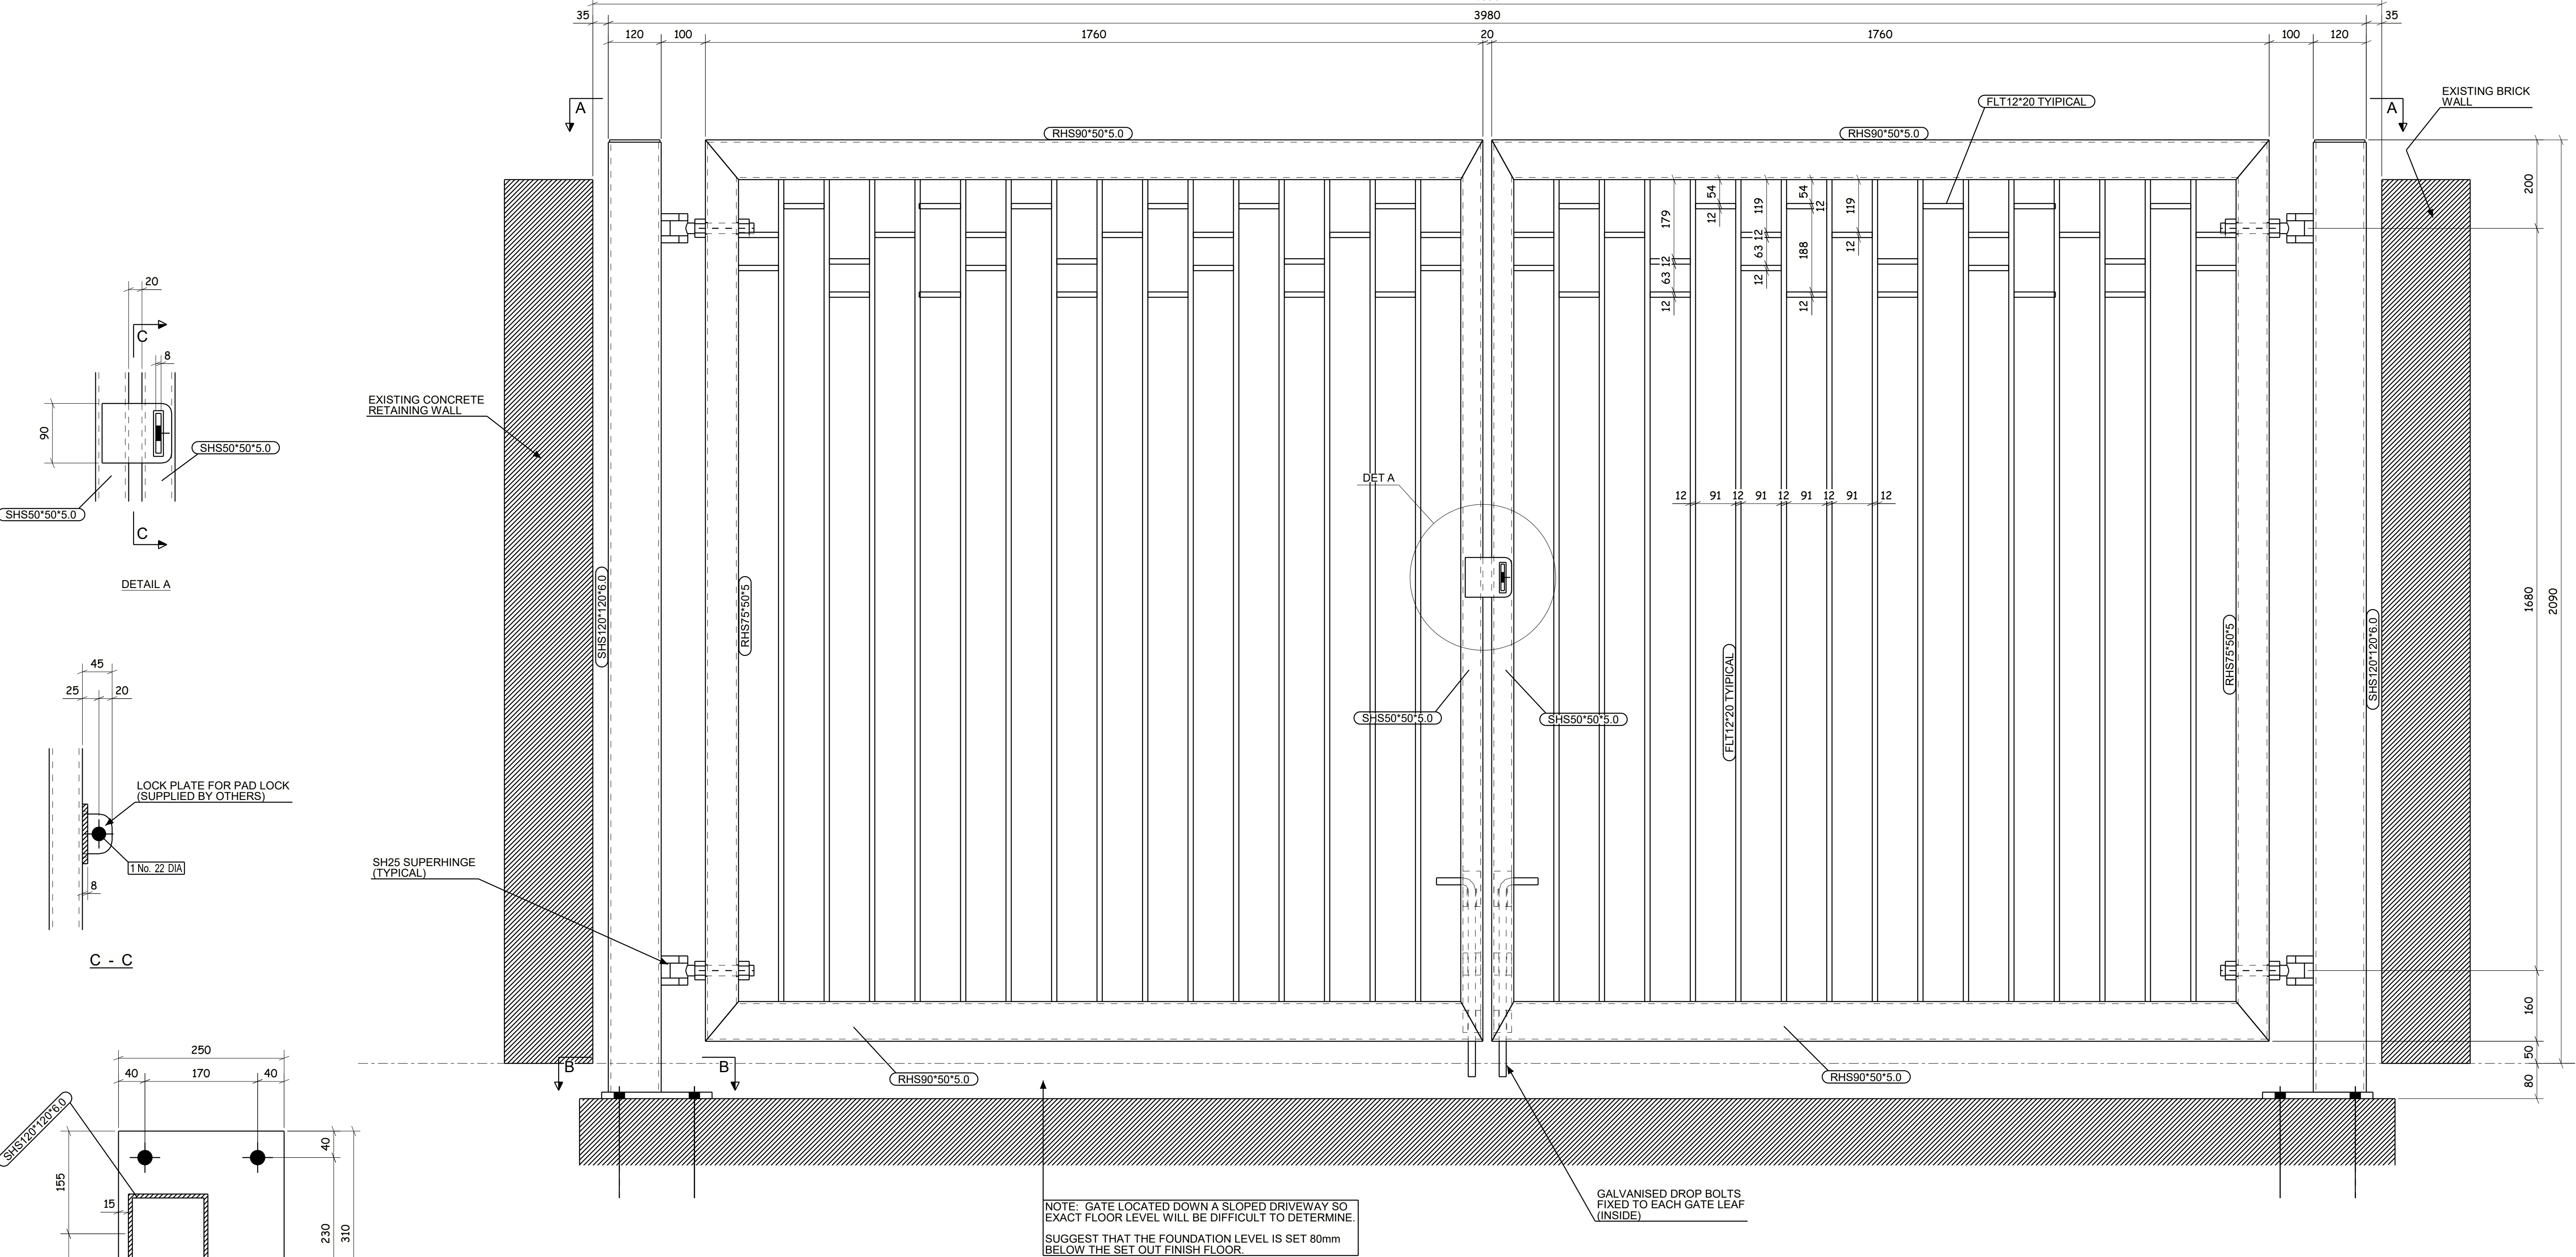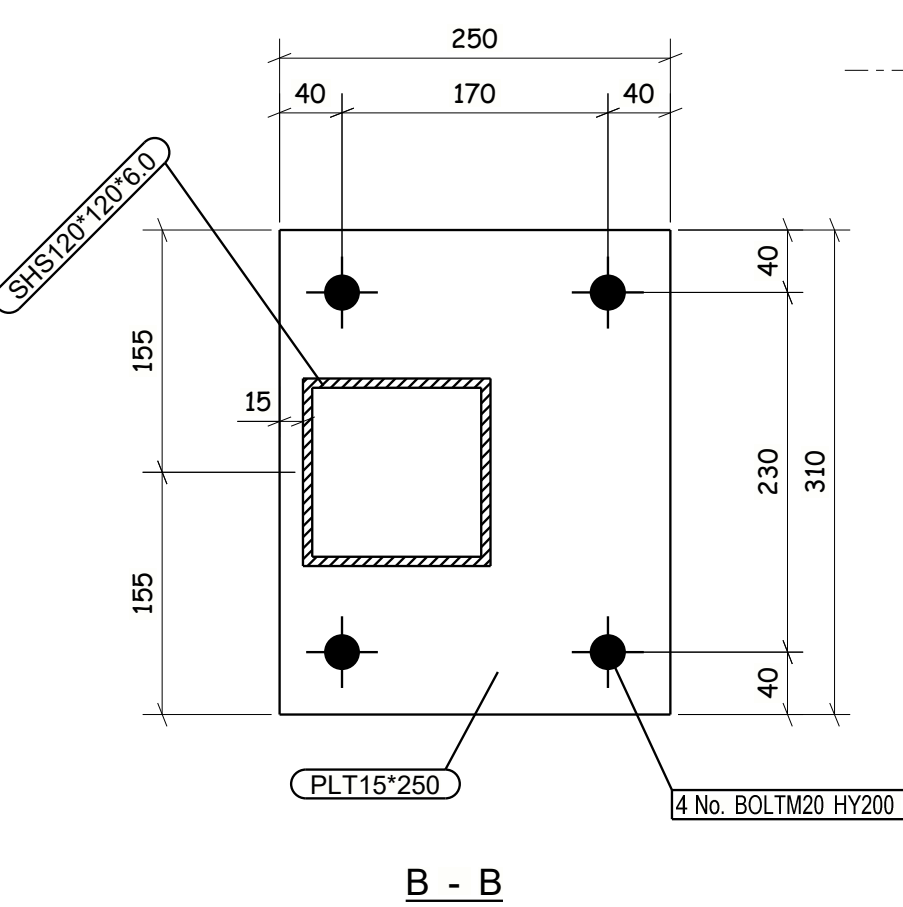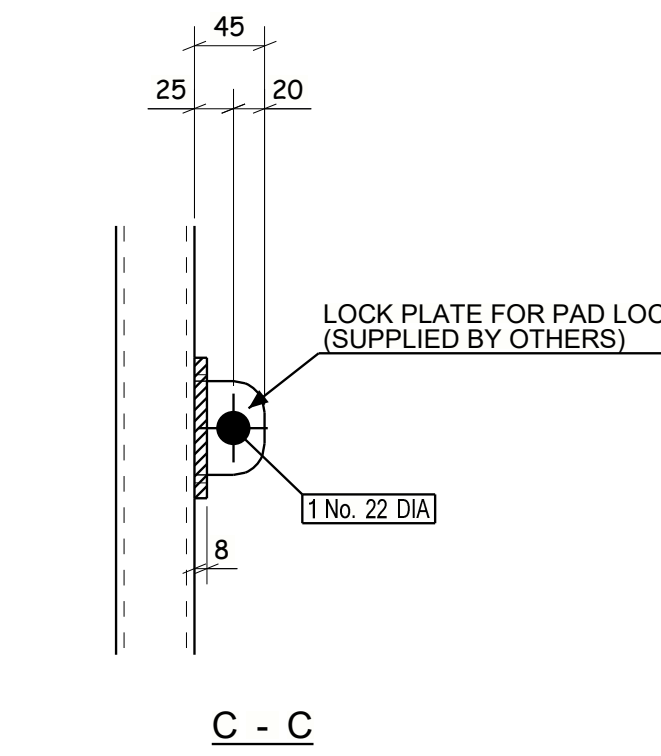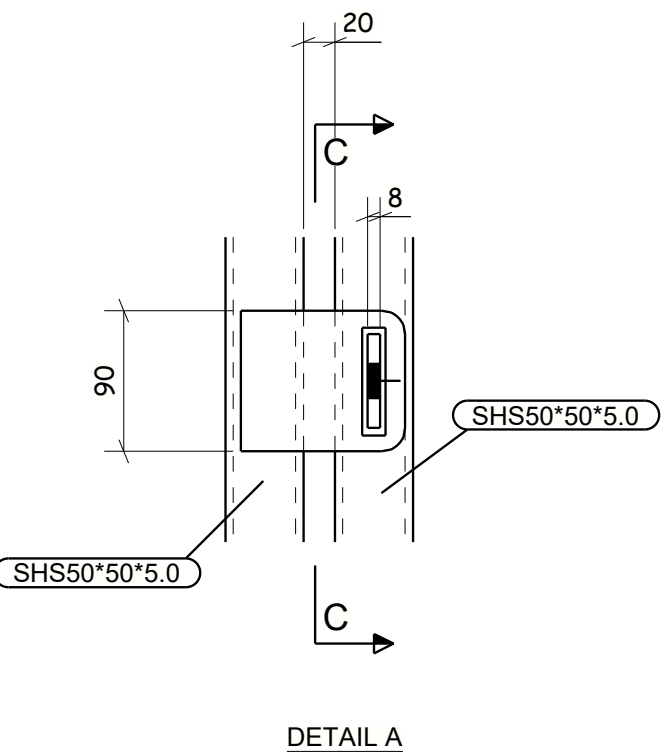

NOTE: GATE LOCATED DOWN A SLOPED DRIVEWAY SO EXACT FLOOR LEVEL WILL BE DIFFICULT TO DETERMINE. SUGGEST THAT THE FOUNDATION LEVEL IS SET 80mm BELOW THE SET OUT FINISH FLOOR.

GALVANISED DROP BOLTS FIXED TO EACH GATE LEAF (INSIDE)

C01	ISSUED FOR COMMENT	03.05.2022
REV MARK	REVISION DESCRIPTION	REVISION DATE
ARDMORE GROUP		
DRAWING TITLE	ENTRANCE GATE 11 DETAILS	
CONTRACT	HORNSEY - ENTRANCE GATES	
MODELLED BY	RJH	DATE 03.05.2022
CONTRACT NO	SEL1142	SCALE 1:5 1:7.5
DRAWING No	7414-08-002	REVISION No. C01

12. Gate 12 – Access road at the rear of block A

Drawing:

- 7414-08-003

Location:

- Rear of block A, access road







Finish:

- RAL 7016 – anthracite grey

Photograph:



NOTES:
GATE FRAME:
90 x 50 x 5 RHS
50 x 50 x 5 SHS
INFILL BARS:
20 x 12 FLAT BAR
POSTS:
120 x 120 x 8 SHS
FINISH = HOT ZINC SPRAYED & PPC RAL 7022

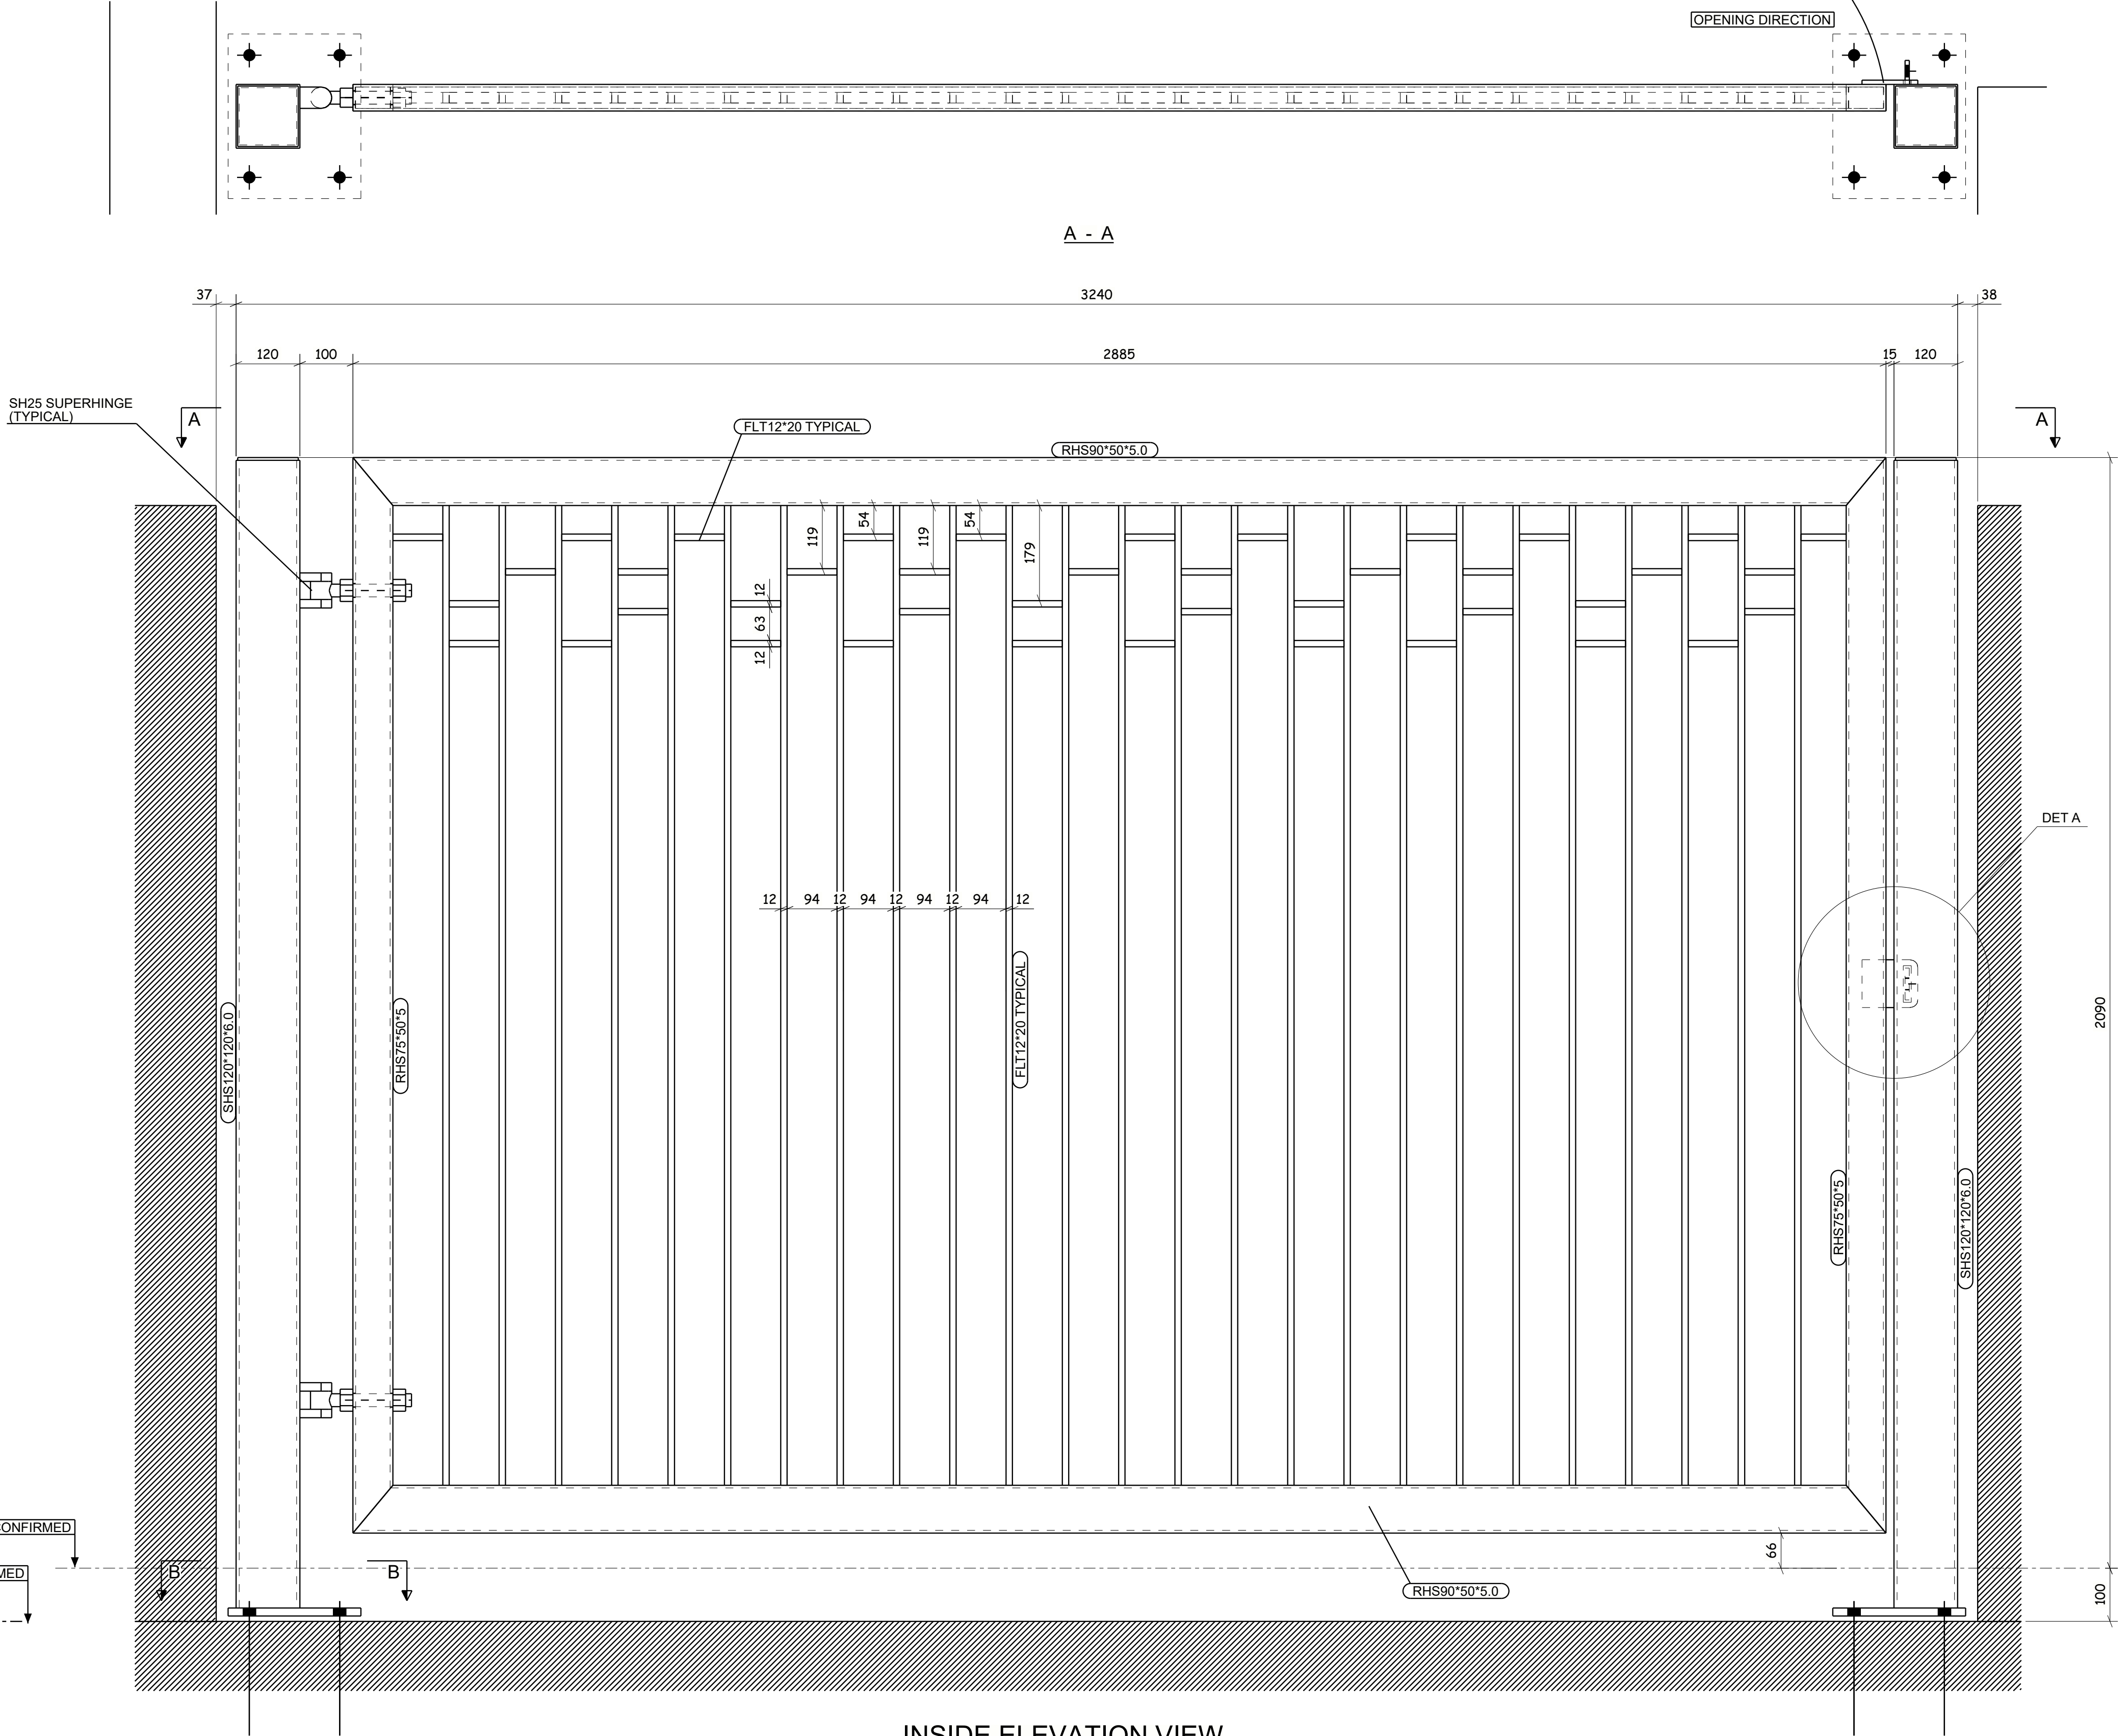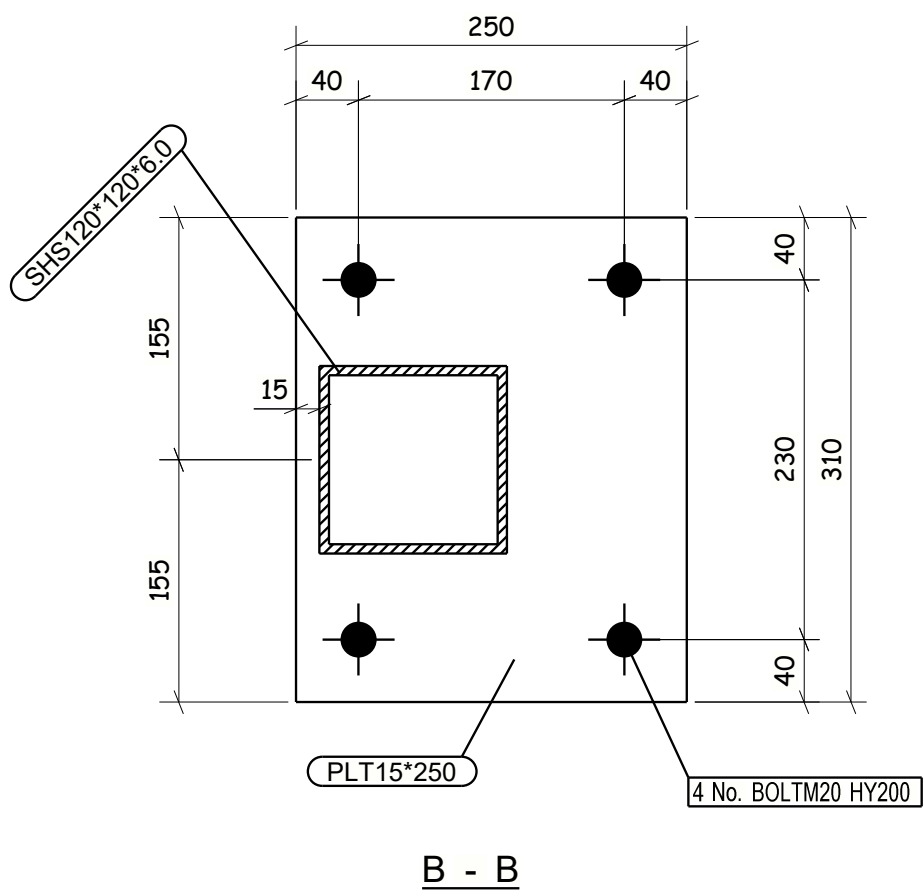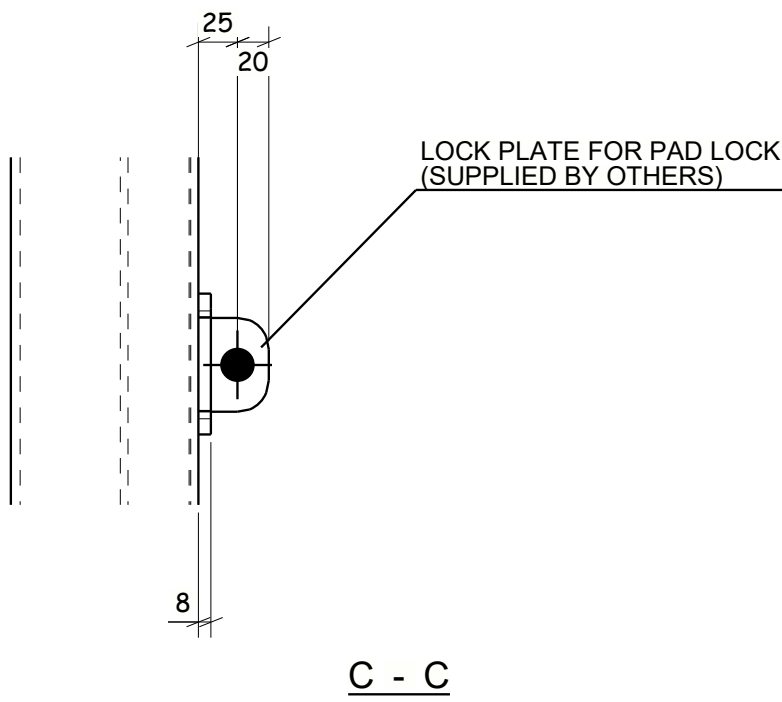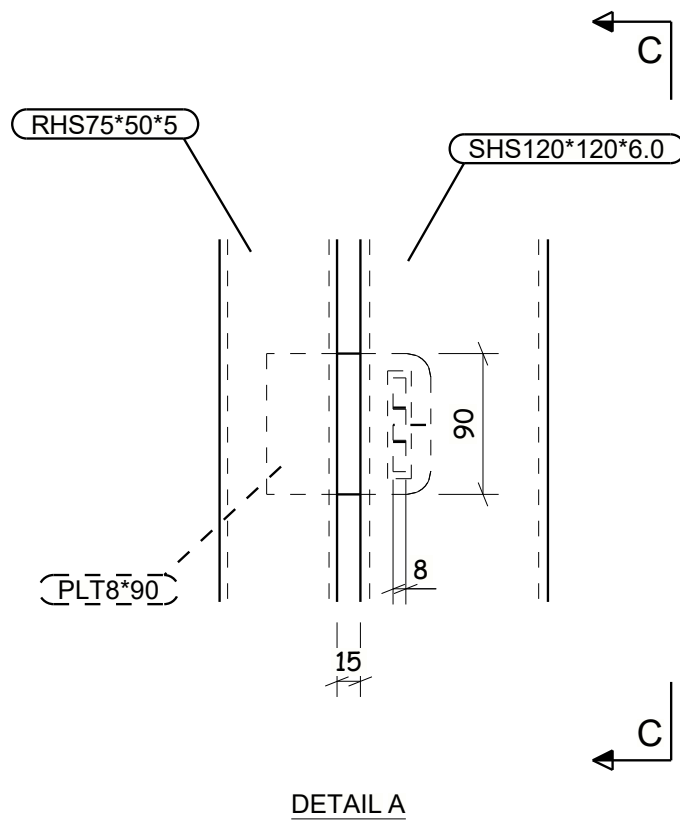

C03	ISSUED FOR CONSTRUCTION	28.06.2022
C02	GATE REVISED TO BECOME ONE LEAF	15.06.2022
C01	ISSUED FOR COMMENT	03.05.2022
REV MARK	REVISION DESCRIPTION	REVISION DATE
ARDMORE GROUP		
DRAWING TITLE	ENTRANCE GATE 10 DETAILS	
CONTRACT	HORNSEY - ENTRANCE GATES	
MODELLED BY	RJH	DATE 03.05.2022
CONTRACT NO	SEL1142	SCALE 1:5 1:7.5
DRAWING No	7414-08-003	REVISION No. C03


13. Gate 13 – Access from block B access road to Town Hall Gardens

Drawing:

- 7414-10-002

Location:

- Block B access road through to Town Hall Gardens

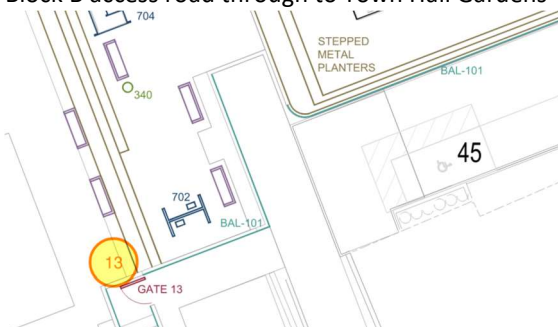









Finish:

- RAL 7016 – anthracite grey

Photograph:



[ANY AUTOMATION, MAG LOCK OR CLOSER TO BE SUPPLIED BY OTHERS]

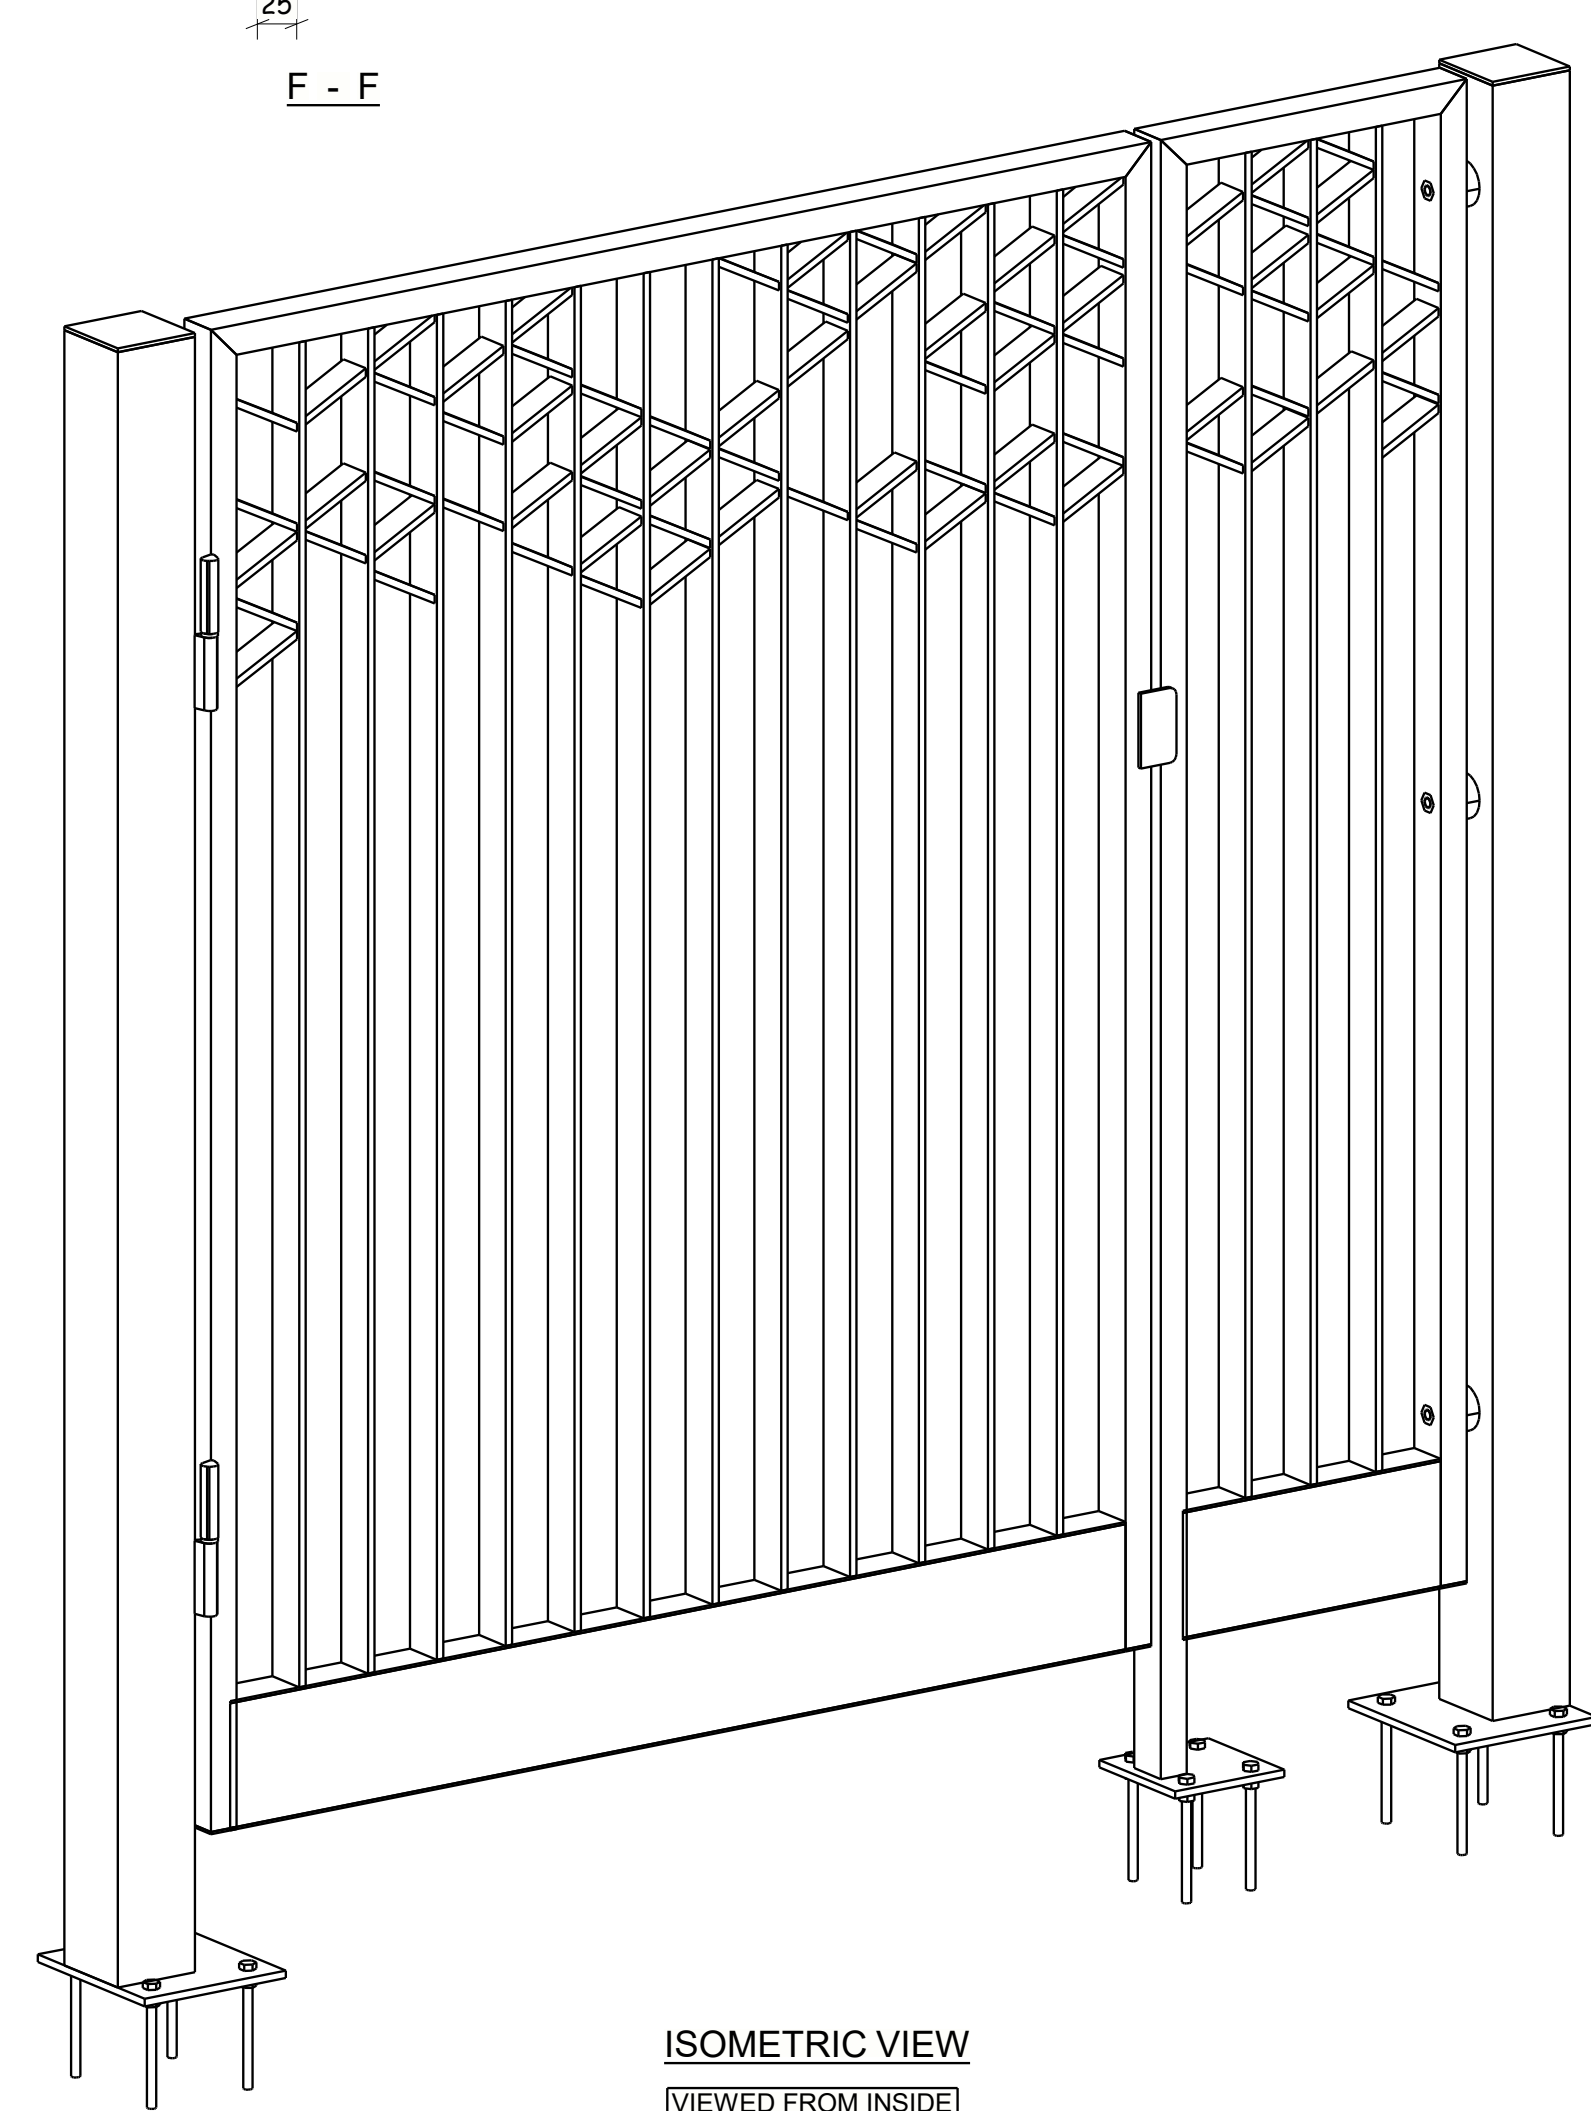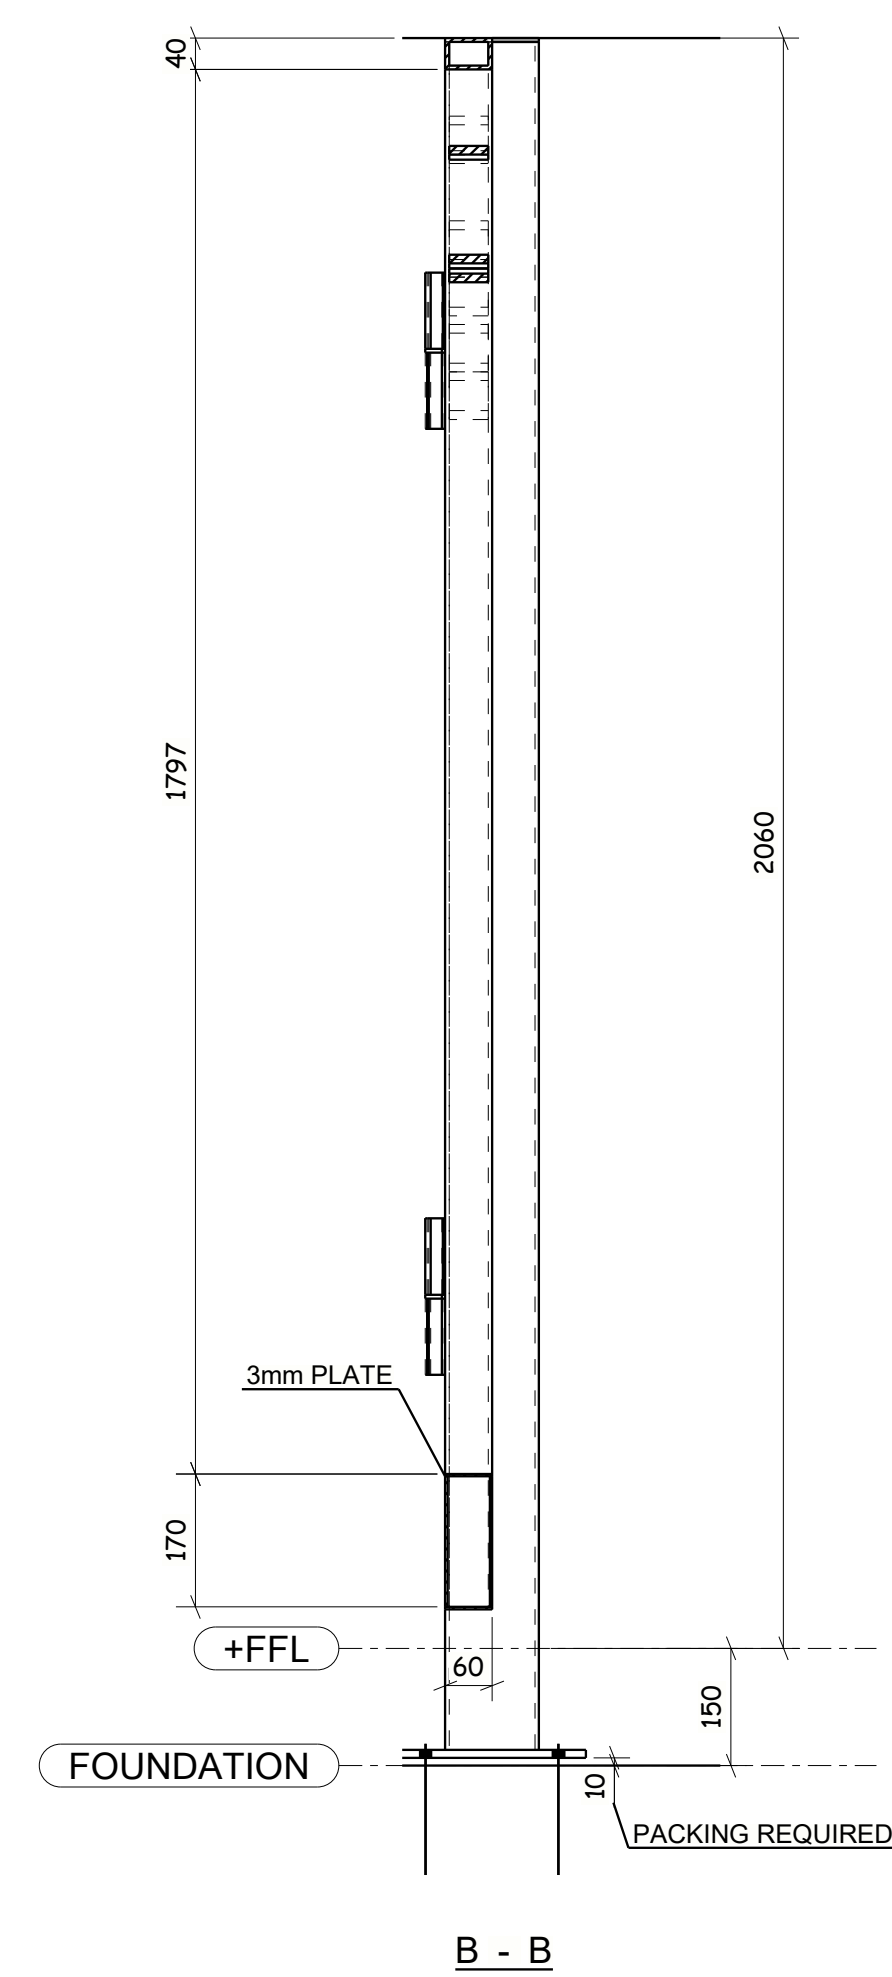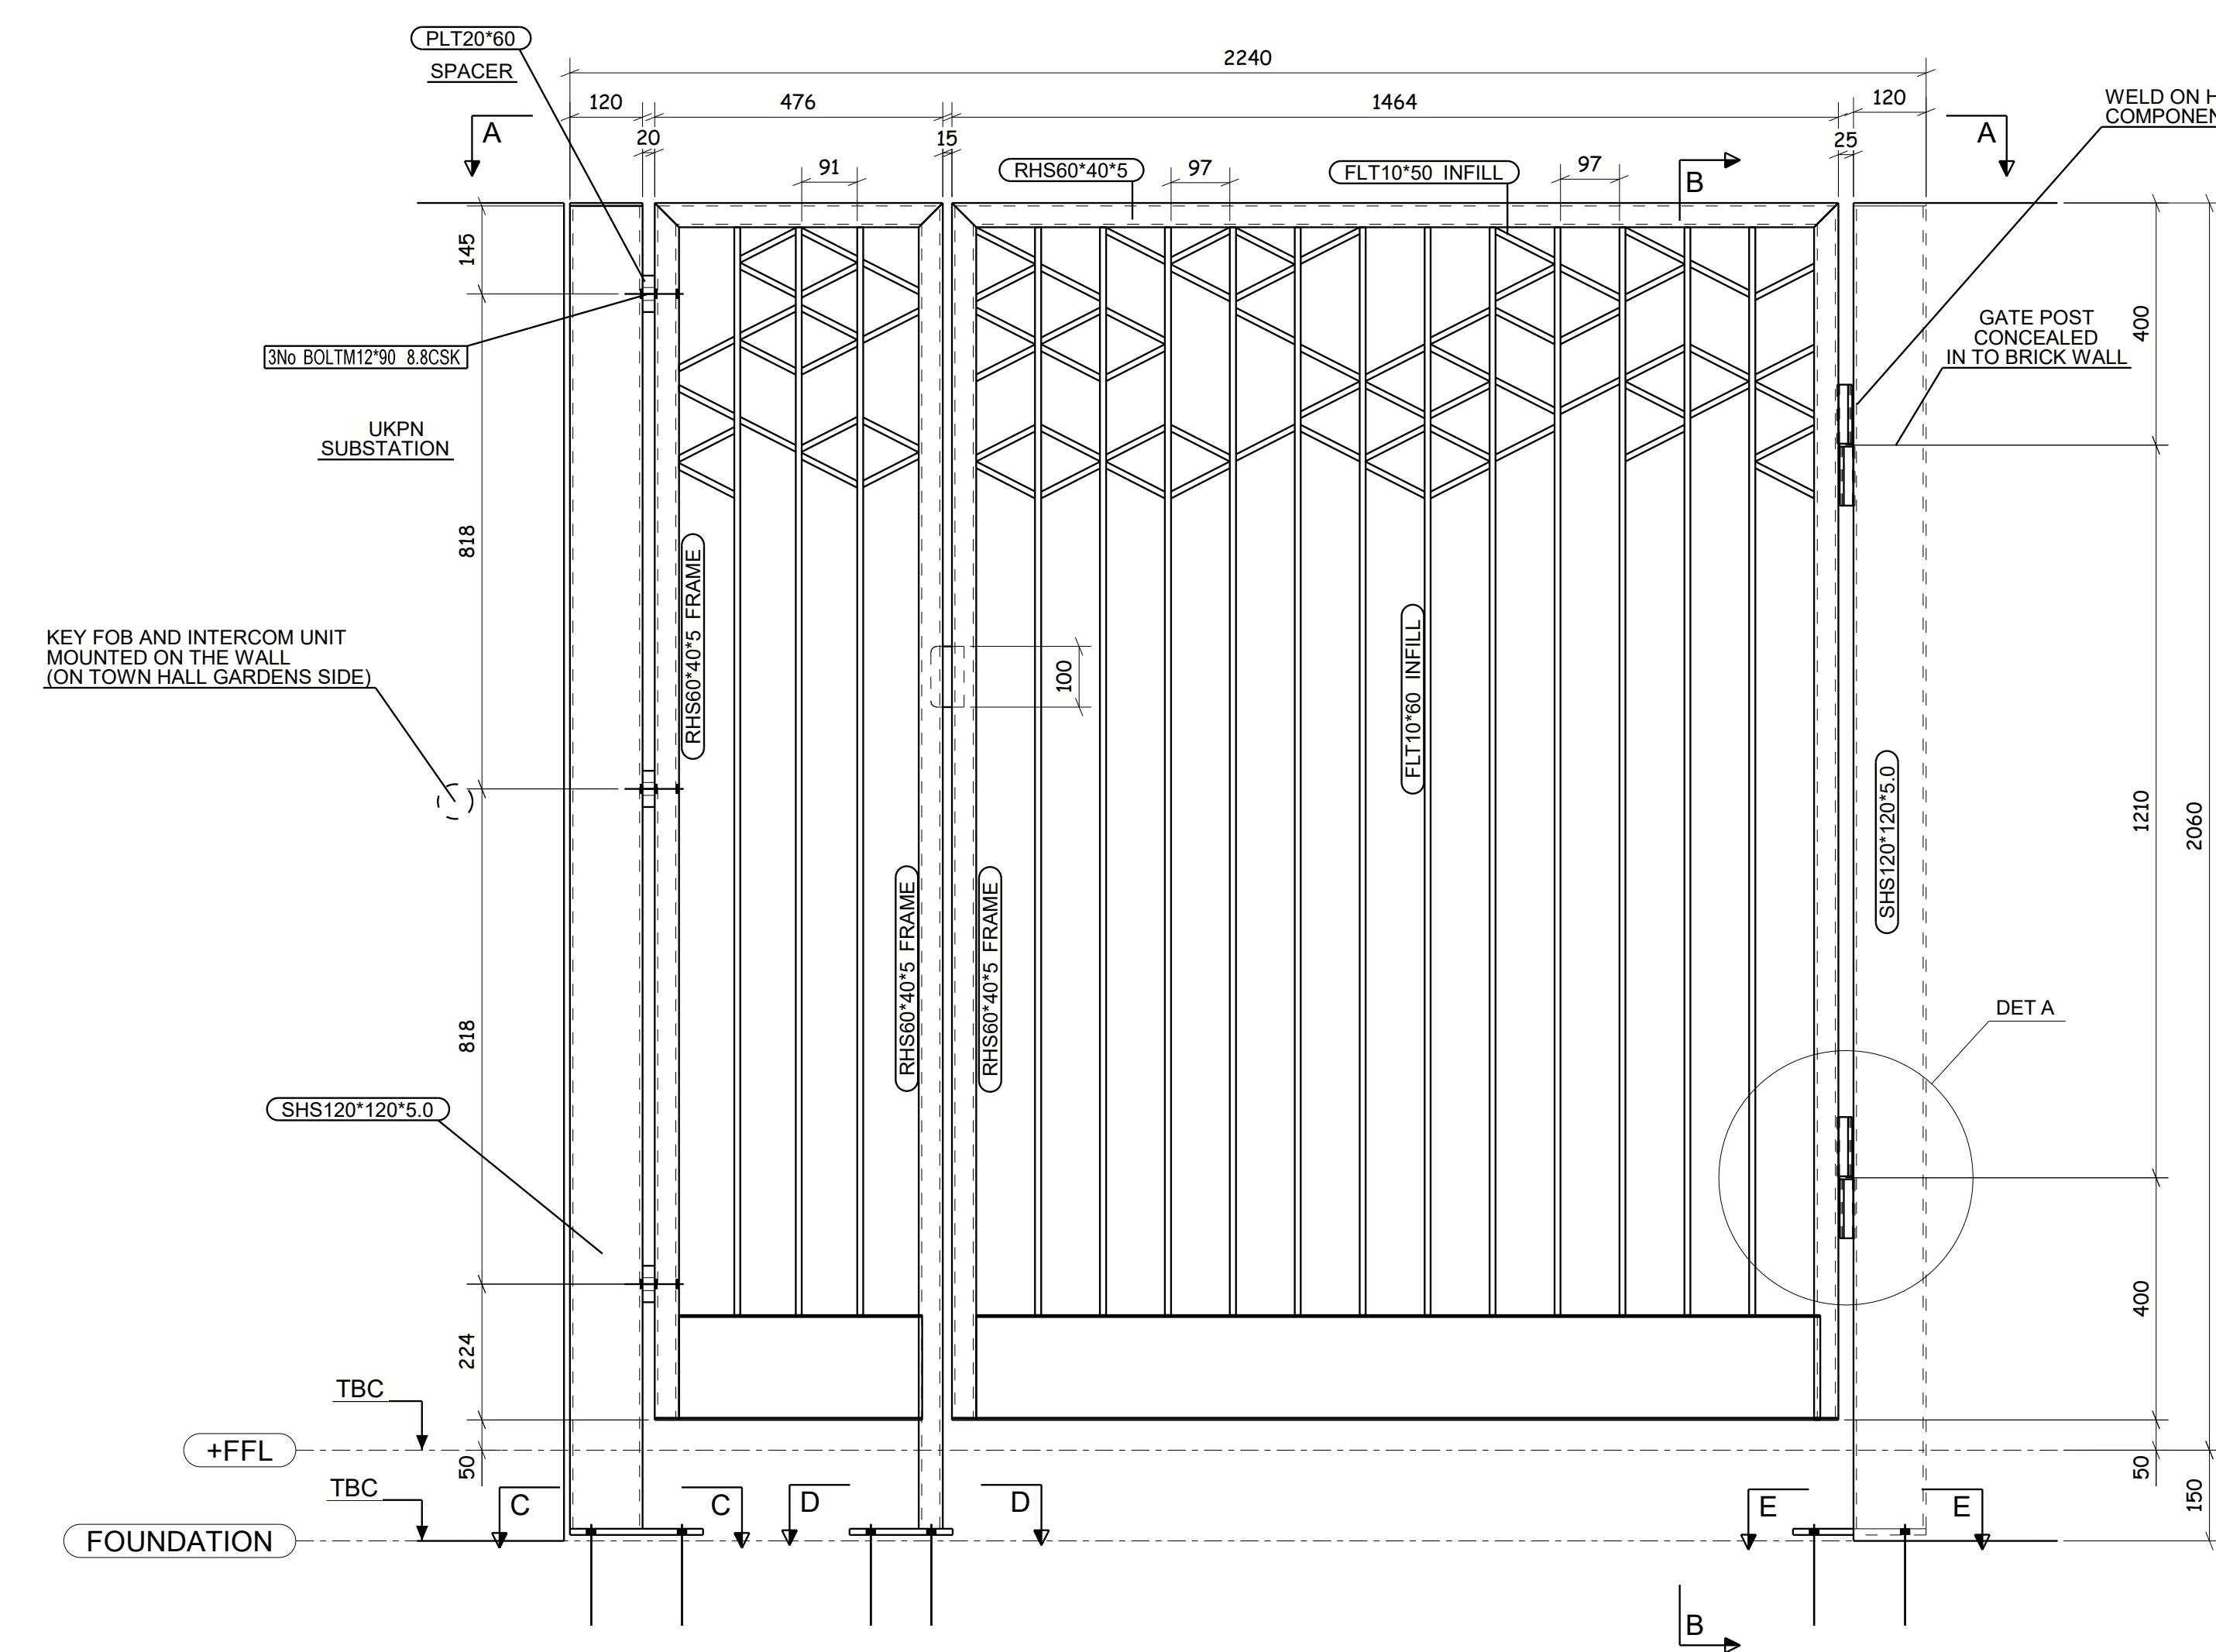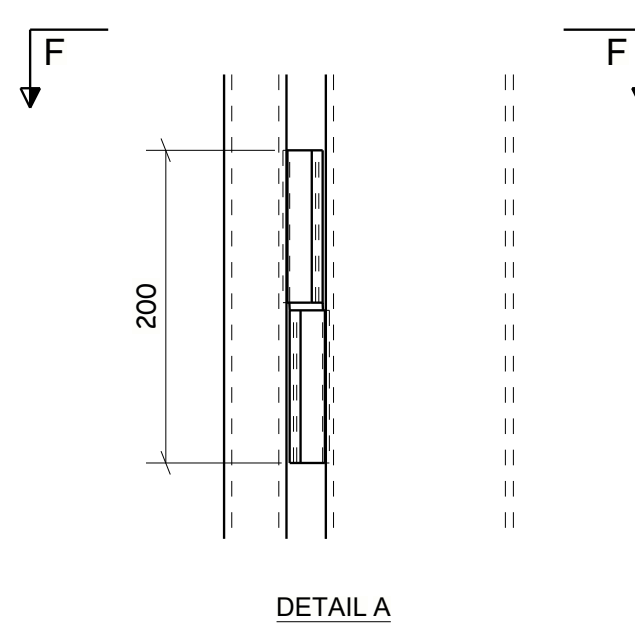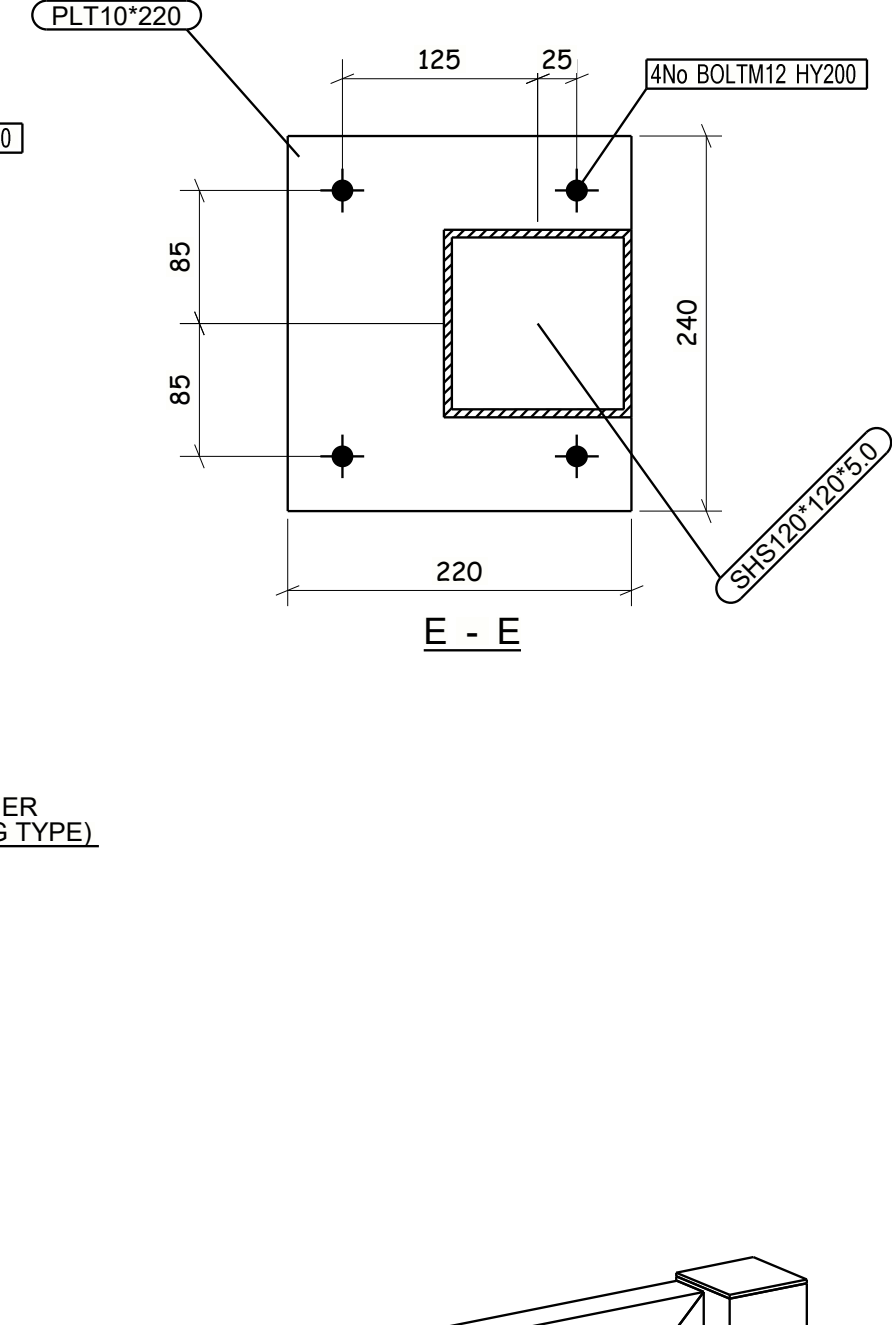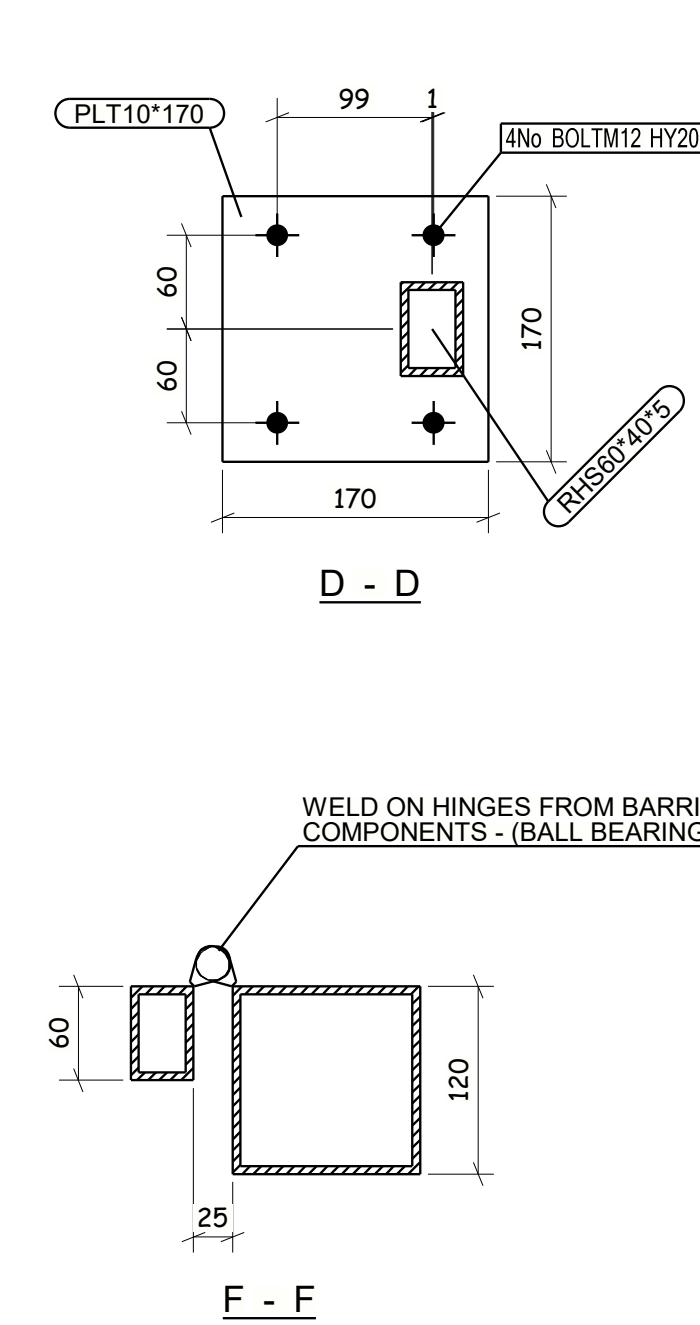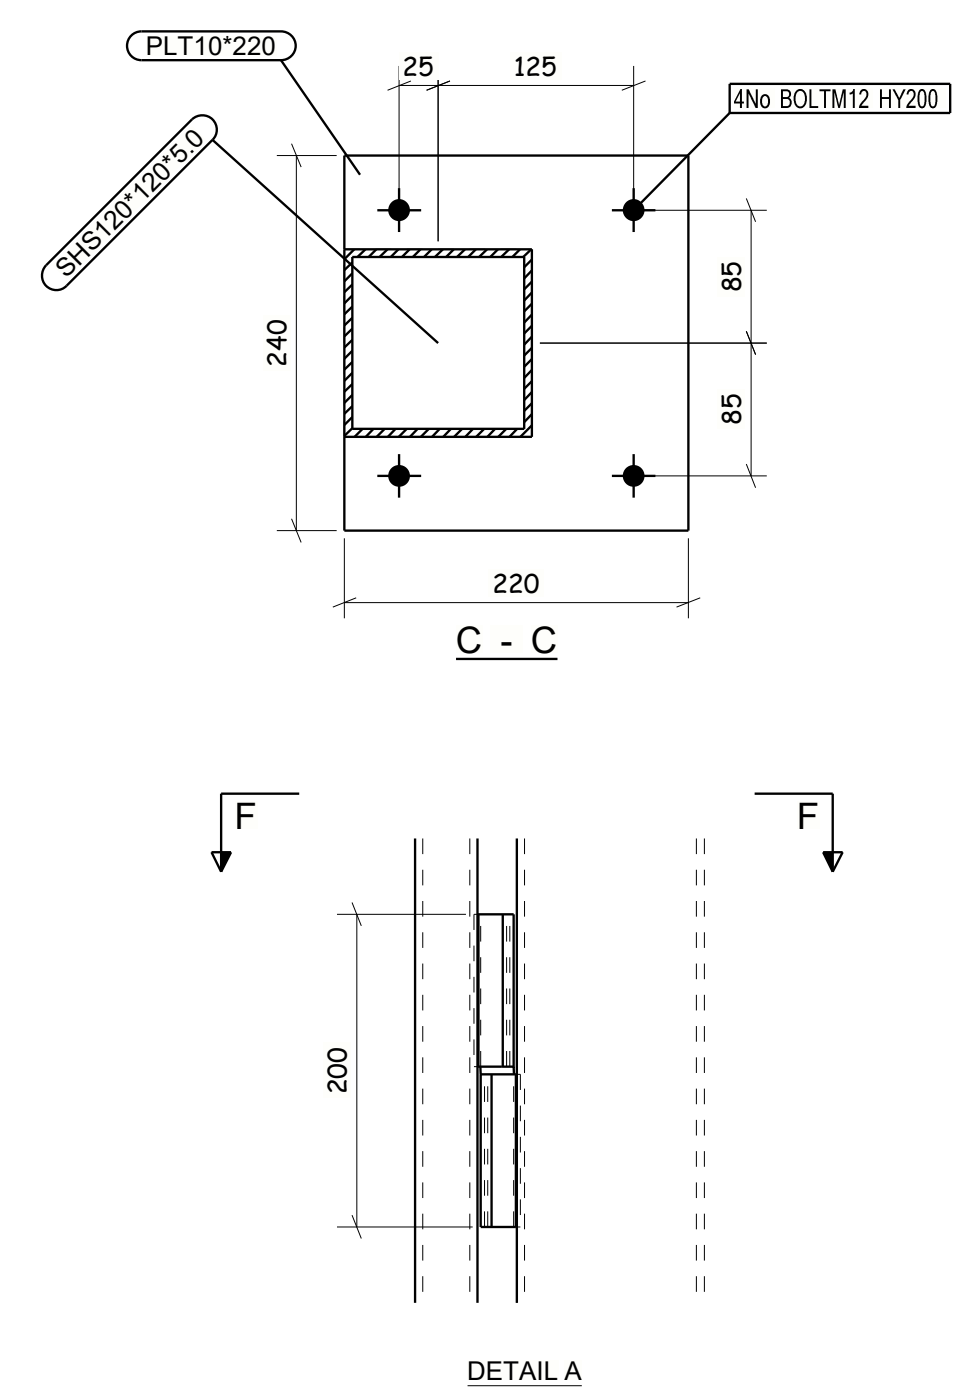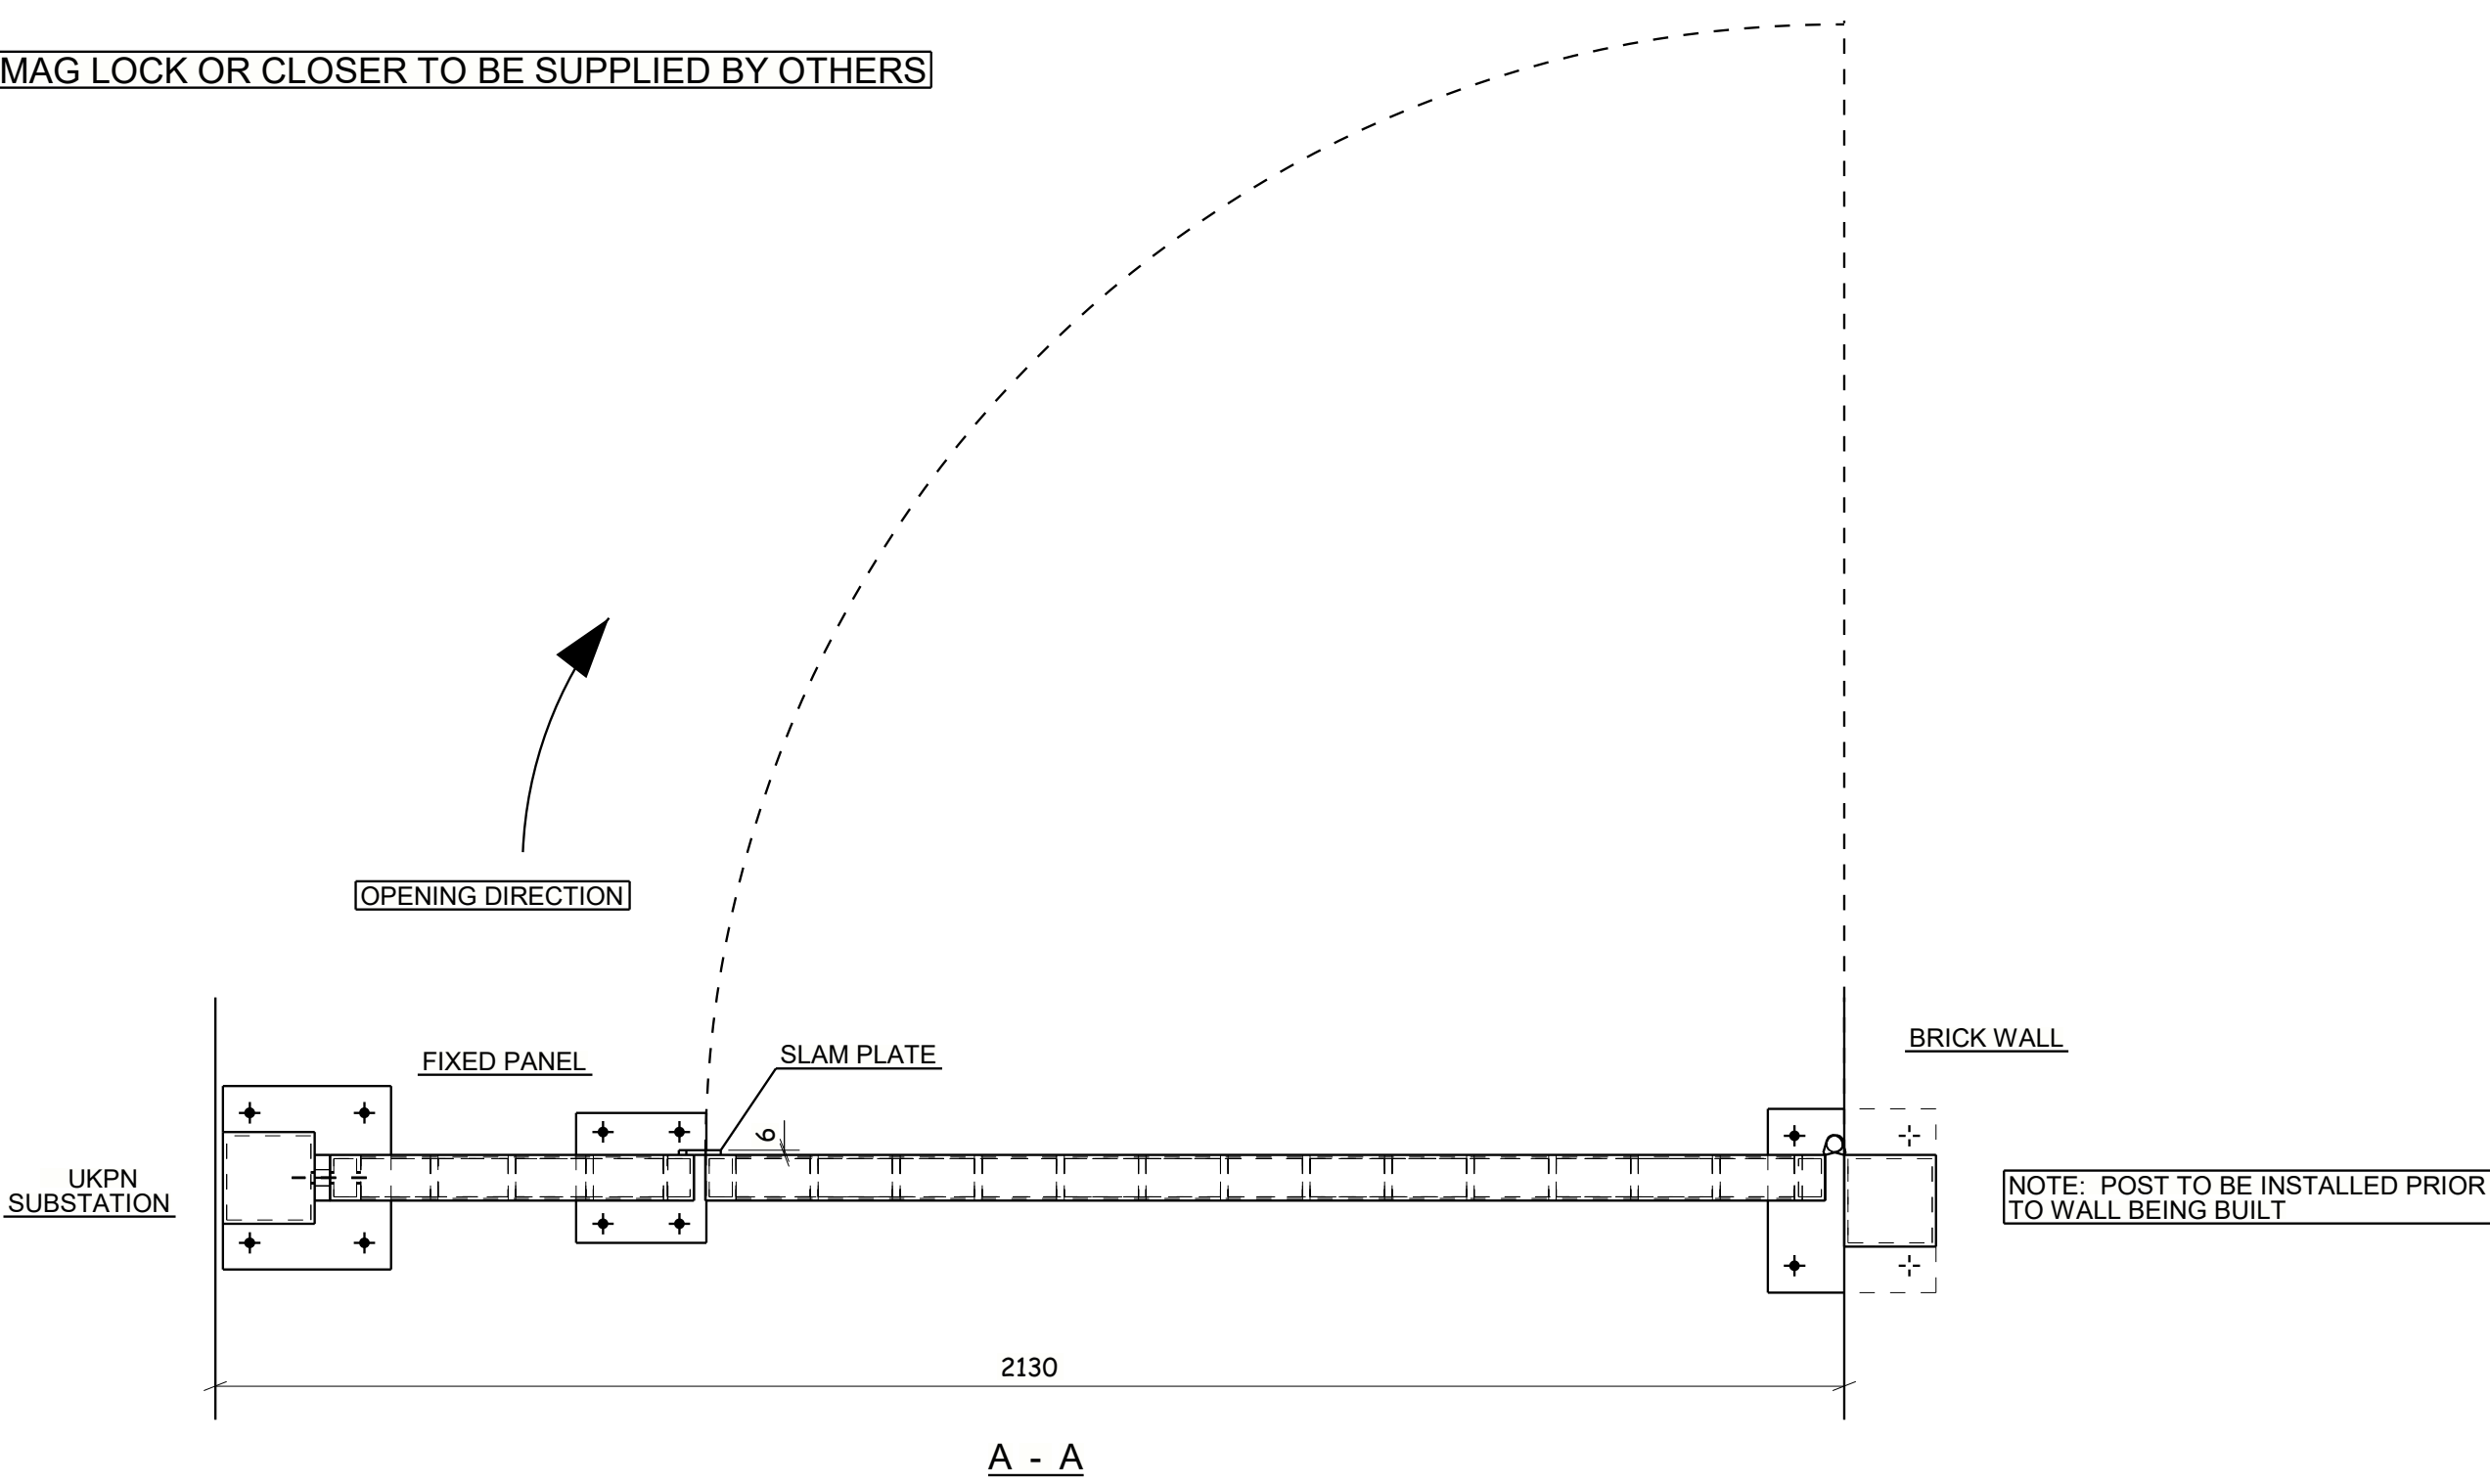

ISOMETRIC VIEW
[VIEWED FROM INSIDE]
CONCRETE NOT SHOWN FOR CLARITY

NOTE:
MAIN POST TO BE SHS120*120*5.0
BOTTOM RAIL 3mm PLATE TO MAKE 170*60*3
GATE FRAME TO BE RHS60*40*5
HINGE TBC
GATE INFILLS TO BE FLT60*10
FINISH RAL7022 GLOSS (TBC)

C01	ISSUED FOR COMMENT	08.06.2022
REV MARK	REVISION DESCRIPTION	REVISION DATE
SKYLINE Engineering (South East) Ltd Unit 10, 11, 12, 99, 100		
DRAWING TITLE	GATE 13 LAYOUT	
CONTRACT	HORNSEY TOWN HALL	
MODELLLED BY	LT	DATE 01.06.2022
CONTRACT No	SEL1142	SCALE 1:5 1:10
DRAWING No	7414-10-002	REVISION No. C01

14. Gate 14 – Access to rear of Annex

Drawing:

- 7414-10-001

Location:


- Rear of annex, access to bin stores











Finish:

- RAL 7016 – anthracite grey

Photograph:

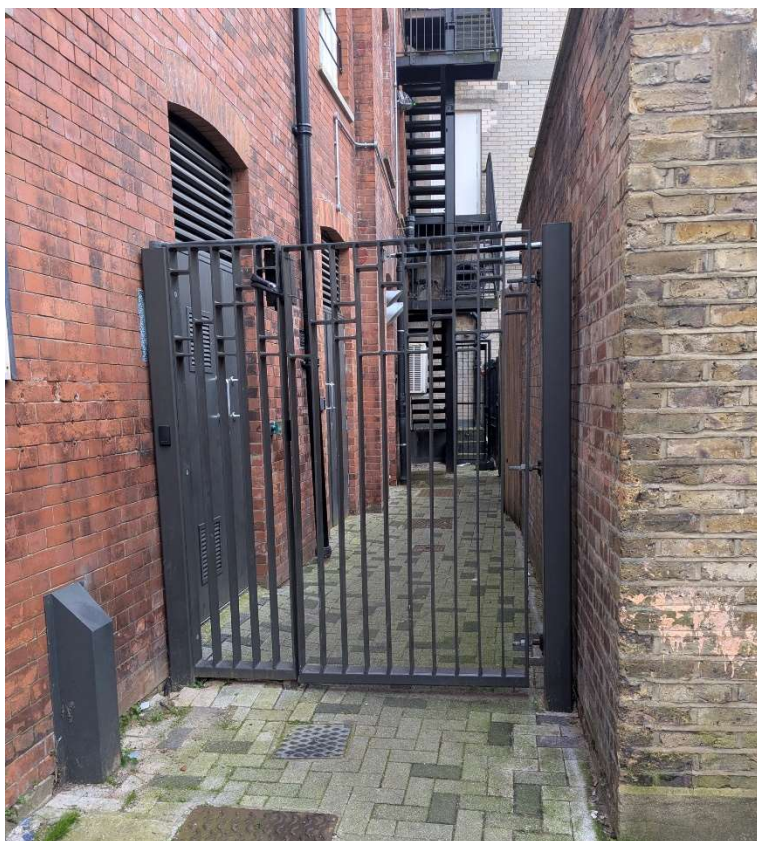

ANY AUTOMATION, MAG LOCK OR CLOSER TO BE SUPPLIED BY OTHERS

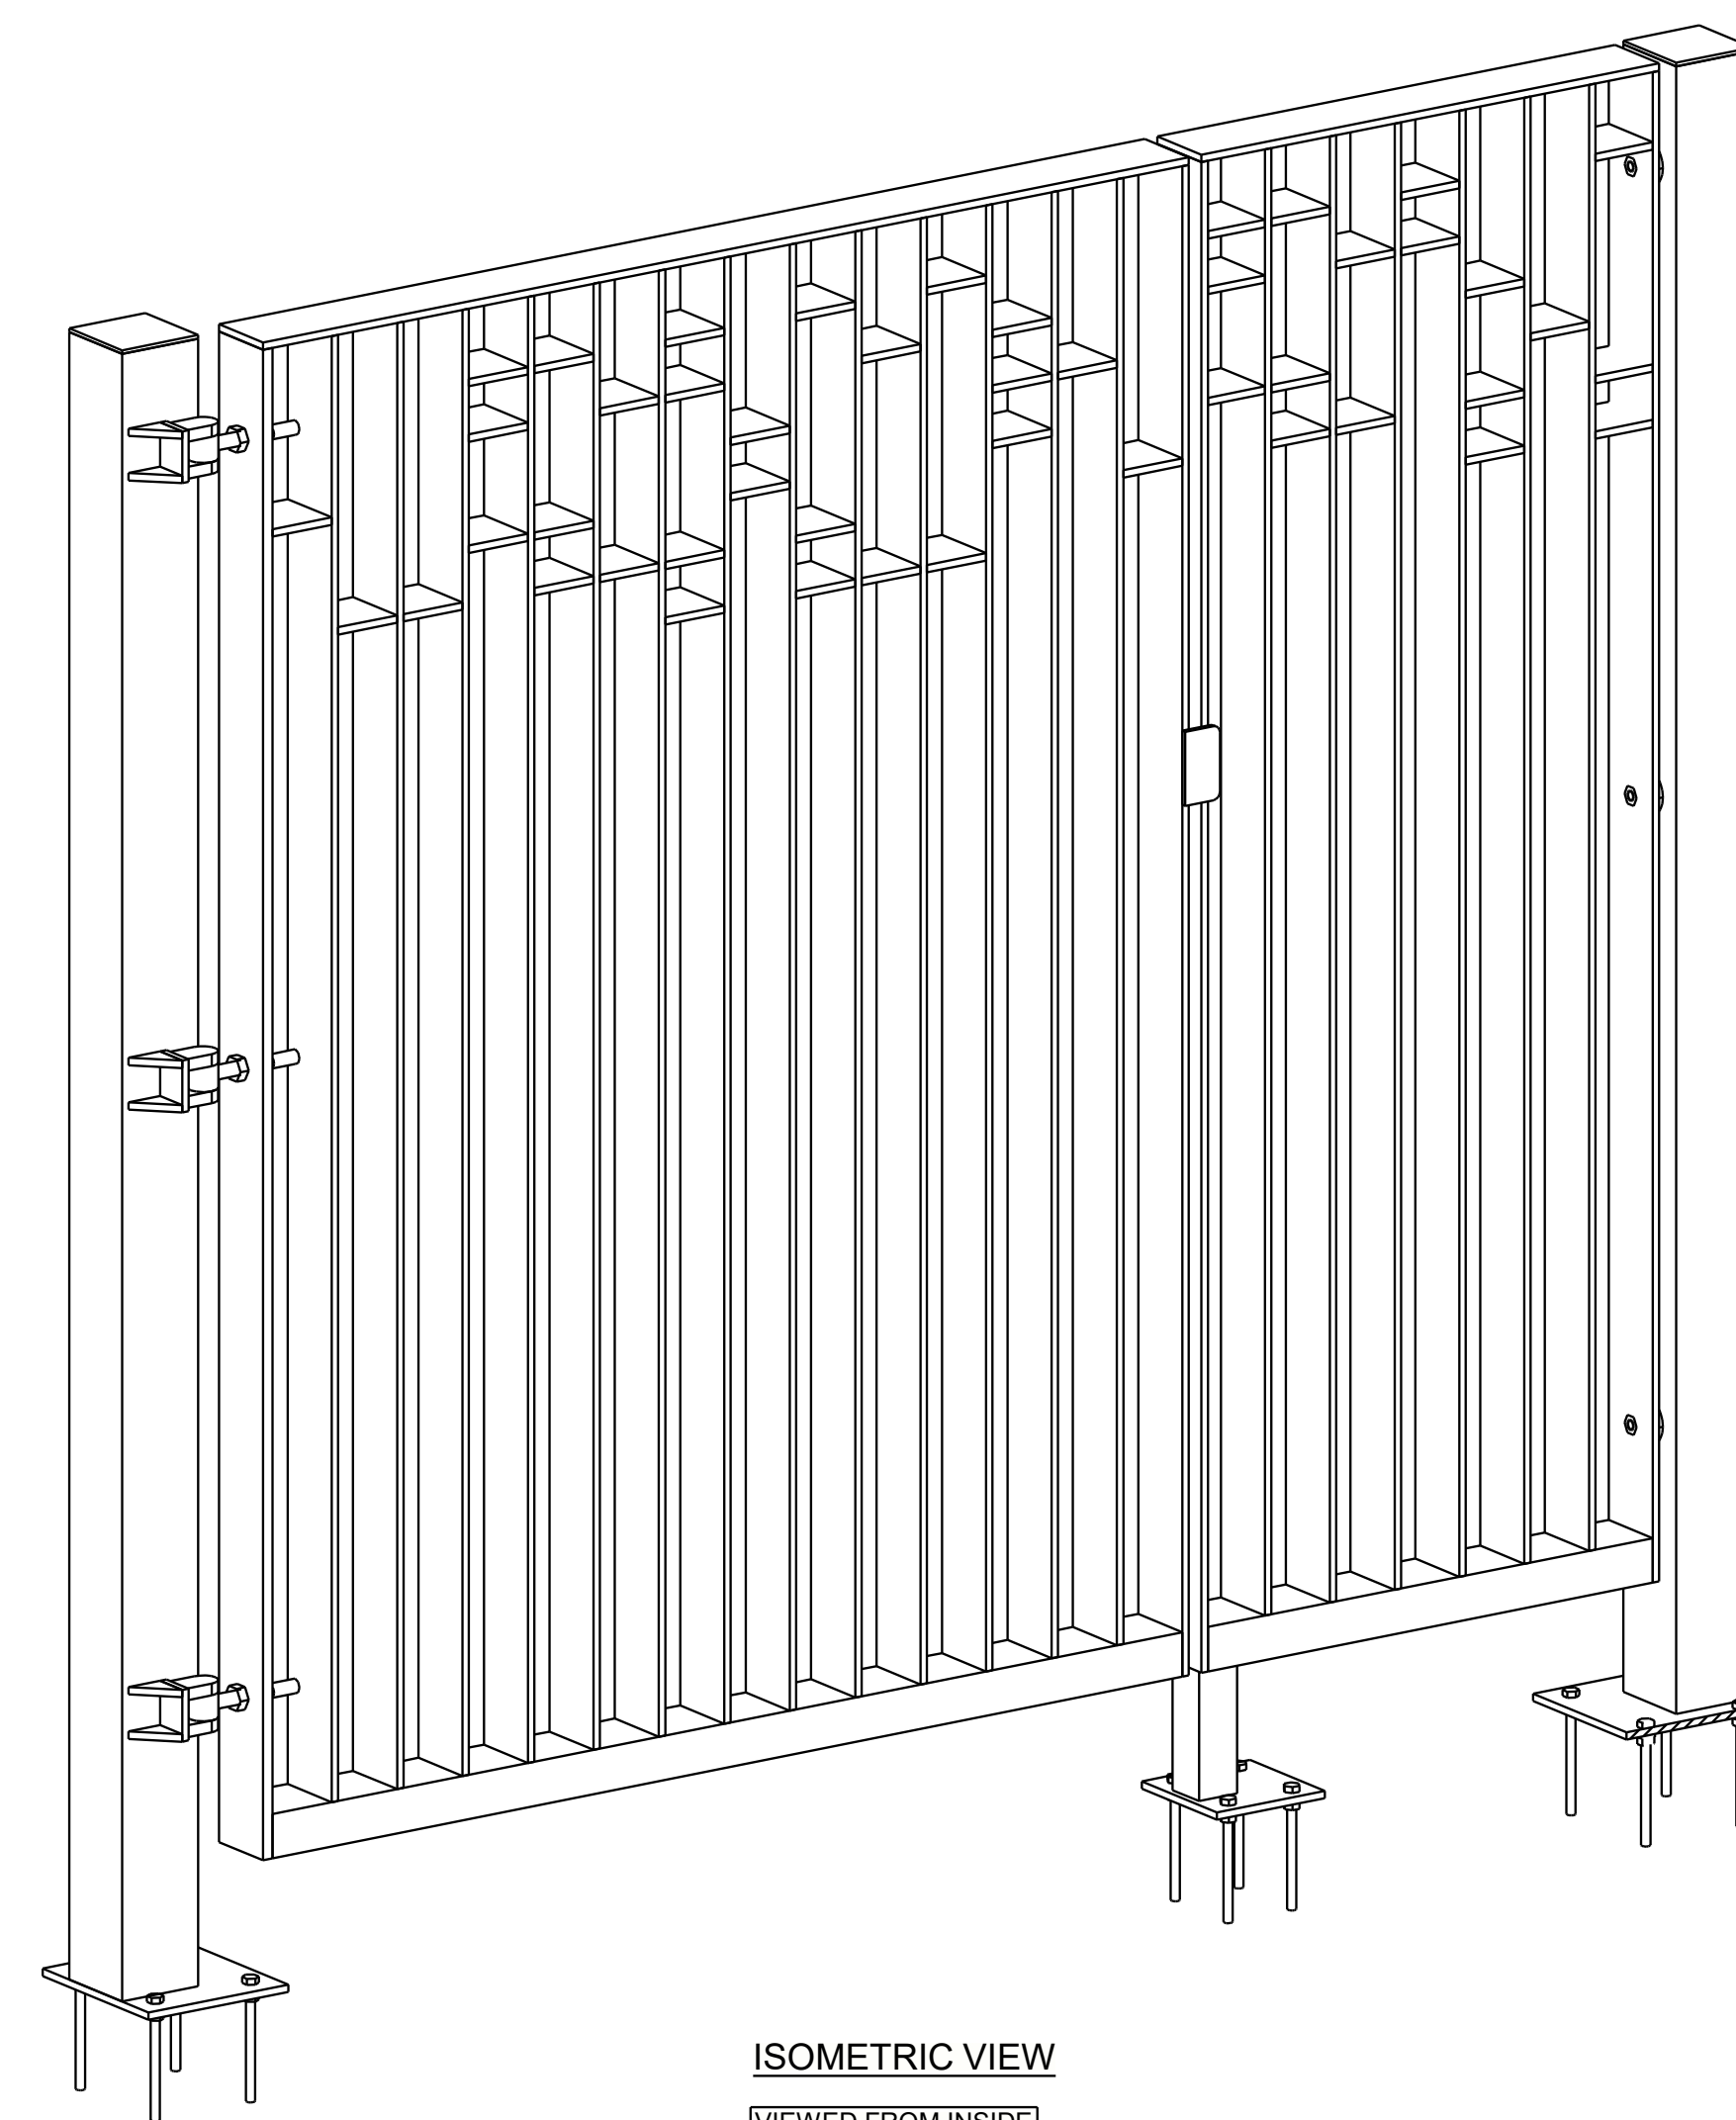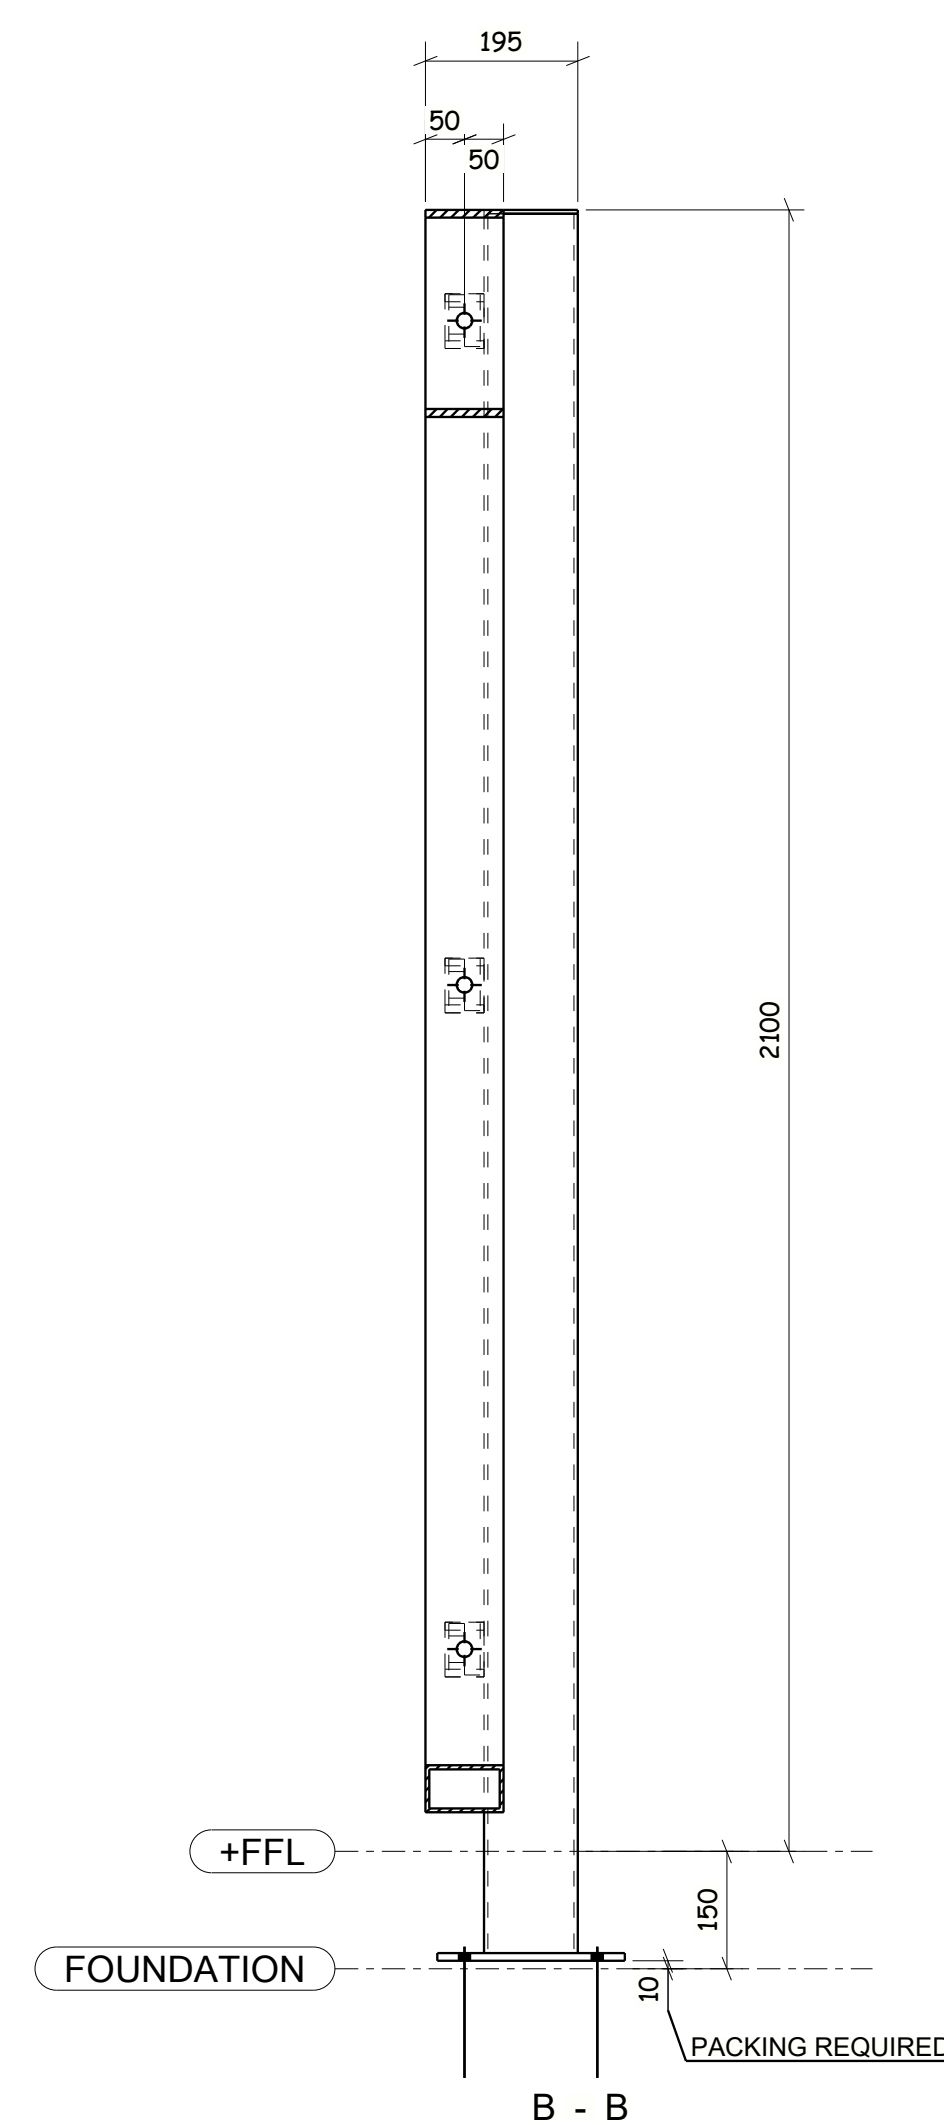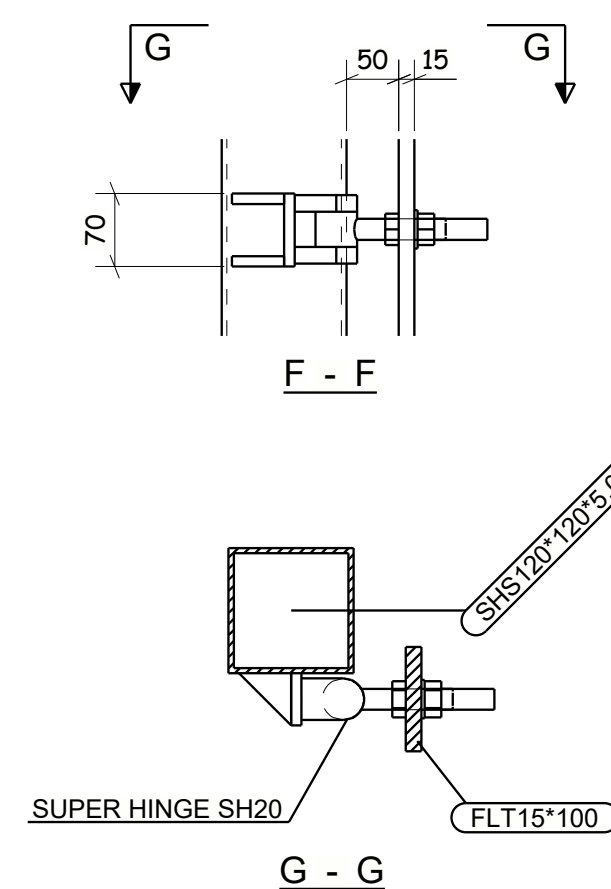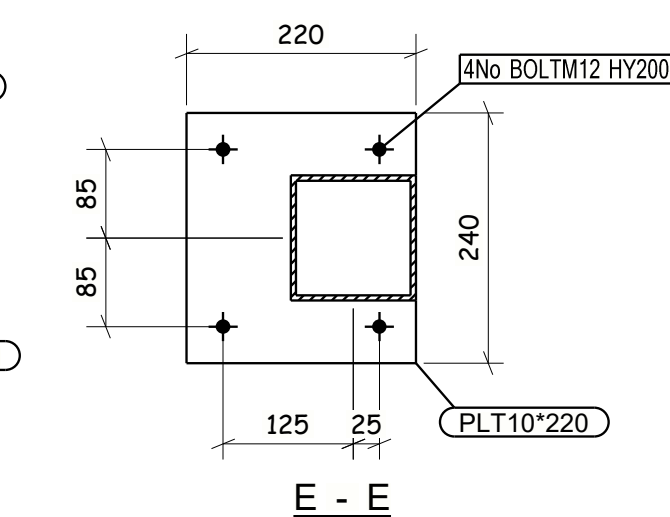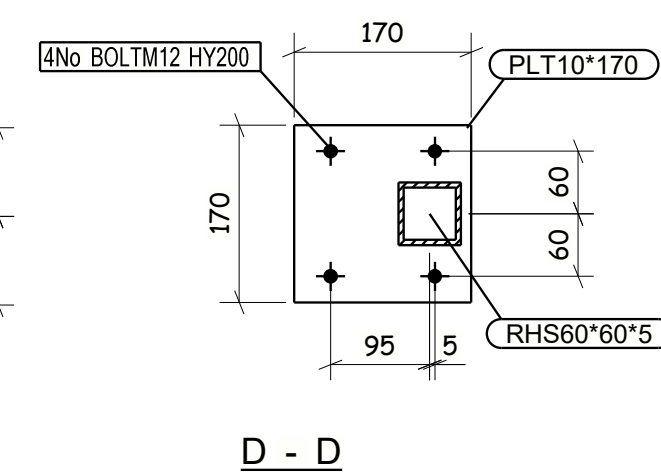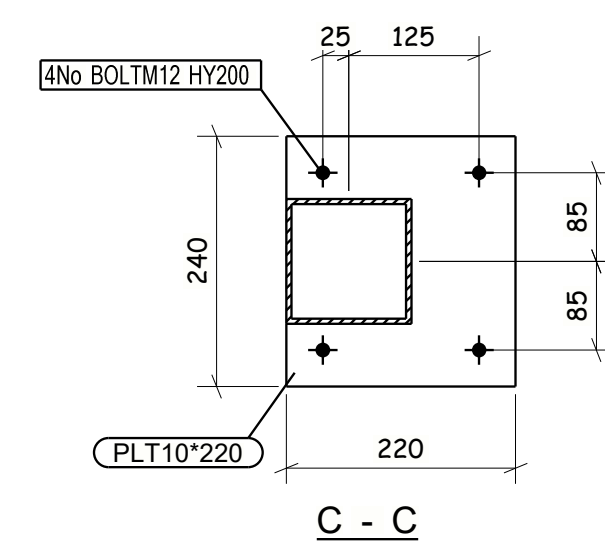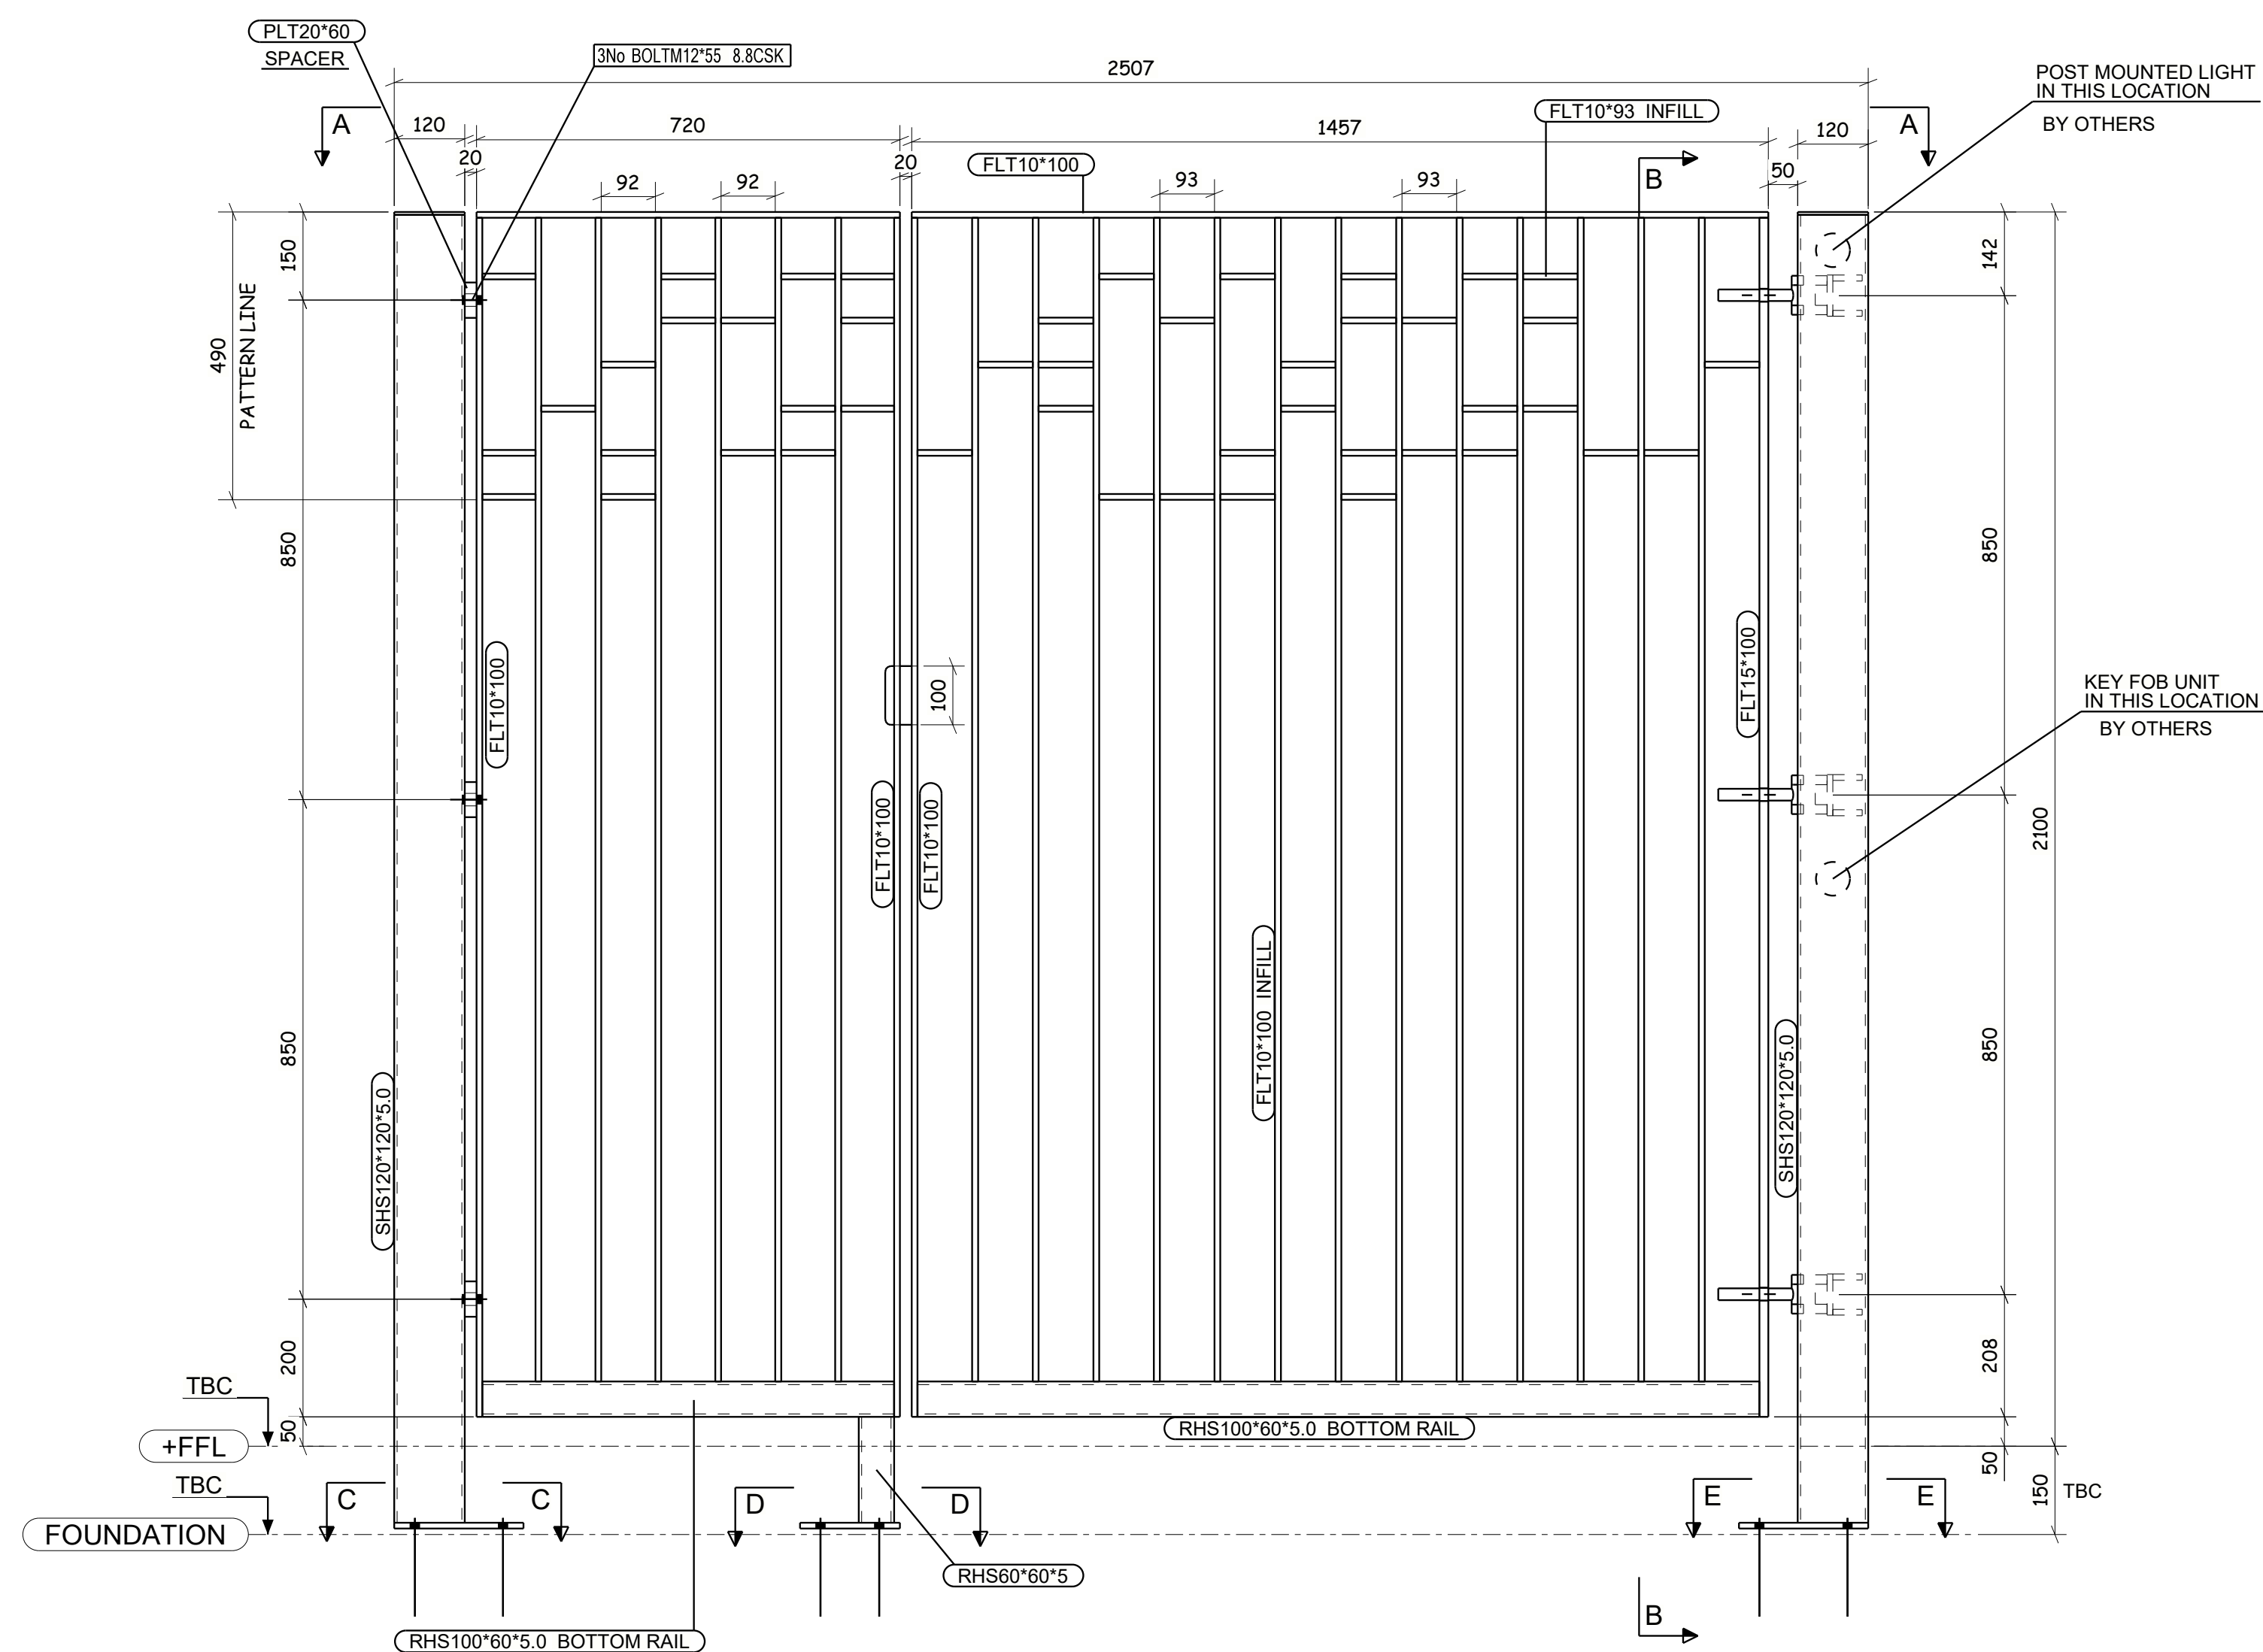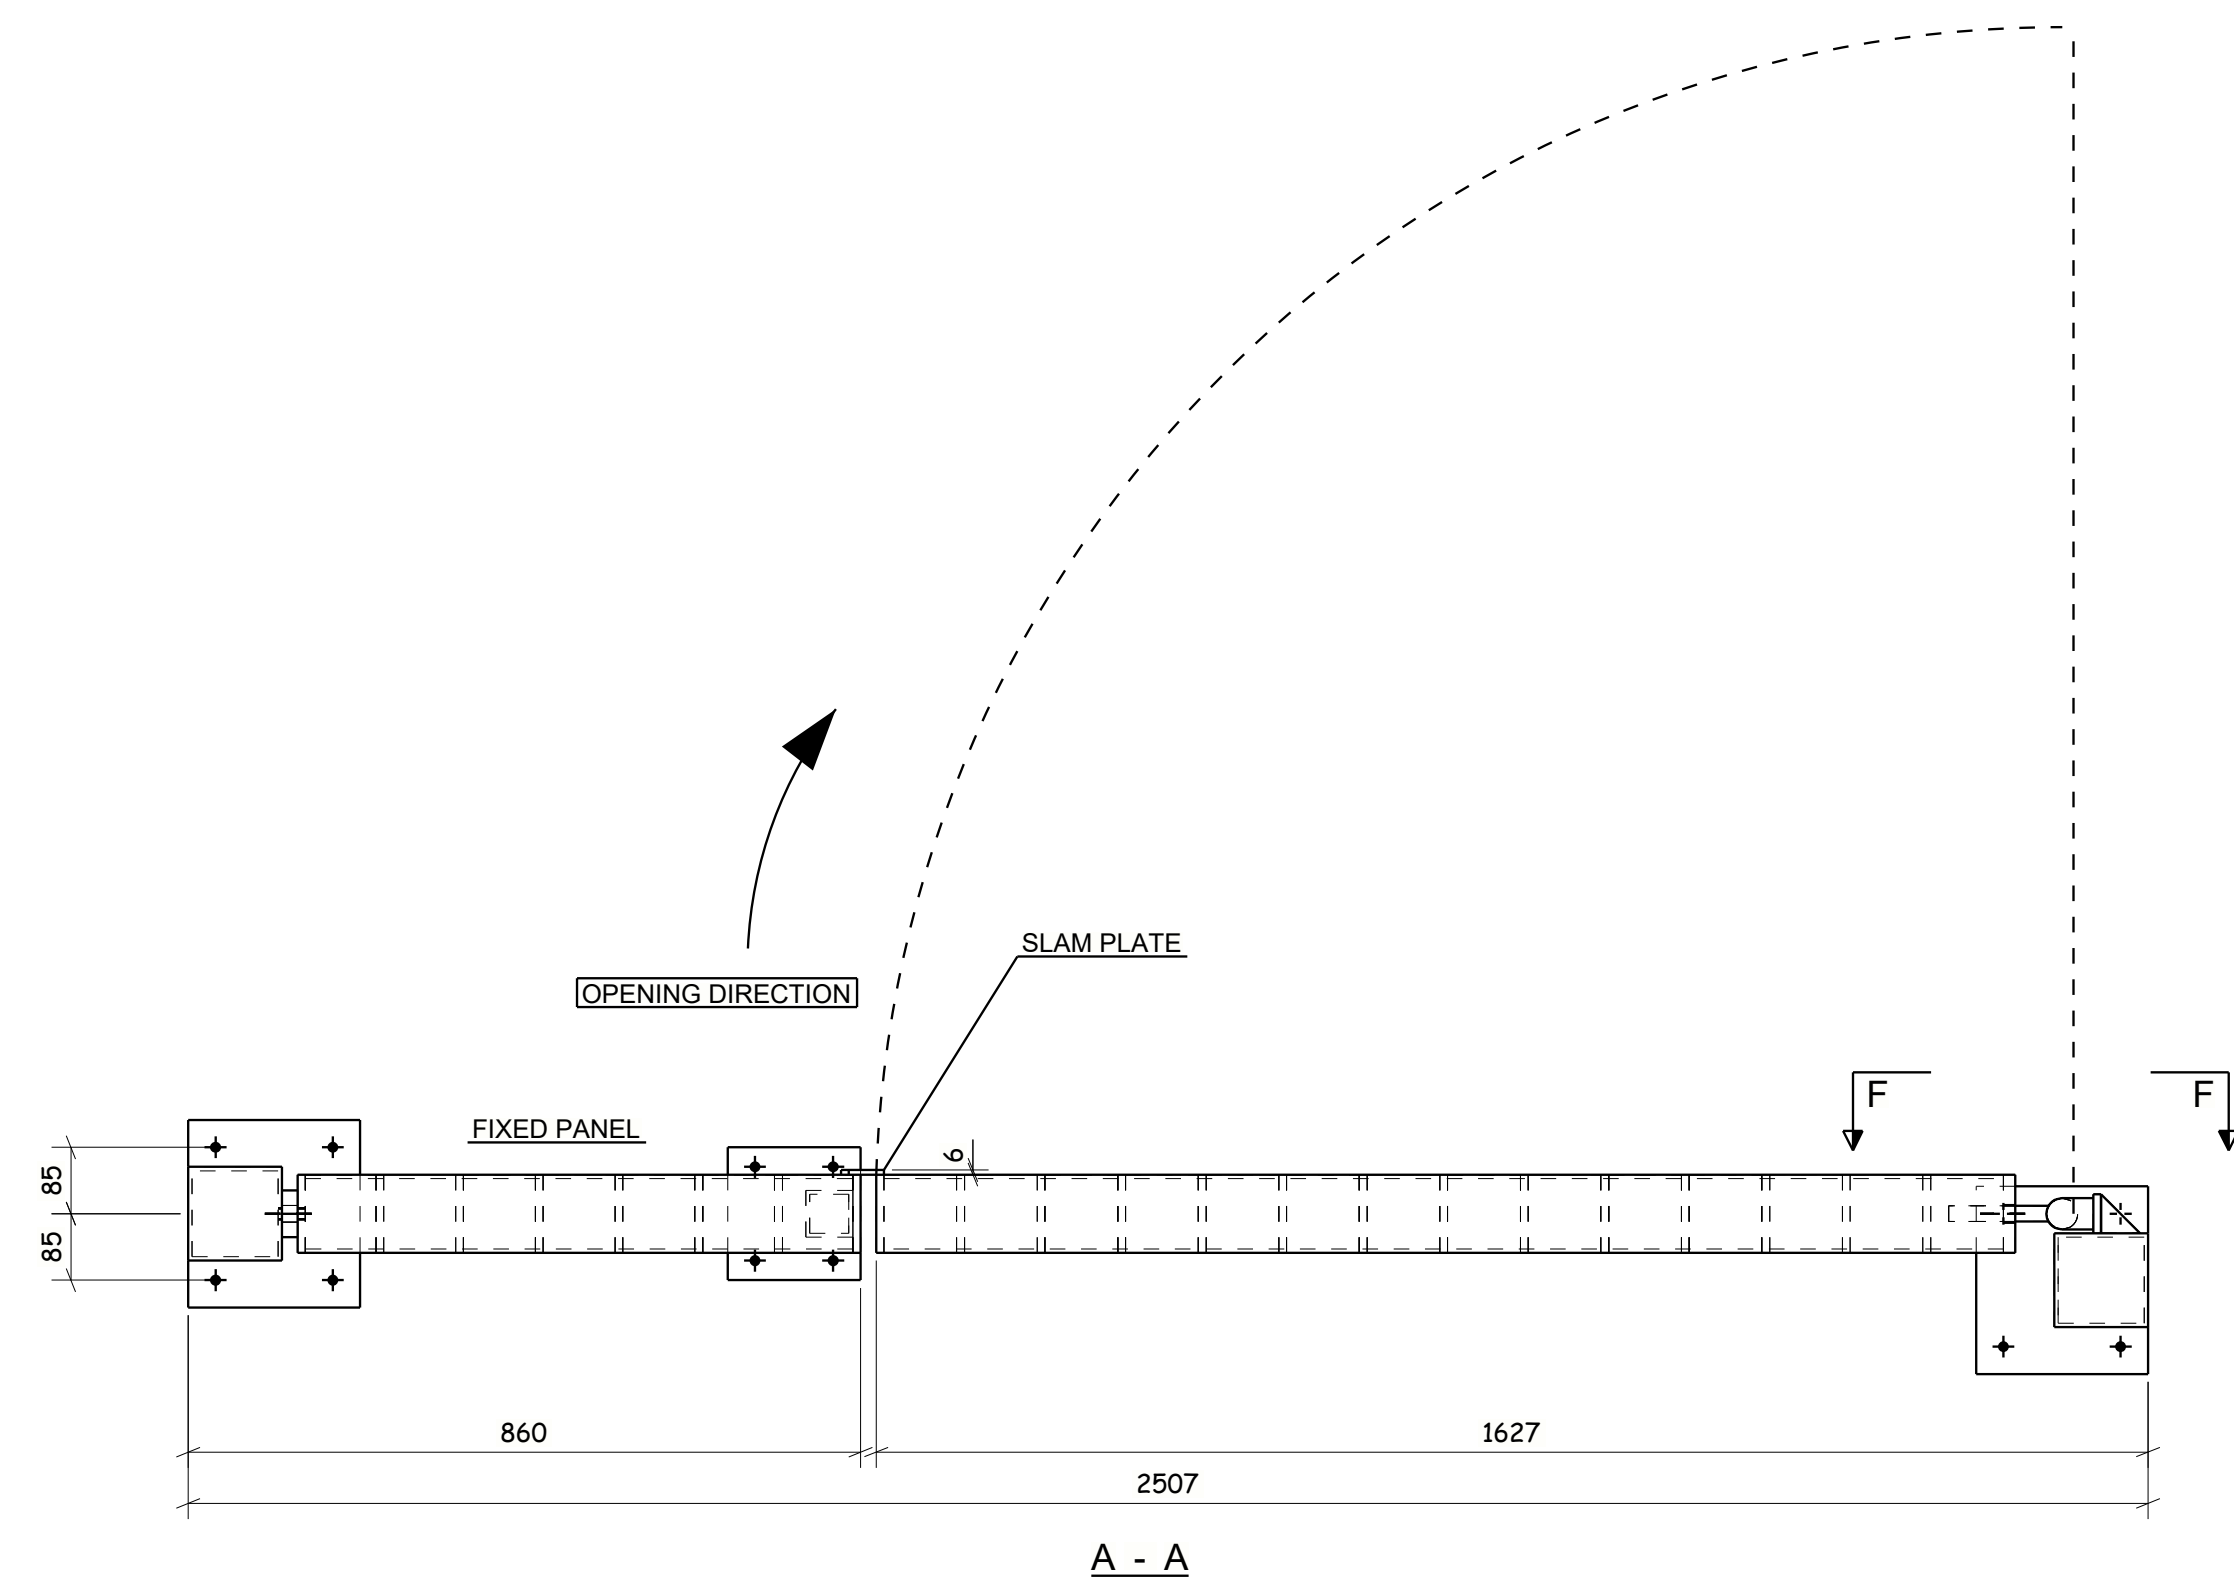

ISOMETRIC VIEW

VIEWED FROM INSIDE

NOTE:
MAIN POST TO BE SHS120*120*5.0
BOTTOM RAIL RHS100*60*5.0
GATE FRAME TO BE FLT100*10
HINGE PLATE TO BE FLT100*15
GATE INFILLS TO BE FLT100*10
HINGE TO BE SUPERHINGE SH20
FINISH RAL7022 GLOSS (TBC)

C01	ISSUED FOR COMMENT	08.06.2022
REV MARK	REVISION DESCRIPTION	REVISION DATE
 0905 10 8 201, Kingsmead Industrial Estate, Jolly Road, Rochester, Kent ME1 3JH Tel: 01716 815421 Email: sales@skyline.co.uk		
DRAWING TITLE	GATE 14 LAYOUT	
CONTRACT	HORNSEY TOWN HALL	
MODELLED BY	LT	DATE 01.06.2022
CONTRACT NO	SEL1142	SCALE 1:7.5 1:10
DRAWING No	7414-10-001	REVISION No. C01


15. Gate 15 – Within hotel courtyards

Drawing:

- 7414-16-001

Location:

- In hotel courtyards

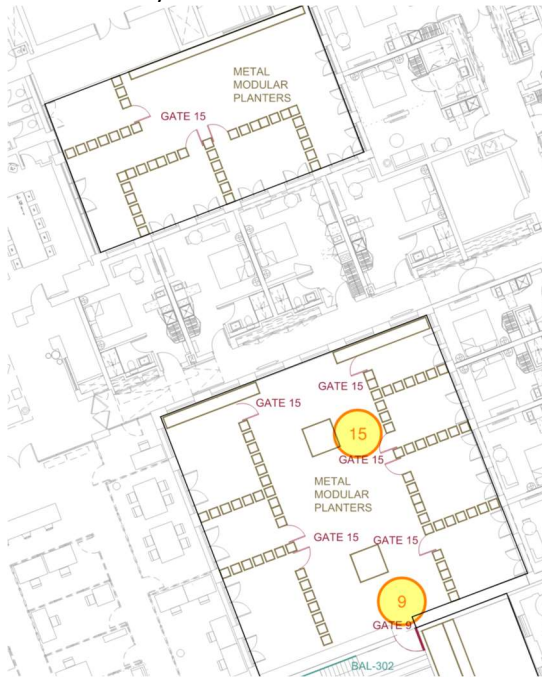


Finish:

- RAL 7016 – anthracite grey



Photograph:



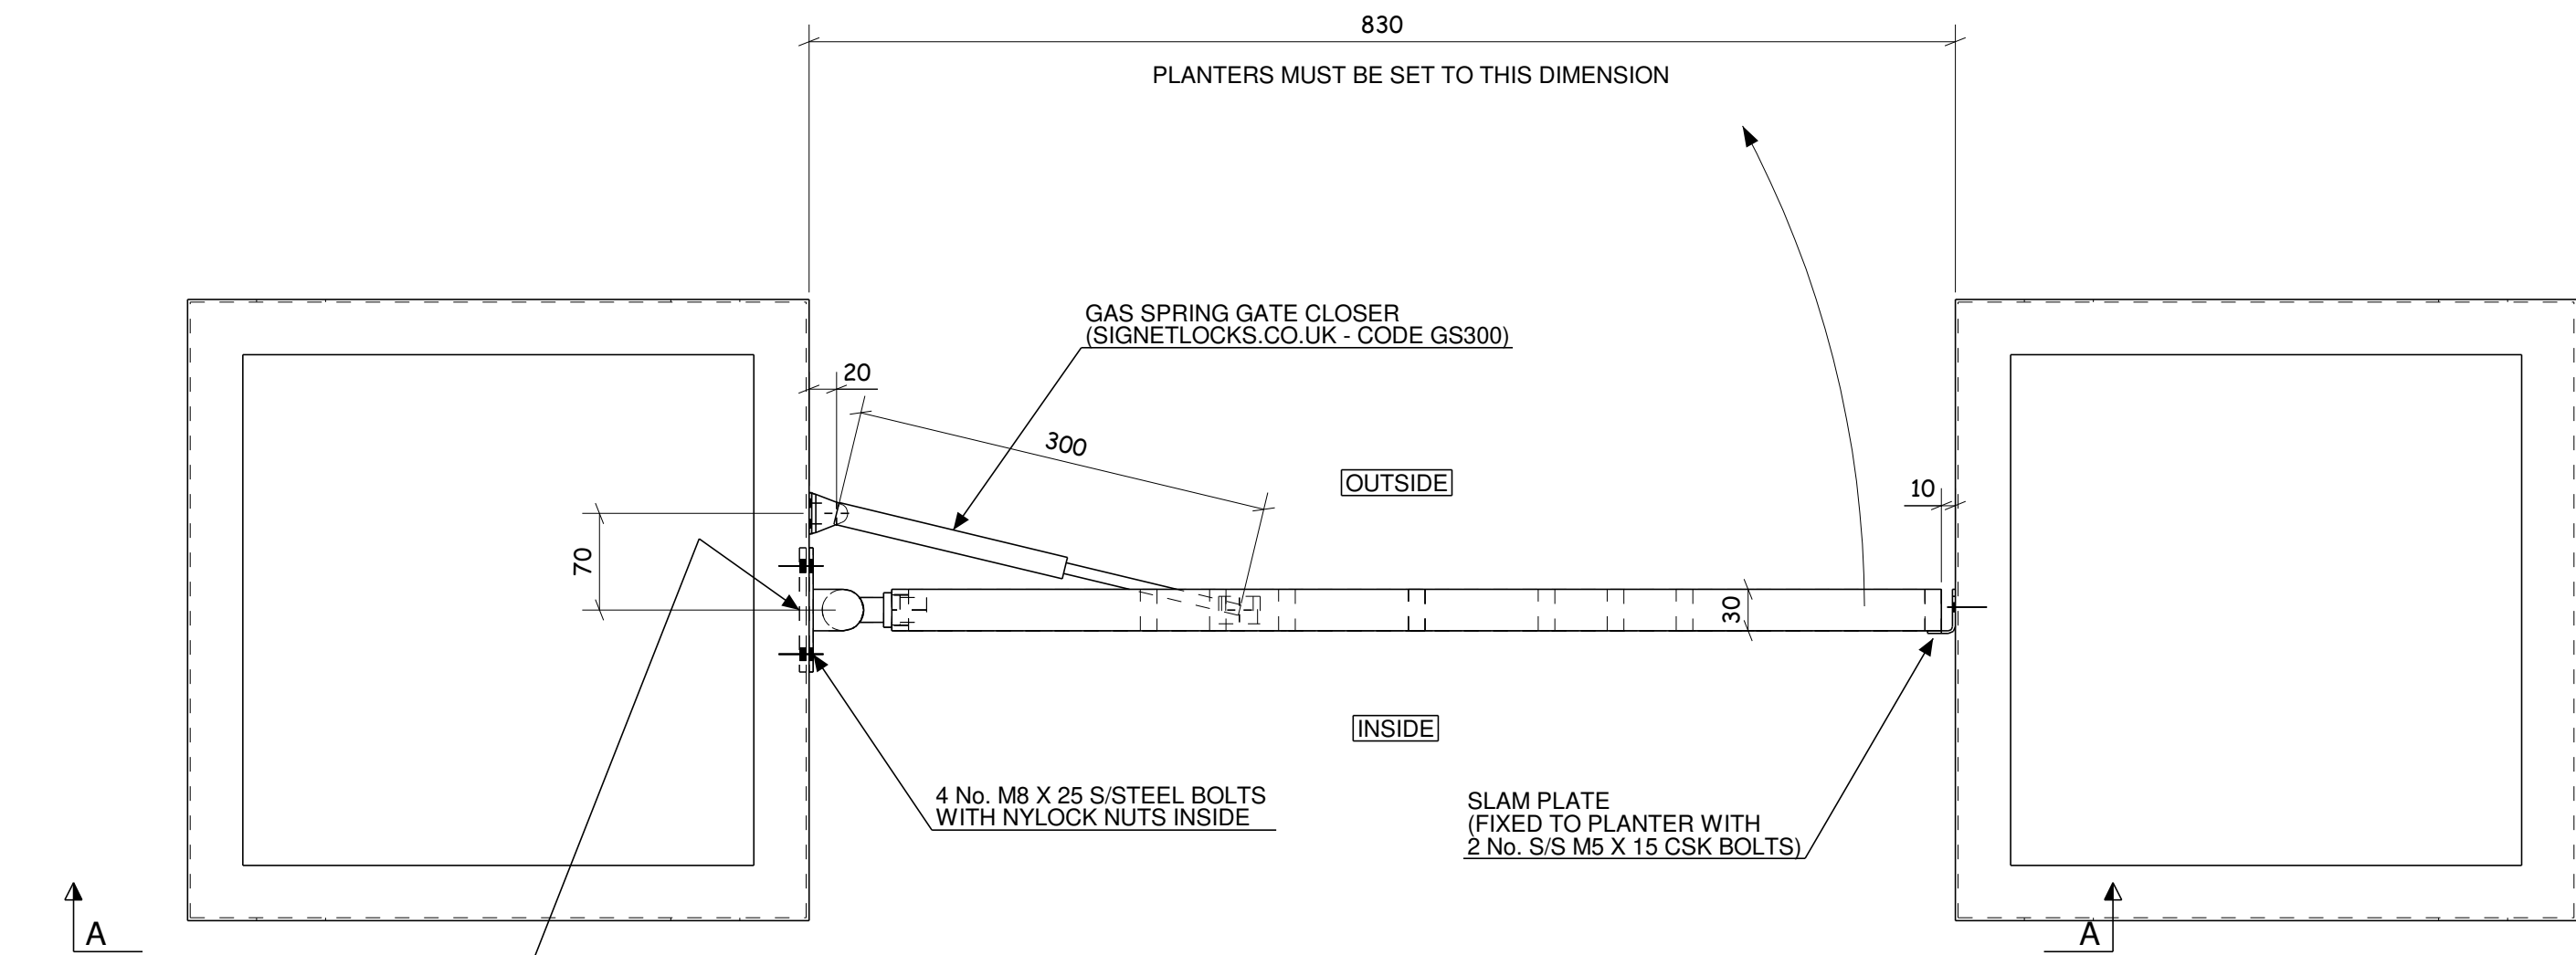

90 X 90 X 5mm THK WASHER PLATE
TO BE FITTED INSIDE THE PLANTER TO
STOP THE BOLTS FROM DEFORMING
THE PLANTER WALL

PLAN

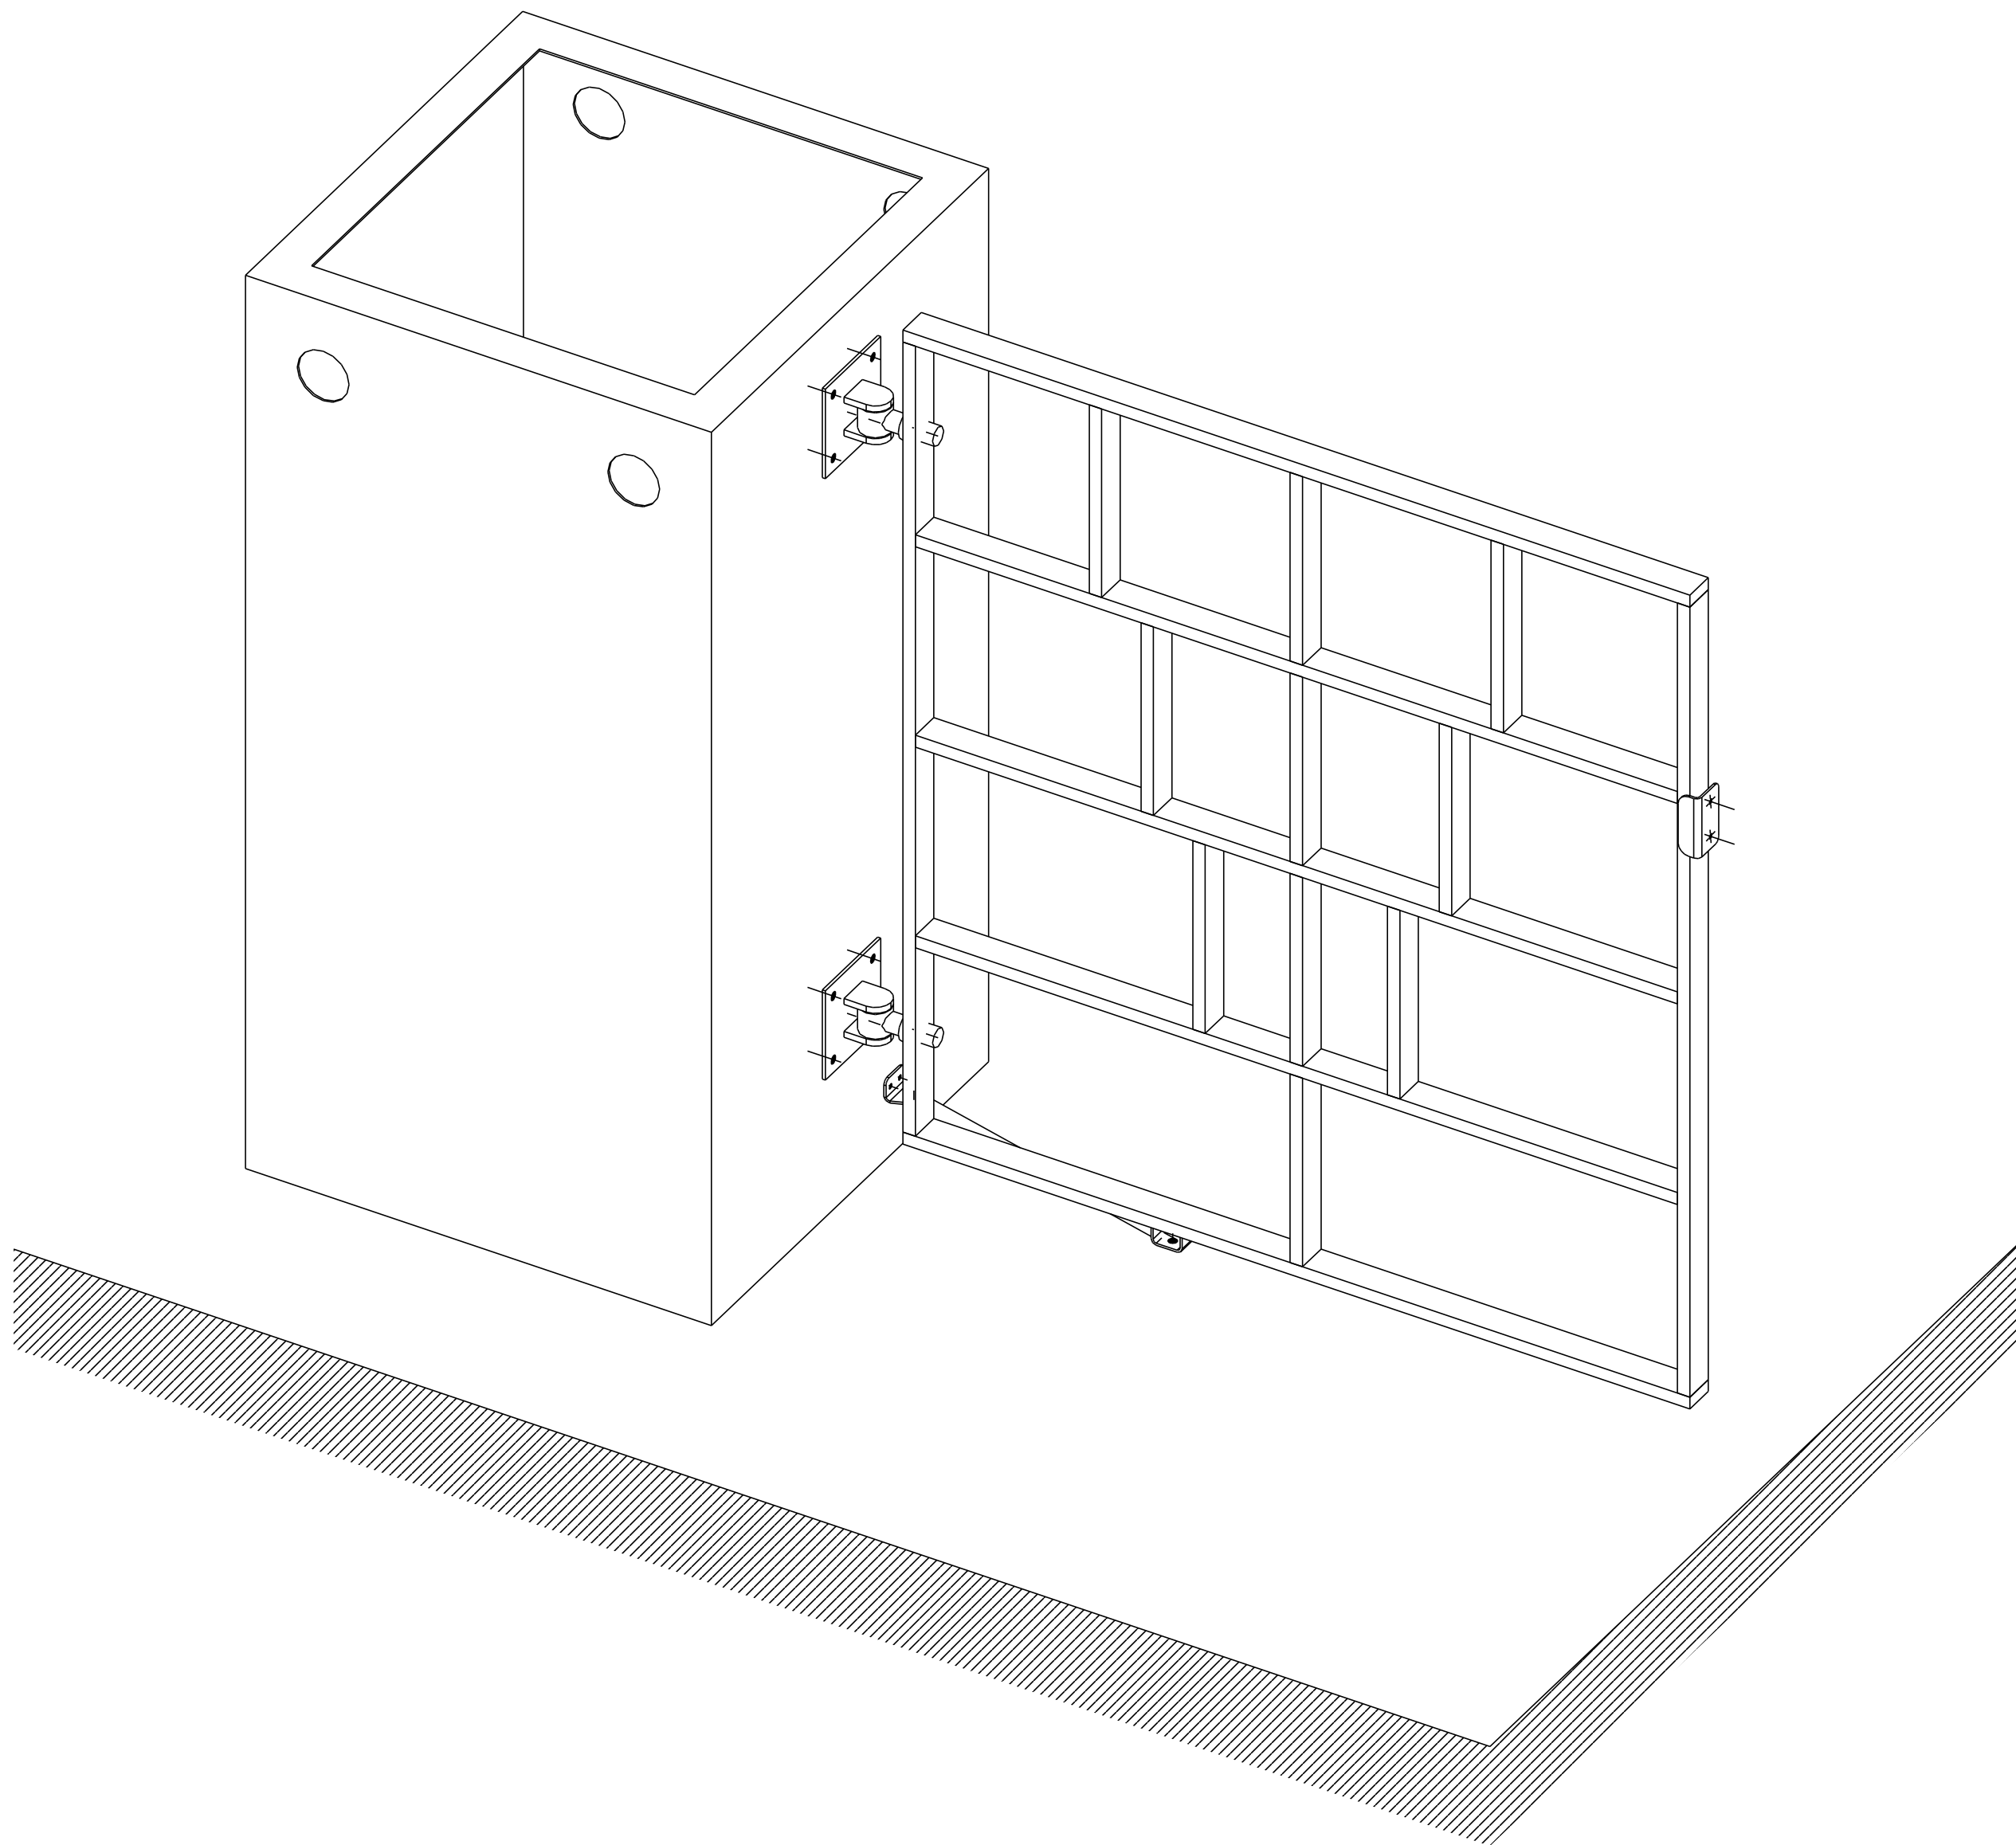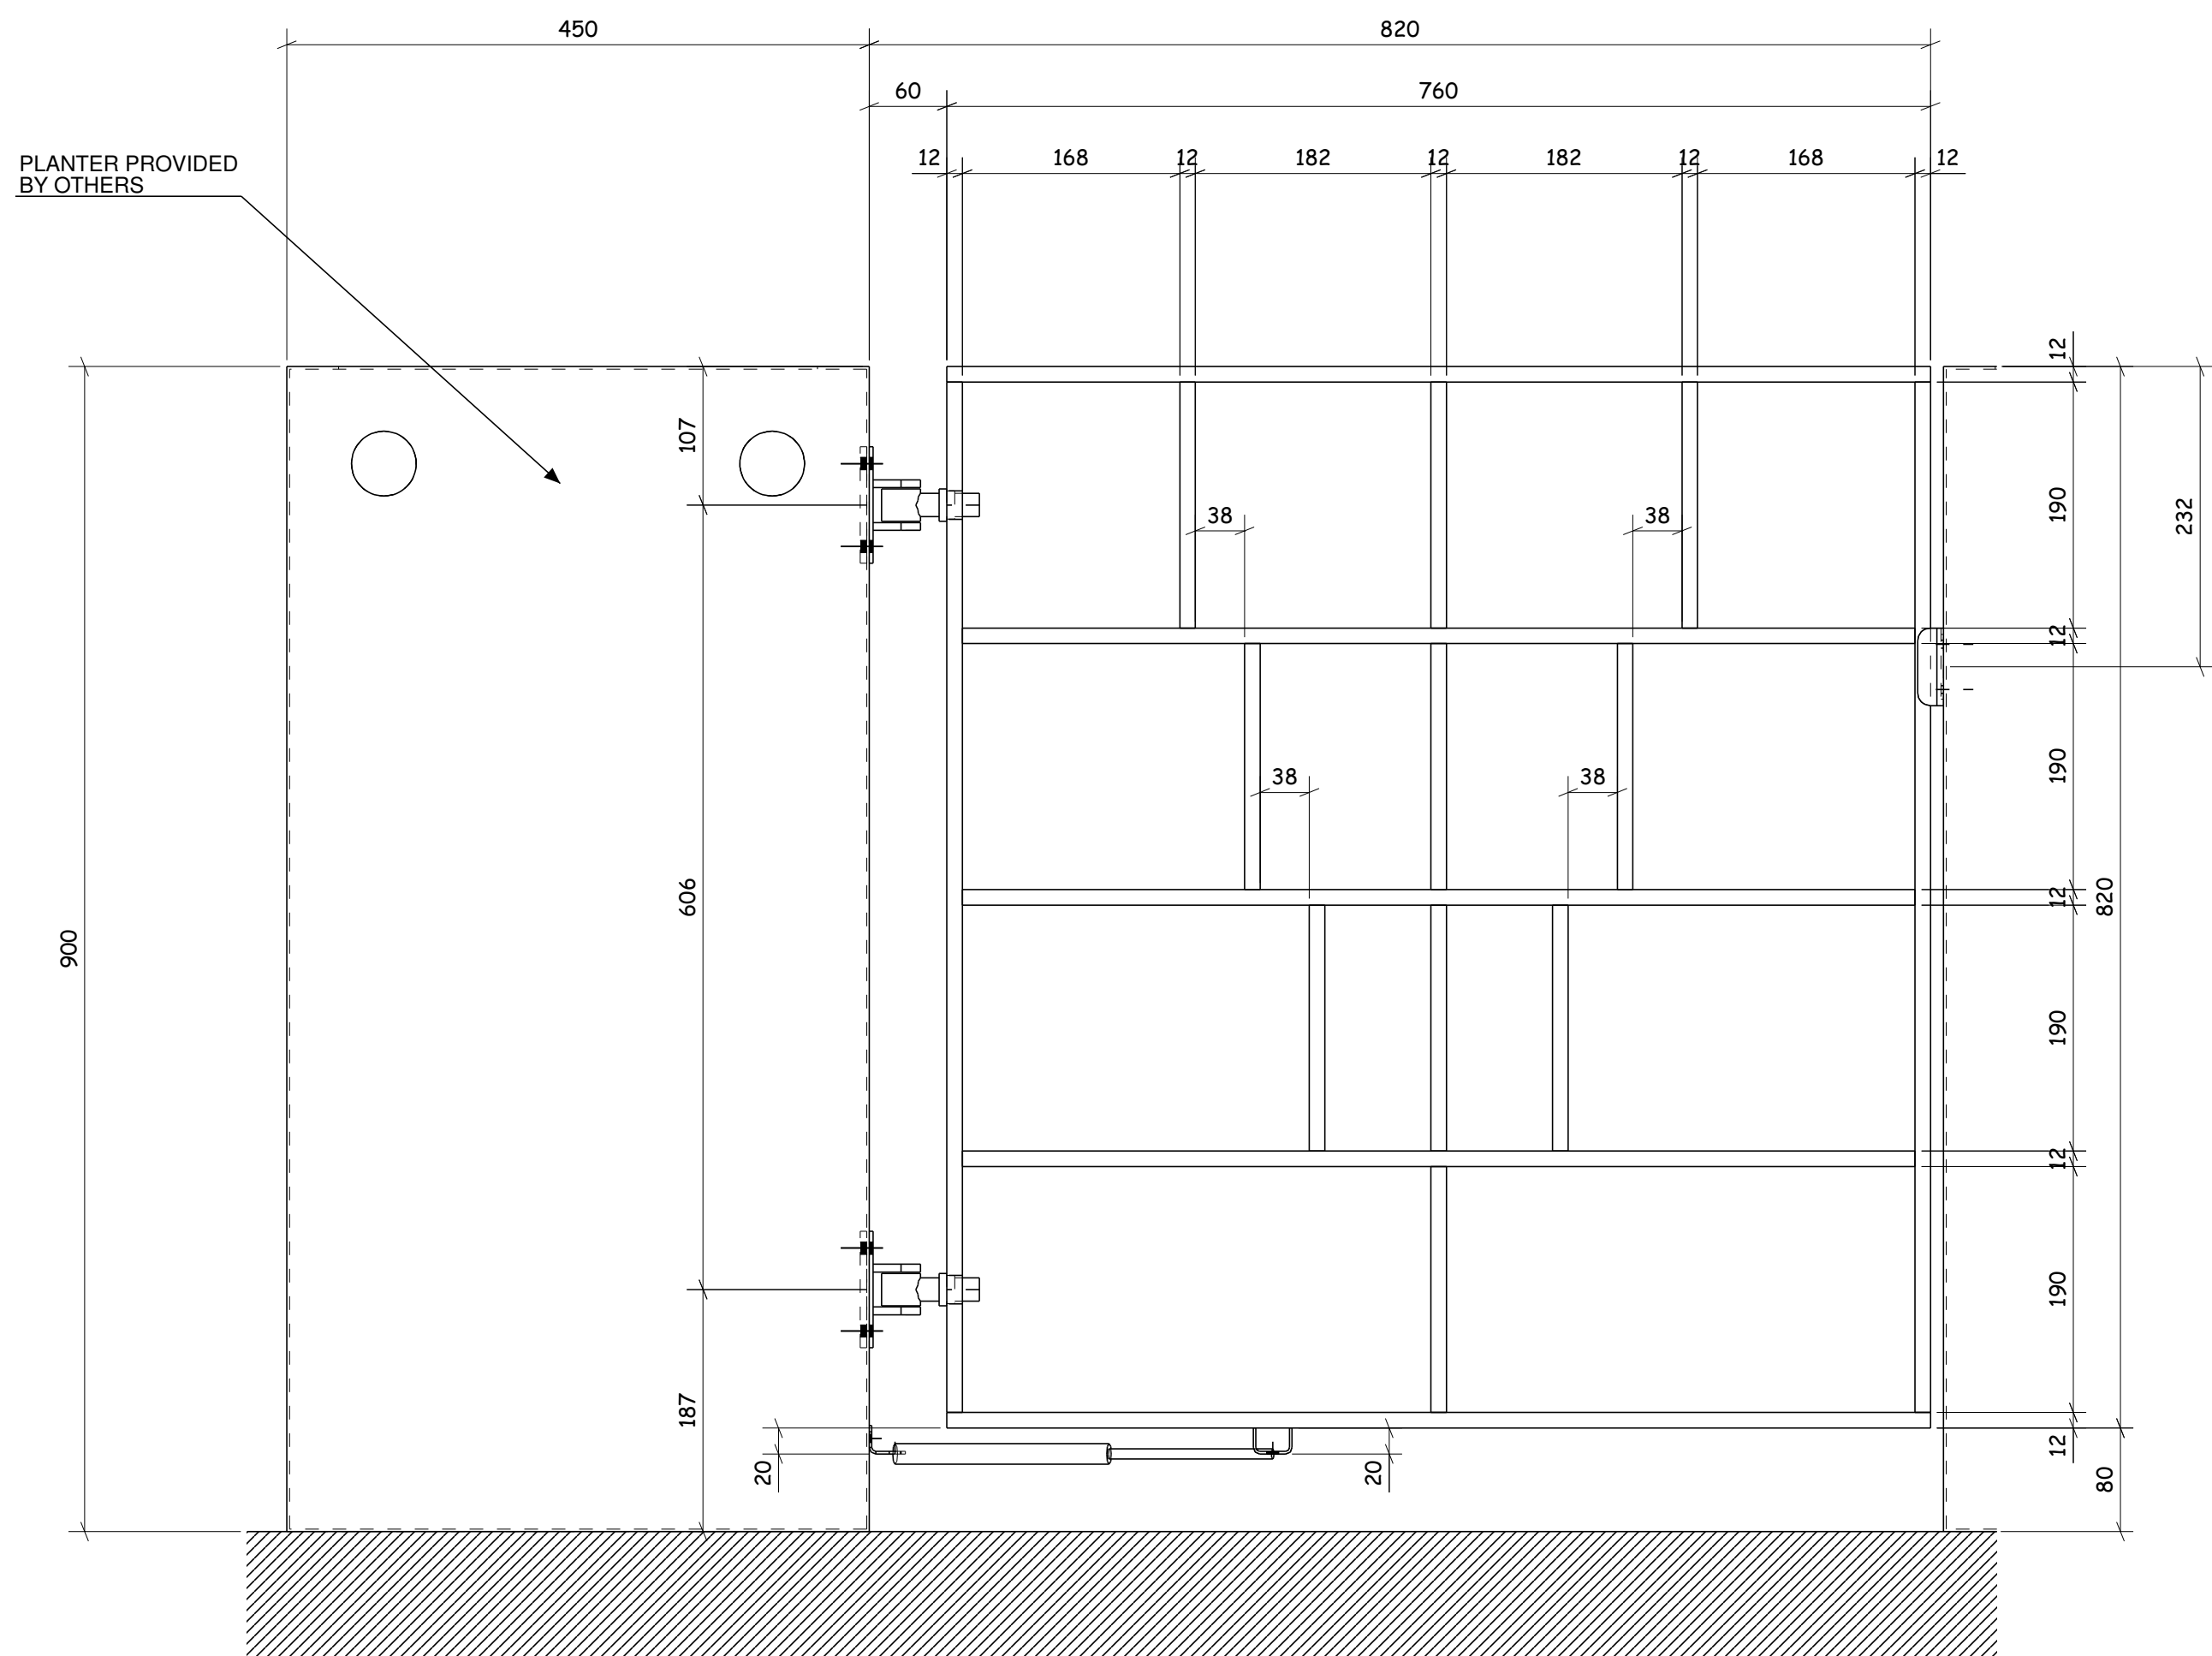

ISOMETRIC VIEW

NOTES:

10 No. GATES REQUIRED IN TOTAL
(5 TO OPEN AS DRAWN & 5 TO OPEN OPP HAND)

GATE TO BE MADE FROM 30 X 12 MILD STEEL FLAT BAR
FINISH - HOT ZINC SPRAYED & PPC RAL 7022 GLOSS

HINGES - FH BRUNDLE ADJUSTABLE HINGES - CODE 0515140
THE GATE HINGES WILL NEED TO BE INSTALLED PRIOR TO THE
PLANTERS BEING FILLED WITH SOIL

GAS SPRING GATE CLOSER FROM SIGNET LOCKS - CODE GS300

C02	GATE CLOSER ADDED	28.11.2022
C01	ISSUED FOR COMMENT	11.10.2022
REV MARK	REVISION DESCRIPTION	REVISION DATE

ARDMORE GROUP



DRAWING TITLE	TOWN HALL EXTERNAL GATE 15	
CONTRACT	HORNSEY TOWN HALL - GATE 15	
MODELLED BY	RJH	DATE 11.10.2022
CONTRACT NO	SEL1142	SCALE 1:5
DRAWING No	7414-16-001	REVISION No. C02



16. Gate 16-18 – Omitted

17. Gate 19 – Fire Escape from Annex

Drawing:

- 7414-28-001

Location:

- Within Mews courtyard, fire escape from Annex




Finish:


- RAL 9005 – black

Photograph:




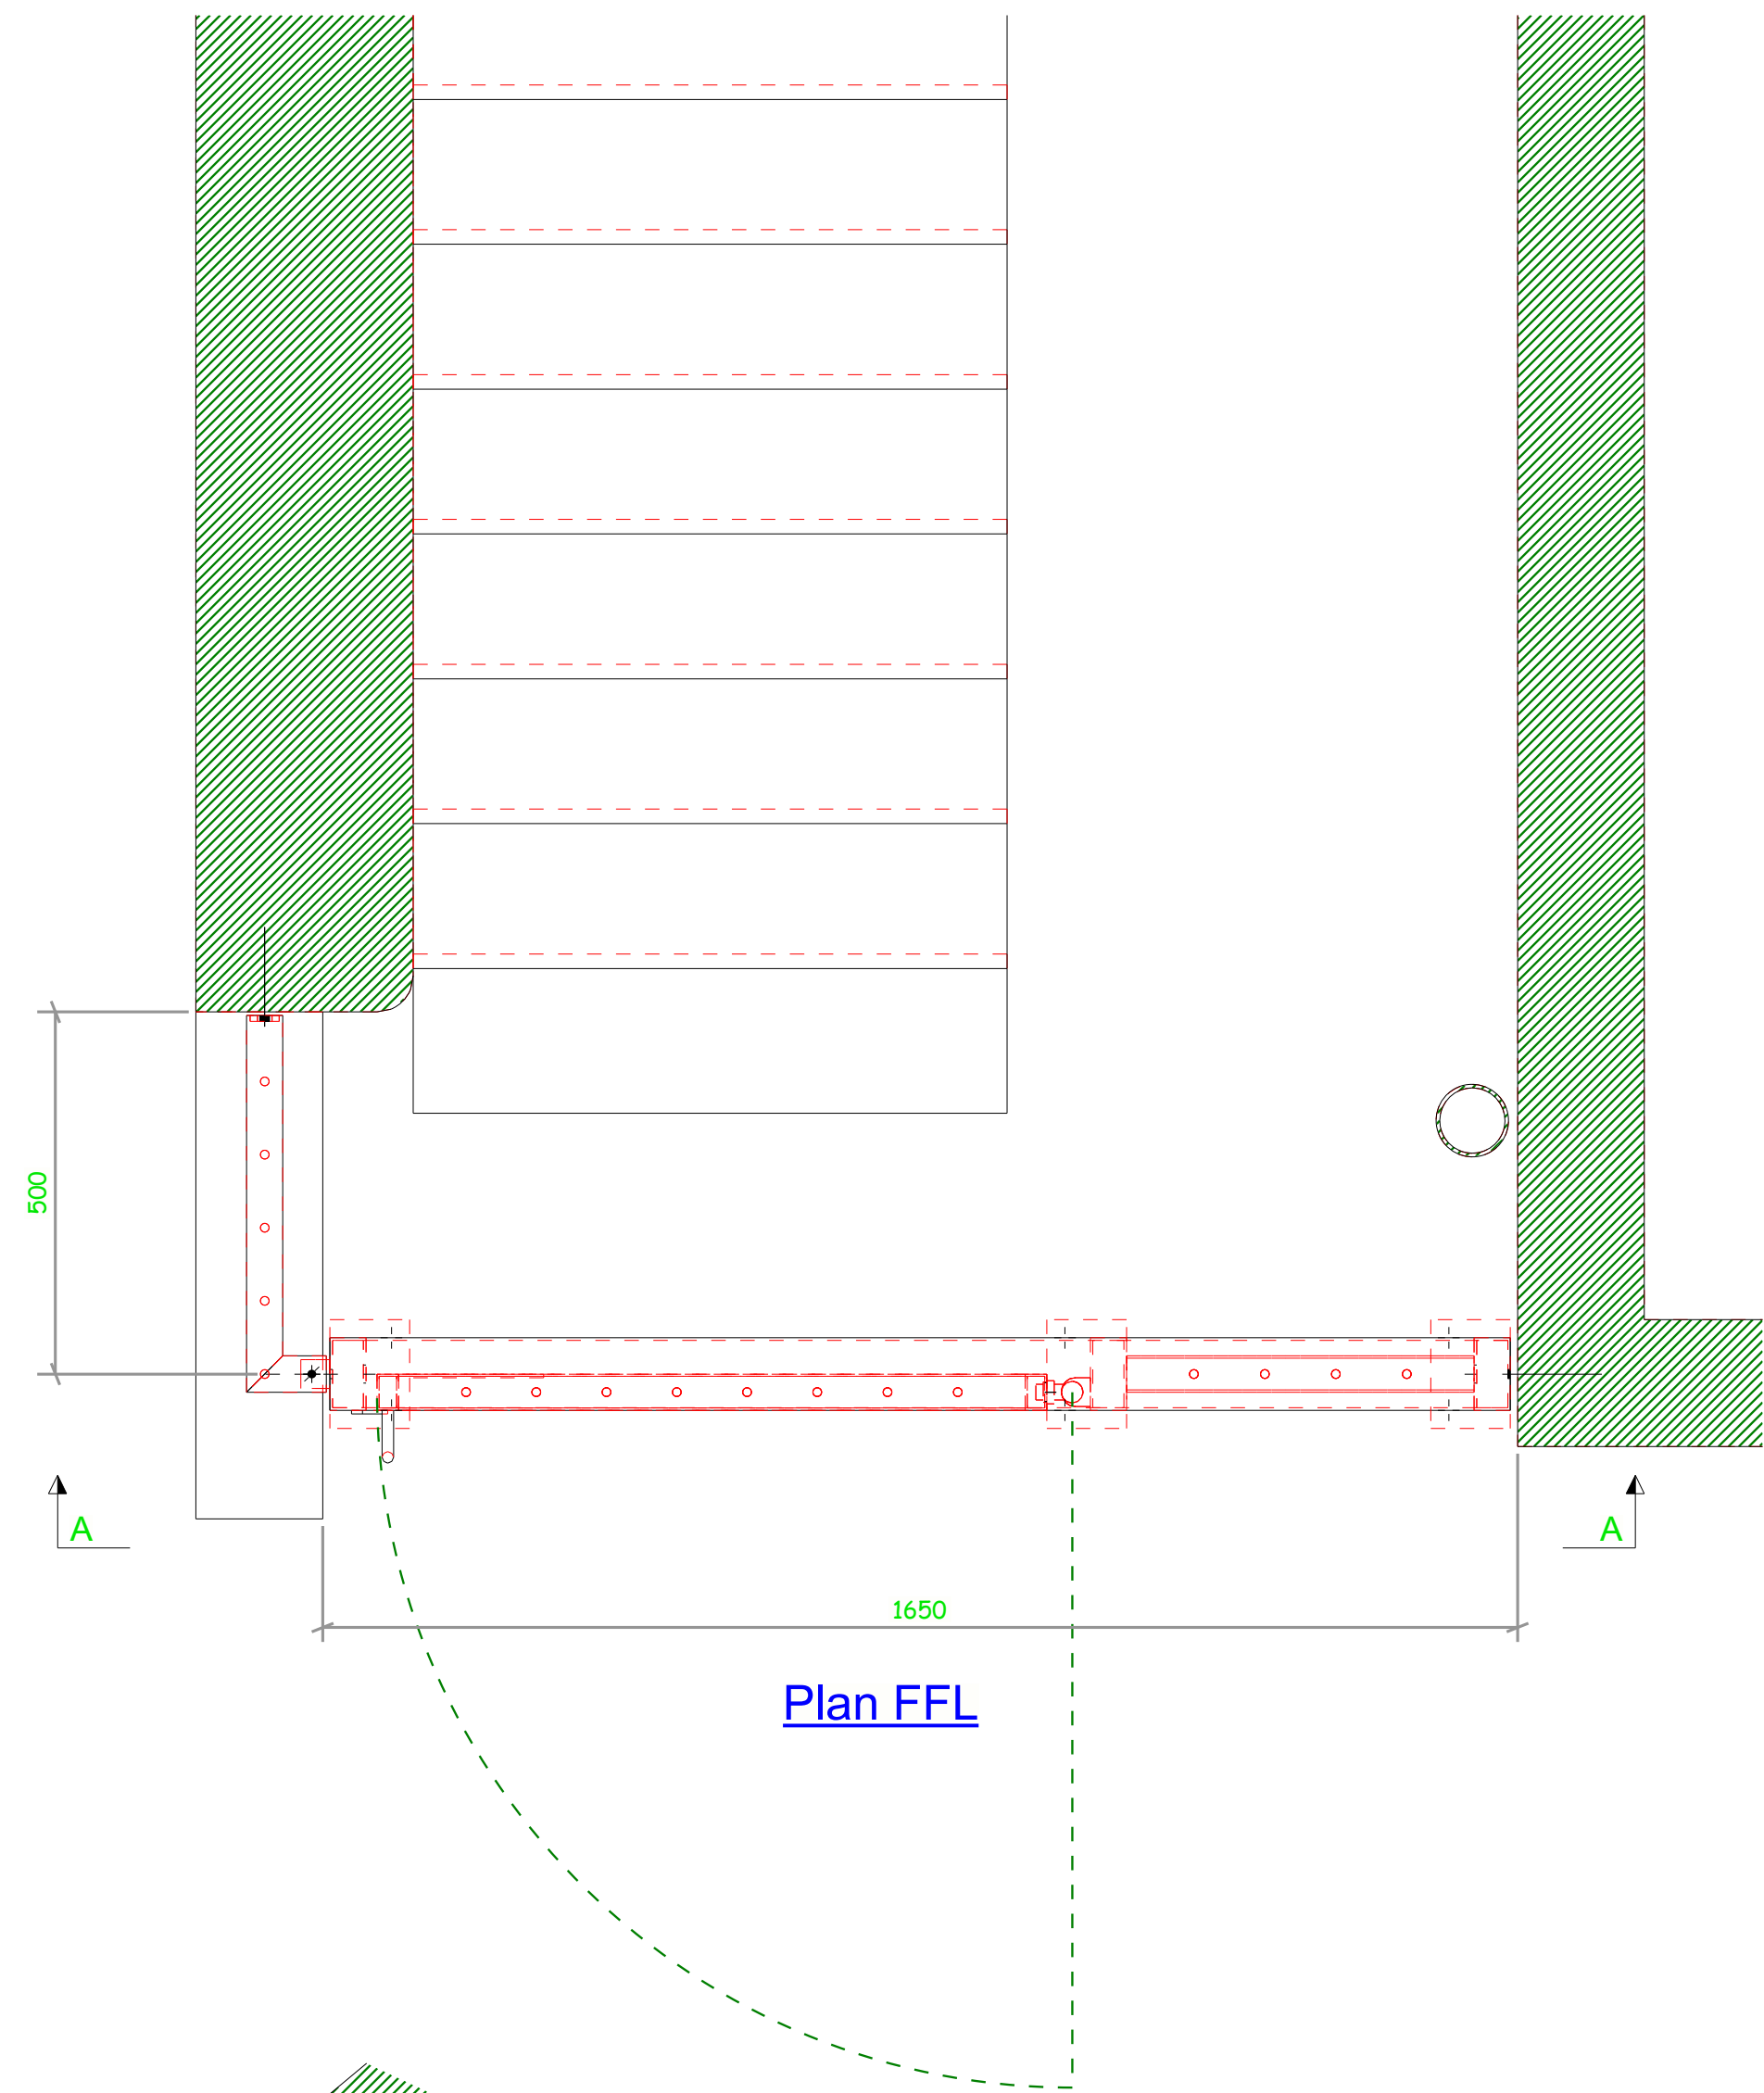

Plan FFL

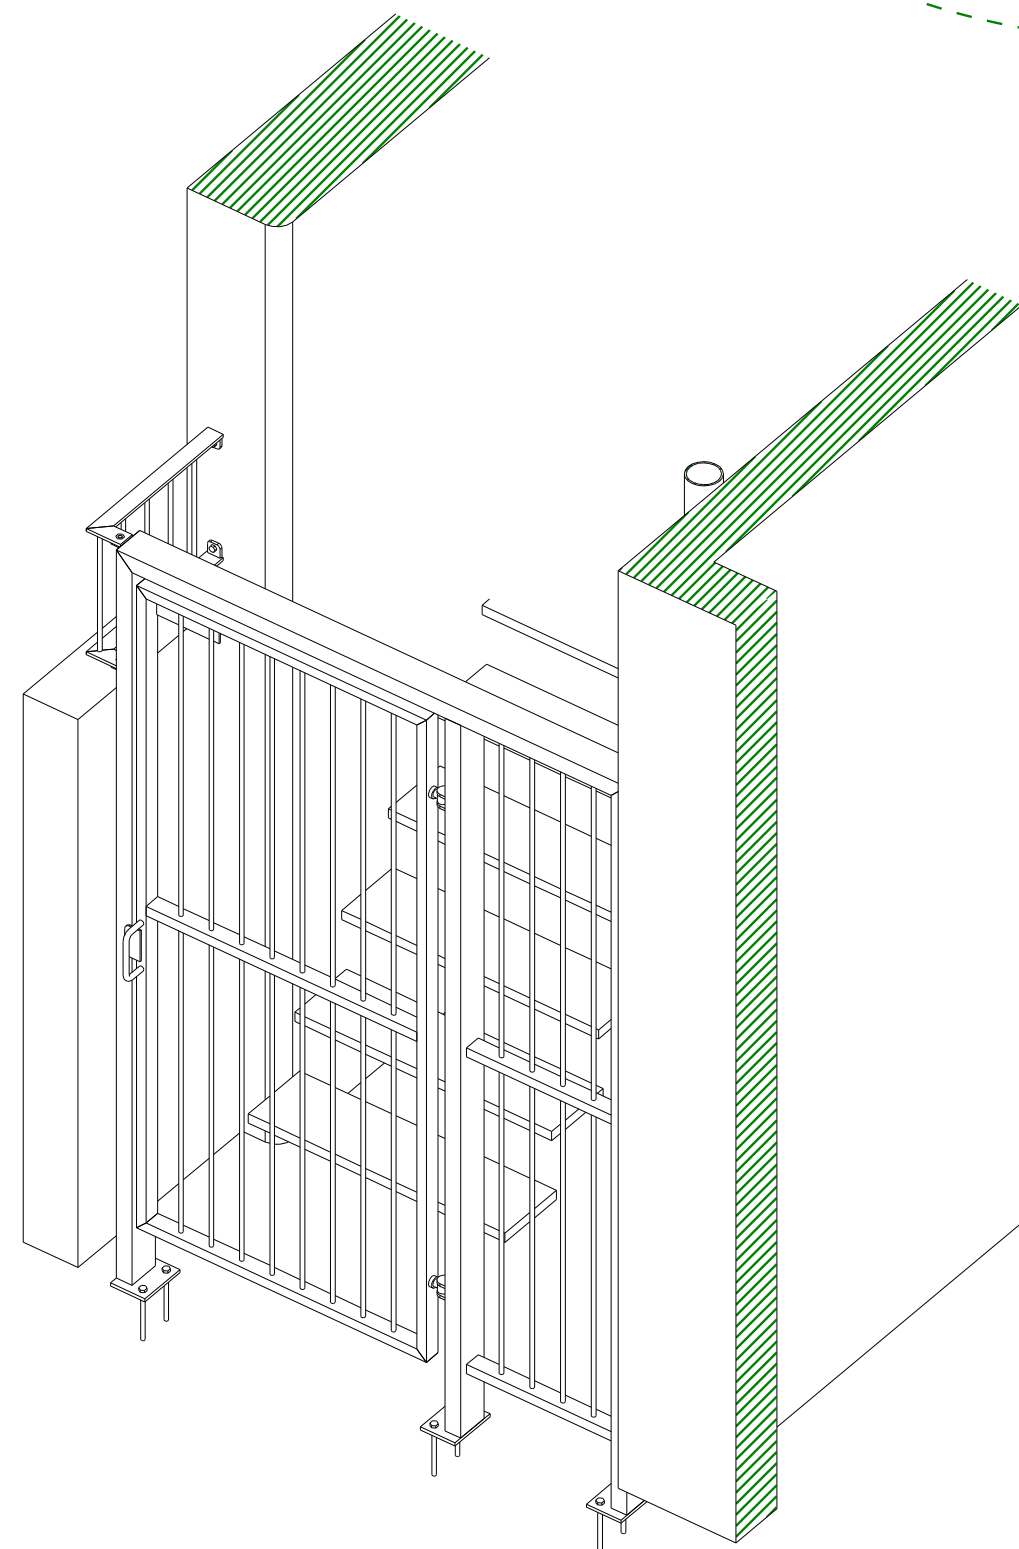


ISOMETRIC VIEW

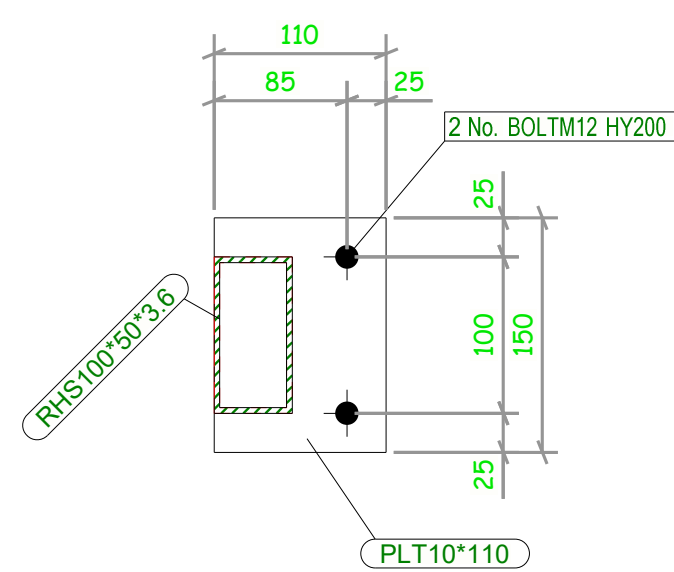


TYPICAL BASE PLATE

C - C

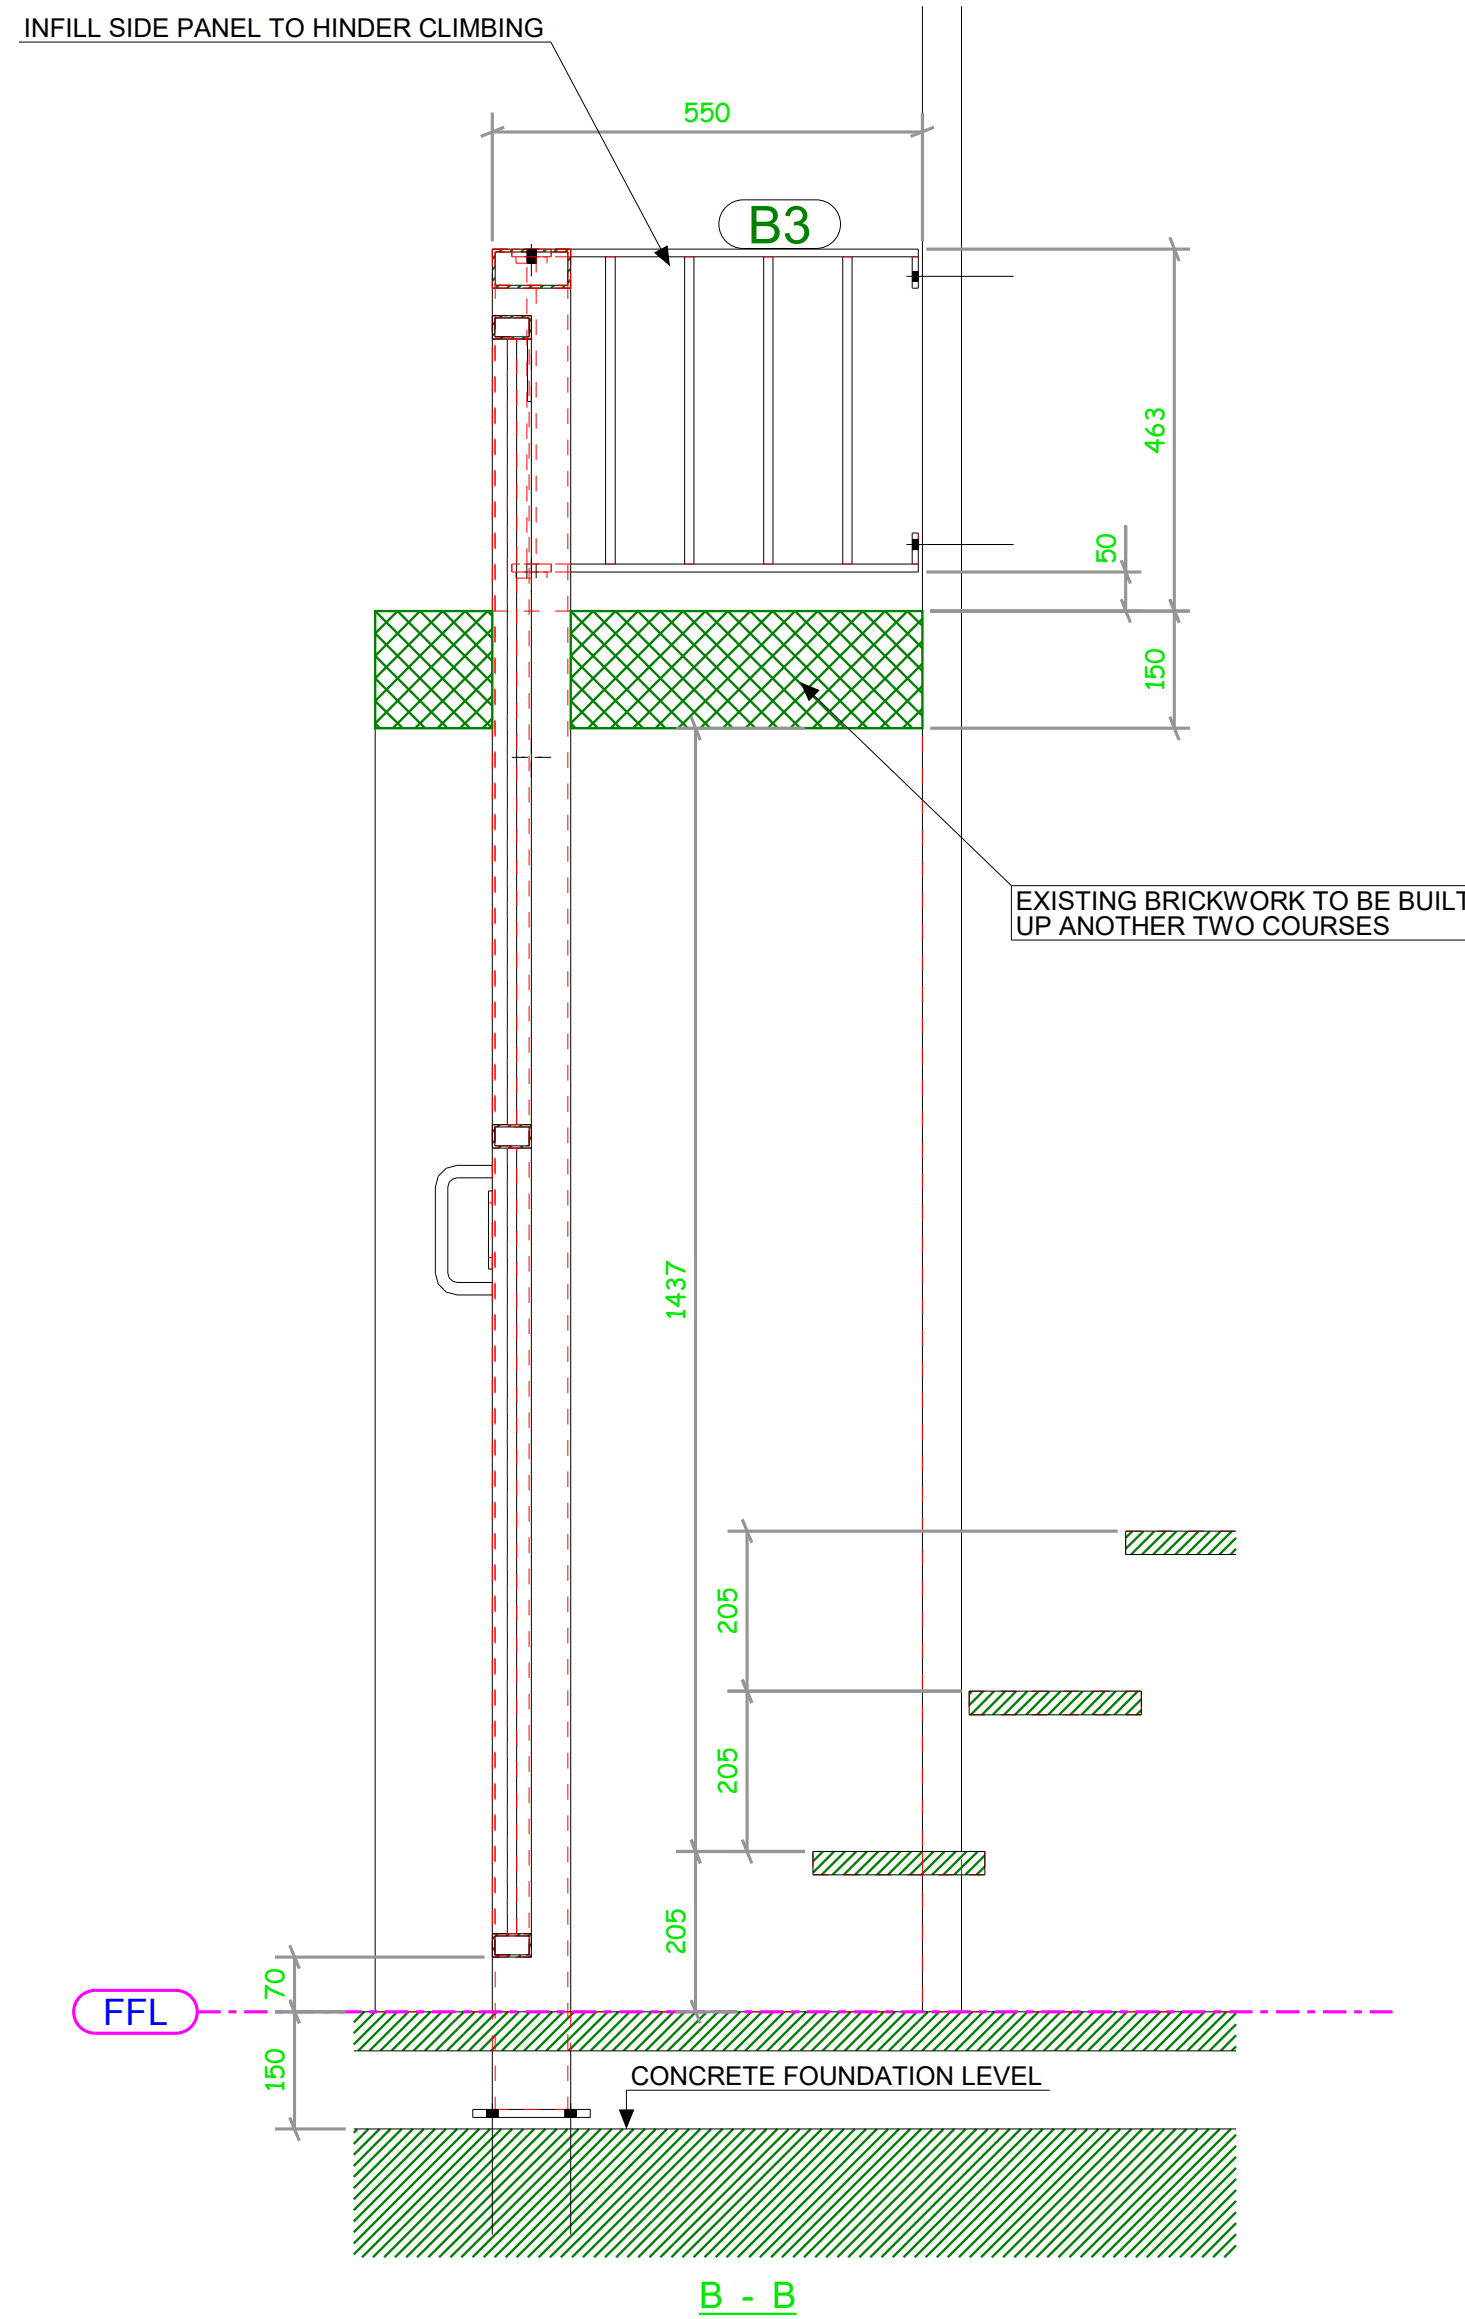

B - B

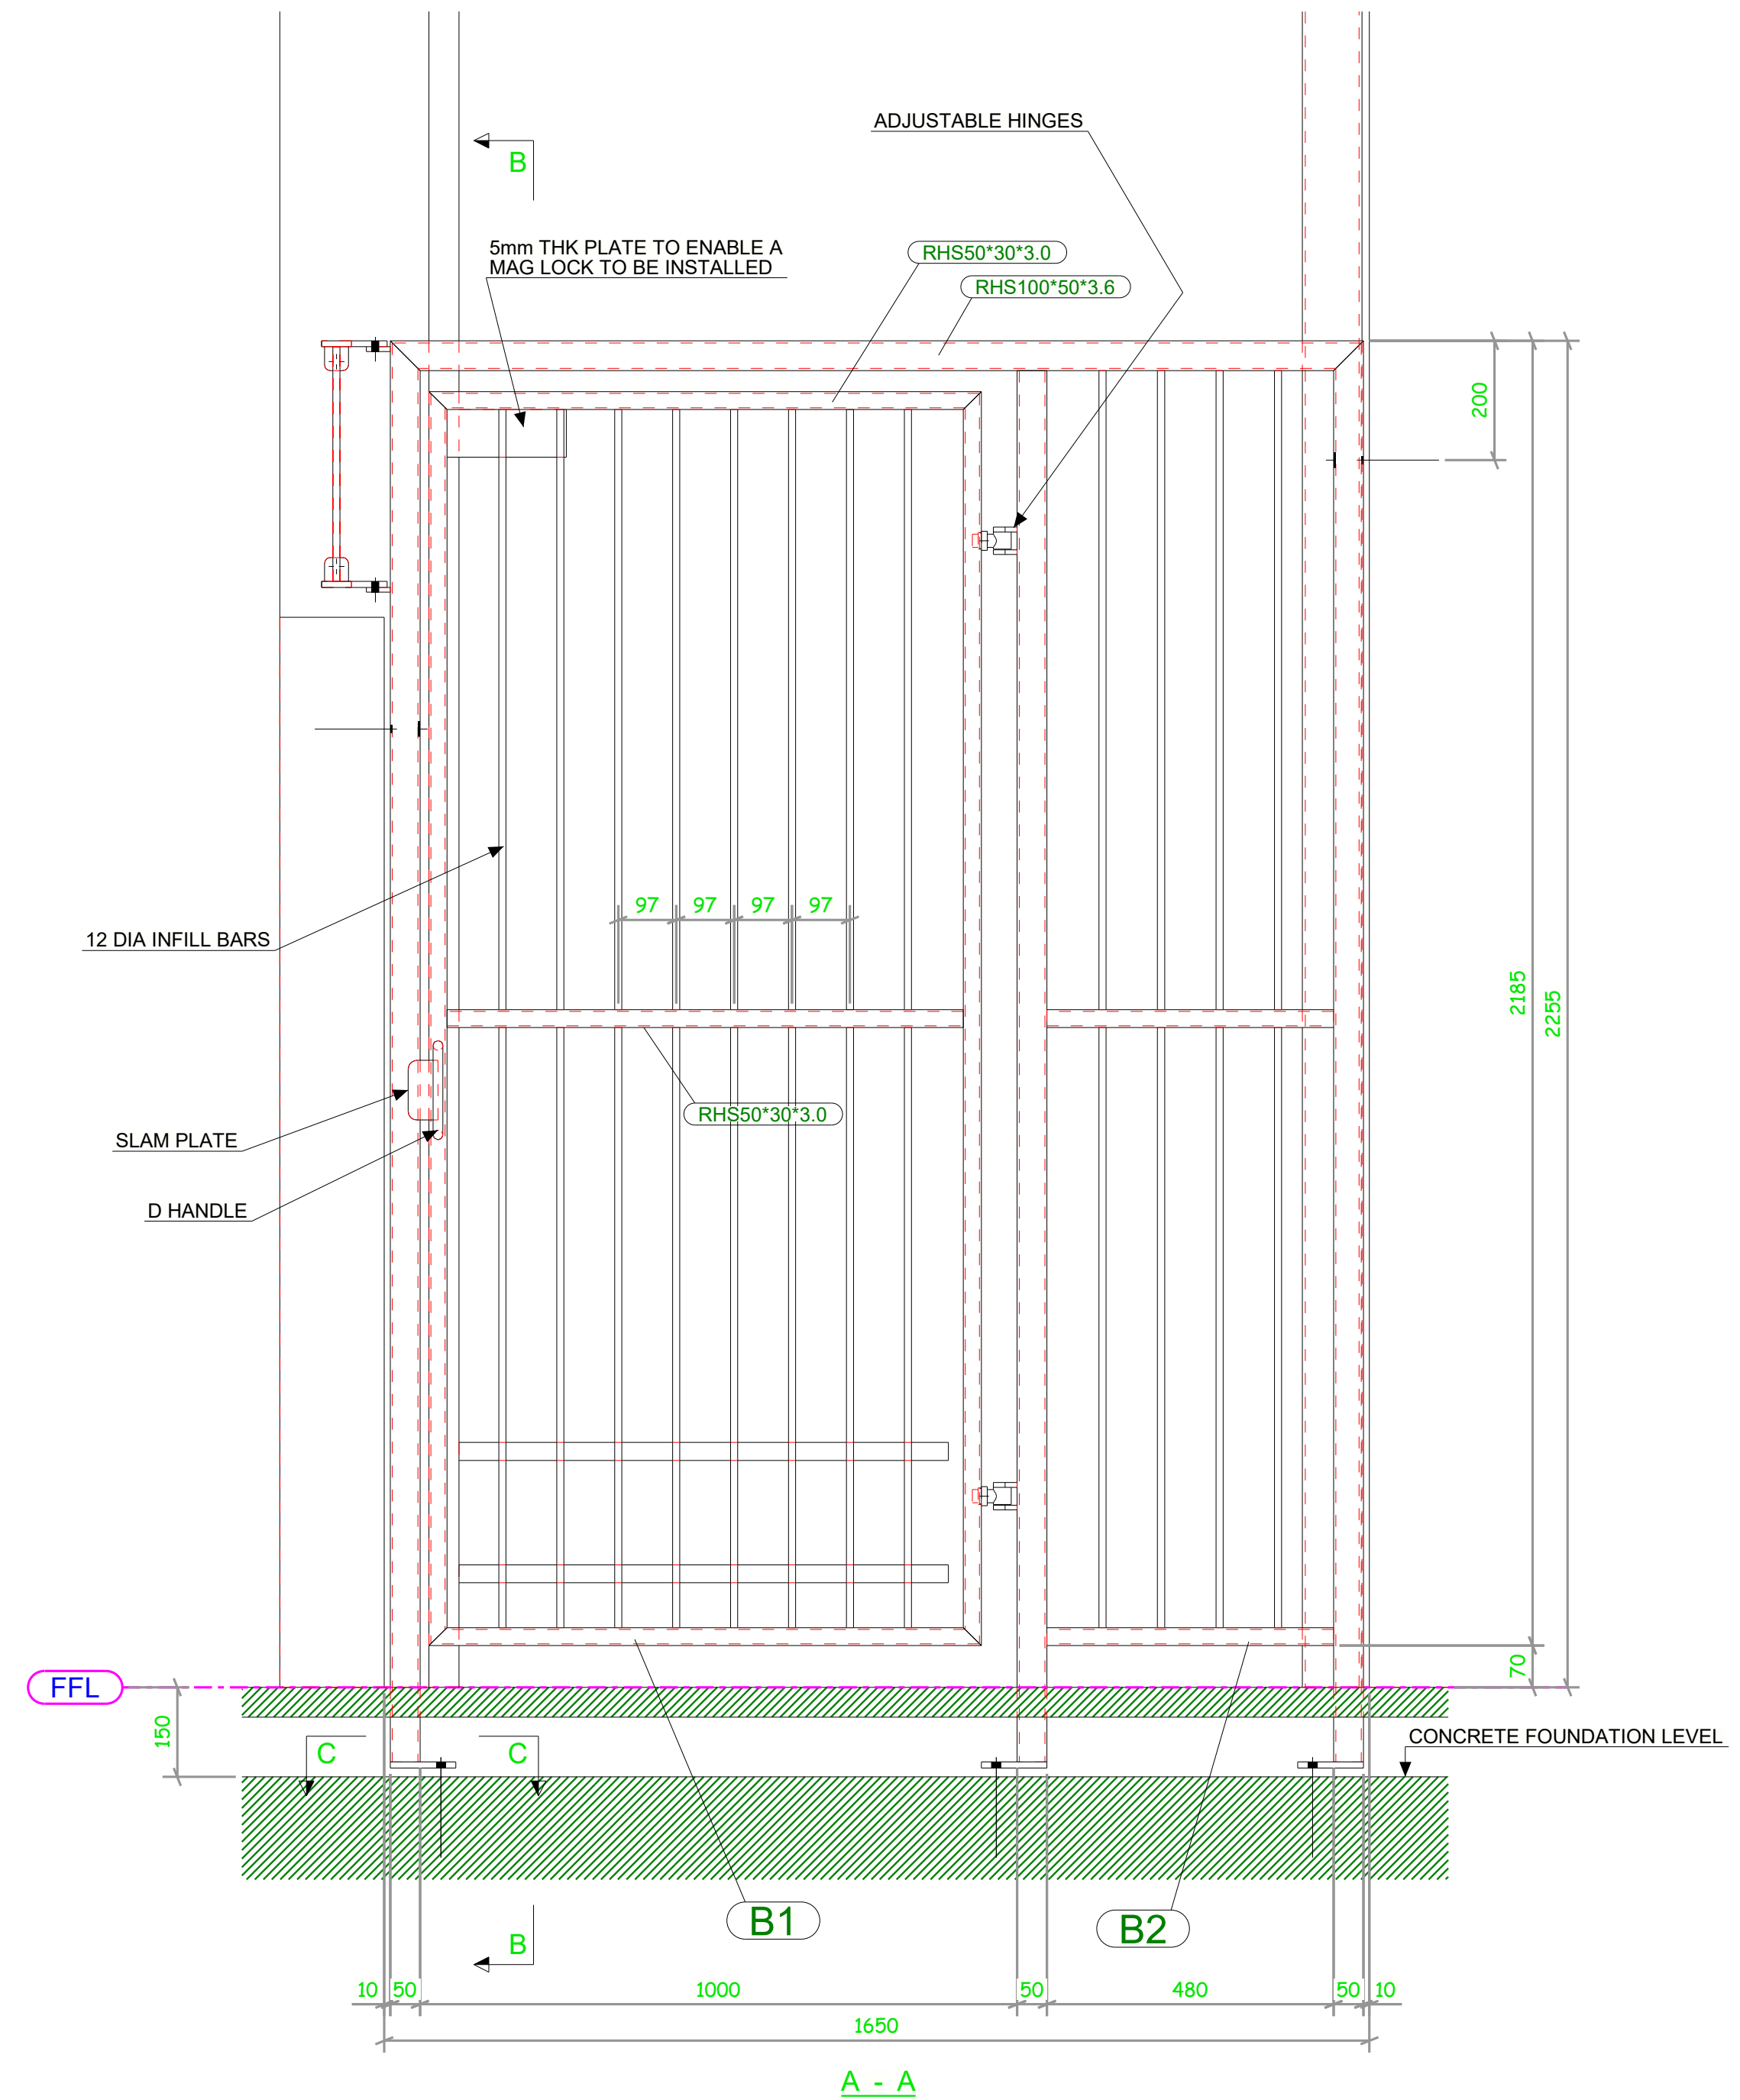

A - A

AS BUILT

NOTES:
GATE & FRAME TO BE MANUFACTURED FROM MILD STEEL
FINISH = HOT ZINC STRAYED & PPC RAL 7022
A SUITABLE CONCRETE FOUNDATION WILL NEED TO BE CAST PRIOR TO THE
GATE BEING INSTALLED 150mm BELOW THE FFL (355mm BELOW THE BOTTOM
STEP OF THE EXISTING STAIR)
MAG LOCK PLATE INCLUDED (MAG LOCK SUPPLIED & INSTALLED BY OTHERS)

AB1	ISSUED AS BUILT	22.03.2024
C02	ISSUED FOR CONSTRUCTION	21.12.2023
C01	ISSUED FOR COMMENT	27.11.2023
REV MARK	REVISION DESCRIPTION	REVISION DATE
ARDMORE		
		
DRAWING TITLE	GATE 19 - BROADWAY FIRE ESCAPE	
CONTRACT	HORNSEY TOWN HALL	
MODELLED BY	RJH	DATE 27.11.2023
CONTRACT NO	SEL1142	SCALE 1:5 1:10 1:20
DRAWING No	7414-28-001	REVISION No. AB1