
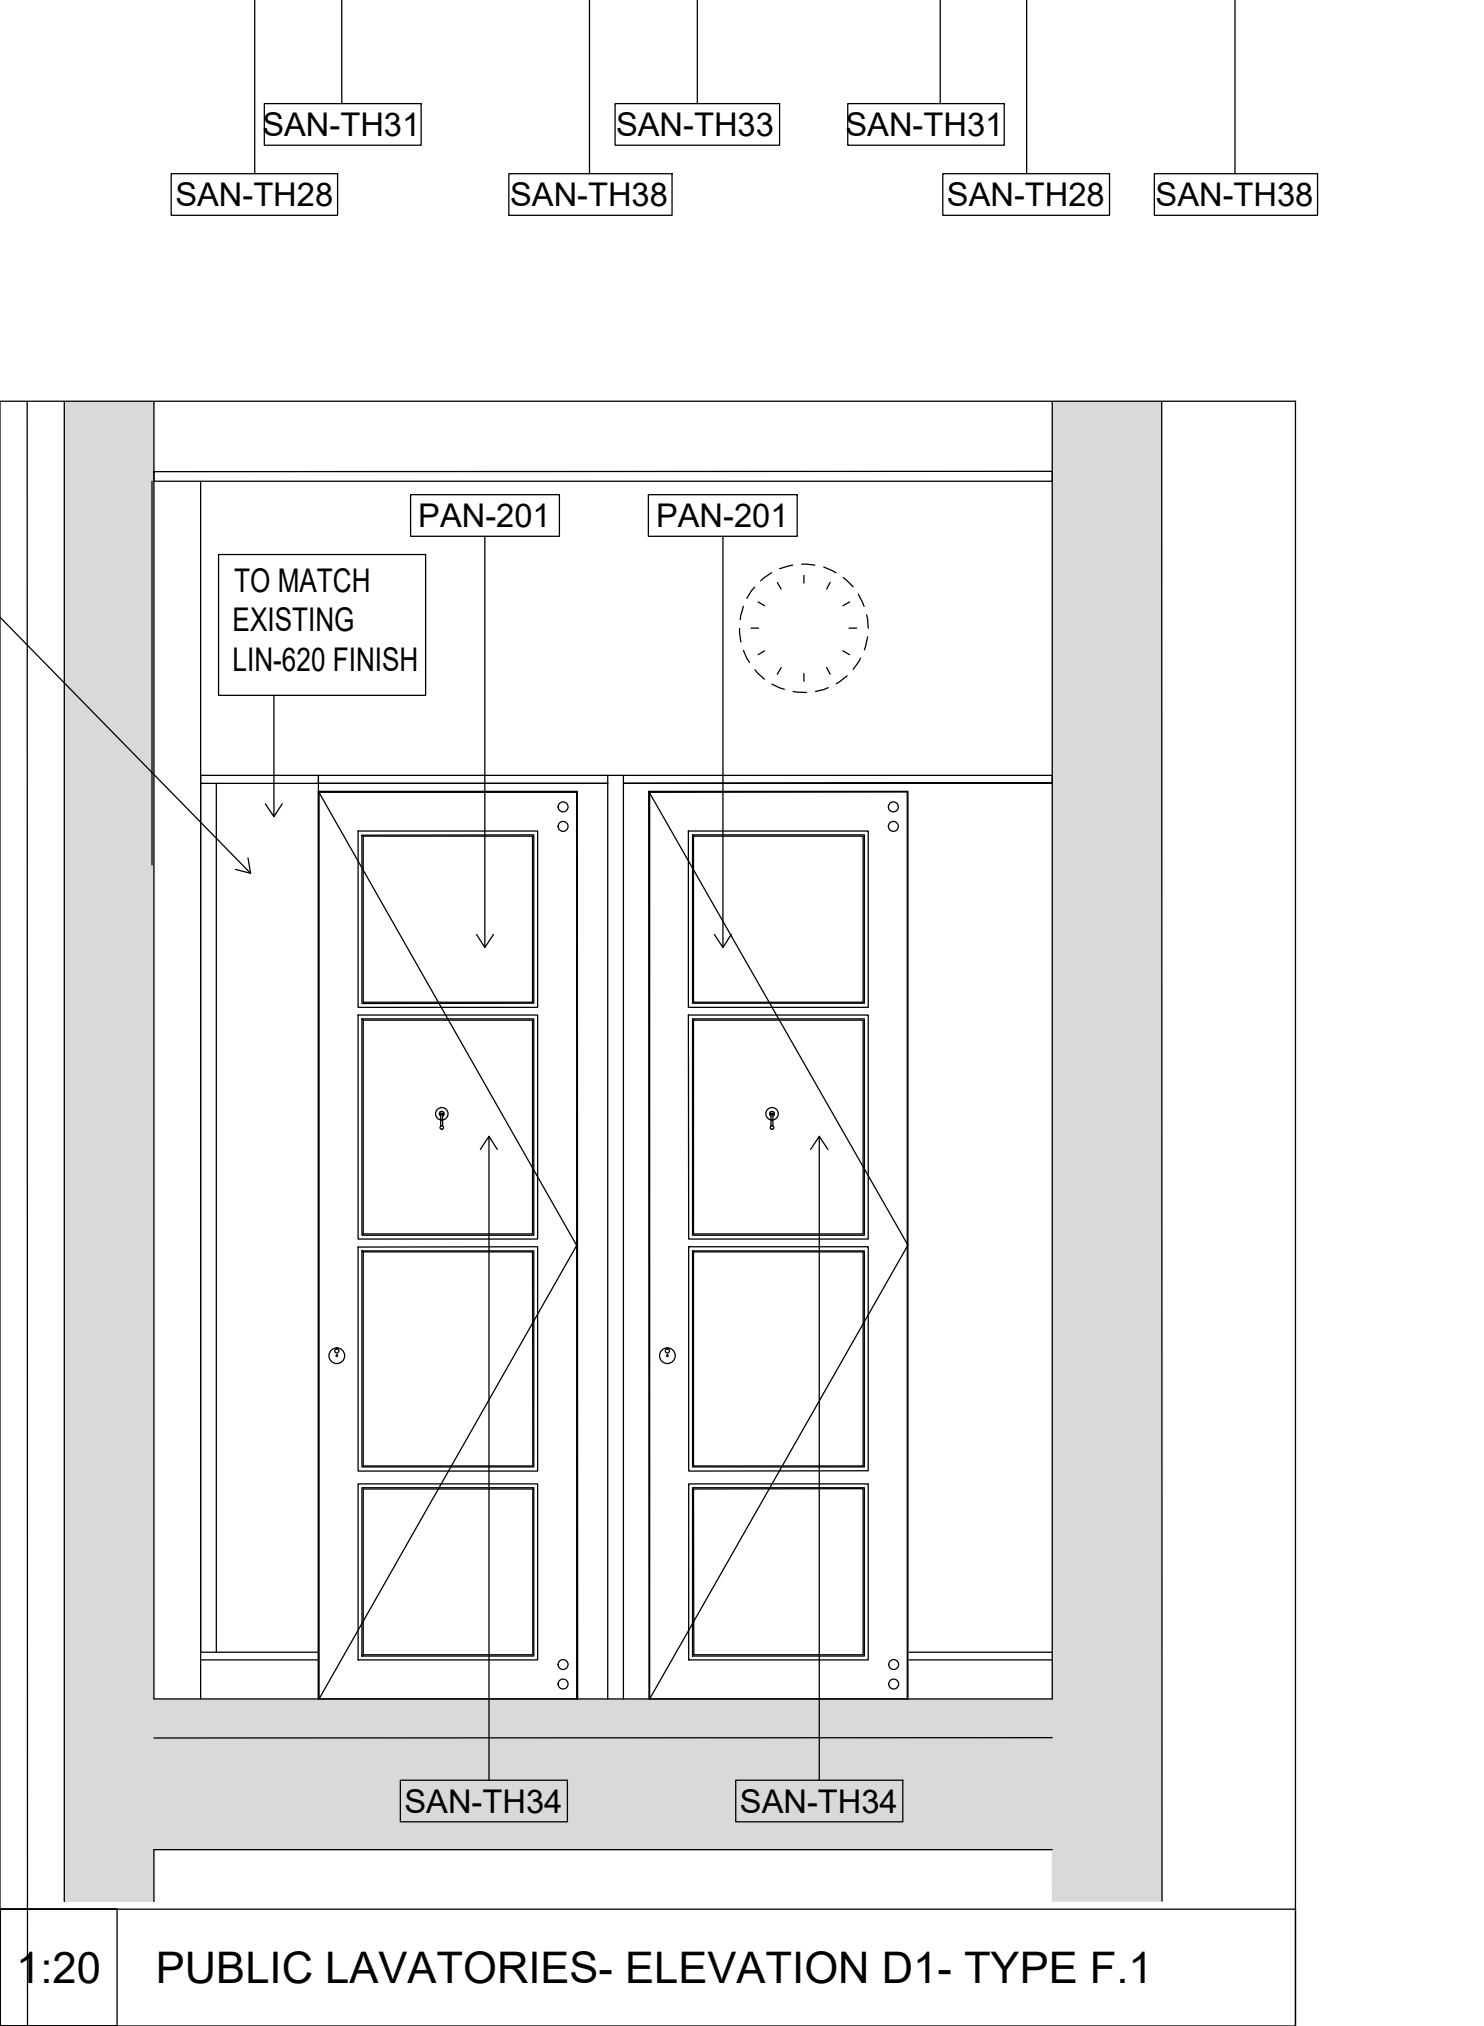
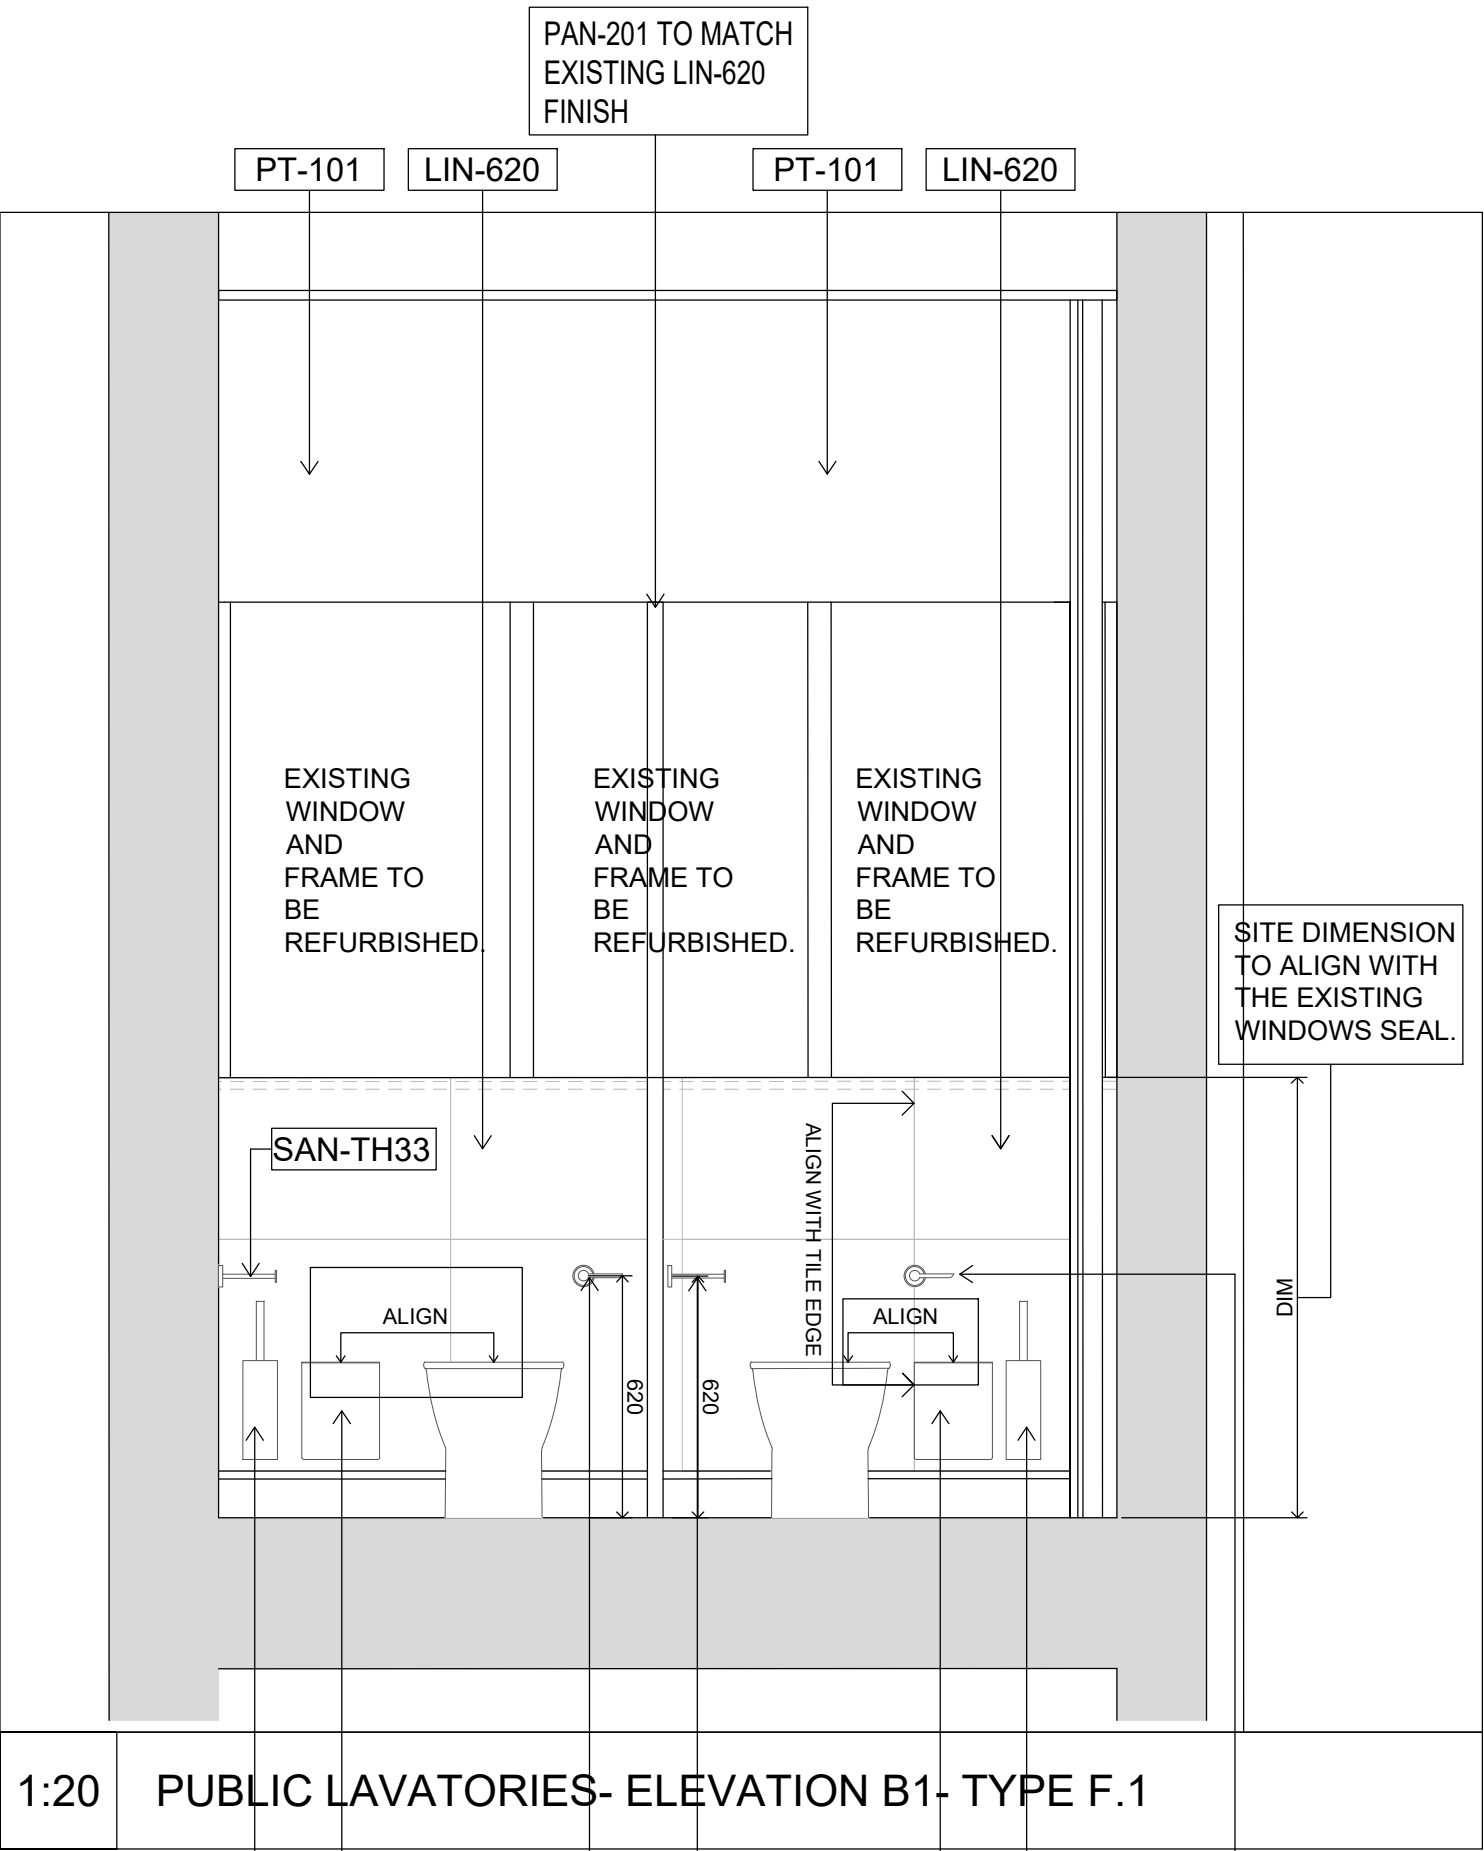
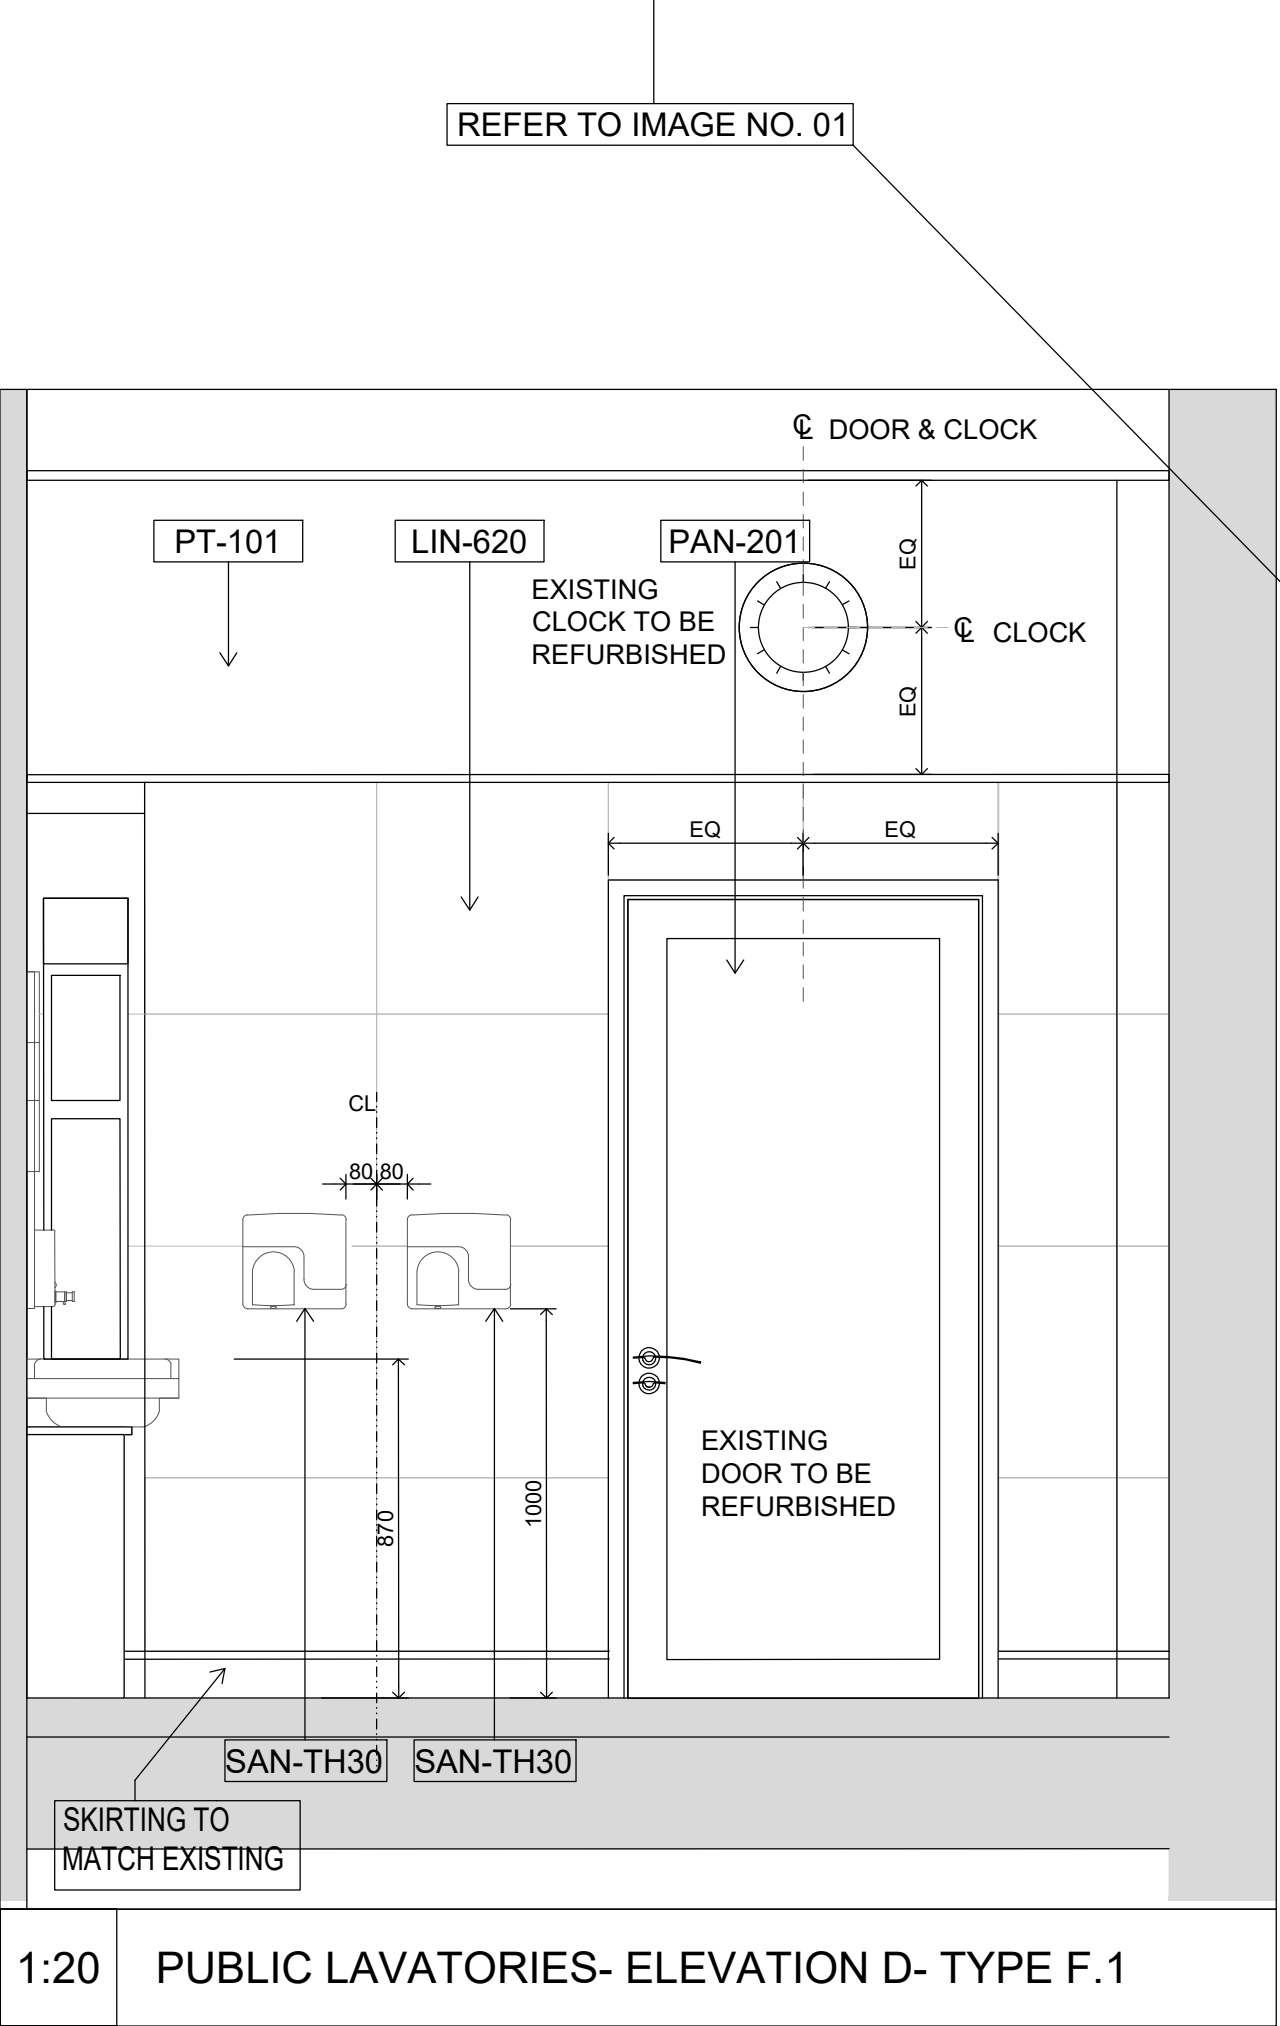
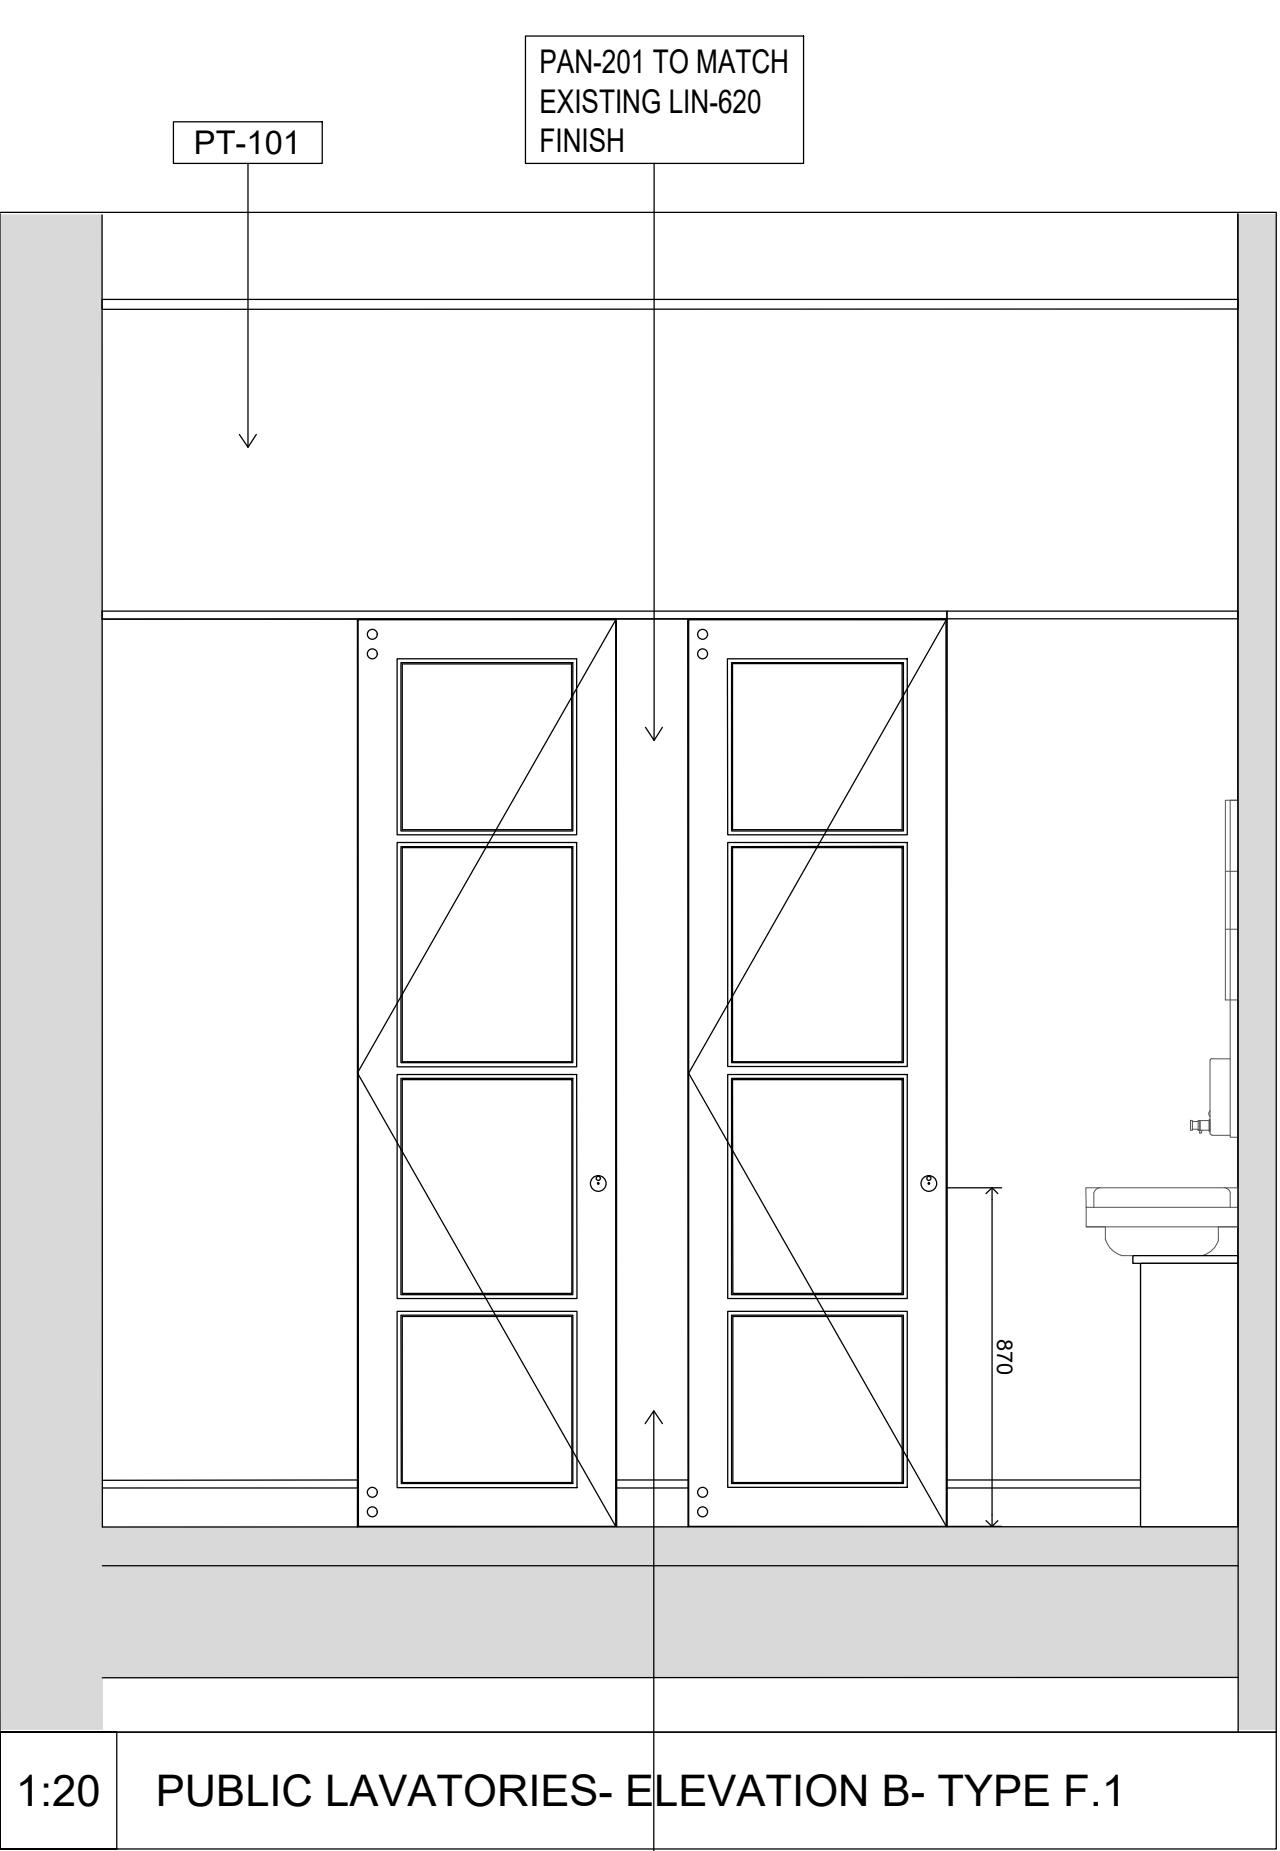
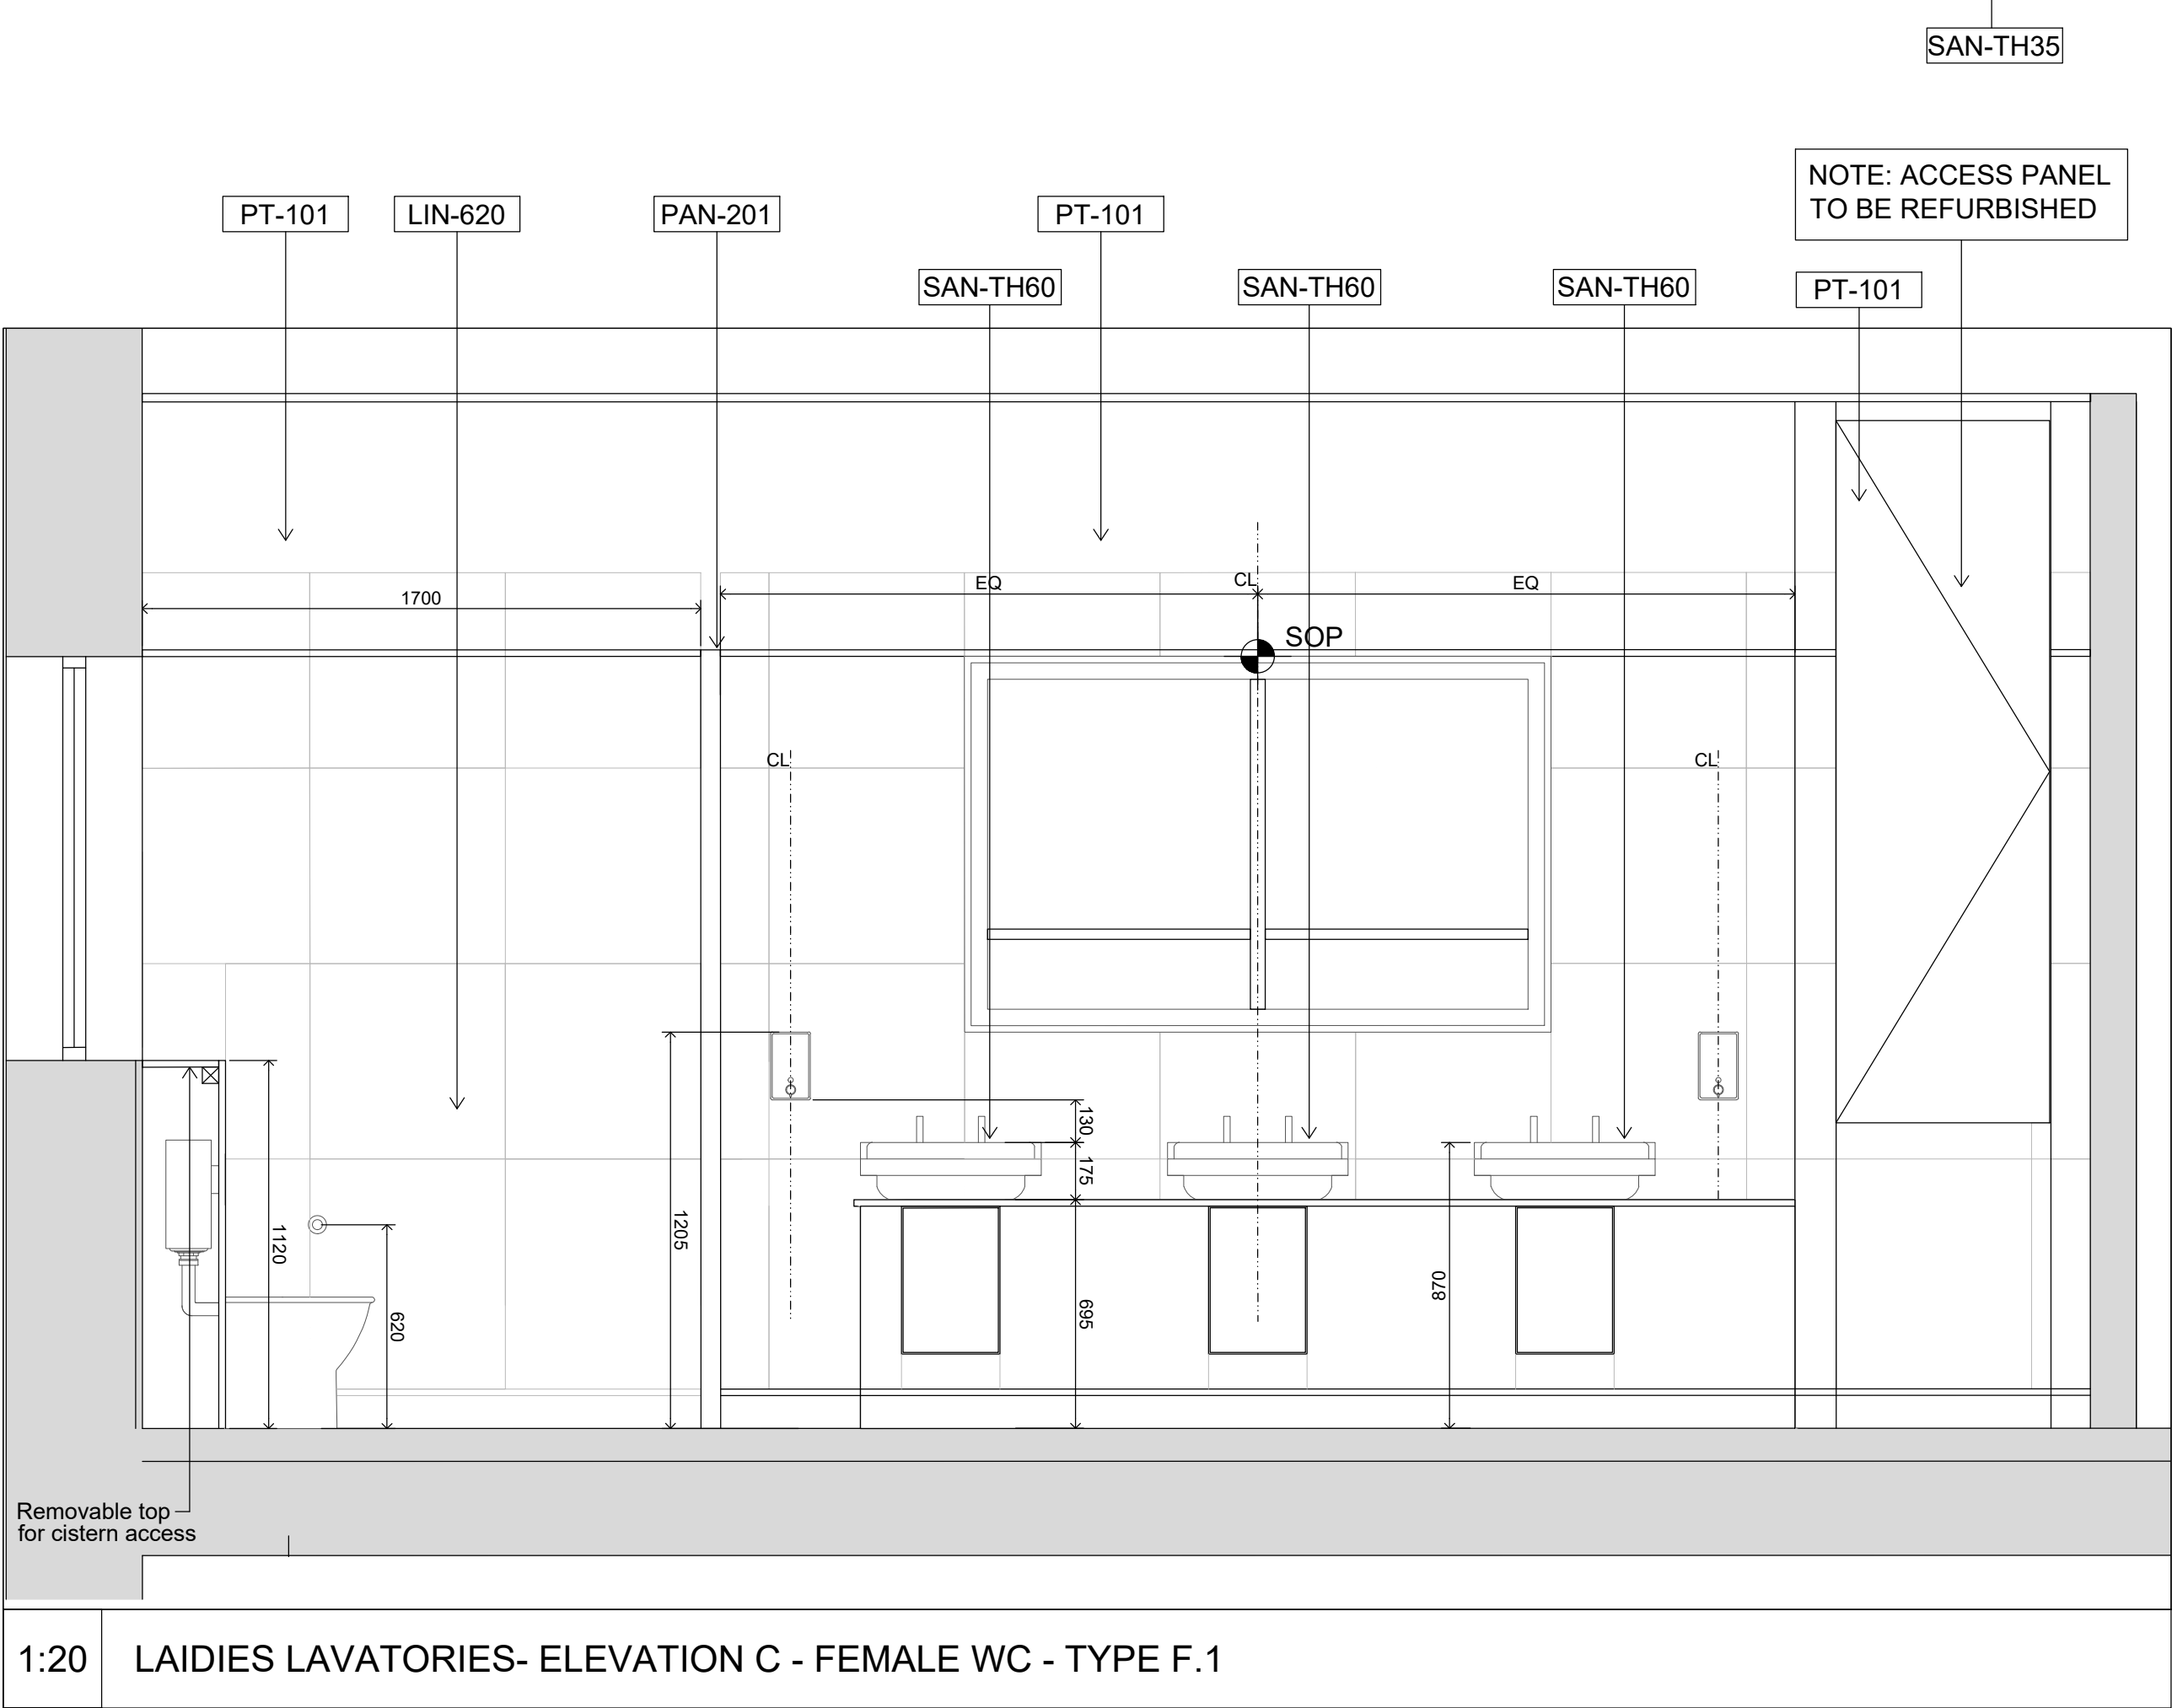


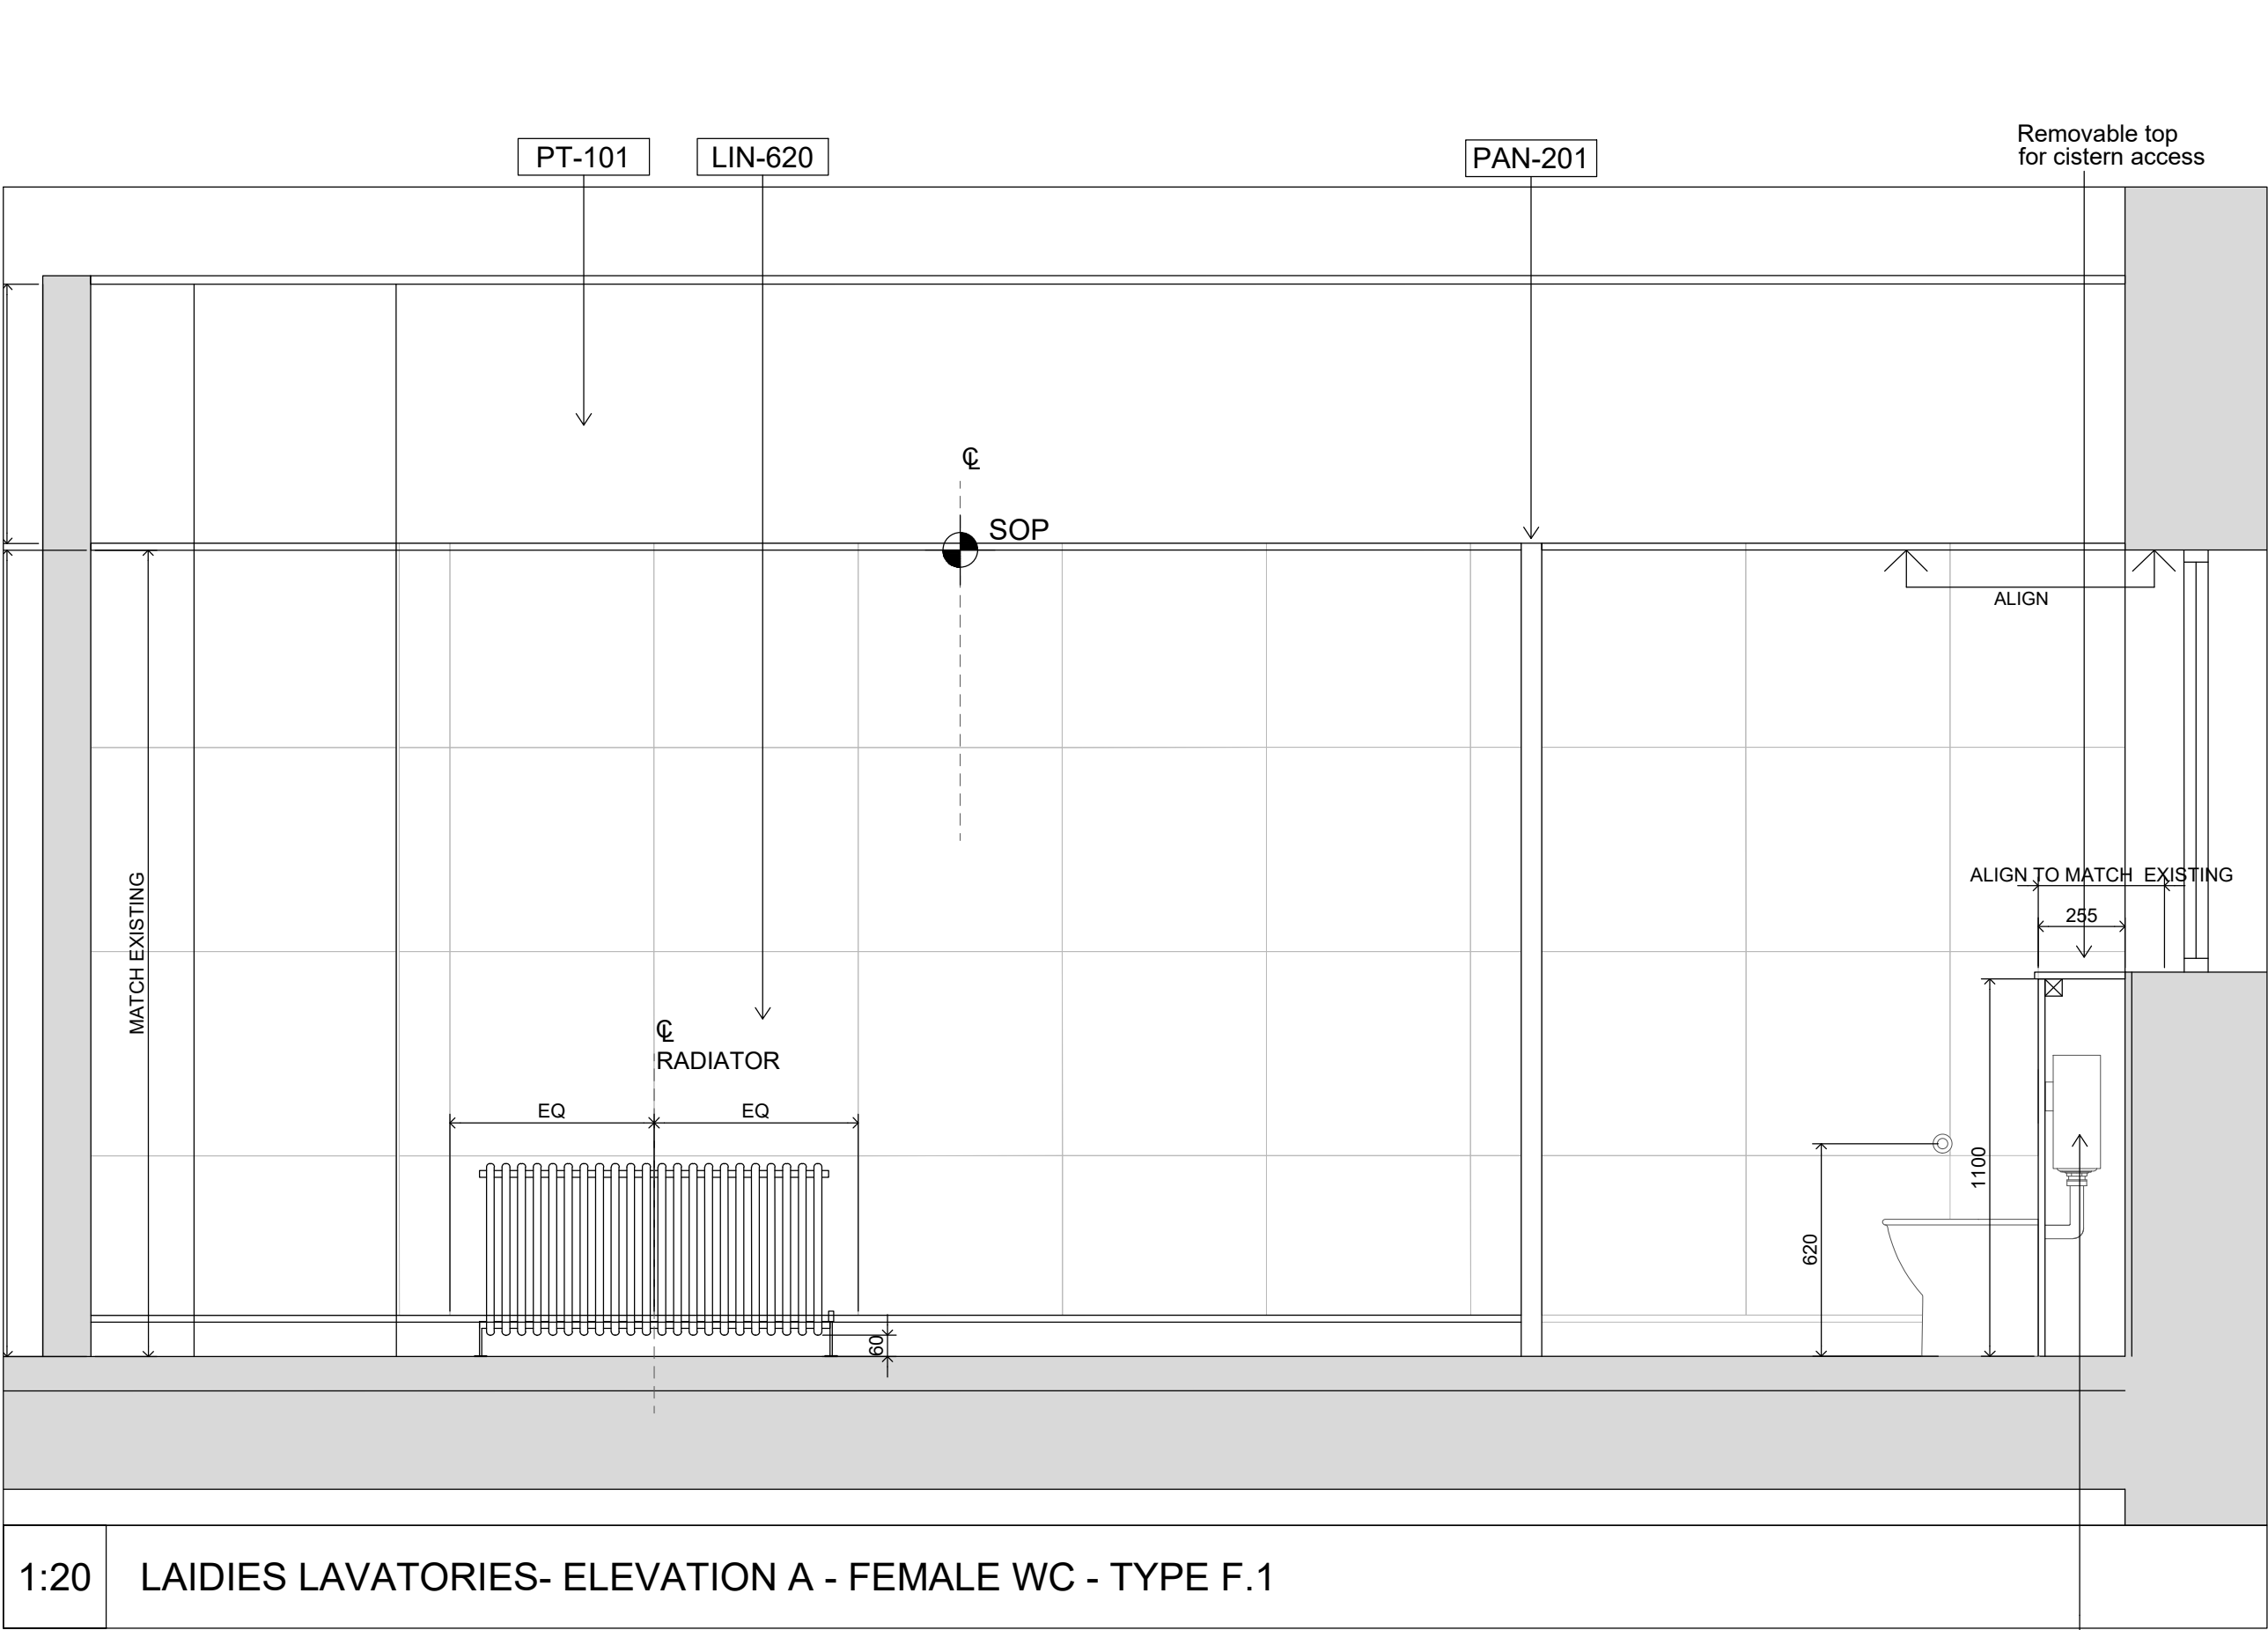

READ IN CONJUNCTION WITH THE DRAWING
3670-KDS-TH-ZZ-DR-A-74-2033

© KDS & Associates Ltd
No part of this drawing may be reproduced without written consent.
All contractors must visit site and be responsible for taking and checking all dimensions relating to this work.
Do not scale from this drawing.

REVISION NOTES				
C1	03.08.22	ZZK	FIRST ISSUE FOR CONSTRUCTION	
C2	08.09.22	ZZK	AMENDED AS HIGHLIGHTED.	

KDS ASSOCIATES LTD
TECHNICAL • ARCHITECTURAL • MANAGEMENT • CONSULTANTS
101 THE BLACKFRIARS FOUNDRY
156 BLACKFRIARS ROAD
LONDON SE1 8EN
0203 355 0775
www.kdsassociates.co.uk

BASE DRAWING REVISION ABOVE BY KDS ASSOCIATES				
REVISIONS BELOW BY LONGLANE ARCHITECTS				
C3	22-06-23	SP	LLA TITLE BLOCK & NOTE - AS BUILT	
C4	04-04-25	SP	VANITY UNITS BENEATH BASINS SHOWN TO REFLECT AS BUILT SITUATION.	


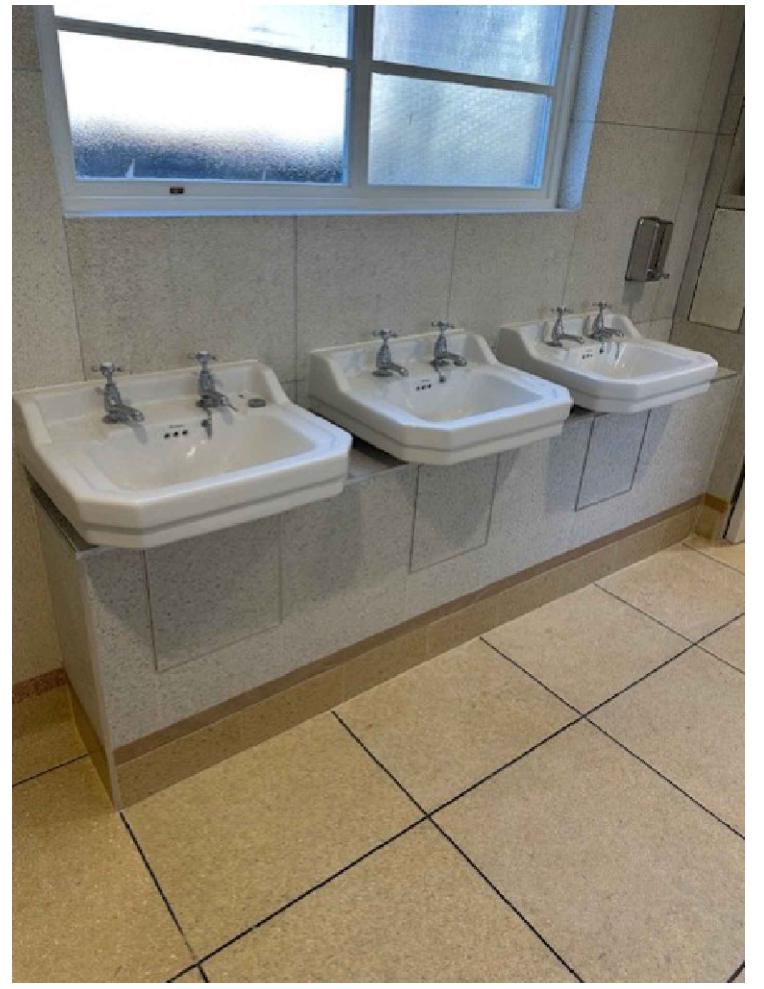


IMAGE NO. 01

NOTE: DRAWING GIVES ONLY HEIGHT SETTING OUT. THE WALL TILES ALIGN WITH THE EXISTING FLOOR AND NEW TILES.

NOTE: ALL THE WALL TILING TO FOLLOW THE FLOOR FINISHES AND WRAP UP.

NOTE: FOR ELECTRICAL DRAWINGS SYMBOLS LEGEND REFER TO WHITECODE DRAWING NO: 10687-E-01-XX-0001

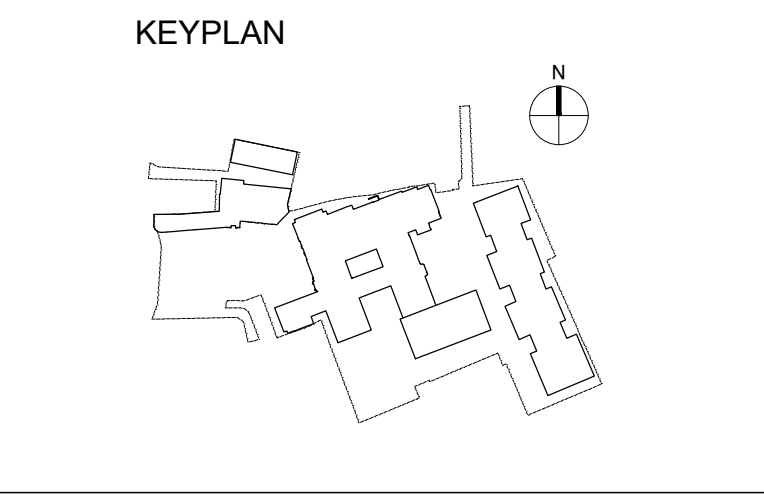

Ardmore GROUP
ARDMORE CONSTRUCTION LTD
6 WHARF STUDIOS,
28 WHARF ROAD,
LONDON, N1 7GR
TEL: 0208-344 0300
www.ardmoregroup.co.uk

Longlane Architects
5 Tanner Street
London, SE1 3LE
office@longlanearchitects.co.uk

AS BUILT

PROJECT / DRAWING TITLE HORNSEY TOWN HALL TOWN HALL & BROADWAY ANNEX LONDON N8 9JJ	
DRAWING TITLE TOWN HALL PUBLIC AREAS LADIES LAVATORIES- ELEVATIONS- TYPE F.1	
DATE / DRAWN BY 27.06.22 ZZK	SCALE 1:20 @A1
PROJECT / DRAWING NO 3670-KDS-TH-ZZ-DR-A-74-2000	REV C4