


Fire strategy to be read in conjunction with latest version of: 622399-MLM-ZZ-XX-RP-YF-001- Hornsey Town Hall Fire Strategy Report_Hornsey Town Hall Fire Strategy Report

[illegible]

PROJECT / DRAWING TITLE				
Hornsey Town Hall				
DRAWING TITLE				
RESIDENTIAL BLOCK A				
Fire Strategy - L05 South Core				
DATE / DRAWN BY			SCALE	
20/12/17 MD			1 : 100	
PROJECT NO	ZONE	LEVEL	TYPE	ROLE CLASS DR. NO.
3596-KDS	BA-05	DR-A	68-1013	REV C3

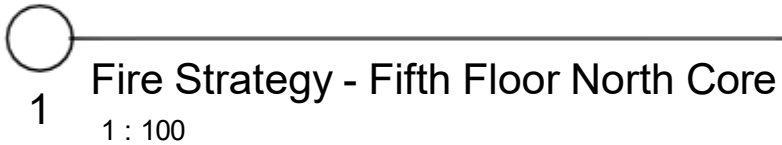

Fire strategy to be read in conjunction with latest version of: 622399-MLM-ZZ-XX-RP-YF-001- Hornsey Town Hall Fire Strategy Report, Hornsey Town Hall Fire Strategy Report

The image contains two logos. On the left is the logo for Ardmore Group, featuring a stylized red and blue 'A' with a swoosh, and the text 'Ardmore GROUP' below it. On the right is the logo for Ardmore Construction Ltd, with the text 'ARDMORE CONSTRUCTION LTD.' in a serif font, followed by '6 WHARF STUDIOS, 28 WHARF ROAD, LONDON, N1 7GR' and 'TEL: 0208-344 9800' in a sans-serif font, and the website 'www.ardmoregroup.co.uk' at the bottom. Below these is the logo for KDS Associates Ltd, with the text 'KDS ASSOCIATES LTD' in a large serif font, followed by 'DESIGN • ARCHITECTURE • MANAGEMENT • CONSULTANTS' in a smaller sans-serif font, and the address '101 The Blackfriars Road, 109 Blackfriars Road, London SE1 1EN' and 'Tel: 020 7330 0770' in a sans-serif font, with the website 'www.kdsassociates.co.uk' at the bottom.

AS BUILT

© KDS & Associates Ltd

No part of this drawing may be reproduced without written consent.
All contractors must visit site and be responsible for taking and
checking all
dimensions relating to this work.
Do not scale from this drawing.

PROJECT / DRAWING TITLE Hornsey Town Hall					
DRAWING TITLE RESIDENTIAL BLOCK A Fire Strategy - L05 North Core					
DATE / DRAWN BY 20/12/17 MD				SCALE 1 : 100	
PROJECT NO 3596-KDS	ZONE BA-05	LEVEL DR-A	TYPE 68-1012	REV C3	



1

File strategy to be read in

Fire strategy to be read in conjunction with latest version of: 622399-MLM-ZZ-XX-RP-YF-001- Hornsey Town Hall Fire Strategy Report_Hornsey Town Hall Fire Strategy Report

© KDS & Associates Ltd
No part of this drawing may be reproduced without written consent.
All contractors must visit site and be responsible for taking and
checking all
dimensions relating to this work.
Do not scale from this drawing.

[illegible]

**Ardmore
GROUP**

ARDMORE CONSTRUCTION LTD
6 WHARF STUDIOS,
28 WHARF ROAD,
LONDON, N1 7GR
TEL: 0208-344 0300
www.ardmoregroup.co.uk


KDS ASSOCIATES LTD
DESIGN & ARCHITECTURE | MANAGEMENT & CONSULTANTS
101 The Blackfriars Foundry
156 Blackfriars Road
London SE1 1BN
Tel: (020) 3555 0775
www.kdsassociates.co.uk

AS BUILT

© KDS & Associates Ltd
No part of this drawing may be reproduced without written consent.
All contractors must visit site and be responsible for taking and
checking all
dimensions relating to this work.
Do not scale from this drawing.

PROJECT / DRAWING TITLE Hornsey Town Hall									
DRAWING TITLE RESIDENTIAL BLOCK A Fire Strategy - L04 South Core									
DATE / DRAWN BY 20/12/17 MD							SCALE 1 : 100		REV C4
PROJECT NO	ZONE	LEVEL	TYPE	ROLE	CLASS	DR. NO.			
3596-KDS	BA-04-	DR-A-	68-	1011					

C:\Users\franco.farina\Documents\HTL_Block_A_CENTRAL_STAGE\LT7_franco.farina@kdsassociates.co.uk.rvt 10/05/2022 13:12:19

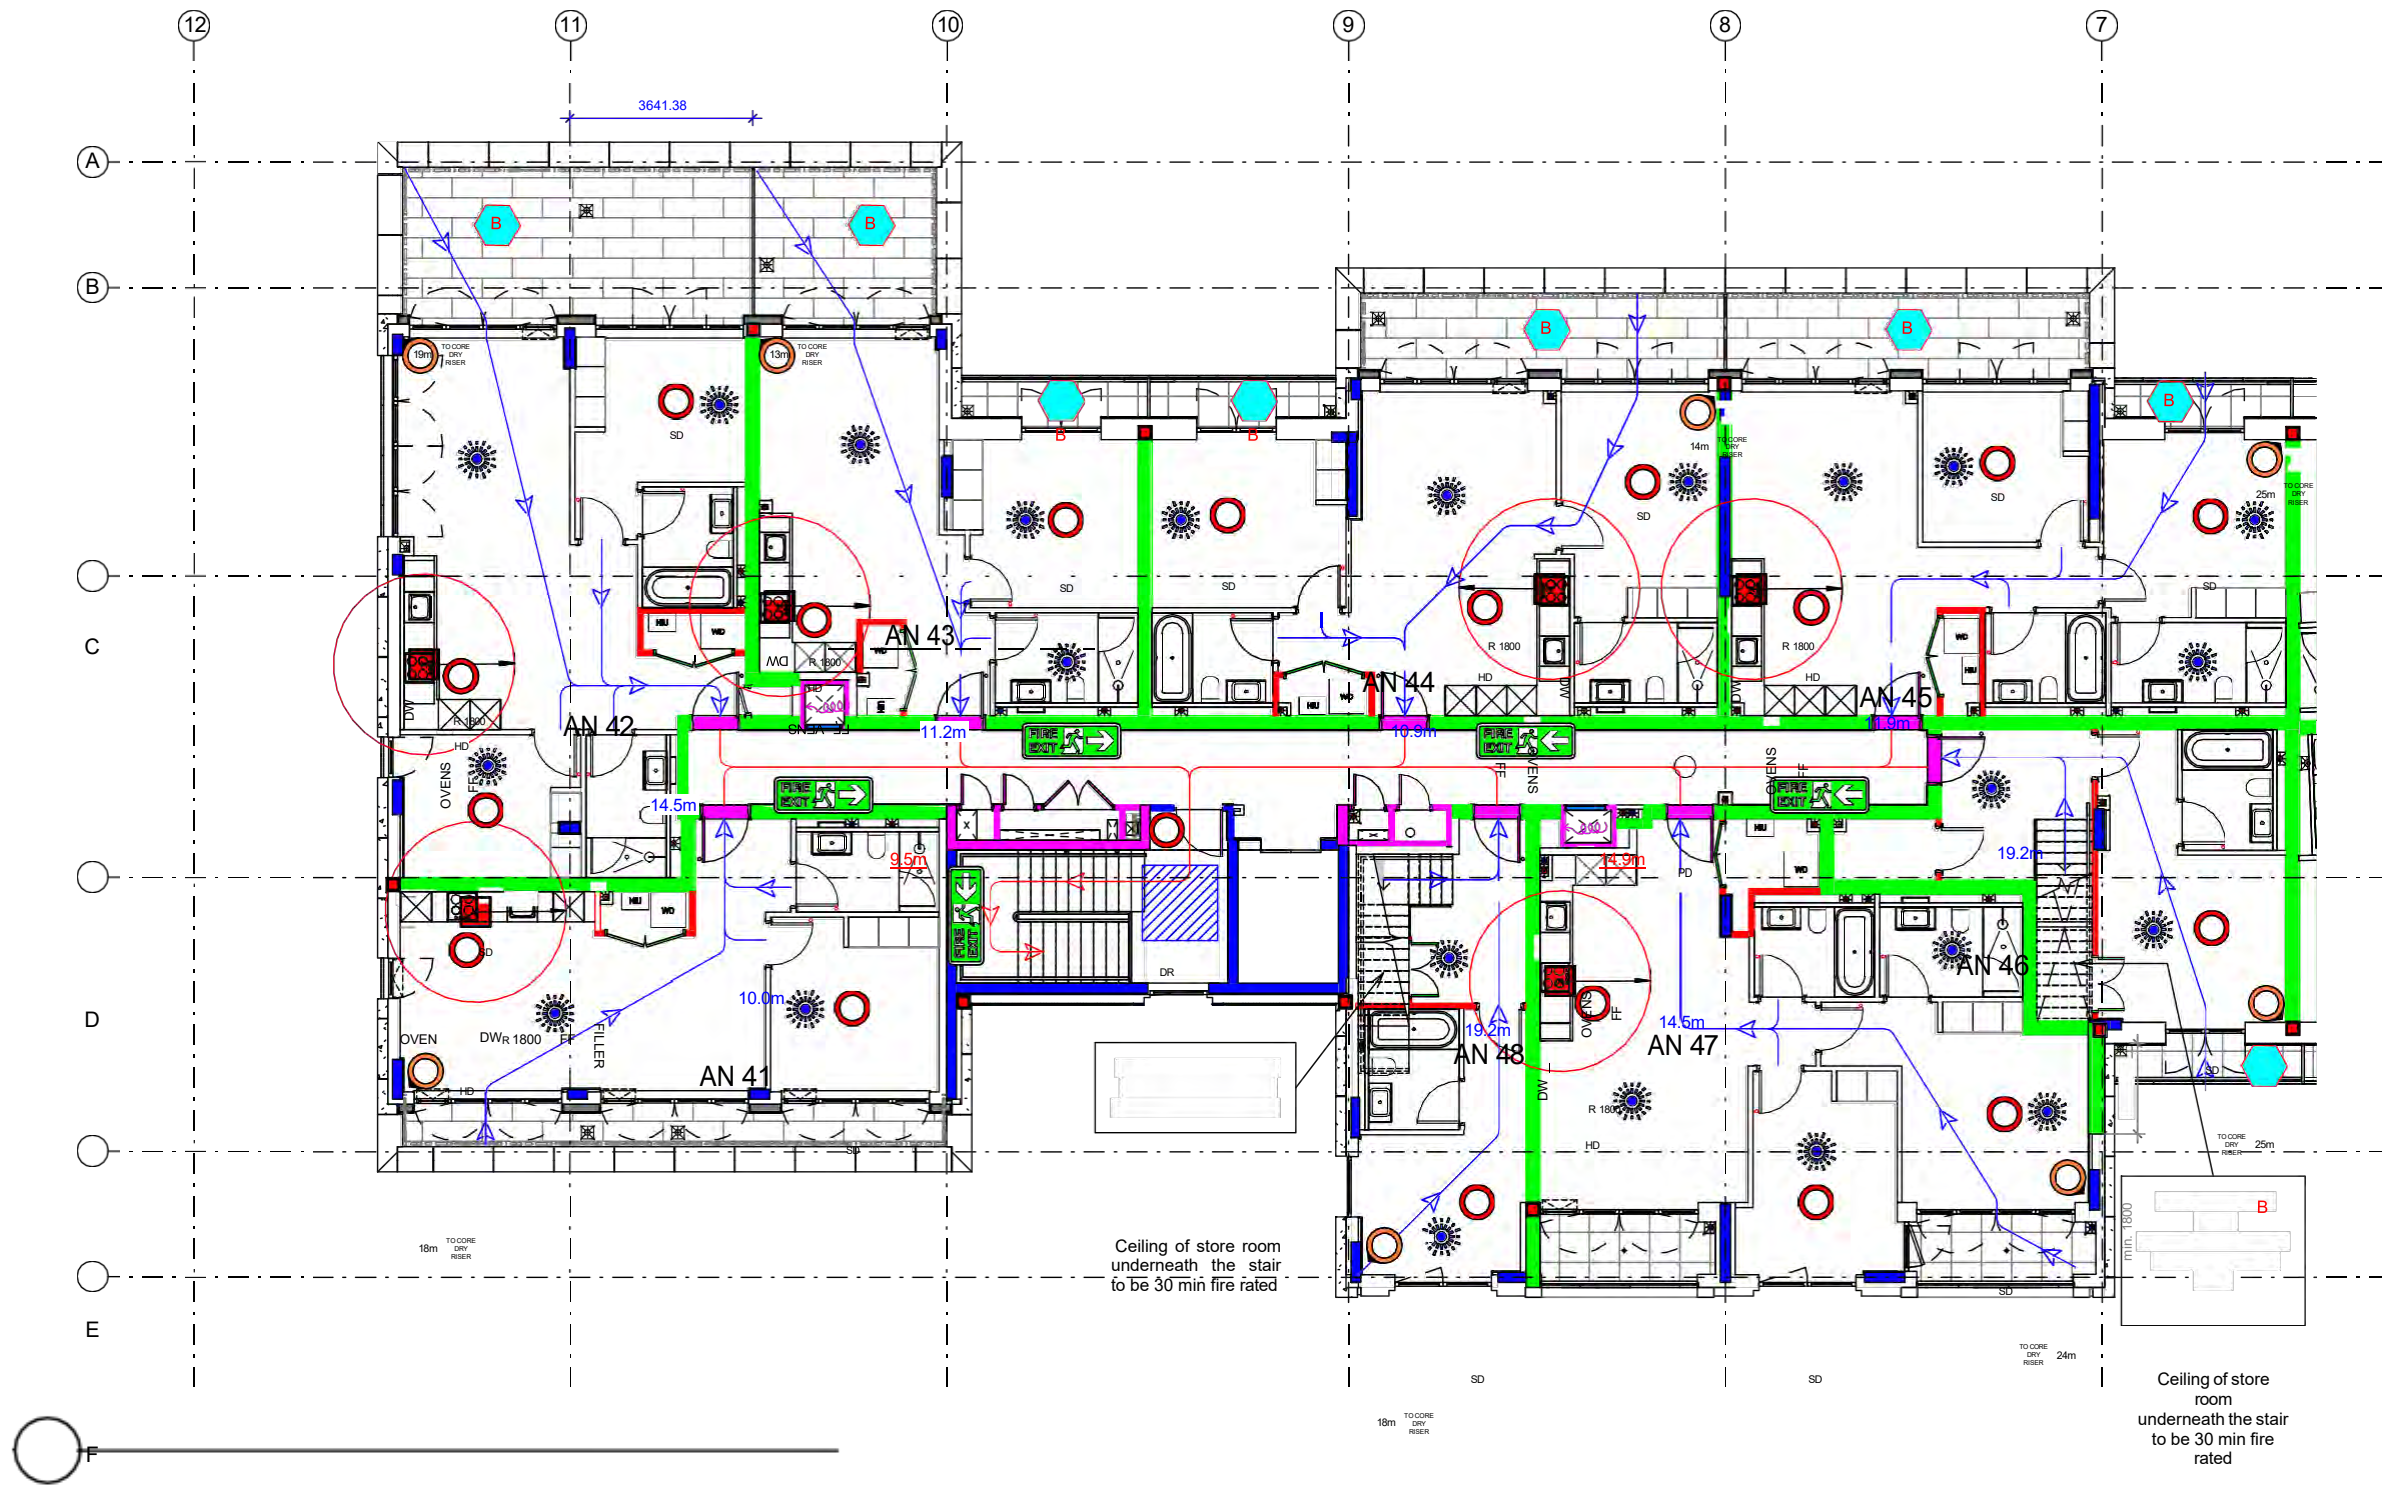

1 Fire Strategy - Fourth Floor North Core
1 : 100

	PARTY WALL FIRE BREAK
	DRY RISER INLET POSITION
	DRY RISER OUTLET POSITION
	STAIRCASE AOV (1.0m2)
	POSITION AND NUMBER OF SMOKE DETECTORS TO M+E DRAWINGS AND SPECIFICATIONS
	POSITION AND NUMBER OF HEAT DETECTORS TO M+E DRAWINGS AND SPECIFICATIONS
	FIRE FIGHTING DOOR / GATE OVERRIDING KEY (GERDA LOCK OSA)
	COOKER LOCATION INDICATING (1800 ZONE)
	BALCONY BEACON/ FLASHING - IN ACCORDANCE WITH BS 5839-6
	FD 30 FIRE DOOR
	FD 30S FIRE DOOR
	FD 60 FIRE DOOR
	FD 60S FIRE DOOR
	FD 120S FIRE DOOR
	FD 20 (20MIN FIRE DOOR WITH INTUMESCENT STRIP TO LEADING EDGE)
	30 MINS FIRE RATED WALL
	60 MINS FIRE RATED WALL
	90 MINS FIRE RATED WALL
	120 MINS FIRE RATED WALL
	ESCAPE LENGTH TO FRONT DOOR (20m MAX)
	PRIMARY DIRECTION OF ESCAPE
	OPEN PLAN BEDROOM ESCAPE LENGTH
	FIRE ESCAPE SIGNAGE
	FIRE HOSE FROM DRY RISER OUTLET MAX LENGTH OF HOSE IN METERS (45m MAX)
	FIRE SPRINKLER (POSITION INDICATIVE OF SPRINKLER SYSTEM TO BE INSTALLED IN THE ROOM)
	IMPULSE FAN
	MECHANICAL SMOKE EXTRACT

Fire strategy to be read in conjunction with latest version of: 622399-MLM-ZZ-XX-RP-YF-001- Hornsey Town Hall Fire Strategy Report_Hornsey Town Hall Fire Strategy Report

© KDS & Associates Ltd
No part of this drawing may be reproduced without written consent. All contractors must visit site and be responsible for taking and checking all dimensions relating to this work. Do not scale from this drawing.

REVISION NOTES			
NO.	DESCRIPTION	DATE	NAME
P1	Preliminary Issue	18/10/19	FF
C1	First construction issue	10/12/19	FF
C2	Issued for Construction	05/03/20	CM
C3	All riser doors changed from FD60 to FD60s fire rating	27/04/21	ZZK
C4	LAST CONSTRUCTION ISSUE FOR AS BUILT PURPOSES	09/05/22	FF

Ardmore GROUP


ARDMORE CONSTRUCTION LTD.
6 WHARF STUDIOS,
28 WHARF ROAD,
LONDON, N1 7GR
TEL: 0208-344 0300
www.ardmoregroup.co.uk

KDSASSOCIATES LTD
DESIGN • ARCHITECTURE • MANAGEMENT • CONSULTANTS
101 The Blackfriars Foundry
156 Blackfriars Road
LONDON SE1 8BN
Tel: 020 3553 0775
www.kdsassociates.co.uk

AS BUILT

© KDS & Associates Ltd
No part of this drawing may be reproduced without written consent.
All contractors must visit site and be responsible for taking and
checking all
dimensions relating to this work.
Do not scale from this drawing.

PROJECT / DRAWING TITLE Hornsey Town Hall									
DRAWING TITLE RESIDENTIAL BLOCK A Fire Strategy - L04 North Core									
DATE / DRAWN BY 20/12/17 MD								SCALE 1 : 100	
PROJECT NO	ZONE	LEVEL	TYPE	ROLE	CLASS	DR. NO.	REV		
3596-KDS	BA-04-	DR-A-	68-1010				C4		

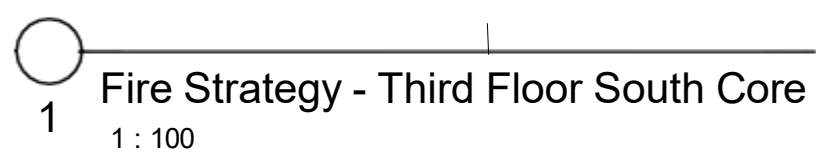

Fire strategy to be read in conjunction with latest version of: 622399-MLM-ZZ-XX-RP-YF-001-
Hornsey Town Hall Fire Strategy Report_Northsey Town Hall Fire Strategy Report

[illegible]


KDS ASSOCIATES LTD
DESIGN **1** ARCHITECTURE **2** MANAGEMENT **3** CONSULTANTS

101 The Blackfriars Foundry
156 Blackfriars Road
London SE1 8EN
Tel: 020 3366 0775
www.kdsassociates.co.uk

AS BUILT

© KDS & Associates Ltd
No part of this drawing may be reproduced without written consent.
All contractors must visit site and be responsible for taking and
checking all
dimensions relating to this work.
Do not scale from this drawing.

PROJECT / DRAWING TITLE Hornsey Town Hall									
DRAWING TITLE RESIDENTIAL BLOCK A Fire Strategy - L03 South Core									
DATE / DRAWN BY 20/12/17 MD							SCALE 1 : 100		
PROJECT NO	ZONE	LEVEL	TYPE	ROLE	CLASS	DR. NO.	REV		
3596-KDS	BA-03-	DR- A-		68-	1009		C4		

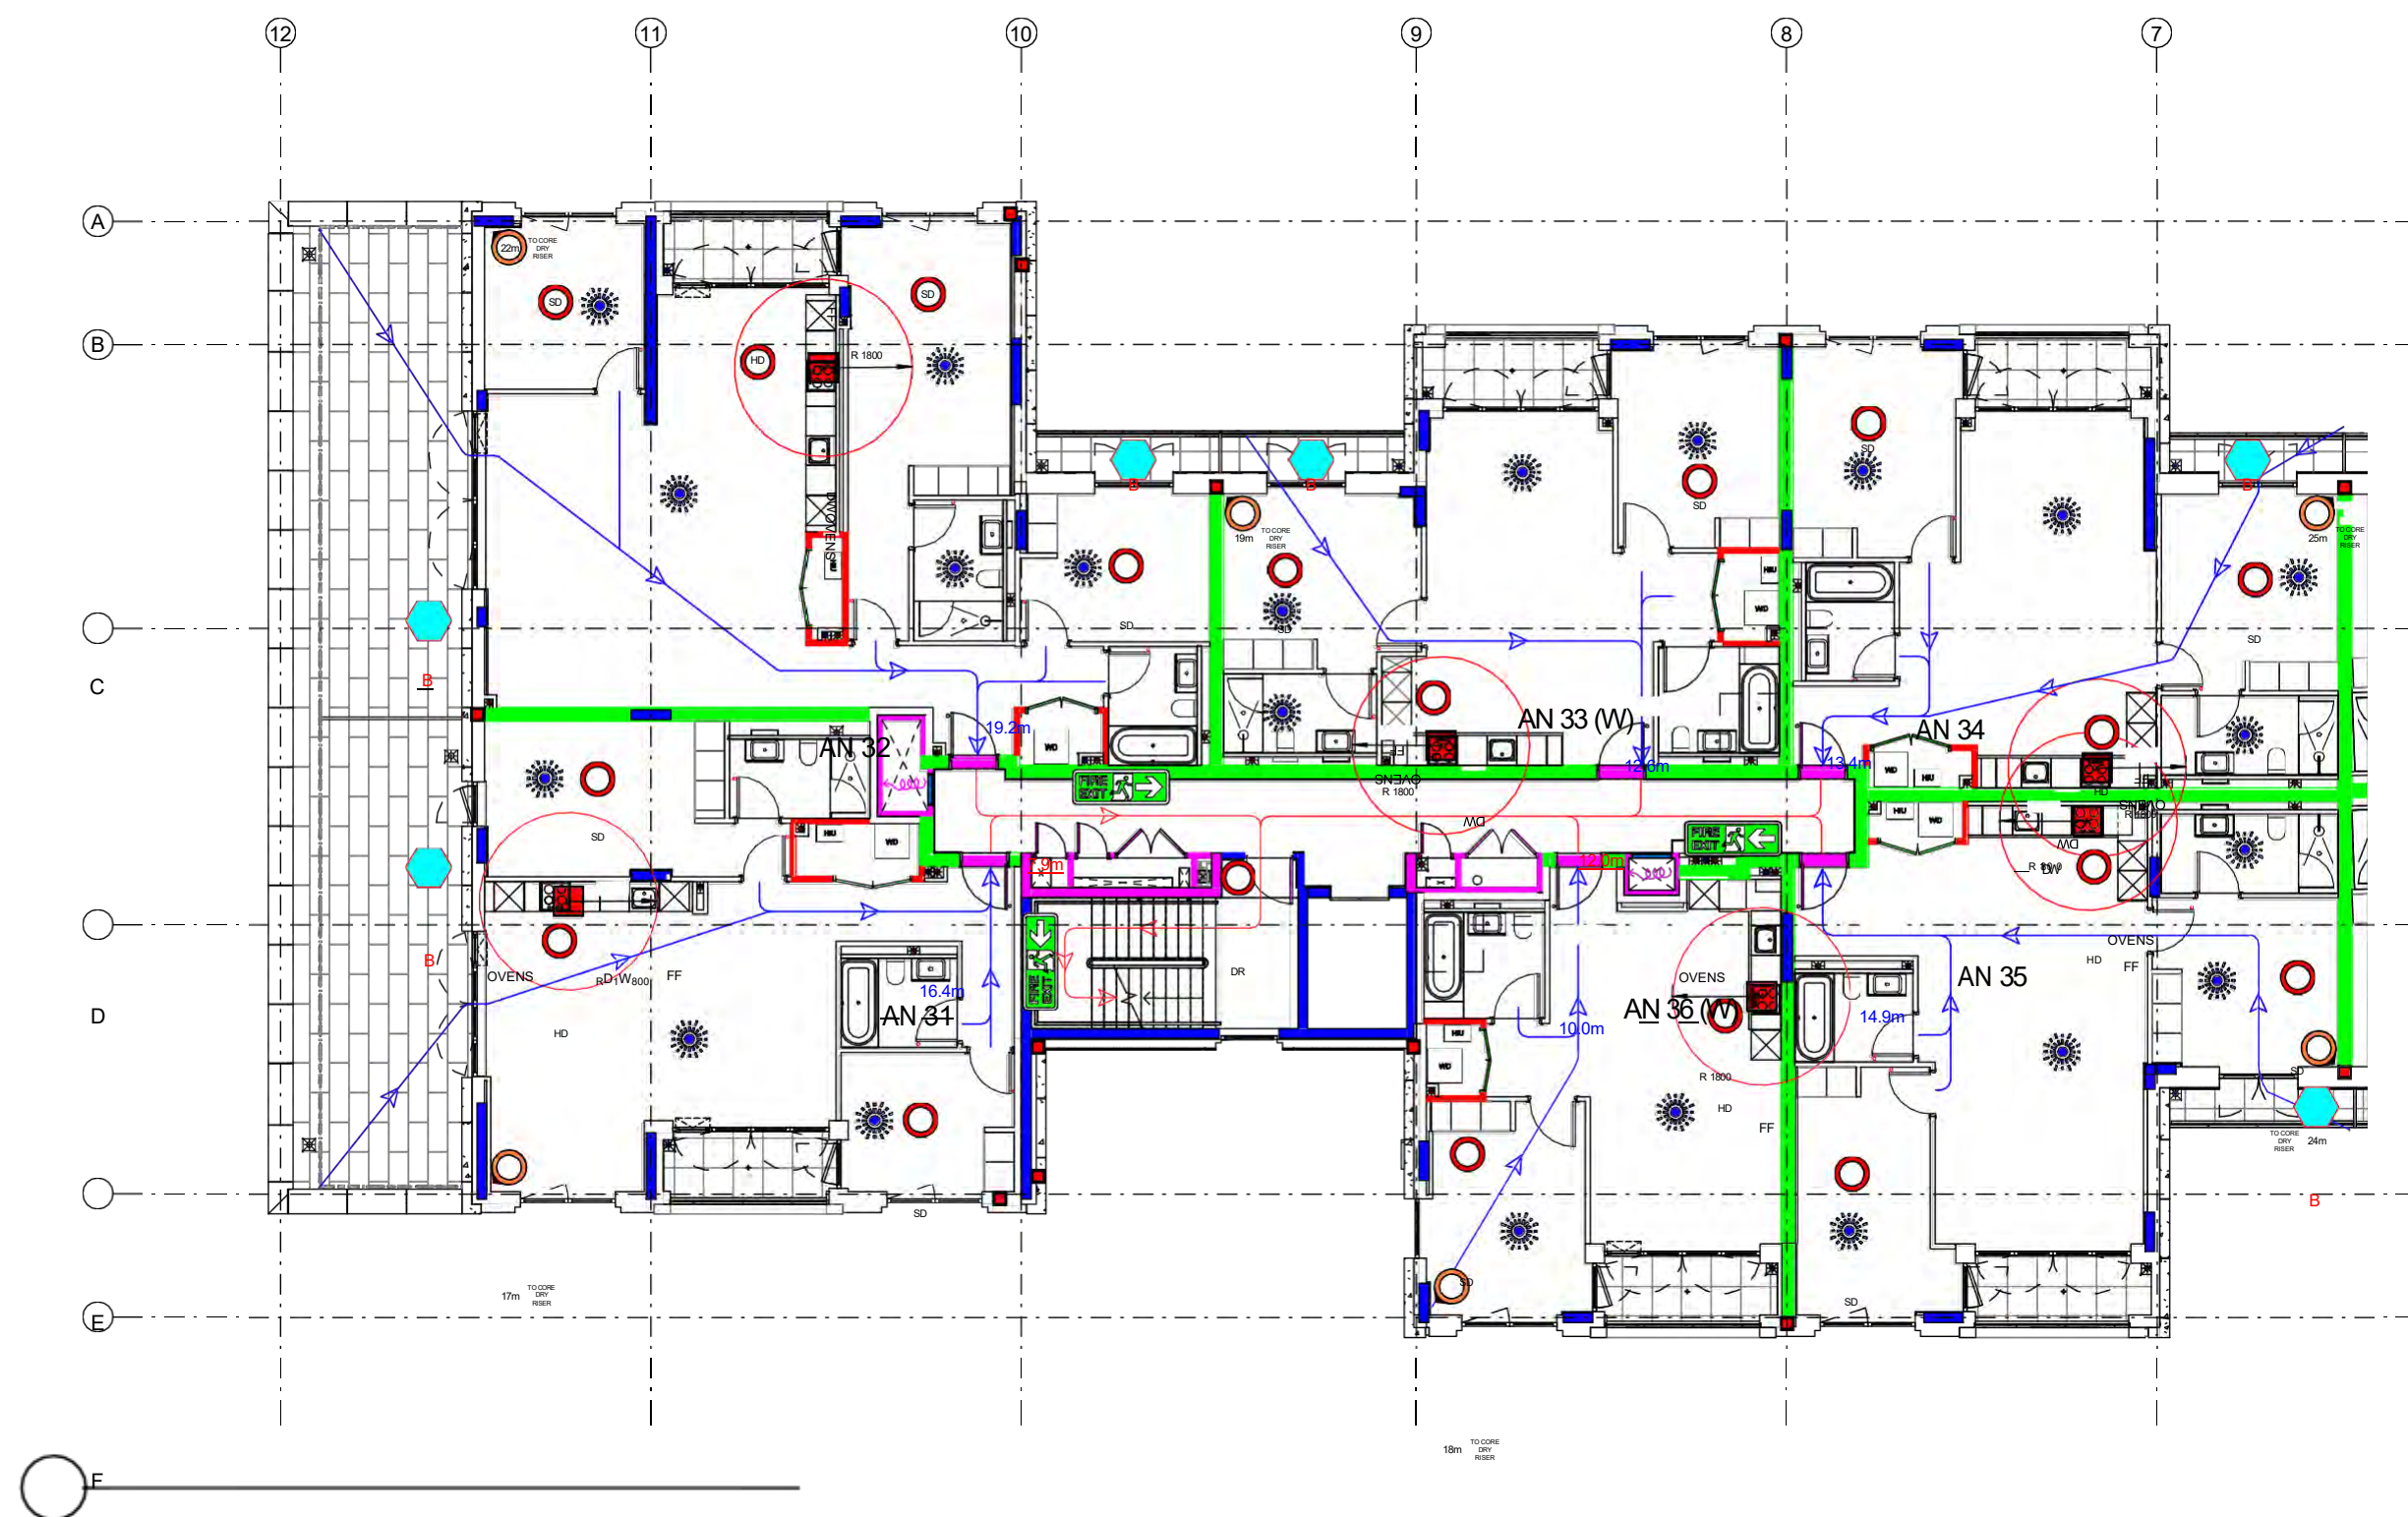

1 Fire Strategy - Third Floor North Core
1 : 100

	PARTY WALL FIRE BREAK
	DRY RISER INLET POSITION
	DRY RISER OUTLET POSITION
	STAIRCASE AOV (1.0m ²)
	POSITION AND NUMBER OF SMOKE DETECTORS TO M+E DRAWINGS AND SPECIFICATIONS
	POSITION AND NUMBER OF HEAT DETECTORS TO M+E DRAWINGS AND SPECIFICATIONS
	FIRE FIGHTING DOOR / GATE OVERRIDING KEY (GERDA LOCK OSA)
	COOKER LOCATION INDICATING (1800 ZONE)
	BALCONY BEACON/ FLASHING – IN ACCORDANCE WITH BS 5839-6
	FD 30 FIRE DOOR
	FD 30S FIRE DOOR
	FD 60 FIRE DOOR
	FD 60S FIRE DOOR
	FD 120S FIRE DOOR
	FD 20 (20MIN FIRE DOOR WITH INTUMESCENT STRIP TO LEADING EDGE)
	30 MINS FIRE RATED WALL
	60 MINS FIRE RATED WALL
	90 MINS FIRE RATED WALL
	120 MINS FIRE RATED WALL
	ESCAPE LENGTH TO FRONT DOOR (20m MAX)
	PRIMARY DIRECTION OF ESCAPE
	OPEN PLAN BEDROOM ESCAPE LENGTH
	FIRE ESCAPE SIGNAGE
	FIRE HOSE FROM DRY RISER OUTLET MAX LENGTH OF HOSE IN METERS (45m MAX)
	FIRE SPRINKLER (POSITION INDICATIVE OF SPRINKLER SYSTEM TO BE INSTALLED IN THE ROOM)
	IMPULSE FAN
	MECHANICAL SMOKE EXTRACT

Fire strategy to be read in conjunction with latest version of: 622399-MLM-ZZ-XX-RP-YF-001- Hornsey Town Hall Fire Strategy Report_Hornsey Town Hall Fire Strategy Report

© KDS & Associates Ltd
No part of this drawing may be reproduced without written consent.
All contractors must visit site and be responsible for taking and
checking all
dimensions relating to this work.
Do not scale from this drawing.

[illegible]

**Ardmore
GROUP**

ARDMORE CONSTRUCTION LTD
6 WHARF STUDIOS,
28 WHARF ROAD,
LONDON, N1 7GR
TEL: 0208-344 6300
www.ardmoregroup.co.uk


KDS ASSOCIATES LTD
DESIGN • ARCHITECTURE • MANAGEMENT • CONSULTANTS

101 The Bookbinder's Foundry
156 Bookbinder's Road
London SE1 1BN
Tel: 020 355 0795
www.kdsassociates.co.uk

AS BUILT

© KDS & Associates Ltd
No part of this drawing may be reproduced without written consent.
All contractors must visit site and be responsible for taking and
checking all
dimensions relating to this work.
Do not scale from this drawing.

PROJECT / DRAWING TITLE Hornsey Town Hall									
DRAWING TITLE RESIDENTIAL BLOCK A Fire Strategy - L03 North Core									
DATE / DRAWN BY 20/12/17 MD								SCALE 1 : 100	
PROJECT NO	ZONE	LEVEL	TYPE	ROLE	CLASS	DR. NO.	REV		
3596-KDS	BA-03-	DR-A-	68-	1008			C4		

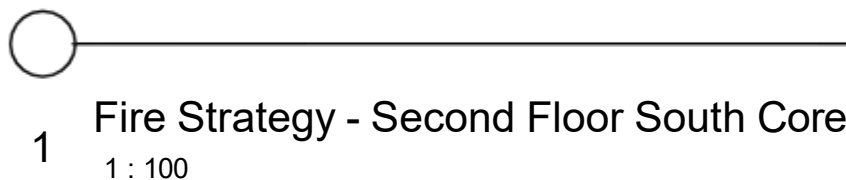

Fire strategy to be read in conjunction with latest version of: 622399 MLM ZZ XX RP YF 001

[illegible]


KDS ASSOCIATES LTD
DESIGN  ARCHITECTURE  MANAGEMENT  CONSULTANTS

101 The Blackfriars Foundry
196 Blackfriars Road
London SE1 1EN
Tel: 020 3355 0775
www.kdsassociates.co.uk

AS BUILT

© KDS & Associates Ltd
No part of this drawing may be reproduced without written consent.
All contractors must visit site and be responsible for taking and
checking all
dimensions relating to this work.
Do not scale from this drawing.

PROJECT / DRAWING TITLE Hornsey Town Hall									
DRAWING TITLE RESIDENTIAL BLOCK A Fire Strategy - L02 South Core									
DATE / DRAWN BY 20/12/17 MD							SCALE 1 : 100		
PROJECT NO	ZONE	LEVEL	TYPE	ROLE	CLASS	DR. NO.	REV		
3596-KDS	BA-02-	DR-	A-	68-	1007		C4		

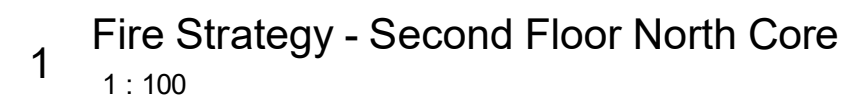

Fire strategy to be read in conjunction with latest version of: 622399-MLM-ZZ-XX-RP-YF-001- Hornsey Town Hall Fire Strategy Report_ Hornsey Town Hall Fire Strategy Report

© KDS & Associates Ltd
No part of this drawing may be reproduced without written consent.
All contractors must visit site and be responsible for taking and checking all dimensions relating to this work.
Do not scale from this drawing.

[illegible]

 **Ardmore
GROUP**

ARDMORE CONSTRUCTION LTD.
6 WHARF STUDIOS,
28 WHARF ROAD,
LONDON, N1 7GR
TEL: 0208-344 0300
www.ardmoregroup.co.uk

KDS ASSOCIATES LTD
DESIGN • ARCHITECTURE • MANAGEMENT • CONSULTANTS

101 The Blackhairs Foundry
156 Blackhairs Road
London SE1 6EN
Tel: 020 3350 0775
www.kdsassociates.co.uk


AS BUILT

© KDS & Associates Ltd

No part of this drawing may be reproduced without written consent.
All contractors must visit site and be responsible for taking and
checking all
dimensions relating to this work.
Do not scale from this drawing.

PROJECT / DRAWING TITLE				
Hornsey Town Hall				
DRAWING TITLE				
RESIDENTIAL BLOCK A				
Fire Strategy - L02 North Core				
DATE / DRAWN BY			SCALE	
20/12/17 MD			1 : 100	
PROJECT NO.	ZONE	LEVEL	TYPE	ROLE CLASS
3596-KDS	BA-02	DR-A	68-1006	REV C4

C:\Users\francisco.fmaria\Documents\HLL_Block_A_CENTRAL_STAGE\LYT_fmaria\kdsassociates.co.uk\nt 10/05/2022 13:11:14

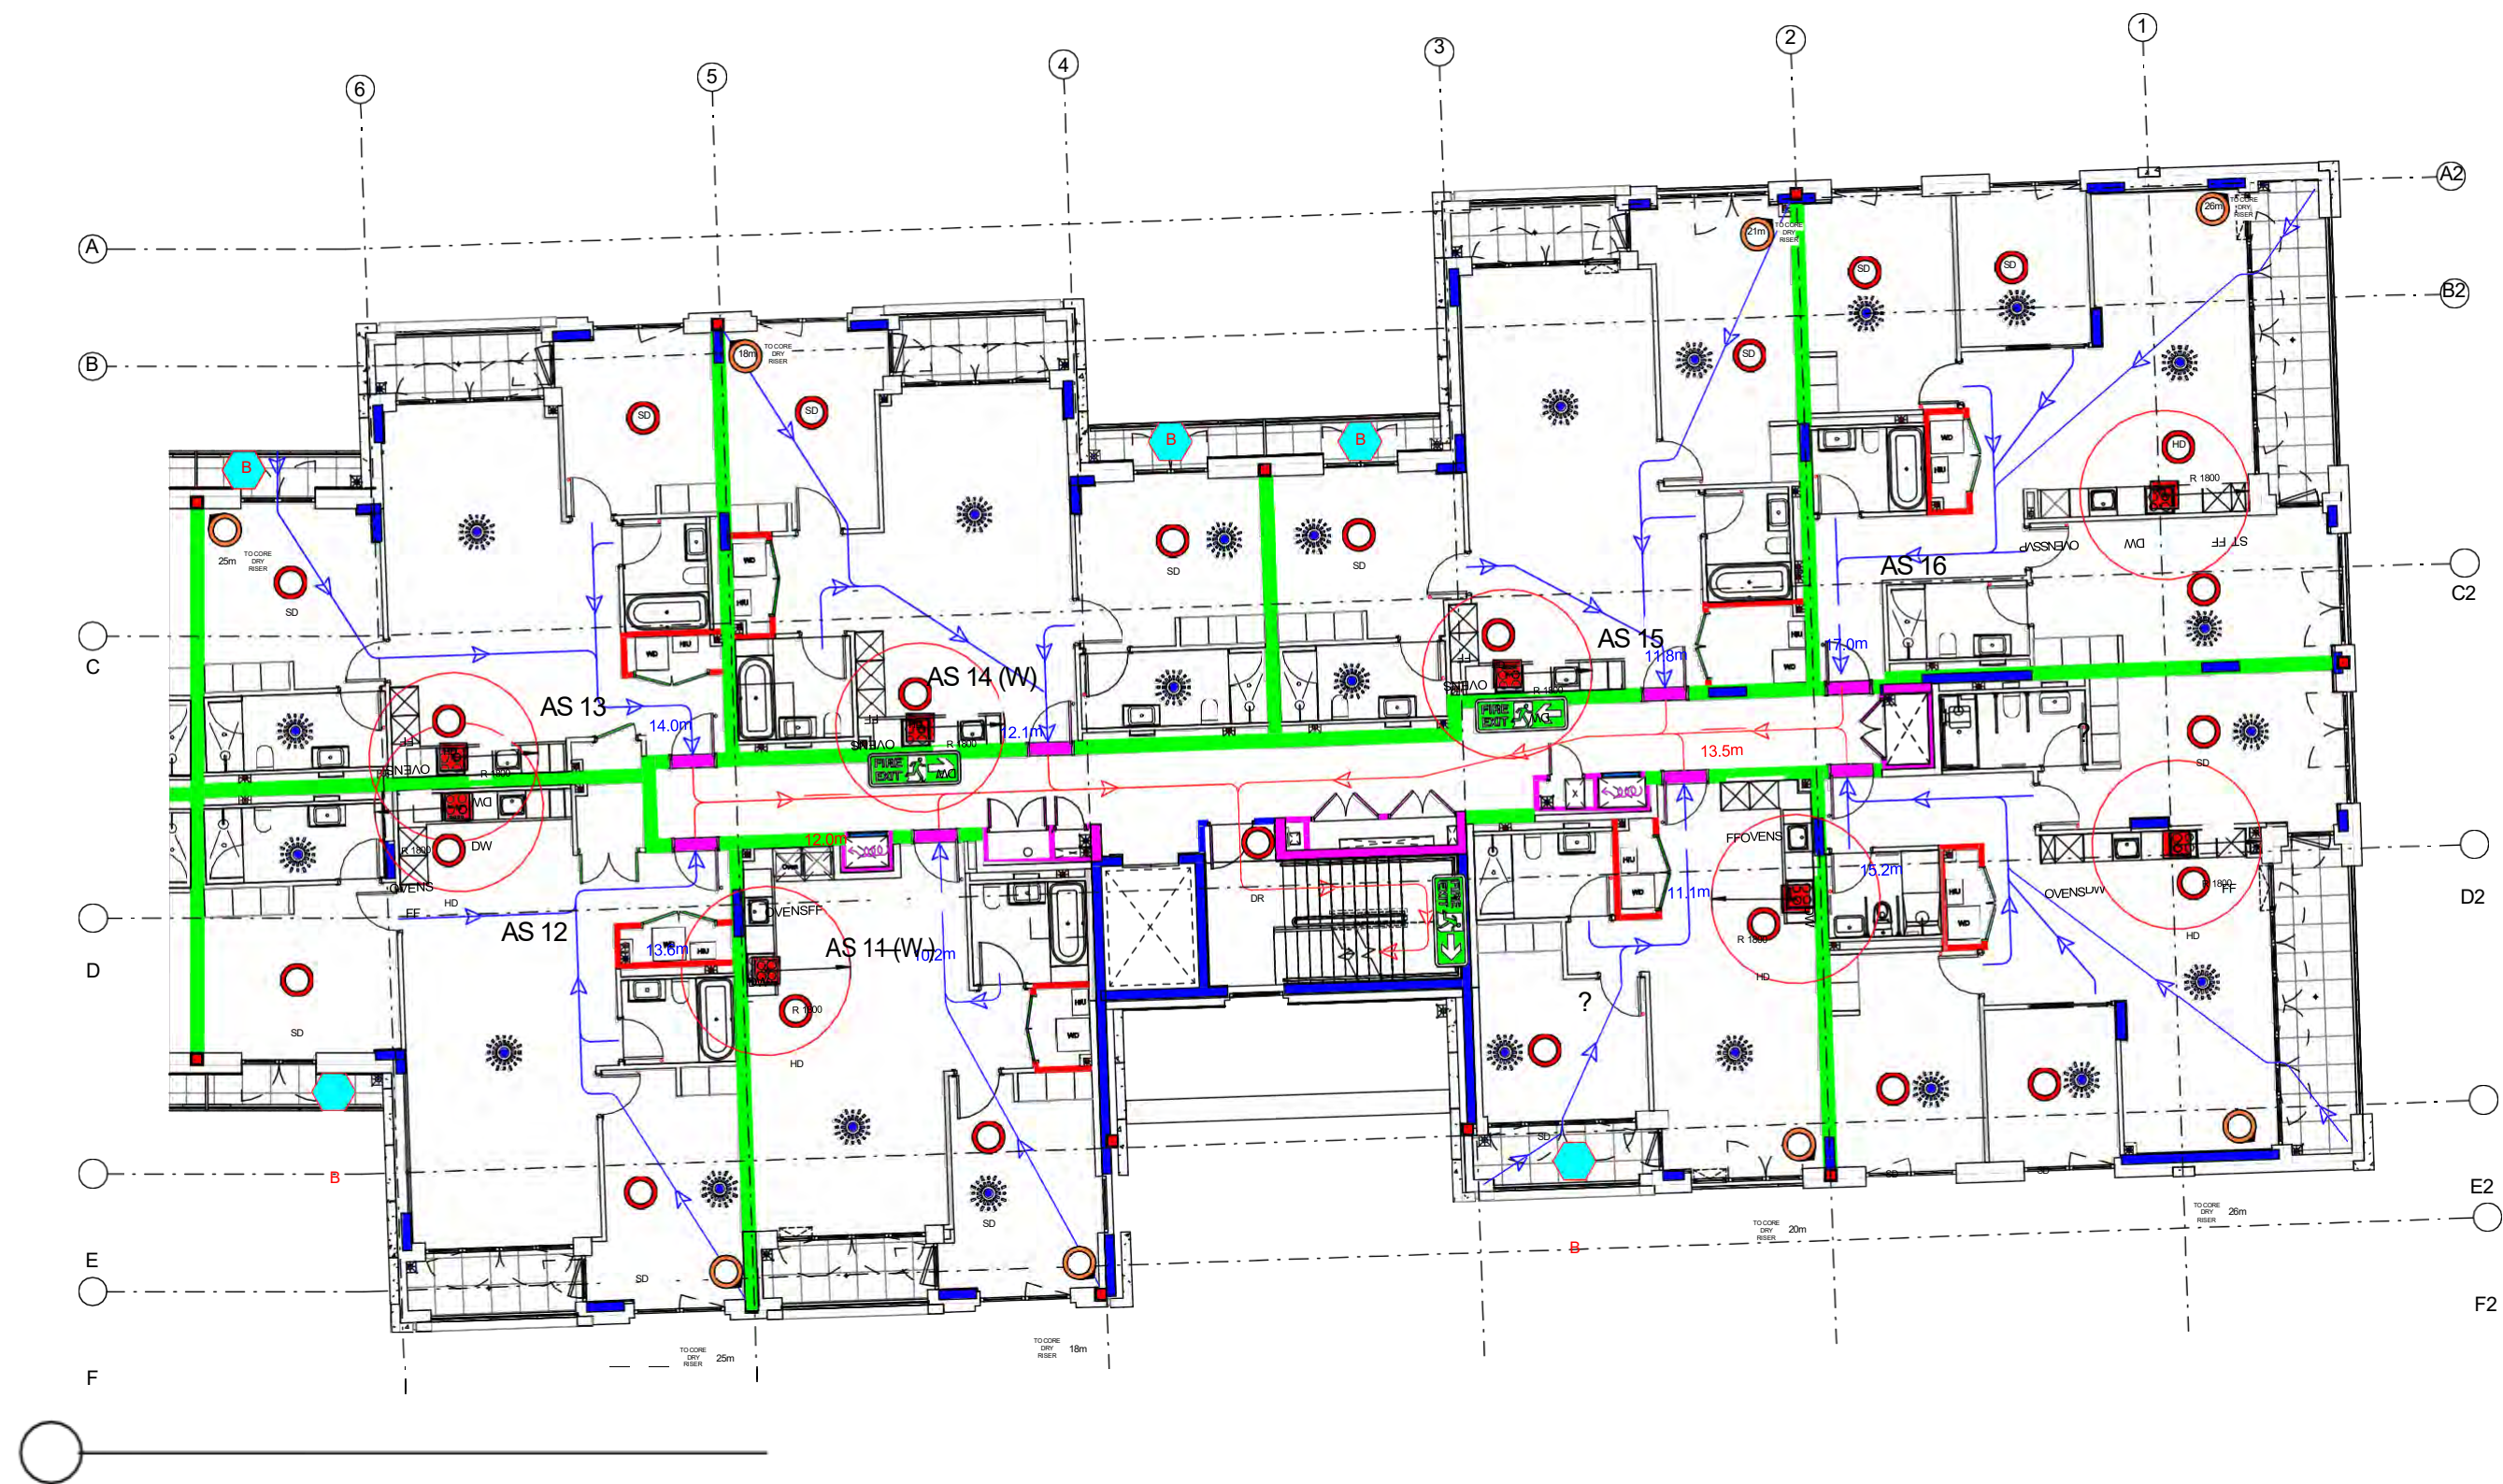

1 Fire Strategy - First Floor South Core
1 : 100

	PARTY WALL FIRE BREAK
	DRY RISER INLET POSITION
	DRY RISER OUTLET POSITION
	STAIRCASE AOV (1.0m2)
	POSITION AND NUMBER OF SMOKE DETECTORS TO M+E DRAWINGS AND SPECIFICATIONS
	POSITION AND NUMBER OF HEAT DETECTORS TO M+E DRAWINGS AND SPECIFICATIONS
	FIRE FIGHTING DOOR / GATE OVERRIDING KEY (GERDA LOCK OSA)
	COOKER LOCATION INDICATING (1800 ZONE)
	BALCONY BEACON/ FLASHING - IN ACCORDANCE WITH BS 5839-6
	FD 30 FIRE DOOR
	FD 30S FIRE DOOR
	FD 60 FIRE DOOR
	FD 60S FIRE DOOR
	FD 120S FIRE DOOR
	FD 20 (20MIN FIRE DOOR WITH INTUMESCENT STRIP TO LEADING EDGE)
	30 MINS FIRE RATED WALL
	60 MINS FIRE RATED WALL
	90 MINS FIRE RATED WALL
	120 MINS FIRE RATED WALL
	ESCAPE LENGTH TO FRONT DOOR (20m MAX)
	PRIMARY DIRECTION OF ESCAPE
	OPEN PLAN BEDROOM ESCAPE LENGTH
	FIRE ESCAPE SIGNAGE
	FIRE HOSE FROM DRY RISER OUTLET MAX LENGTH OF HOSE IN METERS (45m MAX)
	FIRE SPRINKLER (POSITION INDICATIVE OF SPRINKLER SYSTEM TO BE INSTALLED IN THE ROOM)
	IMPULSE FAN
	MECHANICAL SMOKE EXTRACT

Fire strategy to be read in conjunction with latest version of: 622369-MLN-ZZ-XX-PP-YE-001
Hornsey Town Hall Fire Strategy Report_Hornsey Town Hall Fire Strategy Report

© KDS & Associates Ltd
No part of this drawing may be reproduced without written consent. All contractors must visit site and be responsible for taking and checking all dimensions relating to this work. Do not scale from this drawing.

REVISION NOTES			
NO.	DESCRIPTION	DATE	NAME
P1	Preliminary Issue	18/10/19	FF
C1	First construction issue	10/12/19	FF
C2	Issued for Construction	05/03/20	CM
C3	All riser doors changed from FD60 to FD60s fire rating	27/04/21	ZZK
C4	LAST CONSTRUCTION ISSUE FOR AS BUILT PURPOSES	09/05/22	FF

ARDMORE CONSTRUCTION LTD.
6 WHARF STUDIOS,
28 WHARF ROAD,
LONDON, N1 7GR
TEL 0208-344 0300
www.ardmoregroup.co.uk

KDSASSOCIATES LTD
DESIGN ARCHITECTURE MANAGEMENT CONSULTANTS
101 The Blackhairs Foundry
100 Blackhairs Road
London SE1 8EN
Tel 020-300-0775
www.kdsassociates.co.uk

AS BUILT

© KDS & Associates Ltd
No part of this drawing may be reproduced without written consent.
All contractors must visit site and be responsible for taking and
checking all
dimensions relating to this work.
Do not scale from this drawing.

PROJECT / DRAWING TITLE Hornsey Town Hall									
DRAWING TITLE RESIDENTIAL BLOCK A Fire Strategy - L01 South Core									
DATE / DRAWN BY 20/12/17 MD						SCALE 1 : 100		REV C4	
PROJECT NO	ZONE	LEVEL	TYPE	ROLE	CLASS	DR.NO.			
3596-KDS	BA-01-	DR-A-	68-	1005					

No part of this drawing may be reproduced without written consent.
All contractors must visit site and be responsible for taking and
checking all
dimensions relating to this work.
Do not scale from this drawing.

**Ardmore
GROUP**

ARDMORE CONSTRUCTION LTD
6 WHARF STUDIOS,
28 WHARF ROAD,
LONDON, N1 7GR
TEL: 0208-344 0300
www.ardmoregroup.co.uk

KDS ASSOCIATES LTD
DESIGN | ARCHITECTURE | MANAGEMENT | CONSULTANTS

101 The Blackfriars Foundry
158 Blackfriars Road
London SE1 8EN
Tel: 020 3355 0175
www.kdsassociates.co.uk

PROJECT / DRAWING TITLE
Hornsey Town Hall
New Residential buildings


DRAWING TITLE
RESIDENTIAL MEWS
Fire Strategy



	60min FIRE BARRIER
	30min CAVITY CLOSURE
	90min FIRE BARRIER
	120min FIRE BARRIER
	SHEAR WALL EXTENT

LOCATION - BLOCK B

Key Plan

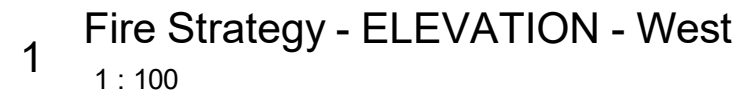


© KDS & Associates Ltd
No part of this drawing may be reproduced without written consent.
All contractors must visit site and be responsible for taking and
checking all
dimensions relating to this work.
Do not scale from this drawing.

PROJECT / DRAWING TITLE Hornsey Town Hall									
DRAWING TITLE RESIDENTIAL BLOCK B Fire Strategy - West Elevation									
DATE / DRAWN BY 27/10/20 ZZK								SCALE 1 : 100	
PROJECT NO	ZONE	LEVEL	TYPE	ROLE	CLASS	DR. NO.	REV		
3596-KDS-BB-XX-DR-A-68-2006							C1		

	60min FIRE BARRIER
	30min CAVITY CLOSURE
	90min FIRE BARRIER
	120min FIRE BARRIER
	SHEAR WALL EXTENT

 LOCATION - BLOCK B



KDS ASSOCIATES LTD
DESIGN • ARCHITECTURE • MANAGEMENT • CONSULTANTS

Architectural section drawing of a building facade. The drawing shows a grid of windows and structural elements. The vertical dimensions are 4940, 7790, 6785, 4295, 7465, and 3125. The horizontal grid lines are labeled 1 through 7. The drawing includes a series of windows with red and blue outlines, and a central vertical red line. The drawing is labeled "PATIO GARD" on the left and "43080 LG SSL" on the right.

1

© KDS & Associates Ltd
No part of this drawing may be reproduced without written consent.
All contractors must visit site and be responsible for taking and
checking all
dimensions relating to this work.
Do not scale from this drawing.

PROJECT / DRAWING TITLE Hornsey Town Hall									
DRAWING TITLE RESIDENTIAL BLOCK B Fire Strategy - South Elevation									
DATE / DRAWN BY 12/10/20 ZZK								SCALE 1 : 100	
PROJECT NO	ZONE	LEVEL	TYPE	ROLE	CLASS	DR. NO.	REV		
3596-KDS-BB-XX-DR-A-68-2005							C1		

	60min FIRE BARRIER
	30min CAVITY CLOSURE
	90min FIRE BARRIER
	120min FIRE BARRIER
	SHEAR WALL EXTENT

LOCATION - BLOCK B

WORKSHEET

Key Plan




PROJECT / DRAWING TITLE Hornsey Town Hall					
DRAWING TITLE RESIDENTIAL BLOCK B Fire Strategy - North Elevation					
DATE / DRAWN BY 10/18/20 ZZK				SCALE 1 : 100	
PROJECT NO. 3596-KDS-BB-XX-DR-A-68-2004	ZONE	LEVEL	TYPE	ROLE CLASS DR. NO.	REV C1



1 Fire Strategy - ELEVATION - North
1 : 100

	60min FIRE BARRIER
	30min CAVITY CLOSURE
	90min FIRE BARRIER
	120min FIRE BARRIER
	SHEAR WALL EXTENT

LOCATION - BLOCK B

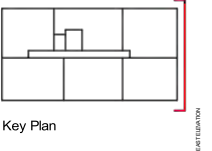


KDS ASSOCIATES LTD
DESIGN • ARCHITECTURE • MANAGEMENT • CONSULTANTS

FOR CONSTRUCTION



1 Fire Strategy - ELEVATION - East
1 : 100

PROJECT / DRAWING TITLE Hornsey Town Hall									
DRAWING TITLE RESIDENTIAL BLOCK B Fire Strategy - East Elevation									
DATE / DRAWN BY 27/10/20 ZZK								SCALE 1 : 100	
PROJECT NO	ZONE	LEVEL	TYPE	ROLE	CLASS	DR. NO.	REV		
3596-KDS-BB-XX-DR-A-68-2003							C1		

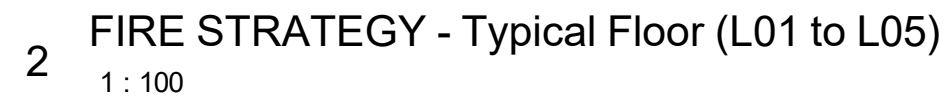




**Ardmore
GROUP**

ARDMORE CONSTRUCTION LTD.
 6 WHARF STUDIOS,
 28 WHARF ROAD,
 LONDON, N1 7GR
 Tel: 0208 344 0000
www.ardmoregroup.co.uk

FOR CONSTRUCTION

© KDS & Associates Ltd
No part of this drawing may be reproduced without written consent.
All contractors must visit site and be responsible for taking and
checking all
dimensions relating to this work.
Do not scale from this drawing.

PROJECT / DRAWING TITLE Hornsey Town Hall									
DRAWING TITLE RESIDENTIAL BLOCK B Fire Strategy - Typical Level									
DATE / DRAWN BY 20/12/17 MD								SCALE 1 : 100	
PROJECT NO	ZONE	LEVEL	TYPE	ROLE	CLASS	DR. NO.	REV		
3596-KDS-BB-XX-DR-A-68-2002							C2		

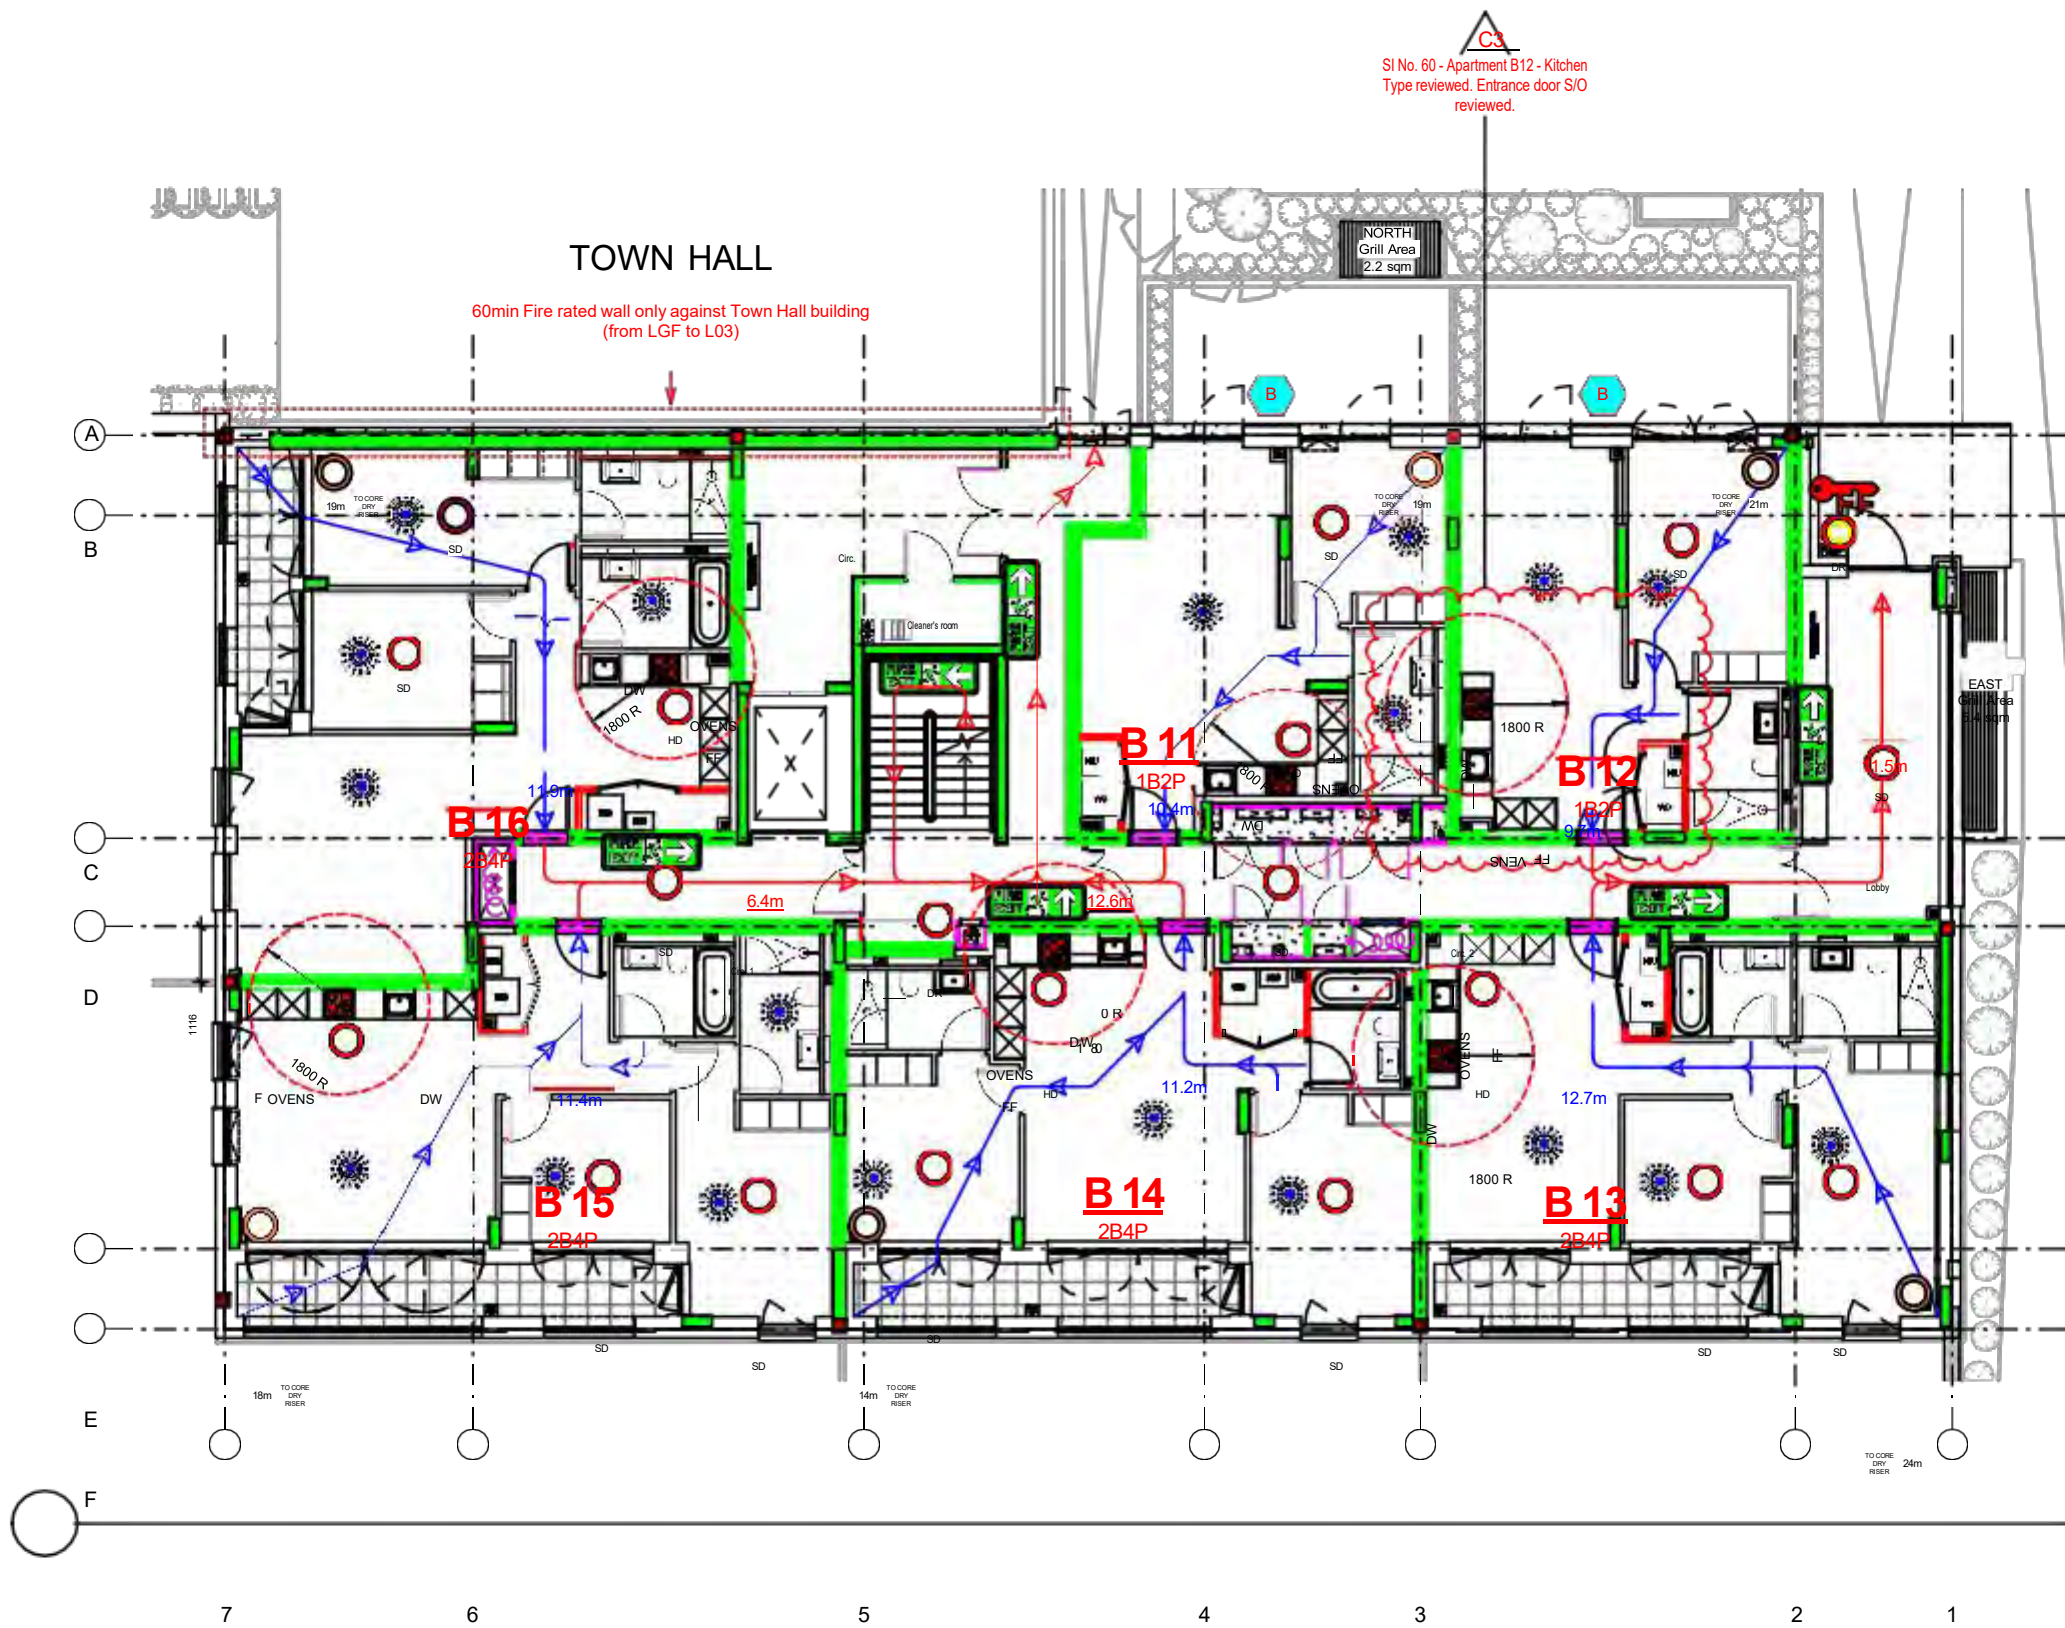

1 FIRE STRATEGY - Ground Floor
1 : 100

■	PARTY WALL FIRE BREAK
DR	DRY RISER INLET POSITION
RO	DRY RISER OUTLET POSITION
STAIRCASE AOV (1.0m2)	
SD	POSITION AND NUMBER OF SMOKE DETECTORS TO M+E DRAWINGS AND SPECIFICATIONS
HD	POSITION AND NUMBER OF HEAT DETECTORS TO M+E DRAWINGS AND SPECIFICATIONS
FF	FIRE FIGHTING DOOR / GATE OVERRIDING KEY (GERDA LOCK OSA)
COOKER	COOKER LOCATION INDICATING (1800 ZONE)
B	BALCONY BEACON/ FLASHING - IN ACCORDANCE WITH BS 5839-6
FD 30	FD 30 FIRE DOOR
FD 30S	FD 30S FIRE DOOR
FD 60	FD 60 FIRE DOOR
FD 60S	FD 60S FIRE DOOR
FD 120S	FD 120S FIRE DOOR
FD 20	FD 20 (20MIN FIRE DOOR WITH INTUMESCENT STRIP TO LEADING EDGE)
30 MINS	30 MINS FIRE RATED WALL
60 MINS	60 MINS FIRE RATED WALL
120 MINS	120 MINS FIRE RATED WALL
20.0m	ESCAPE LENGTH TO FRONT DOOR (20m MAX)
→	PRIMARY DIRECTION OF ESCAPE
←	OPEN PLAN BEDROOM ESCAPE LENGTH
EXIT	FIRE ESCAPE SIGNAGE
45m	FIRE HOSE FROM DRY RISER OUTLET MAX LENGTH OF HOSE IN METERS (45m MAX)
SPRINKLER	FIRE SPRINKLER (POSITION INDICATIVE OF SPRINKLER SYSTEM TO BE INSTALLED IN THE ROOM)
IMPULSE FAN	IMPULSE FAN
MECHANICAL SMOKE EXTRACT	MECHANICAL SMOKE EXTRACT

© KDS & Associates Ltd
No part of this drawing may be reproduced without written consent.
All contractors must visit site and be responsible for taking and checking all dimensions relating to this work.
Do not scale from this drawing.

REVISION NOTES			
NO.	DESCRIPTION	DATE	NAME
P1	PRELIMINARY ISSUE	18/10/19	FF
C1	ISSUED FOR CONSTRUCTION	08/03/20	CM
C2	All riser doors changed from FD60 to FD60s fire rating	27/04/21	ZZK
C3	Updated as per ACL site instruction n.60	19/04/22	FF



ARDMORE CONSTRUCTION LTD.
6 WHARF STUDIOS,
28 WHARF ROAD,
LONDON, N1 7GR
TEL: 0208-344 0300
www.ardmoregroup.co.uk



KDSASSOCIATESLTD
DESIGN • ARCHITECTURE • MANAGEMENT • CONSULTANTS
101 The Blackhairs Foundry
156 Blackhairs Road
London SE1 1RN
Tel: 020 3055 0775
www.kdsassociates.co.uk

FOR CONSTRUCTION

PROJECT / DRAWING TITLE Hornsey Town Hall									
DRAWING TITLE RESIDENTIAL BLOCK B Fire Strategy - Ground Level									
DATE / DRAWN BY 20/12/17 MD								SCALE 1 : 100	
PROJECT NO 3596-KDS		ZONE BB	LEVEL GF	TYPE DR	ROLE CLASS A	DR. NO. 68-2001	REV C3		

exaprojects

TRANSPORT, TRAVEL AND COMMUNITY

CYCLING AND WALKING

CYCLING

Cycling is a great way to get around London. Cycling in Central London is becoming easier with an increasing number of hire bikes available and bike highways being developed.

Barclays Cycle Hire offers short-term hire bikes around London. There are over 700 bike docking stations. Your closest bike docking station is at Santander Cycles: Allington Street, Victoria. It has 27 bikes/docks. Registered users pay £2 for an unlimited number of journeys within any 24-hour period, as long as each journey is under 30 minutes.

Your nearest cycling shop for advice, repairs and purchases is Future Cycles Shop, 314 Park Rd, Muswell Hill, London N8 8LA

WALKING

Including some walking in your daily commute is a great way to keep active and stay healthy.

Walk it is a web-based walking-route planner which aims to increase the number of people walking around the country. Information on walking events, walking to work or school, or walking for health can be found on the website at <https://walkit.com>

Walk 4 Life is another web-based programme which helps you to find at least 10 organised walks and walking events in your area. The programme, run by Walk England, aims to promote healthy and active lifestyles. There is more information on the website at www.walkengland.org.uk

PUBLIC TRANSPORT

BUSES

Your local bus services and routes are set out below. For timetables and a route map, see the Transport for London website at www.tfl.gov.uk.

Service	Route
ROUTE W7: Metroline	Muswell Hill Broadway - Finsbury Park Station.
NIGHT BUS N91: Metroline	Cockfosters Station - Trafalgar Square.

ROUTE 41: Arriva London	Tottenham Hale Station - Archway Station.
ROUTE 91: Metroline	Crouch End, Elmfield Avenue - Trafalgar Square.
ROUTE W3: Arriva London	Northumberland Park Station - Park Station.
ROUTE W5: CT Plus	Harringay Sainsbury's, Endymion Road - Archway Station.

TRAINS AND TUBES

Your nearest train and tube stations are set out below, along with the facilities available and opening times.

Station	Contact details	Opening times	Common destinations served or tube lines	Facilities
Finsbury Park	Address: Finsbury Park Underground Station London Underground Ltd. Wells Terrace London N4 3JU Phone: 0800 138 1018	Monday - Sunday 07:00 - 22:00 The assisted helpline is not available on Christmas Day.	Piccadilly	ATM Machine Public Wi-Fi Refreshment facilities Toilets Waiting Rooms
Crouch Hill	Address: Crouch Hill station Crouch Hill Stroud Green Greater London N4 4AU Phone: 0345222123	Monday - Friday 05:50 - 00:33 Saturday 06:10 - 00:36 Sunday 08:50 - 00:21	-	-
Harringay Green Lanes station	Address: Green Lane	Monday, Tuesday, Wednesday, Thursday, Friday 05:47 -		Refreshment facilities Shops

exaprojects

	Harringay Greater London N4 1DR	00:30 Saturday 06:15 - 00:33 Sunday 08:50 - 00:18		
--	------------------------------------	---	--	--

CAR PARKING AND SHARING

The following car parks are nearby.

Location	Opening times	Price	Number of spaces
Muswell Hill, London N10 3QN	Mon to Sat 8am – 6.30pm	1.25 £ /hour	90
3 Shepherd's Hill, London N6 5QJ	24 h	Mon- Fri 7£/day Sat – Sun 3£/day	30
Bury Road Wood Green N22 6JA	Mon to Sat 8am - 8.15pm Sunday 11am – 5.15pm	Up to 1.25£/hour	500
20 Pelham Rd, London N22 6LW	6am – 1.30am	2£/h	1200

ELECTRIC CAR CHARGING POINTS

Electric cars are becoming more popular as they offer a range of financial, performance and environmental benefits compared to petrol and diesel engines. Electric car charging points have been installed in the communal car parks of your home to provide convenient charging solutions for electric car owners, helping to reduce environmental pollution and save you money. Charging points play an important role in promoting sustainable transportation development.

Electric car charging points are available on the lower ground floor of the car park of Block A, 4 of these located in disabled car parking bays.

Five external charging points are also provided. Three of these are in the car park directly behind the Town Hall, while two are located behind Hornsey Library.

The car charging points are provided by Project EV.

Regular maintenance of the ports will be undertaken by the Building Owner. If you notice any issues or believe a charging point requires a repair, contact Far East Consortium Limited 020 3370 6804 Direct.

AMENITIES AND PLACES OF INTEREST

You can find information on your local amenities, including places of interest, below.

Your nearest...	Name	Contact details	Distance
Supermarkets	Tesco Express	Address: 25 The Broadway, London N8 8DU Phone: +443450269248	Walk- 5 min; 0.2 mile
Supermarkets	Waitrose	35-39 The Broadway, London N8 8DU	Walk – 5 min; 0,5 mile
Supermarkets	Co – op	21-23 The Broadway, London N8 8DU	Walk – 3 min ; 0,2 mile
Banks	Barclays Bank	Address: 8 The Broadway, London N8 9SX Phone: +443457345345	Walk – 4 min; 0.2 mile
Post office	Crouch End Post Office & UOE Store	Address: Crouch End Post Office, 28-29 Topsfield Rd, London N8 8QB Telephone: +442083654102	Walk – 7 min; 0.4 mile
Parks	Crouch Hill Park	Address: Crouch Hill, London N4 4AP	Walk – 12 min; 0,5 mile
Pubs	The Harringay Arms	Address: 153 Crouch Hill, London N8 9QH Phone: +442082454673	Walk – 4 min; 0,2 mile
Nurseries	Bright Horizons Crouch End Day Nursery and Preschool	Address: 113 Crouch Hill, London N8 9QN Phone: +442037807914	Walk – 7 min; 0.3 mile
Schools	Coleridge Primary School	Address: Crouch End Hill, London N8 8DN Phone: +442083403173	Walk – 10 min; 0.4 mile
Colleges	New River College	Address: 5 Elthorne Rd, Archway, London N19 4AB Phone: +442075272723	Bus W5 or Bus 41 – 20 min
Churches	Christ Church Crouch End Hill	Address: 34 Crescent Rd, London N8 8AX Phone: +442083401566	Walk – 8 min; 0.4 mile

exaprojects

Dentists	Crouch Hall Dental Care	Address: Crouch End Dental Practice, 70 Crouch Hall Rd, London N8 8HA Phone: +442078703111	Walk – 7 min; 0.3 mile
Opticians	Specsavers Opticians London - Crouch End	Address: 33 The Broadway, London N8 8DU Phone: +442083425080	Walk – 5 min; 0.3 mile
Gyms	My Gym Crouch End	Address: 2-4 The Broadway, London N8 9SN Phone: +447802724941	Walk – 4 min; 0.3 mile
Pharmacies	Boots	Address: 11 The Broadway, London N8 8DU Phone: +442083403892	Walk 2 min
Museums	Islington Museum	Address: 245 St John St, London EC1V 4NB Phone: +442075272837	Victoria line – 40 min
Restaurants	Paesan Crouch End	Address: 48c The Broadway, London N8 9TP Phone: +442083470900	<i>Walk 2 min</i>
Cafes	Harris + Hoole	Address: 9 The Broadway, London N8 8DU Phone: +442083476269	Walk 1 min
Allotments	Shepherds Hill Allotments	Address: Montenotte Rd, London N8 8RL Phone:	Car 5 min

exaprojects

APPENDICES

CERTIFICATES

Add HQM Certificate

exaprojects

MANUALS

Manual title	Yes	No
Washing Machine	☒	☐
Dishwasher	☒	☐
Fridge – freezer	☒	☐
Oven	☒	☐
Extractor fan	☒	☐
Wine cooler	☒	☐
Hob	☒	☐
	☐	☐

exaprojects

MAP OF NEAREST RECYCLING FACILITIES

