


01 AS BUILT ELEVATION- EAST A-A
1:200



02 PROPOSED ALTERATIONS ELEVATION- EAST A-A
1:200

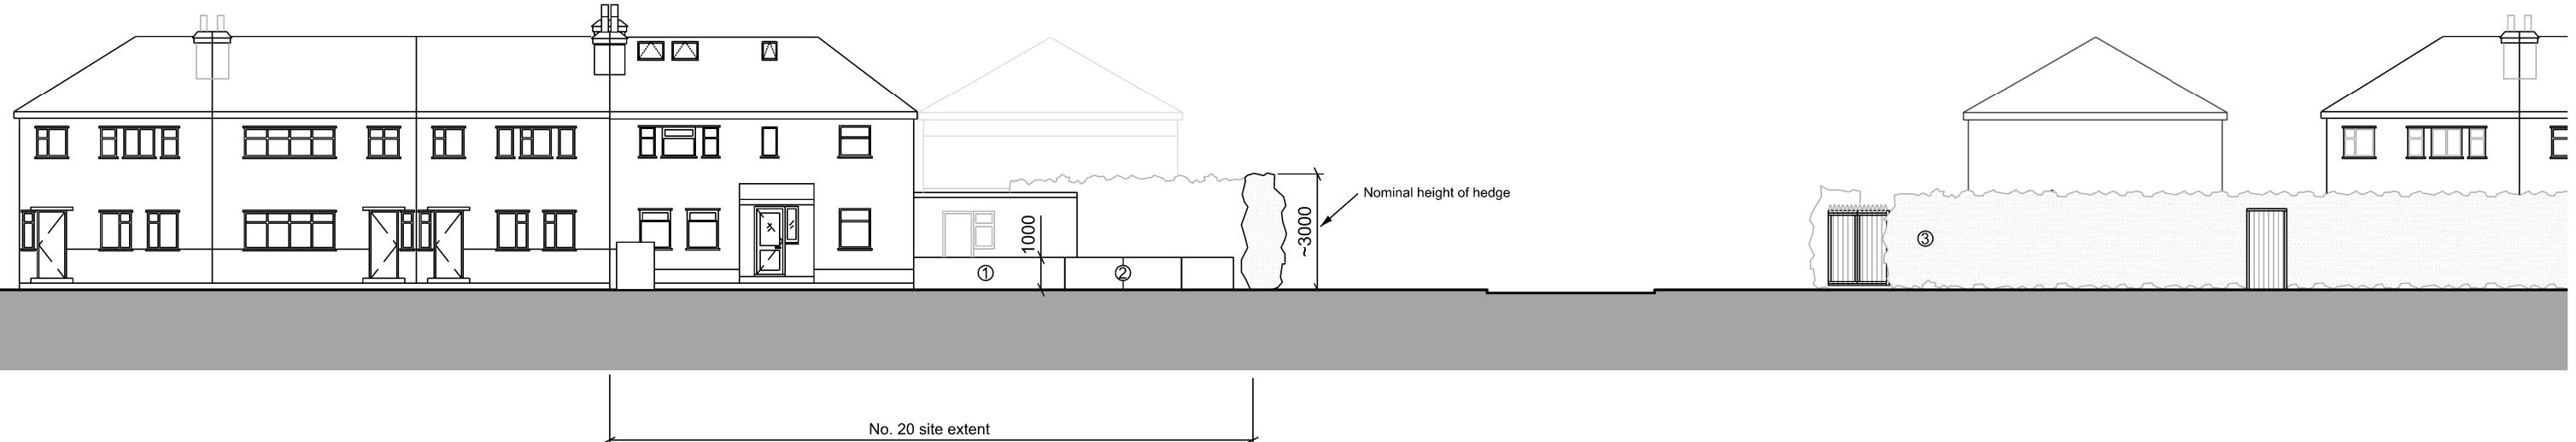

KEY PLAN

NOTES

- ① White render to match existing
- ② Pedestrian access gates
- ③ Mature ~3m boundary hedge
- ④ Area of wall to be removed

REV.	NOTES	DATE
P00	RETROSPECTIVE PLANNING	11.03.24

TITLE
AS BUILT + PROPOSED
ALTERATIONS LONG
ELEVATION

DRAWING NO. 030-PE110
REVISION P01

DATE 11.03.24
SCALE 1:200 @ A3

Tikari Works
Studio 4 6-8 Cole St.
studio@tikari.co.uk
London SE1 4YH
020 300 52406

PROJECT
20 CROXFORD GARDENS

STATUS
PLANNING