



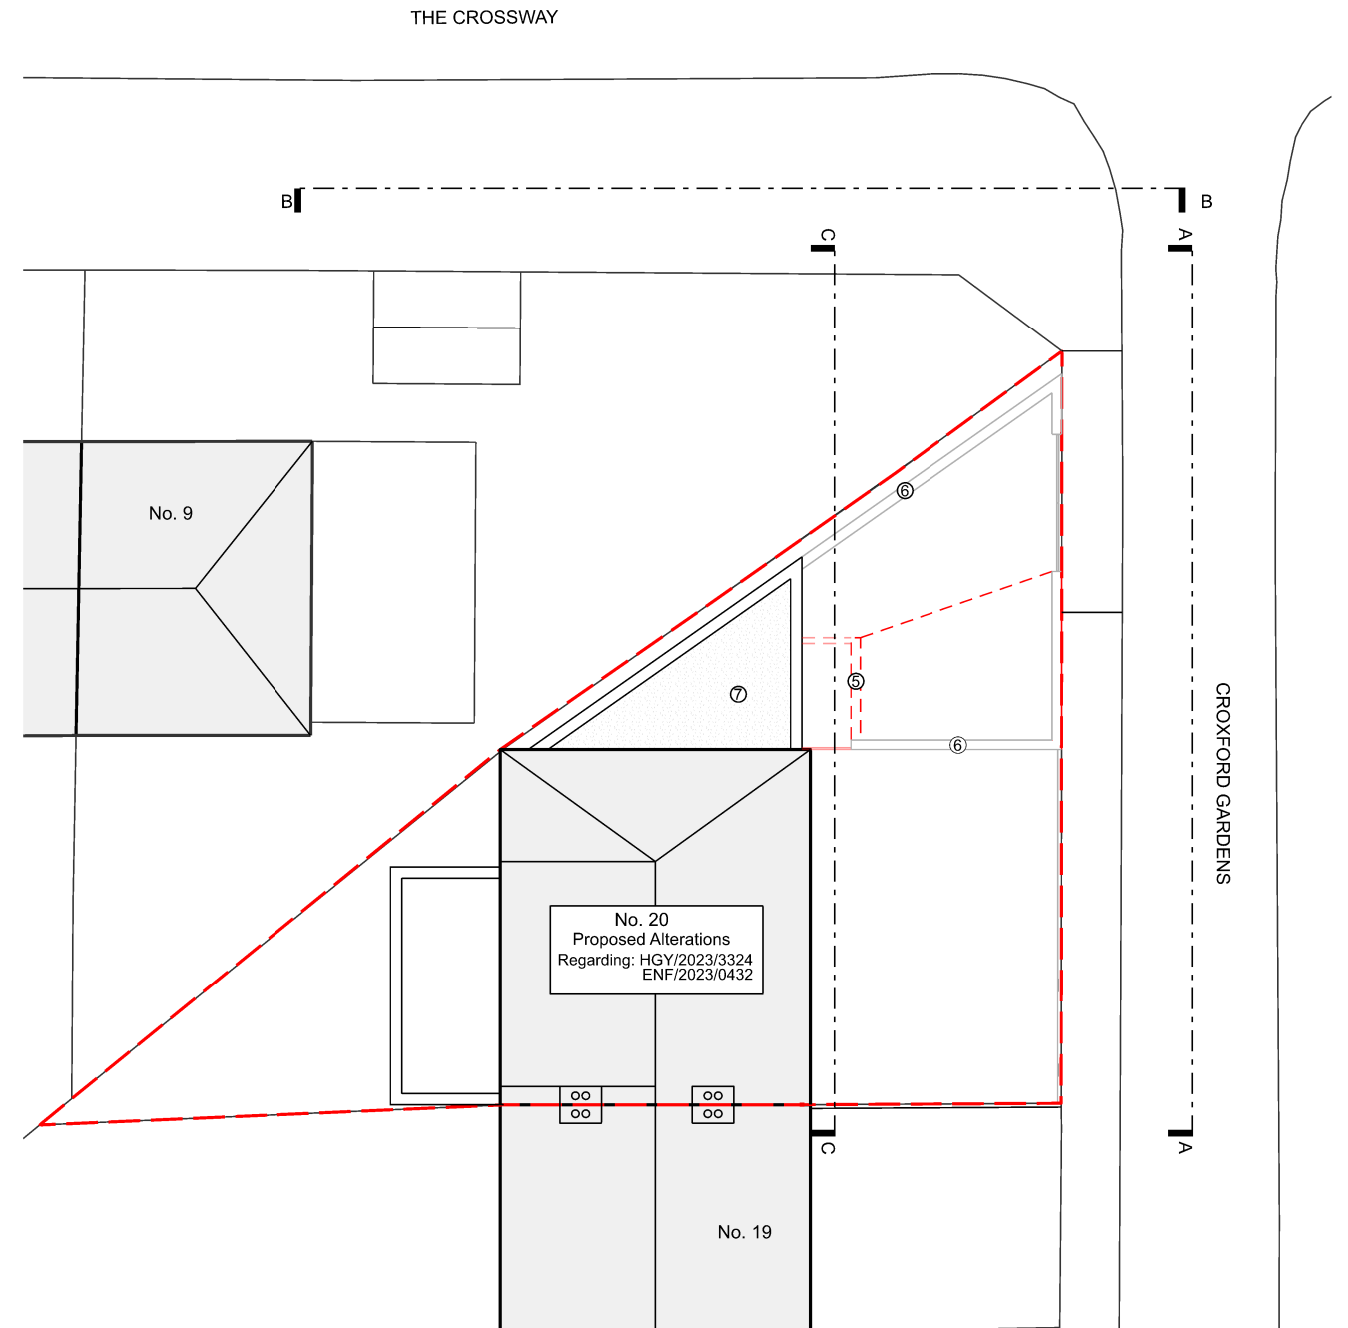

01 AS BUILT SITE PLAN
1:200

02 PROPOSED ALTERATIONS SITE PLAN
1:200

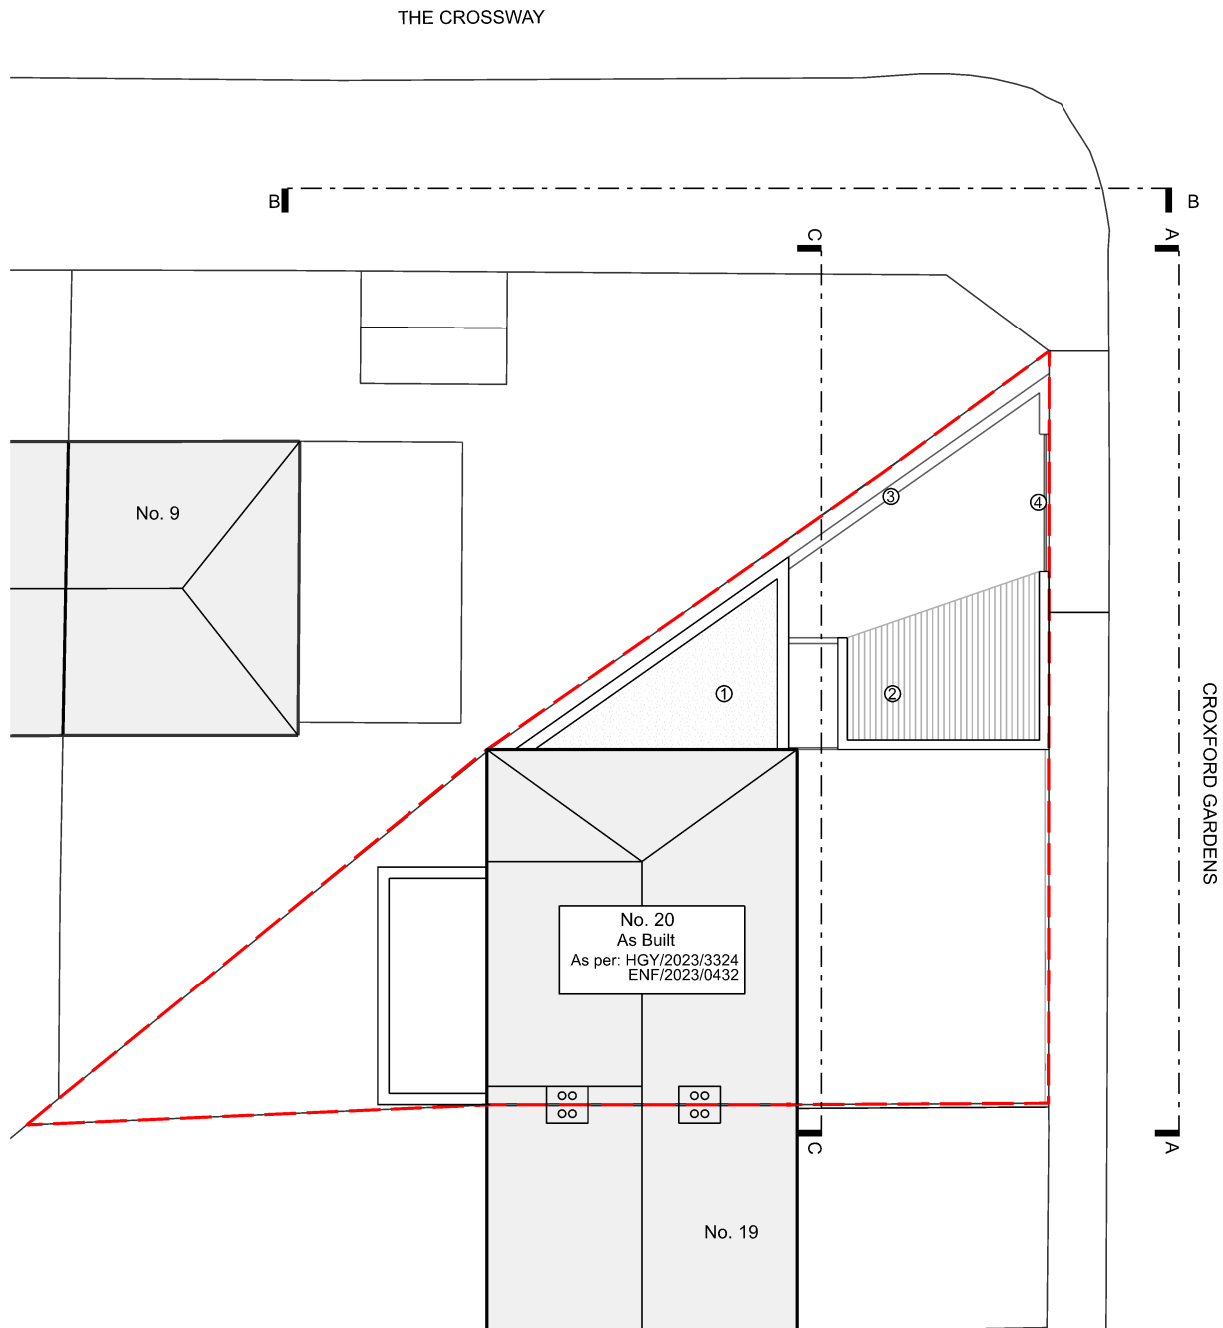

KEY PLAN

NOTES

- ① Side extension storage room
- ② External storage shelter
- ③ 2.5m Garden walls
- ④ Access gates
- ⑤ External Storage shelter removed
- ⑥ Walls and gate lowered to 1m
- ⑦ Side extension storage room retained

REV.	NOTES	DATE
P00	RETROSPECTIVE PLANNING	11.03.24

TITLE
AS BUILT SITE +
LOCATION PLANS

DRAWING NO. 030-ESP01
REVISION P00

DATE 11.03.24
SCALE 1:200

Tikari Works
Studio 4 6-8 Cole St.
studio@tikari.co.uk
London SE1 4YH
020 300 52406

PROJECT
20 CROXFORD GARDENS

STATUS
PLANNING