



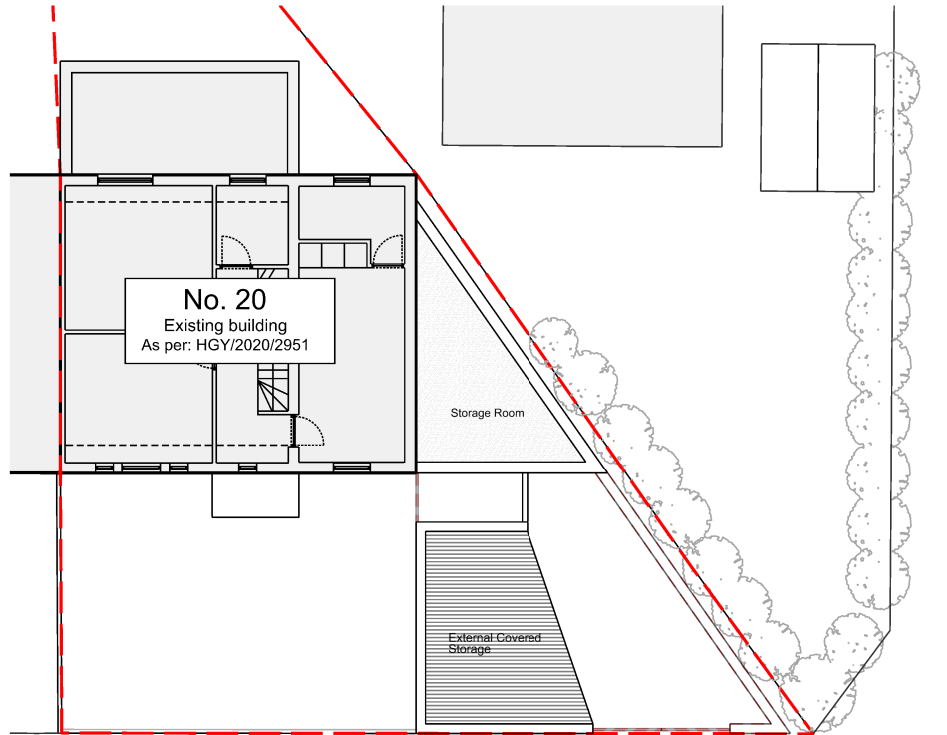

01 AS BUILT FIRST FLOOR PLAN
1:200

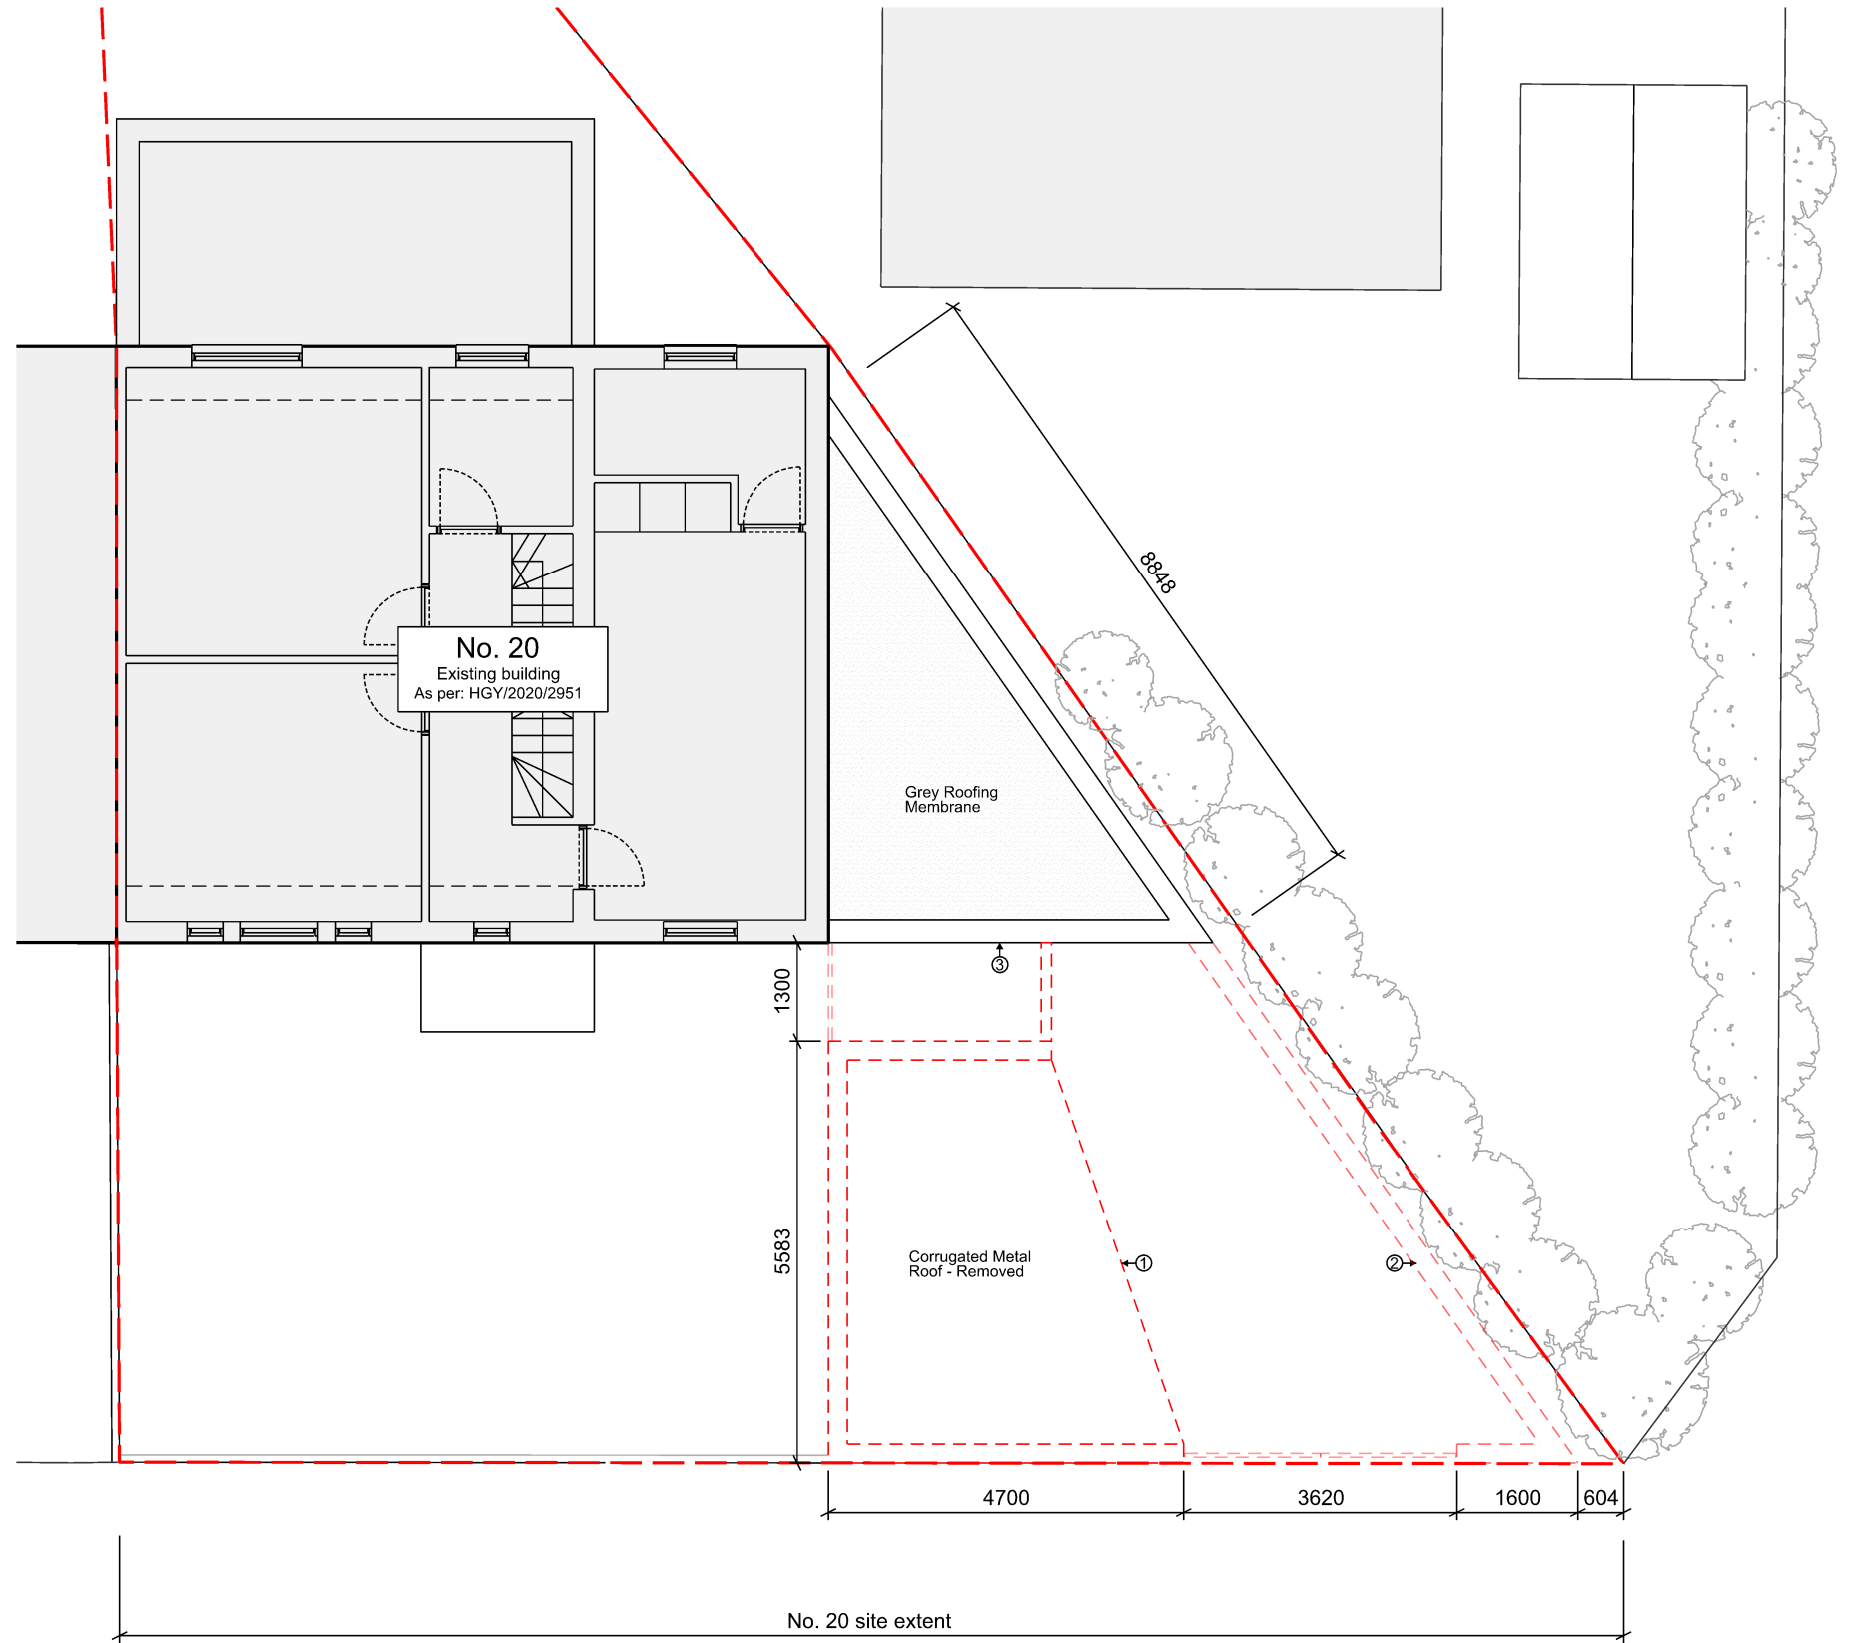

01 PROPOSED ALTERATIONS - FIRST FLOOR PLAN
1:100



KEY PLAN

NOTES

- ① Front store room removed
- ② 2.5m walls lowered to 1m
- ③ Side extension store room retained

REV.	NOTES	DATE
P00	RETROSPECTIVE PLANNING	11.03.24

TITLE
AS BUILT + PROPOSED
ALTERATIONS FIRST
FLOOR / ROOF PLAN

DRAWING NO. 030-PP01
REVISION P00

DATE 11.03.24
SCALE @ A3

Tikari Works
Studio 4 6-8 Cole St.
studio@tikari.co.uk
London SE1 4YH
020 300 52406

PROJECT
20 CROXFORD GARDENS

STATUS
PLANNING