



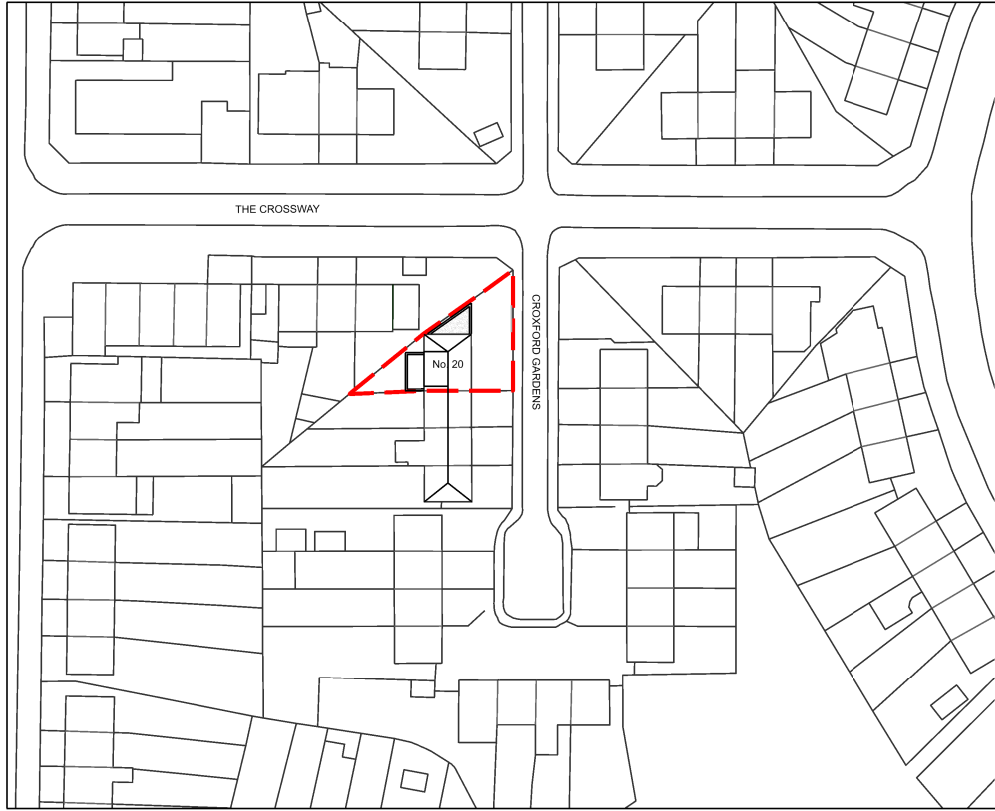

01 LOCATION PLAN - AS BUILT
1:1250 As per: HGY/2023/3324
ENF/2023/0432

02 PROPOSED ALTERATIONS LOCATION PLAN
1:1250

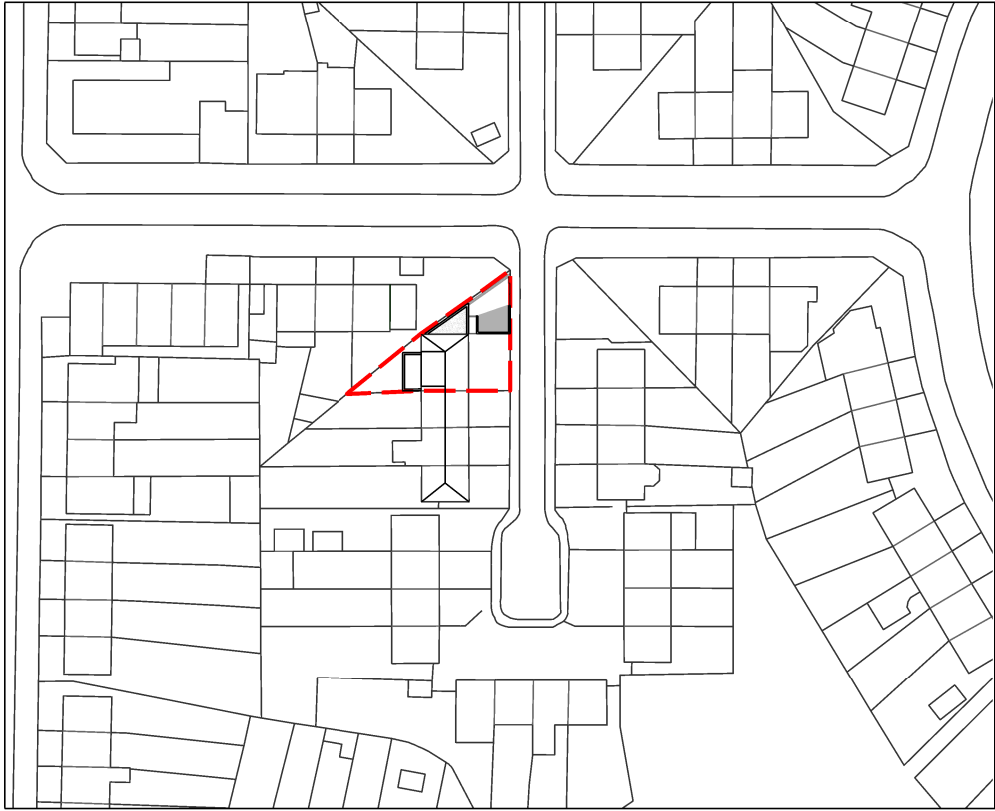

KEY PLAN

NOTES

REV.	NOTES	DATE
P00	RETROSPECTIVE PLANNING	11.03.24

TITLE
AS BUILT + PROPOSED
ALTERATIONS LOCATION
PLANS

DRAWING NO.
030-LP01

REVISION
P00

DATE
11.03.24

SCALE
1:1250

Tikari Works
Studio 4 6-8 Cole St.
studio@tikari.co.uk London SE1 4YH
020 300 52406

PROJECT
20 CROXFORD GARDENS

STATUS
PLANNING