


- DOCUMENT NOTES:
1. THIS DRAWING IS FOR PLANNING PURPOSES ONLY AND SHOULD NOT BE USED FOR CONSTRUCTION.
 2. THIS DRAWING AND DESIGN IS FOR USE SOLELY IN CONNECTION WITH THE PROJECT DESCRIBED BELOW.
 3. THIS DRAWING AND DESIGN IS THE PROPERTY OF AS STUDIO AND MUST NOT BE ISSUED, LOANED OR COPIED WITHOUT WRITTEN CONSENT.
 4. THIS DRAWING IS TO BE READ IN CONJUNCTION WITH ALL ADDITIONAL INFORMATION FORMING PART OF THIS APPLICATION.
 5. THIS DRAWING AND DESIGN REQUIRES TO BE COORDINATED WITH OTHER DESIGN ELEMENTS BY THE PRINCIPAL DESIGNER APPOINTED TO ENSURE COMPLIANCE UNDER THE NEW BUILDING REGULATIONS REGIME.
 6. AS STUDIO IS NOT ACTING AS PRINCIPAL DESIGNER ON THE PROJECT HERE SHOWN AND ALL PRINCIPAL DESIGNER DUTIES ARE BY THE CLIENT AND THE CONTRACTOR


KEY

- Boundary line
- Existing walls
- Proposed walls
- Demolition

scale 1:100

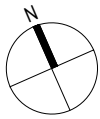

EXISTING SECOND FLOOR (AS BUILT)

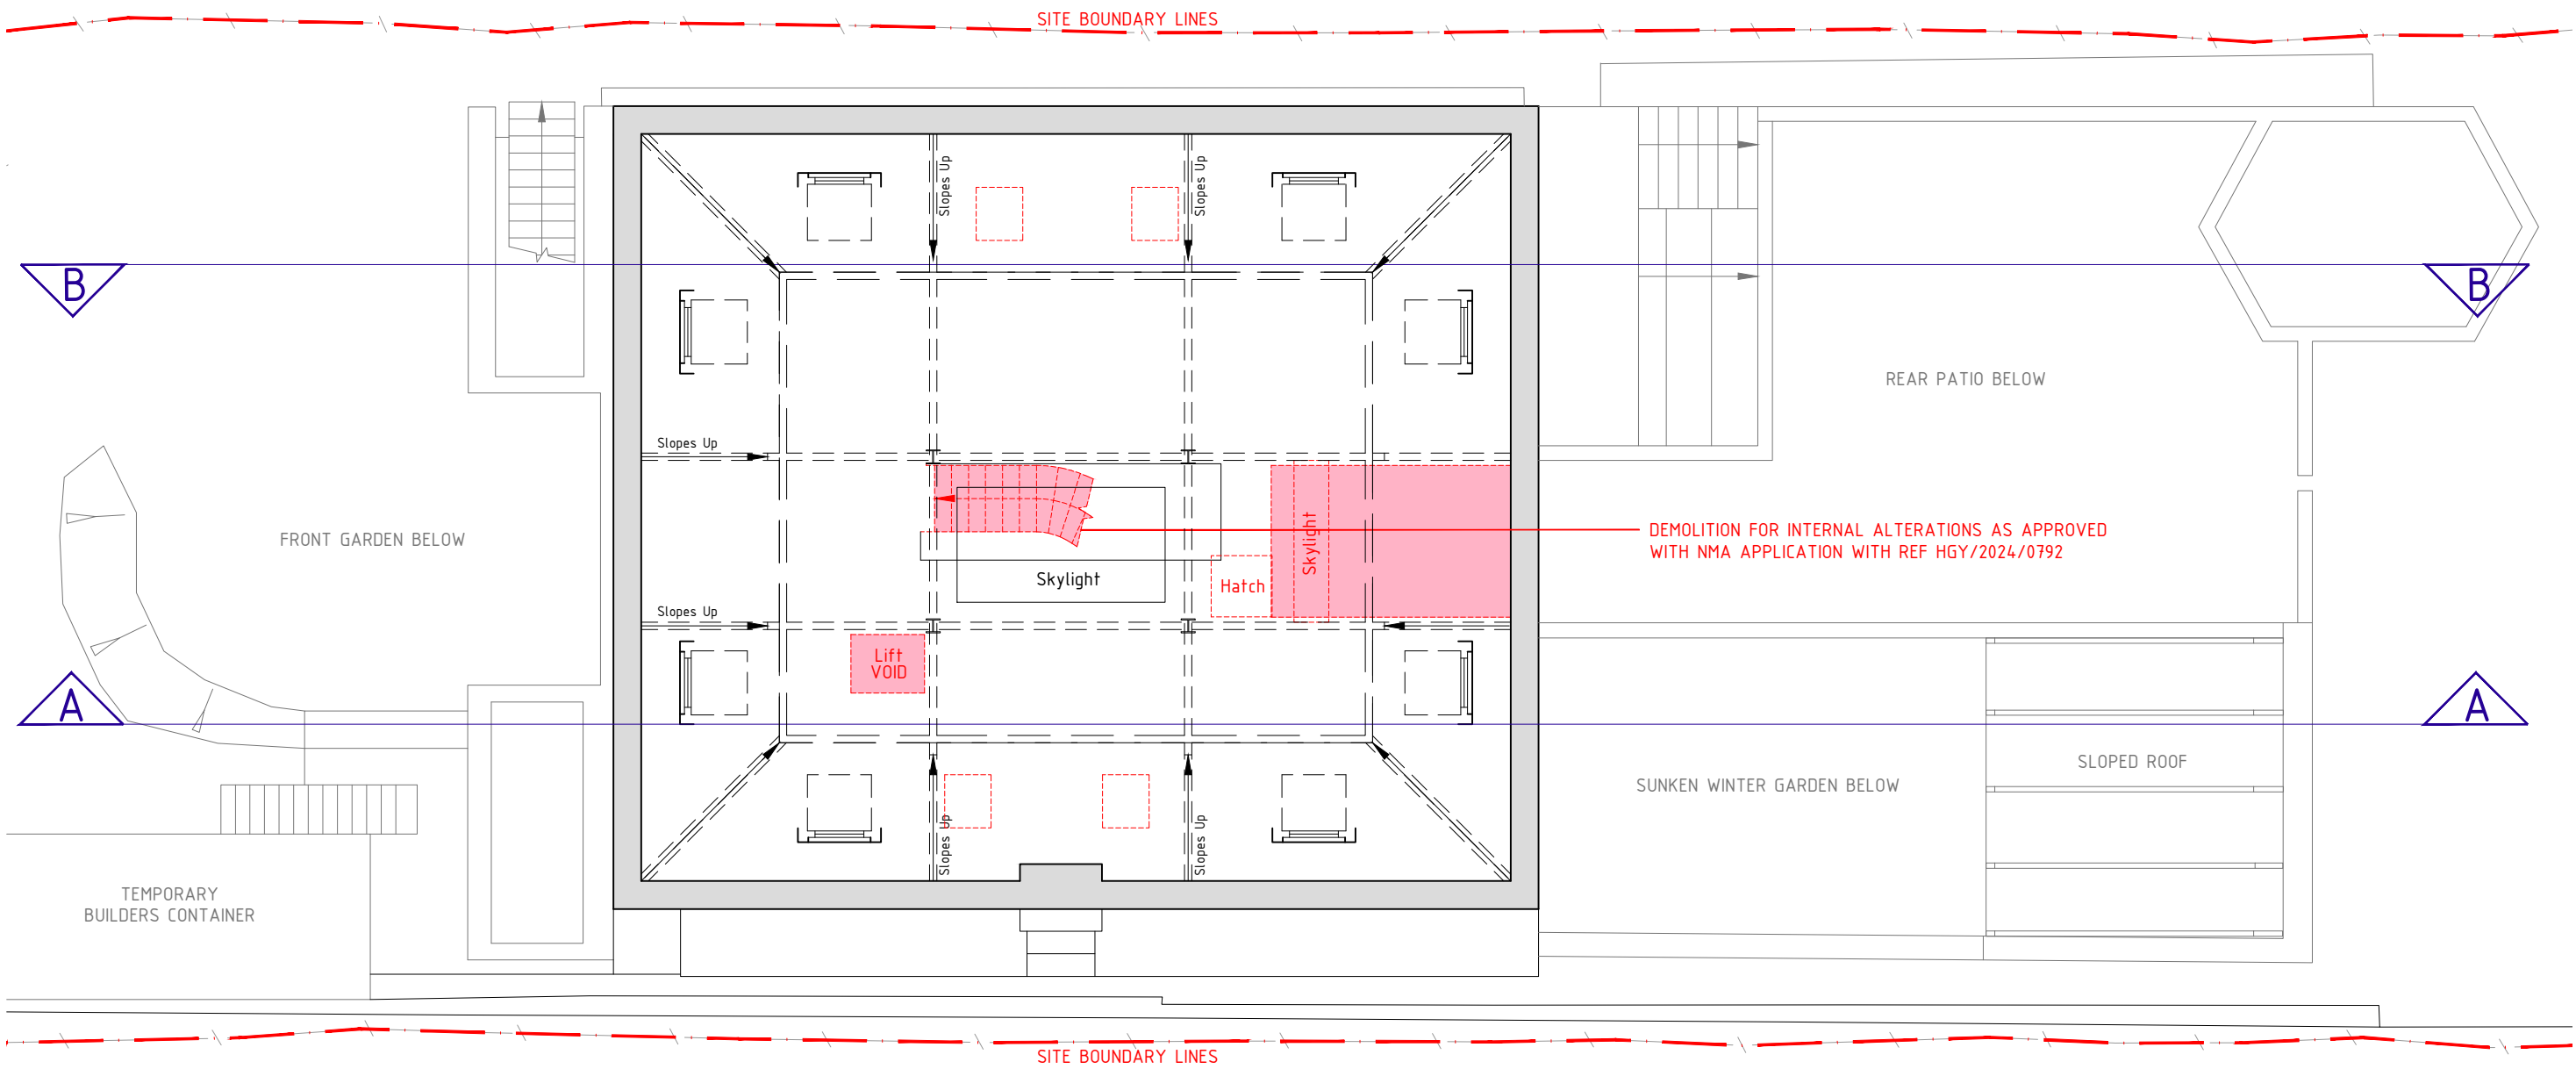

Existing surveyed by LASER SURVEYS in September 2023



2 magdalen mews
back of 164 finchley road
london
NW3 5HB
tel:+44 (0)207 794 1625 fax:+44 (0) 207 794 0296
info@as-studio.co.uk

PROJECT ADDRESS:
64 SHELDON AVENUE
N6 4ND, LONDON
CLIENT NAME:
BEN & NAAMA FISCHMAN

EXISTING SECOND FLOOR			
DRAWING NO: 1064(PLA2)105	DWG FILE: 1064(PLA2)100-300		
PROJECT STAGE: PLANNING	DRAWN: CS		
VERSION:	SCALE: 1:100	SIZE: A3	DATE: 15.07.24

THIS DRAWING AND DESIGN IS THE PROPERTY OF AS-STUDIO LTD AND MUST NOT BE ISSUED, LOANED OR COPIED WITHOUT WRITTEN CONSENT