

REAR ELEVATION. SW.

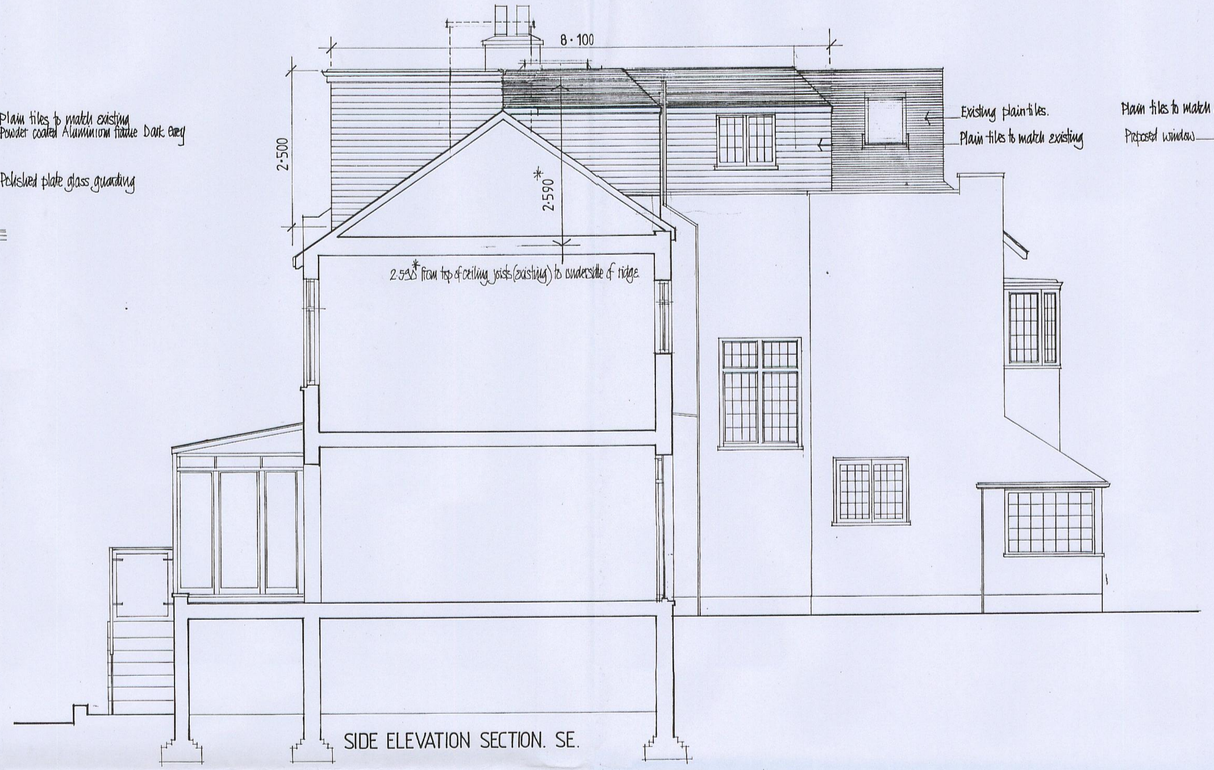

SIDE ELEVATION SECTION. SE.

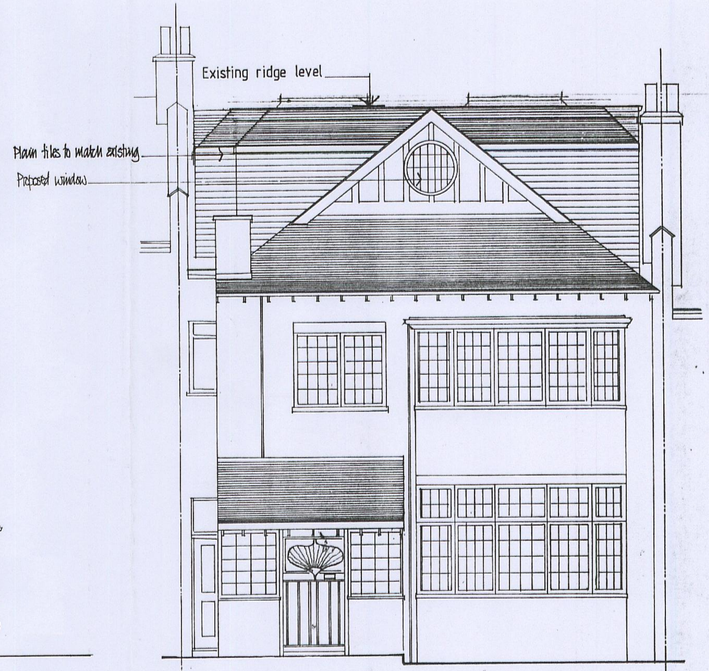

FRONT ELEVATION NE

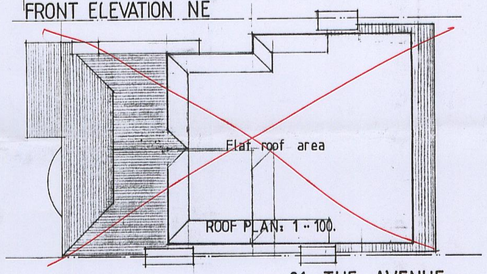

81. THE AVENUE
MUSWELL HILL
LONDON N10 2QG

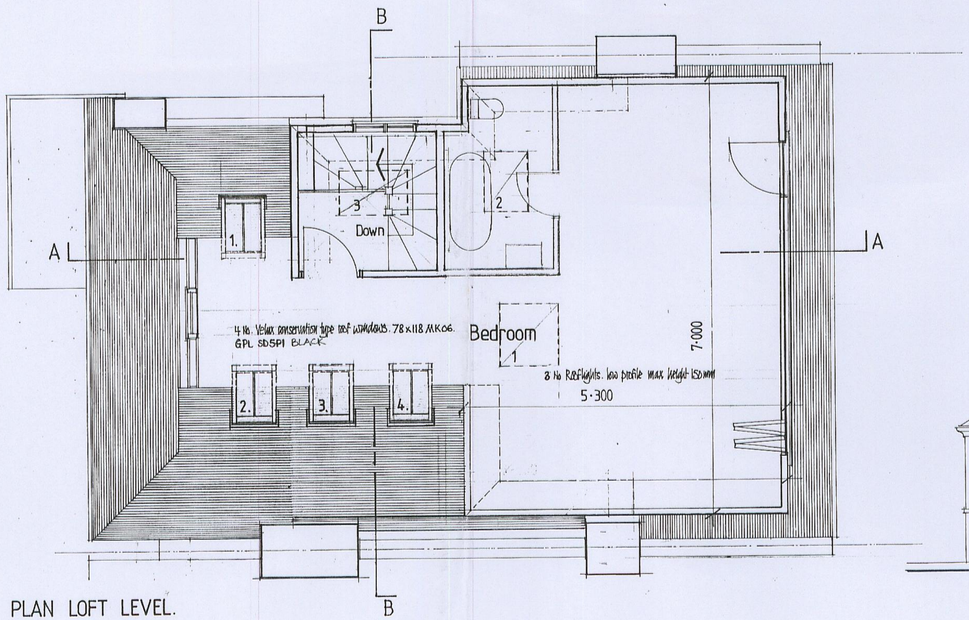

PLAN LOFT LEVEL.

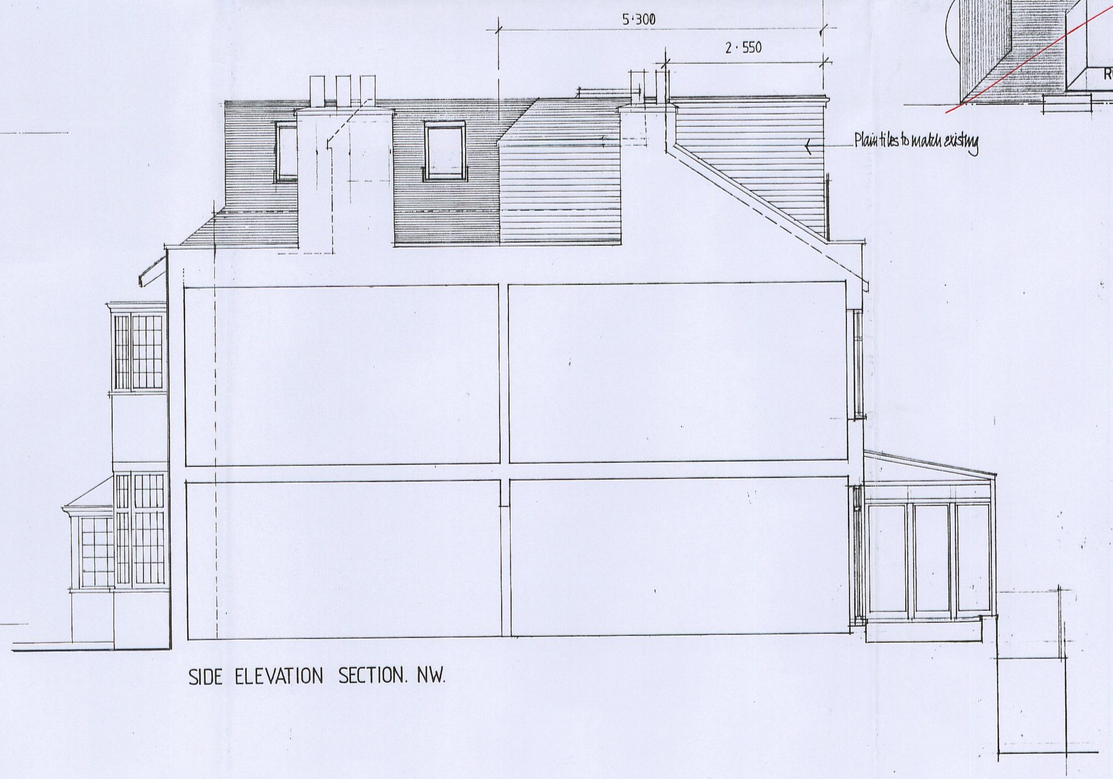

SIDE ELEVATION SECTION. NW.

PLAN + ELEVATIONS PROPOSED

Drawing No: 0514 ·· 02. ~~A~~ ~~B~~ ~~C~~ D

Scale: 1··50.

0 ·5 1 1·5 2 3 4

Revision A July 2014. Dimensions added.

Revision B. October 2014. Front Dormer roof chamfered.

Revision C. January 2015. Dormer to NW elevation reduced in size (set back 2·8 metres from original position). Rear Dormer width increased from 6·6M to 7M.

Revision D March 2015. Rooflights added to Flat Roof Area. Velux windows added to existing front pitched section. staircase enclosure reduced in size. Rooflights 3No to stair enclosure. Bathroom and Bedroom.