



AS INSTALLED FRONT ELEVATION
Scale 1:50

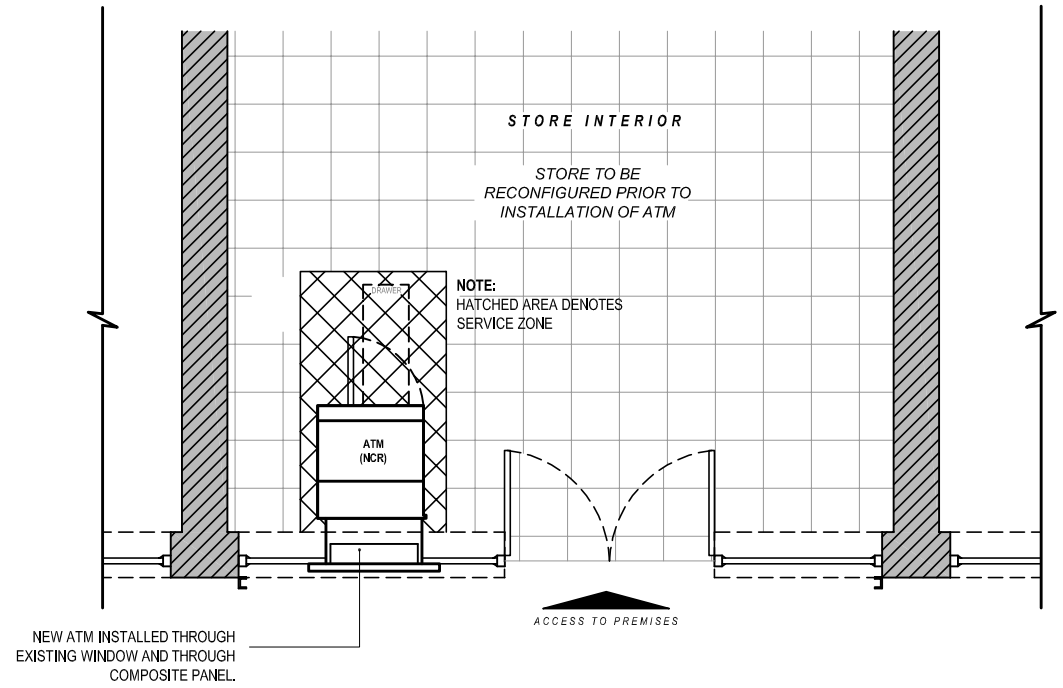

AS INSTALLED PART PLAN
Scale 1:50

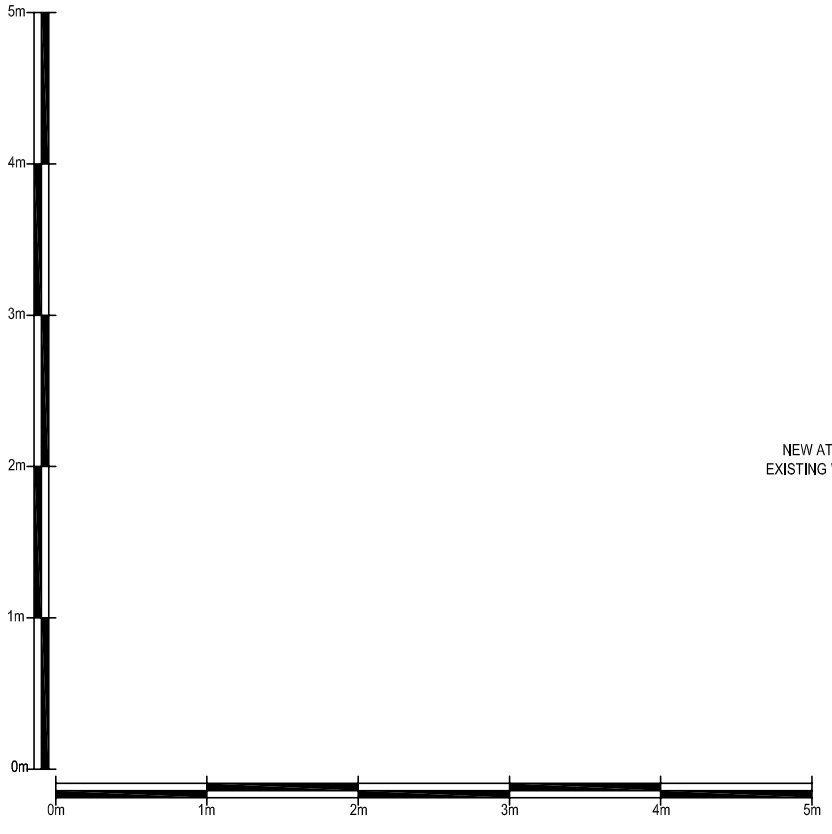

NOTE MACHINE

Date:	Comments:	By:

GENERAL NOTES:

1) All dimensions in millimeters unless otherwise stated.

Site:
SNOW WHITE DRY CLEANERS

78 Stroud Green Road
London
N4 3EN

Drawing Title:
As Installed Elevations and Plans

Ref:	Date:	Rev:
NM-10-2015-39-2	16-10-2015	
Scale: 1:50	**Paper:** A3	**Date Rev:**