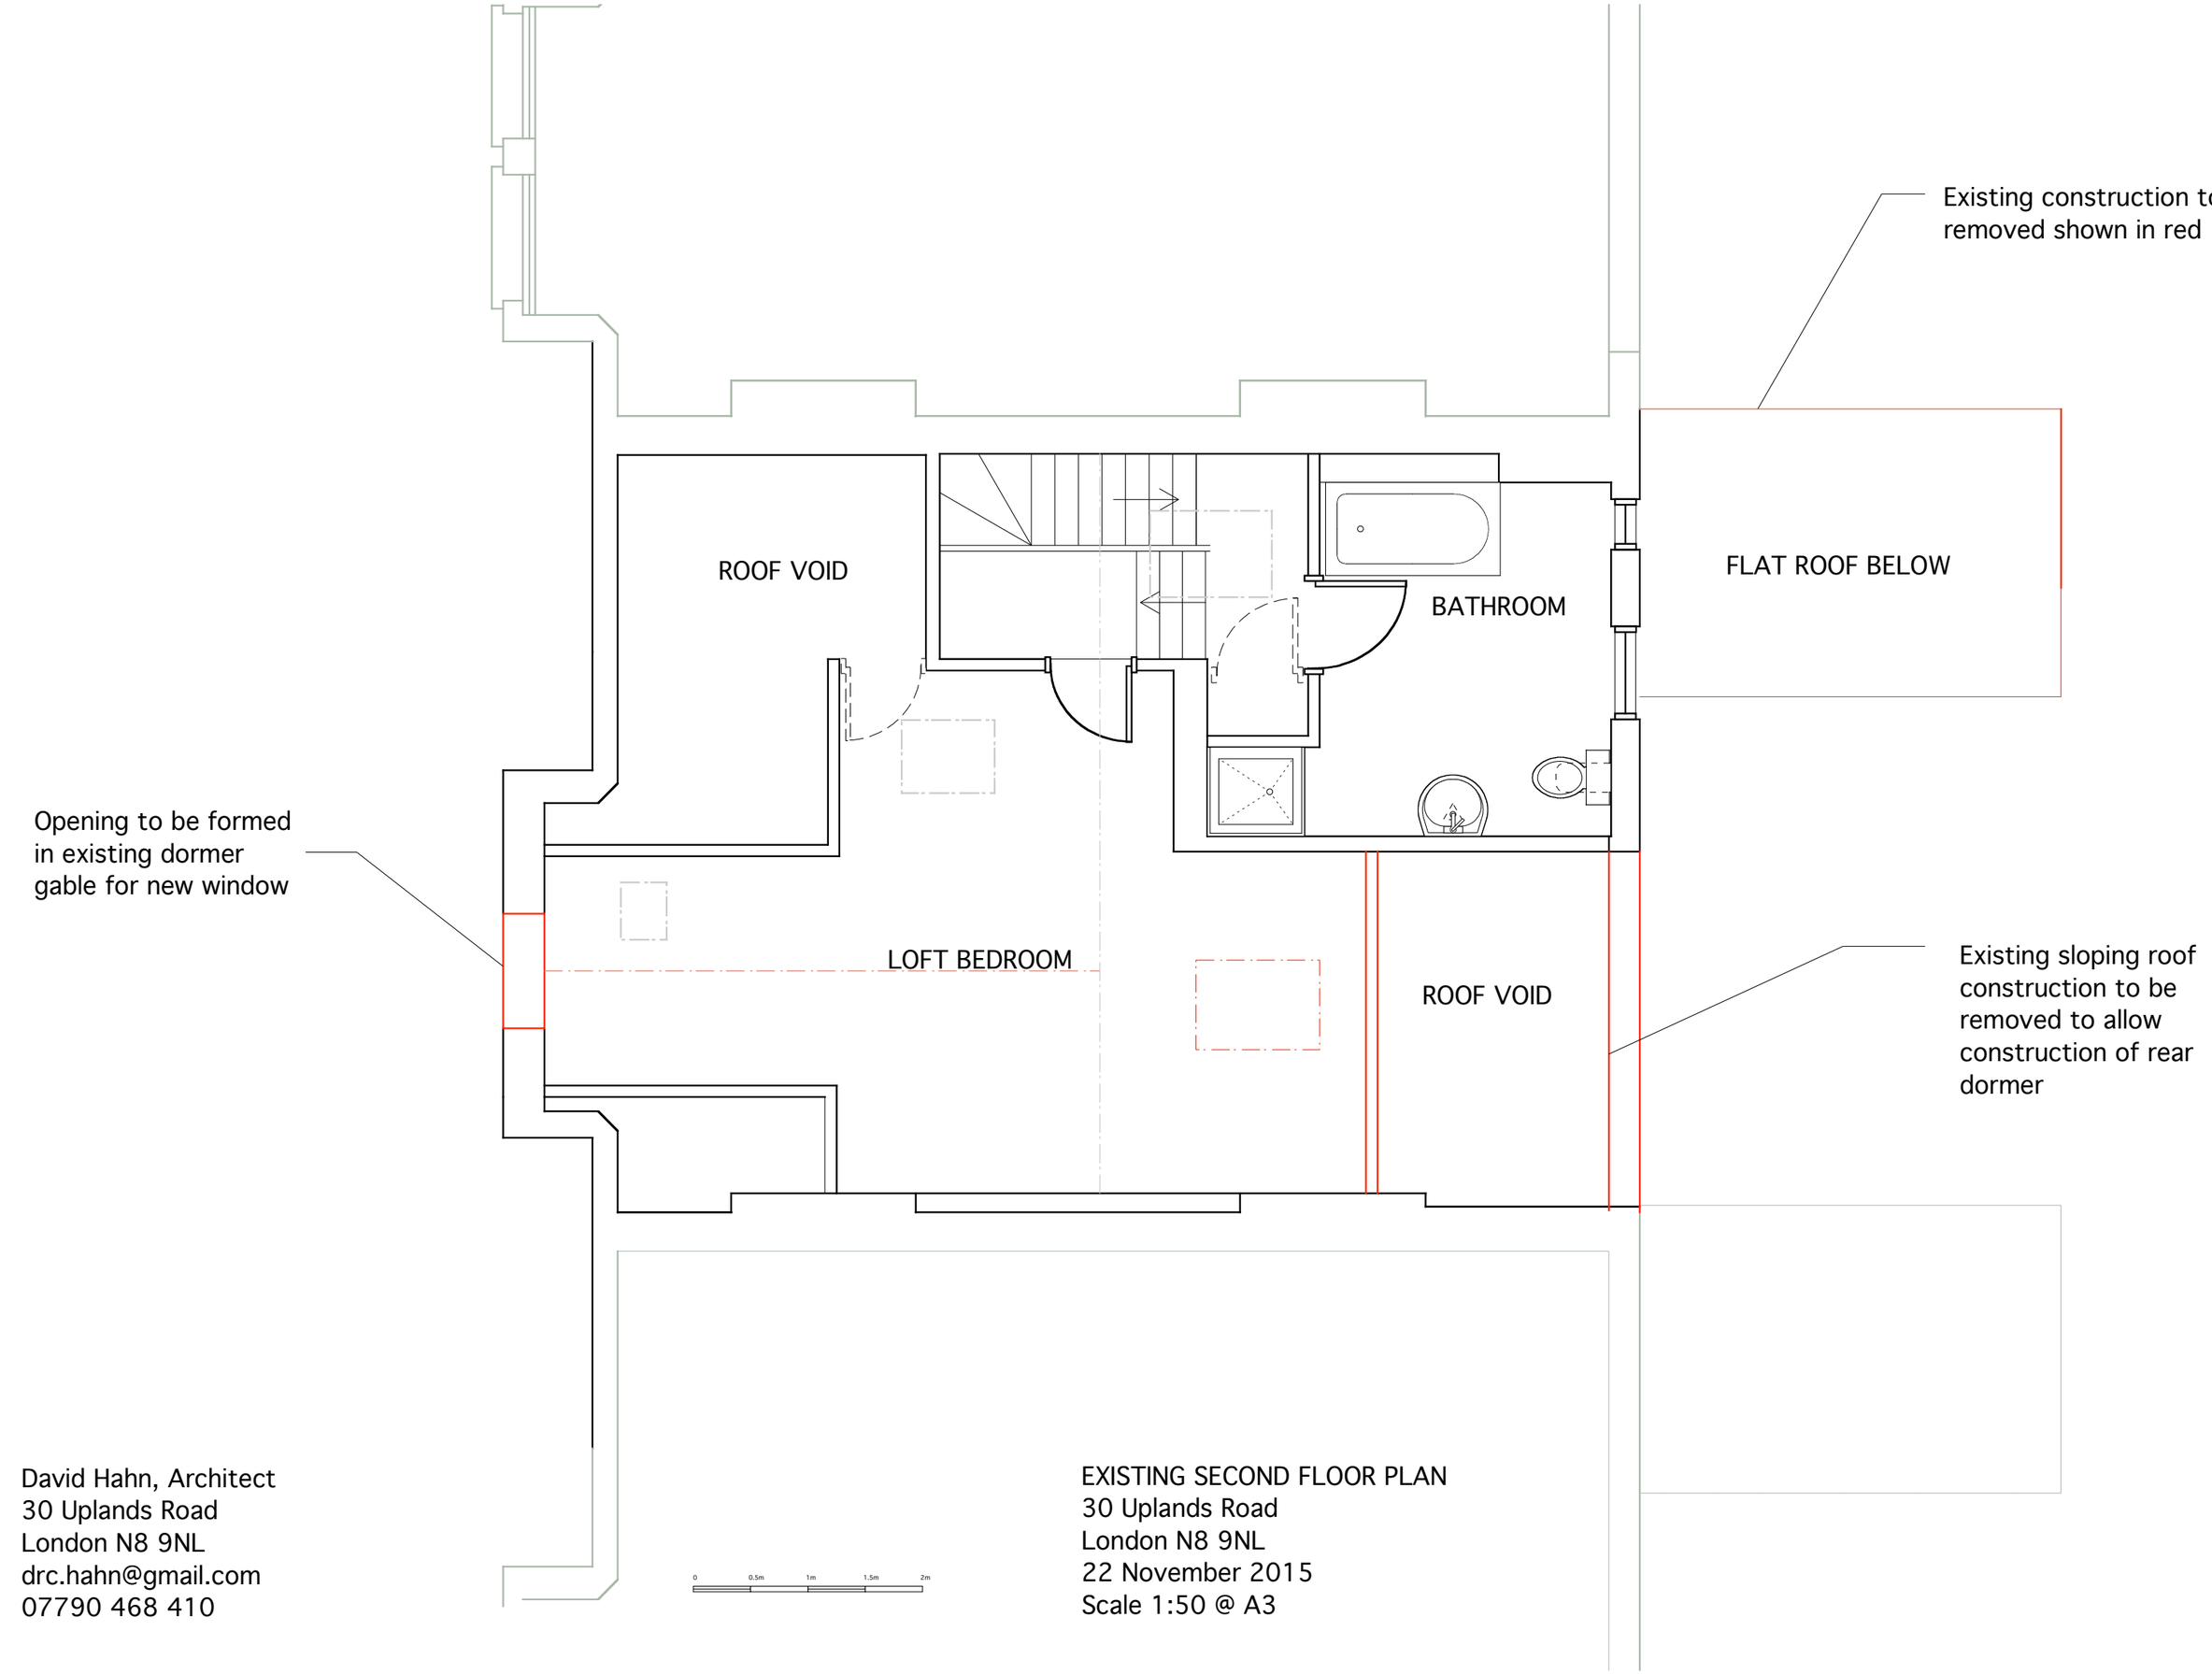

Existing construction to be removed shown in red

Opening to be formed in existing dormer gable for new window

Existing sloping roof construction to be removed to allow construction of rear dormer

David Hahn, Architect
30 Uplands Road
London N8 9NL
drc.hahn@gmail.com
07790 468 410

EXISTING SECOND FLOOR PLAN
30 Uplands Road
London N8 9NL
22 November 2015
Scale 1:50 @ A3