

AS INSTALLED FRONT ELEVATION
Scale 1:50

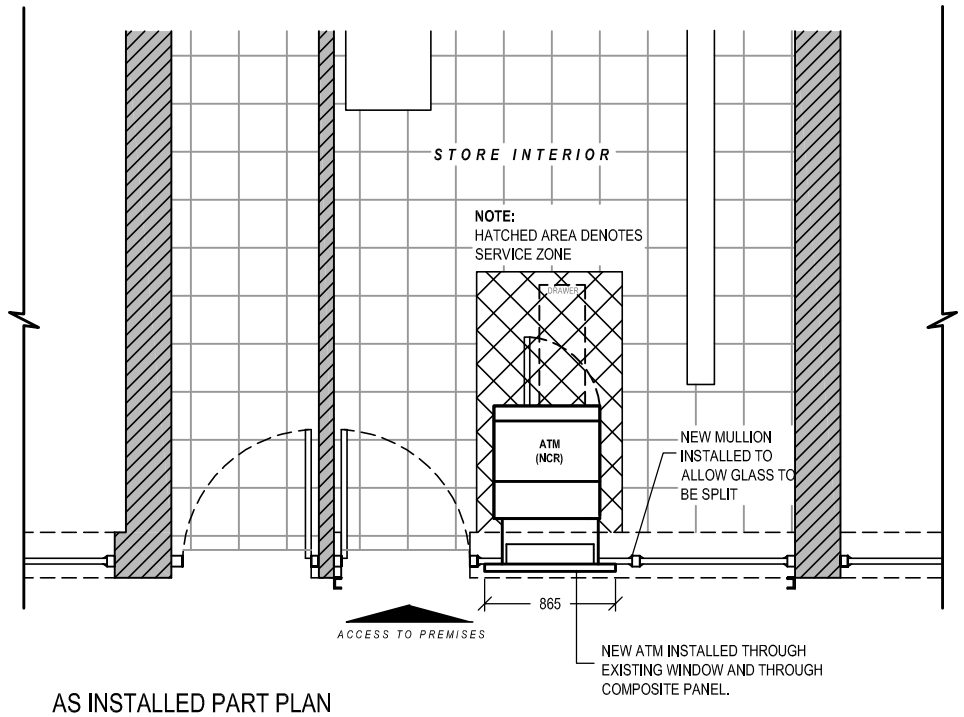

AS INSTALLED PART PLAN
Scale 1:50

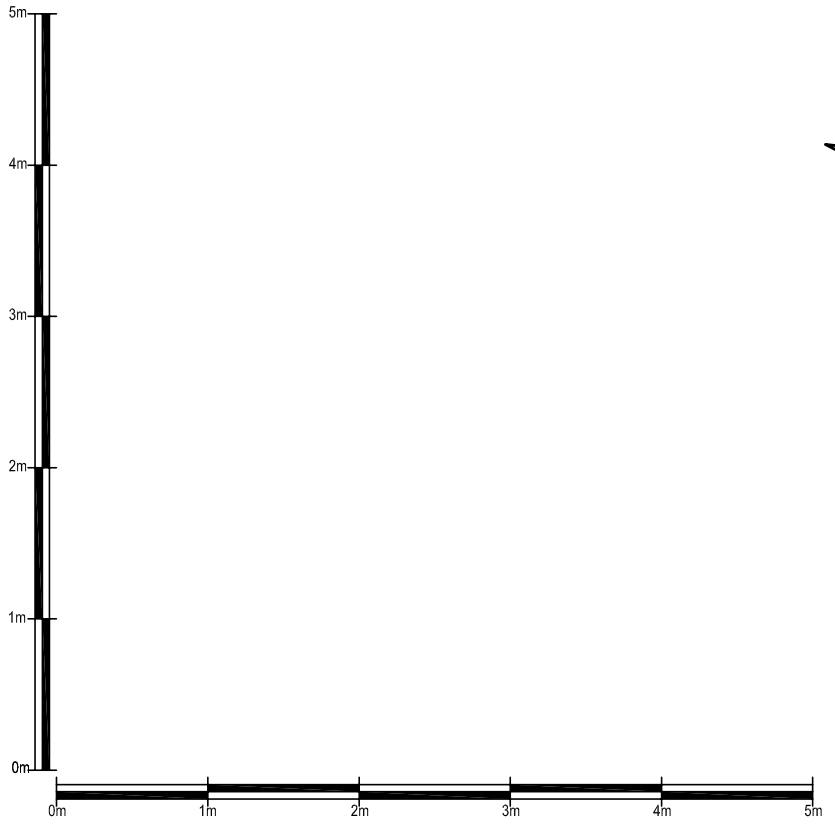

NOTE MACHINE

Date:	Comments:	By:

GENERAL NOTES:

1) All dimensions in millimeters unless otherwise stated.

Site:
BARAKA SUPERMARKET

84 West Green Road
London
N15 5NS

Drawing Title:
As Installed Elevations and Plans

Ref:	Date:	Rev:
NM-11-2015-21-2	17-11-2015	
Scale: 1:50	**Paper:** A3	**Date Rev:**