


This Is A Cad Drawing
UNDER NO CIRCUMSTANCES SHALL MANUAL ALTERATIONS BE MADE.
FIGURED DIMENSIONS TAKE PREFERENCE TO SCALE.
VERIFY AND CHECK ALL DIMENSIONS ON SITE BEFORE WORK IS PUT IN HAND, AND ANY DISCREPANCIES ARE TO BE REFERED TO SEESAW-STUDIOS.

Copyright Is Reserved
COPYING OR REPRODUCTION OF THIS DRAWING OR ELECTRONIC DATA WITHOUT THE WRITTEN PERMISSION OF SEESAW - STUDIOS IS NOT PERMITTED

Disclaimer
THE HARD COPY ACCOMPANYING THE ELECTRONIC DATA IS THE LEGAL

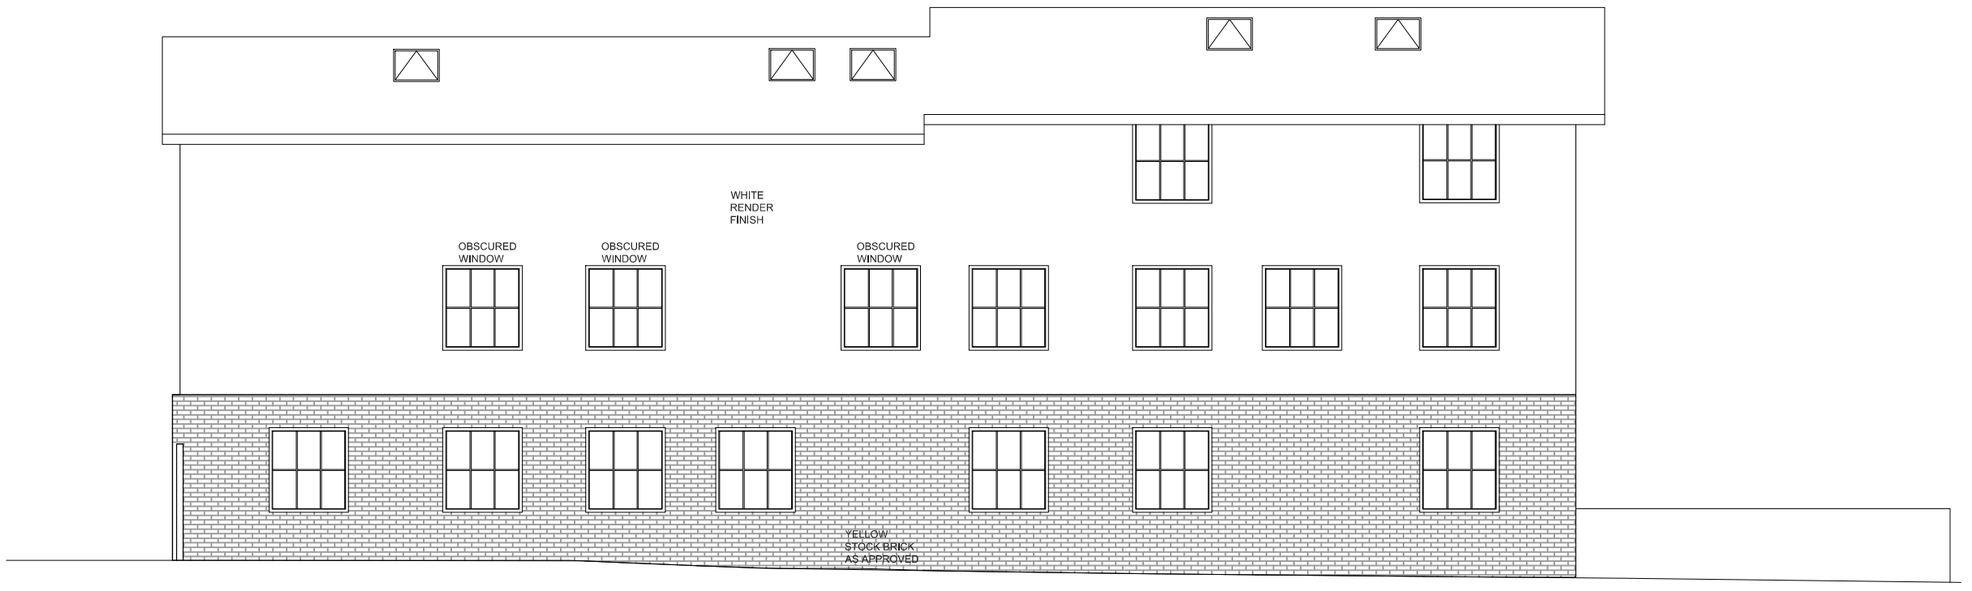

Proposed North Elevation
Scale 1:100 @A3

Rev.	Date.	Amendment.
Project.		

44 Finsbury road, N22 8PA

SEESAW-STUDIOS
Architecture Planning Interior Design
3 Stanford Mews, Dalston Lane
London E8 1JA

T +44 (0)20 7254 5671

info@seesaw-studios.com
www.seesaw-studios.com

Drawing title.
Proposed North
Elevations as Built

Status.
CONDITIONS APPROVAL

Client.
Tagmarsh Ltd

Scale.
1:100 @A3

DWG No.
SE1321-02

Date.
May'16

Dwn.
T.K