
Location Plan:
Sections

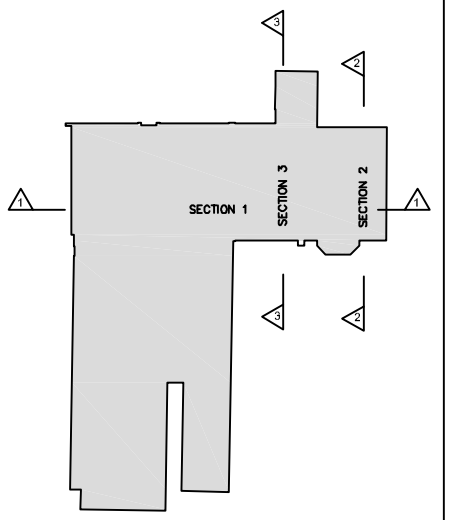

SECTION 2-2

Revisions:
Suffix / Date / Drawn/ Description
A April 16 PB Title block

GENERAL
Do not scale drawings, Report any dimensional discrepancies.

©This drawing is the property of Philip Bailey Architects and must not be copied or reproduced in full or in part without express written permission

- ○ Approval
- ○ Preliminary
- ○ Information
- ○ Tender
- ○ Construction
- ● As Built

Client Redwing
Project 7 Bruce Grove
Drawing Existing Section 2

Format A3
Scale 1:100
Date Aug 11

Project Ref. 548
Drawing No. 310
Revision A

philip bailey architects
1 Watton Road
Knebworth
Herts
SG3 6AH
Tel: 01923 289960
Fax: 01923 289961