

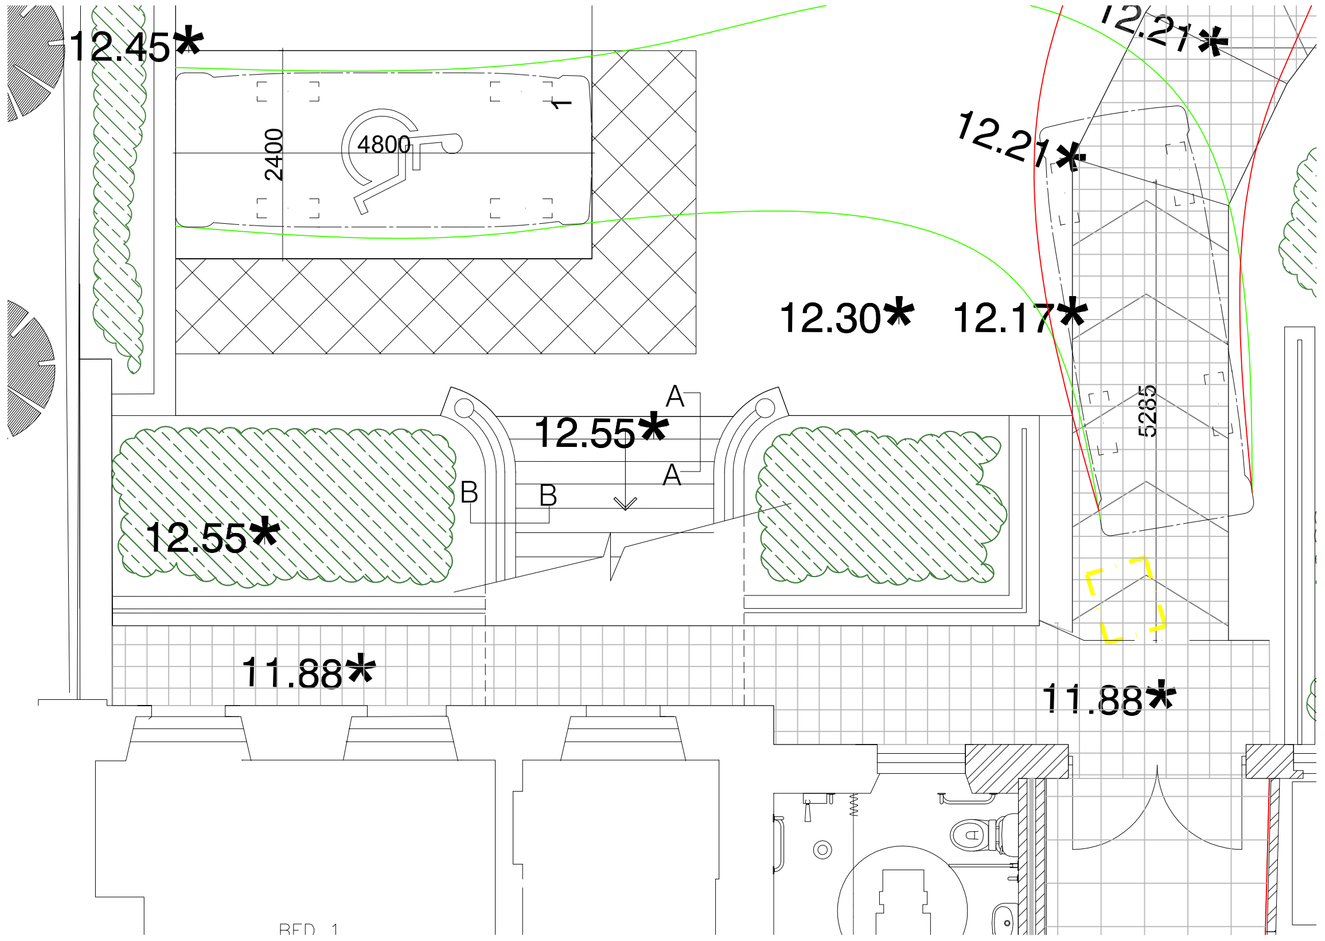


Front Area Plan

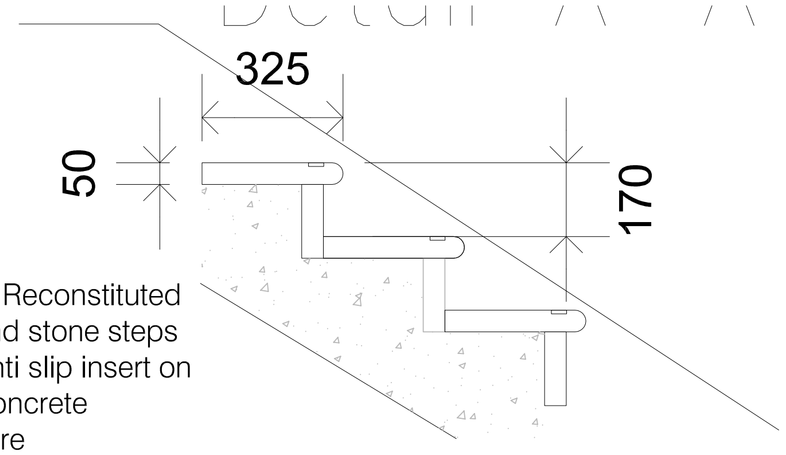


50mm Reconstituted Portland stone steps with anti slip insert on cast concrete structure

Portland stone steps and risers.
Stone capping with Balustrade on cast concrete steps to engineers detail
Handrail to be 20mm x 50mm steel flat painted black with 10mm balusters at 100mm centers.
Secured into concrete steps with lead plug.

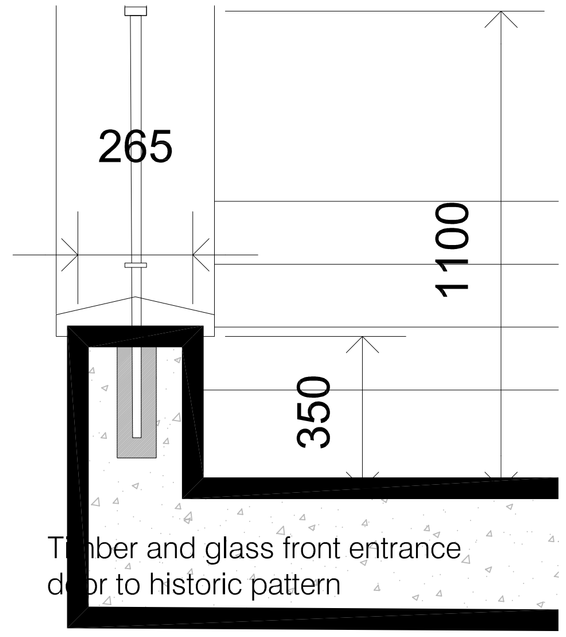

Timber and glass front entrance door to historic pattern

Detail B–B

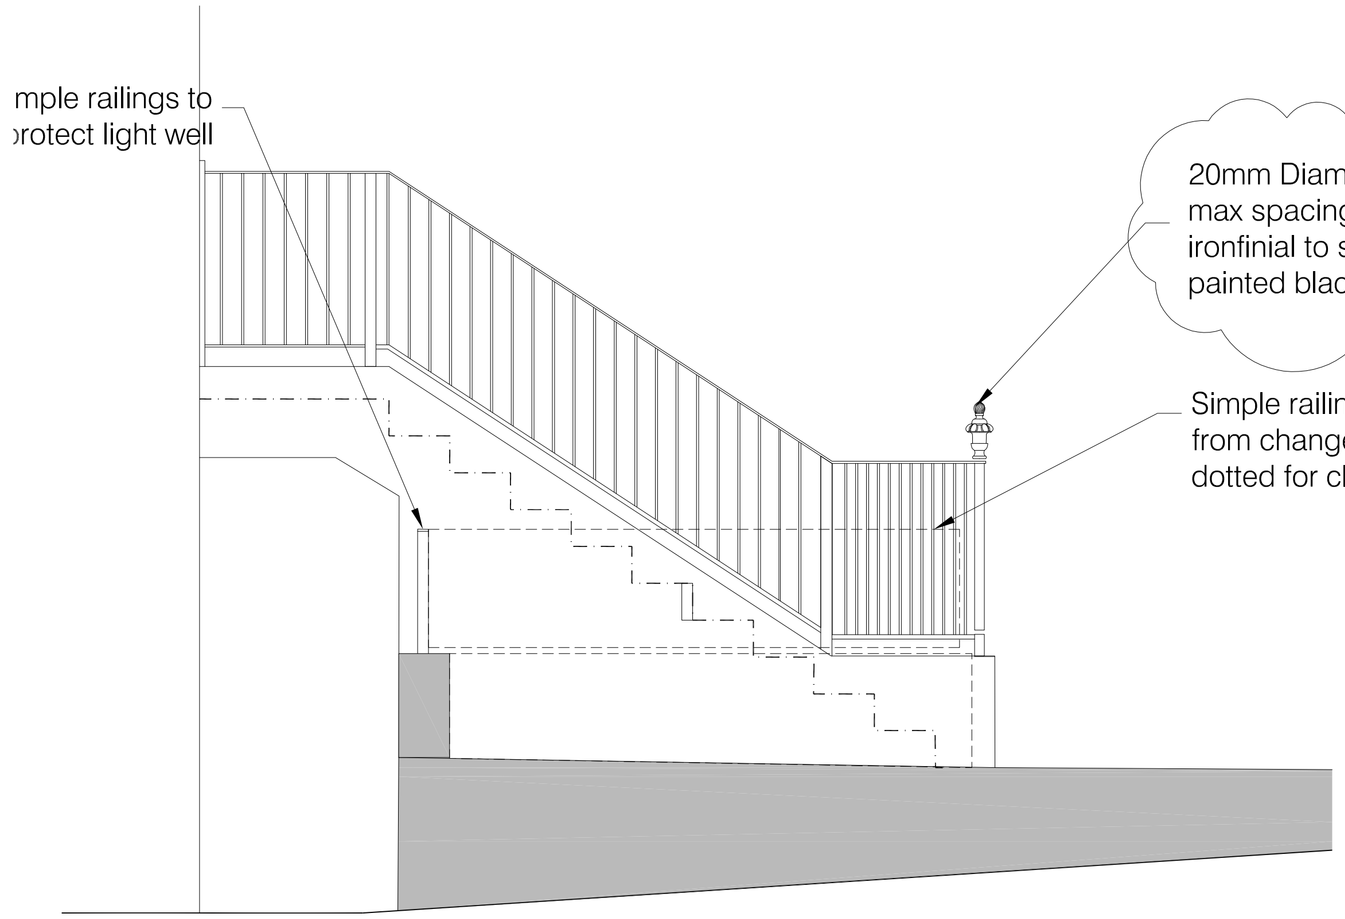

Front Steps Side Elevation



Front Steps front elevation

isions:
ix / Date /Dwn /Chkd / Revision

GENERAL
Do not scale drawings, Report any dimensional discrepancies.

1:10 0 1 2 3 4 5 METRES

1:20 0 1 2 3 4 5 METRES

©This drawing is the property of Philip Bailey Architects Ltd Ltd and must not be copied or reproduced in full or in part without express written permission

- Approval
- Preliminary
- Information
- Tender
- Construction
- As Built

Client Redwing Group

Project 7 Bruce Grove

Drawing Proposed Entrance steps & Railing

Format. A1

Scale 1:10 & 1:20

Date May 16

Project Ref. 548

Drawing No. 118

Revision A

philipbailey architects
1 Watton Road
Knebworth
Herts
SG3 6AH
Tel: 01923 289960
Fax: 01923 289961