



CHANGES FROM THE PREVIOUSLY CONSENTED SCHEME MARKED IN RED

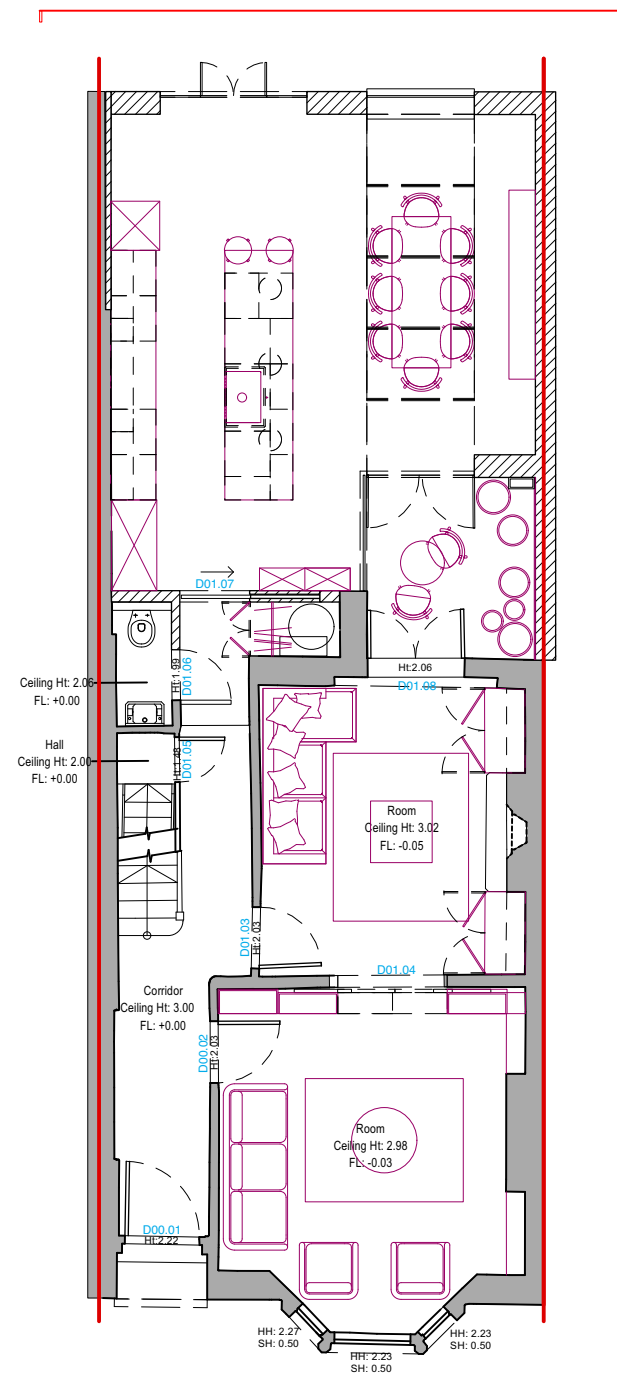

3) Reference Plan
1:100

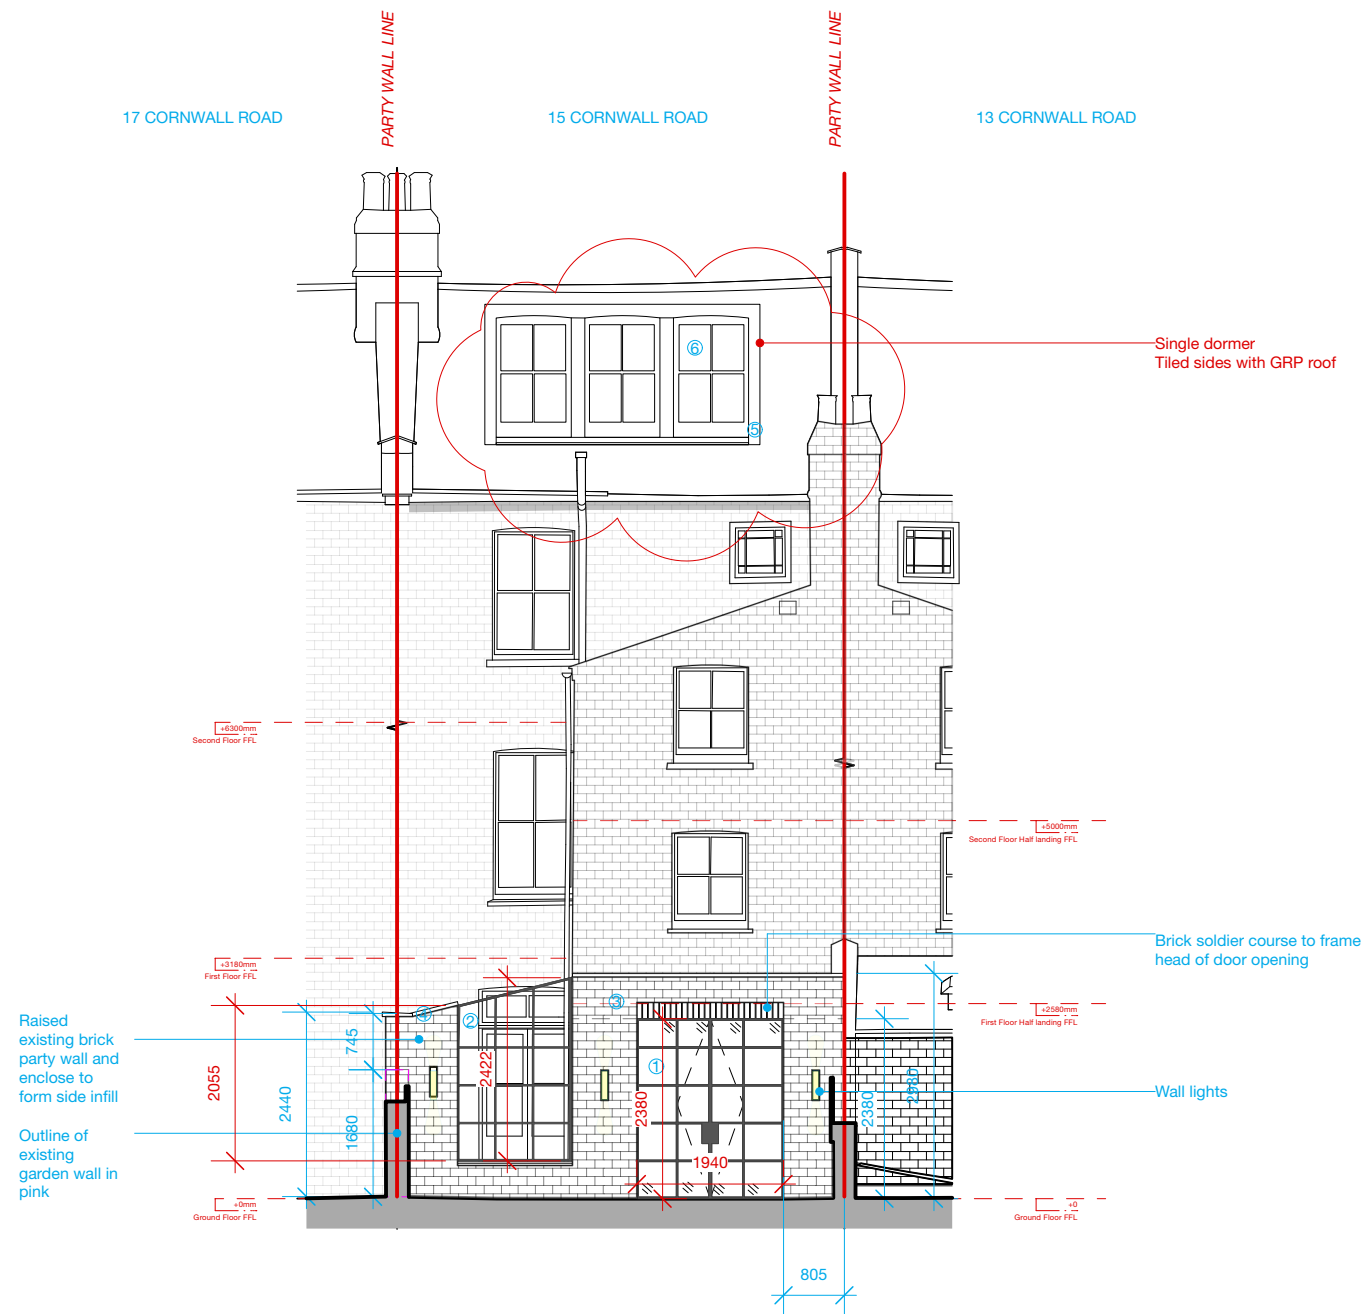

2 Rear Elevation
1:100

KEY

- ① Crittall double doors
- ② Fixed Crittall window
- ③ Reclaimed london stocks
- ④ Single weathered coping stone
- ⑤ Tiled dormer with GRP roof
- ⑥ Timber sash window

• This drawing is the property of Natalia Eddy. No disclosure or copy of it may be made without the written permission of Natalia Eddy.

For Construction purposes:

- All dimensions and levels to be checked on site.
- Discrepancies to be reported to Natalia Eddy before proceeding
- If in any doubt about information on this drawing contact Natalia Eddy

REVISION			
NUMBER	DATE	BY	NOTES
P1	24/02/2022	NE	Issued to planning
P2	24/08/2022	NE	Small change to dormer design. 2 x single dormers changed to 1 large dormer

NOTES:

KEY


 EXISTING

 PROPOSED

 PARTY WALL LINE

CLIENT SUPPLY

OUTLINE OF EXISTING STRUCTURE

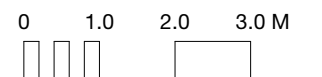

N A T A L I A E D D Y

99 Florence Road, London, N4 4DL
nataliaeddy3@gmail.com

CLIENT
Mr J Randall & Ms. E Hawes

PROJECT
15 Cornwall Road, London, N4 4PH

SHEET TITLE
Proposed Rear Elevation

SCALE
1:100@A3

DATE CREATED	FILE REFERENCE
24/02/2022	911-DWG-XX

DRAWING NUMBER

911-DWG-121-02

REVISION
P2