Copyright, Designs and Patents Act 1988
The copyright & design right of the design documents & of the design remains that of Whitecode Ltd. All copies are only for the purposes of the application; they may not be used for any other purpose or copied without the express written permission of Whitecode Ltd.

Conflicts of Information
It still remains the responsibility of the installer/contractor to ensure that there are no conflicts with information provided by ourselves & that of any manufacturers information or relevant requirements of statuary Bodies or Client specification/EIr's. If any conflicts do exist it is the responsibility of the Installer/Contractor to inform The Consultant/Client immediately Verbally & in writing.

WARNING TO HOUSE PURCHASERS - Property Misdescriptions Act 1991
Buyers are warned that this is a working drawing and is not intended to be treated as descriptive material describing, in relation to any descriptive material describing, in relation to any descriptive particular property or development, any of the Specific Matters prescribed by an Order made under the above Act. The contents of this drawing may be subject to change at any time & alterations and variations can occur during the progress of the works without revision of the drawing. Consequently the finished Works or contents & dimensions of the finished construction may differ materially from those shown. Nor do the contents of this drawing constitute a contract, part of any contract or a warranty.

NOTES

General Electrical Notes

- Mechanical services shown for coordination purposes only. Refer to mechanical drawings for mechanical services information.
- Before commencing work on site, please read Design Risk Management information.
- All manufacturer's instructions to be reviewed prior to installation.
- All electrical installations shall be carried out in accordance with BS 7671.
- This drawing is to be read in conjunction with the electrical symbols legend & typical mounting heights drawings.
- Where electrical boxes, conduits, trunking, pattresses or luminaires penetrate floors, walls, roofs, ceilings or other partitions, they must be suitably fire-stopped in order to arrest the spread of fire through the electrical system; as per section 527.2 of BS 7671 and Approved Document B.
- Dimensioned setting out details to be confirmed by architect.
- All discrepancies are to be queried with WDA before works commence.
- Electrical contractor to allow for supply and install of power assisted doors.

Electrical Installation Notes

1.01 All switches and sockets must be installed at least 300mm from internal room corners to meet the requirements of Lifetime Homes, 150mm from hobs and 300mm from sink basin to comply with BS7671.

2. Common Area Notes

2.01 Servie voids, ceiling voids, floor voids, undercrofts or any other void within the building shall be measured on site and relayed to WDA prior to installation of any components of the fire alarm system.

2.02 External lighting to be controlled by photocell and timeclock. Photocells shall be located above street lighting level. Most beneficial positions to be determined on site.

2.03 Adjustable down light (positioning to be assessed depending on panel location) controlled by key switch to provide 200 lux at lift control panel. Switch shall be marked 'Lift Landing Lighting'.

2.04 Key switch for testing of emergency lighting.1No.required per circuit.

2.05 All equipment required for the smoke control and environmental systems shall be supplied and installed by a specialist as per their designs, including all smoke/heat detectors, breaklgasses, actuators, and keyswitches. Electrical contractor to provide power supplies to specialist's panels. Bin stores shall be independant of the main fire alarm system to provide local detection and sounder.

2.06 Switched fused connection units shall be provided in risers for IRS equipment, AOV, CCTV, door entry and access control equipment. Specialist contractor shall confirm requirements.

2.07 Provisional Emergency exit signs. Final location and quantity to be confirmed by fire strategy/architect.

2.08 Lift 3-phase supply to be terminated in a lockable rotary 4-pole isolator made by Gewiss. ref: GW 75438. All items are to have a 2m length of spare cable to enable the final position to be determined by the lift installer.

2.09 Smoke detection for the control of AOV system, specialist to provide final requirements prior to installation.

2.10 Refer to electrical riser elevation drawings for positioning of equipment within the electrical riser.

2.12 Smoke detection for the control of AOV system , specialist to provide final requirements prior to installation.

2.13 Fire interface to form part of the local fire system. Fire specialist to confirm final requirements.

2.14 Door access controls to be confirmed against specification.

2.15 Provisional CCTV camera. Final location and quantity to be confirmed by client/architect.

2.16 Gate control panel to be operated by remote FOB to specialist design.

2.17 Door entry requirements to be confirmed upon receipt of ingress access strategies.

2.18 Head of stair AOV break glass override switch.

2.19 Lobby AOV break glass override switch.

2.20 Final location of equipment and plant shall be coordinated with the mechanical contractor prior to procurement and installation.

2.21 Video entry panel to be mounted on pedestal . Specification and location TBC by archited.

2.22 3 gang grid switch fitted with 20A double pole switches, each switch engraved with the name of the appliance served:-
- Tumble Dryer
- Washing Machine
- Washing Machine

2.23 100x100mm boxing out for cabling to rise from underfloor containment for desk services.

2.24 Power supply for smoke dampers to be wired back to damper control panel within riser. Installation shall be in accordance with smoke control specialist design requirements.

2.25 Switching arrangement within Assembly Hall to be co-ordinated with theatre projects

2.26 Override switch for new and existing lighting circuits

2.27 Luminaire type TBC

2.28 LPA luminaires provide insufficient performance in this area. Client to confirm if alternate lighting shall be provided.

2.29 Magnetic Track Linear & spot lights (refer to LPA drawings for quantities)

FA1 Fire alarm interface for connection to relay base within adjacent apartment for connection to landlords fire alarm system.


FA2 Fire alarm interface for sprinkler flow switch.

FA3 Fire alarm interface for smoke ventilation system.

FA4 Fire alarm interface for connection to BMS and shall provide signal to shutdown all energy centre plant in the event of a fire and shall also be resettable from the fire alarm panel within the fire control centre.

FA5 Gate to open in the event of a fire.

Areas of existing ceilings to be removed and reinstated for services

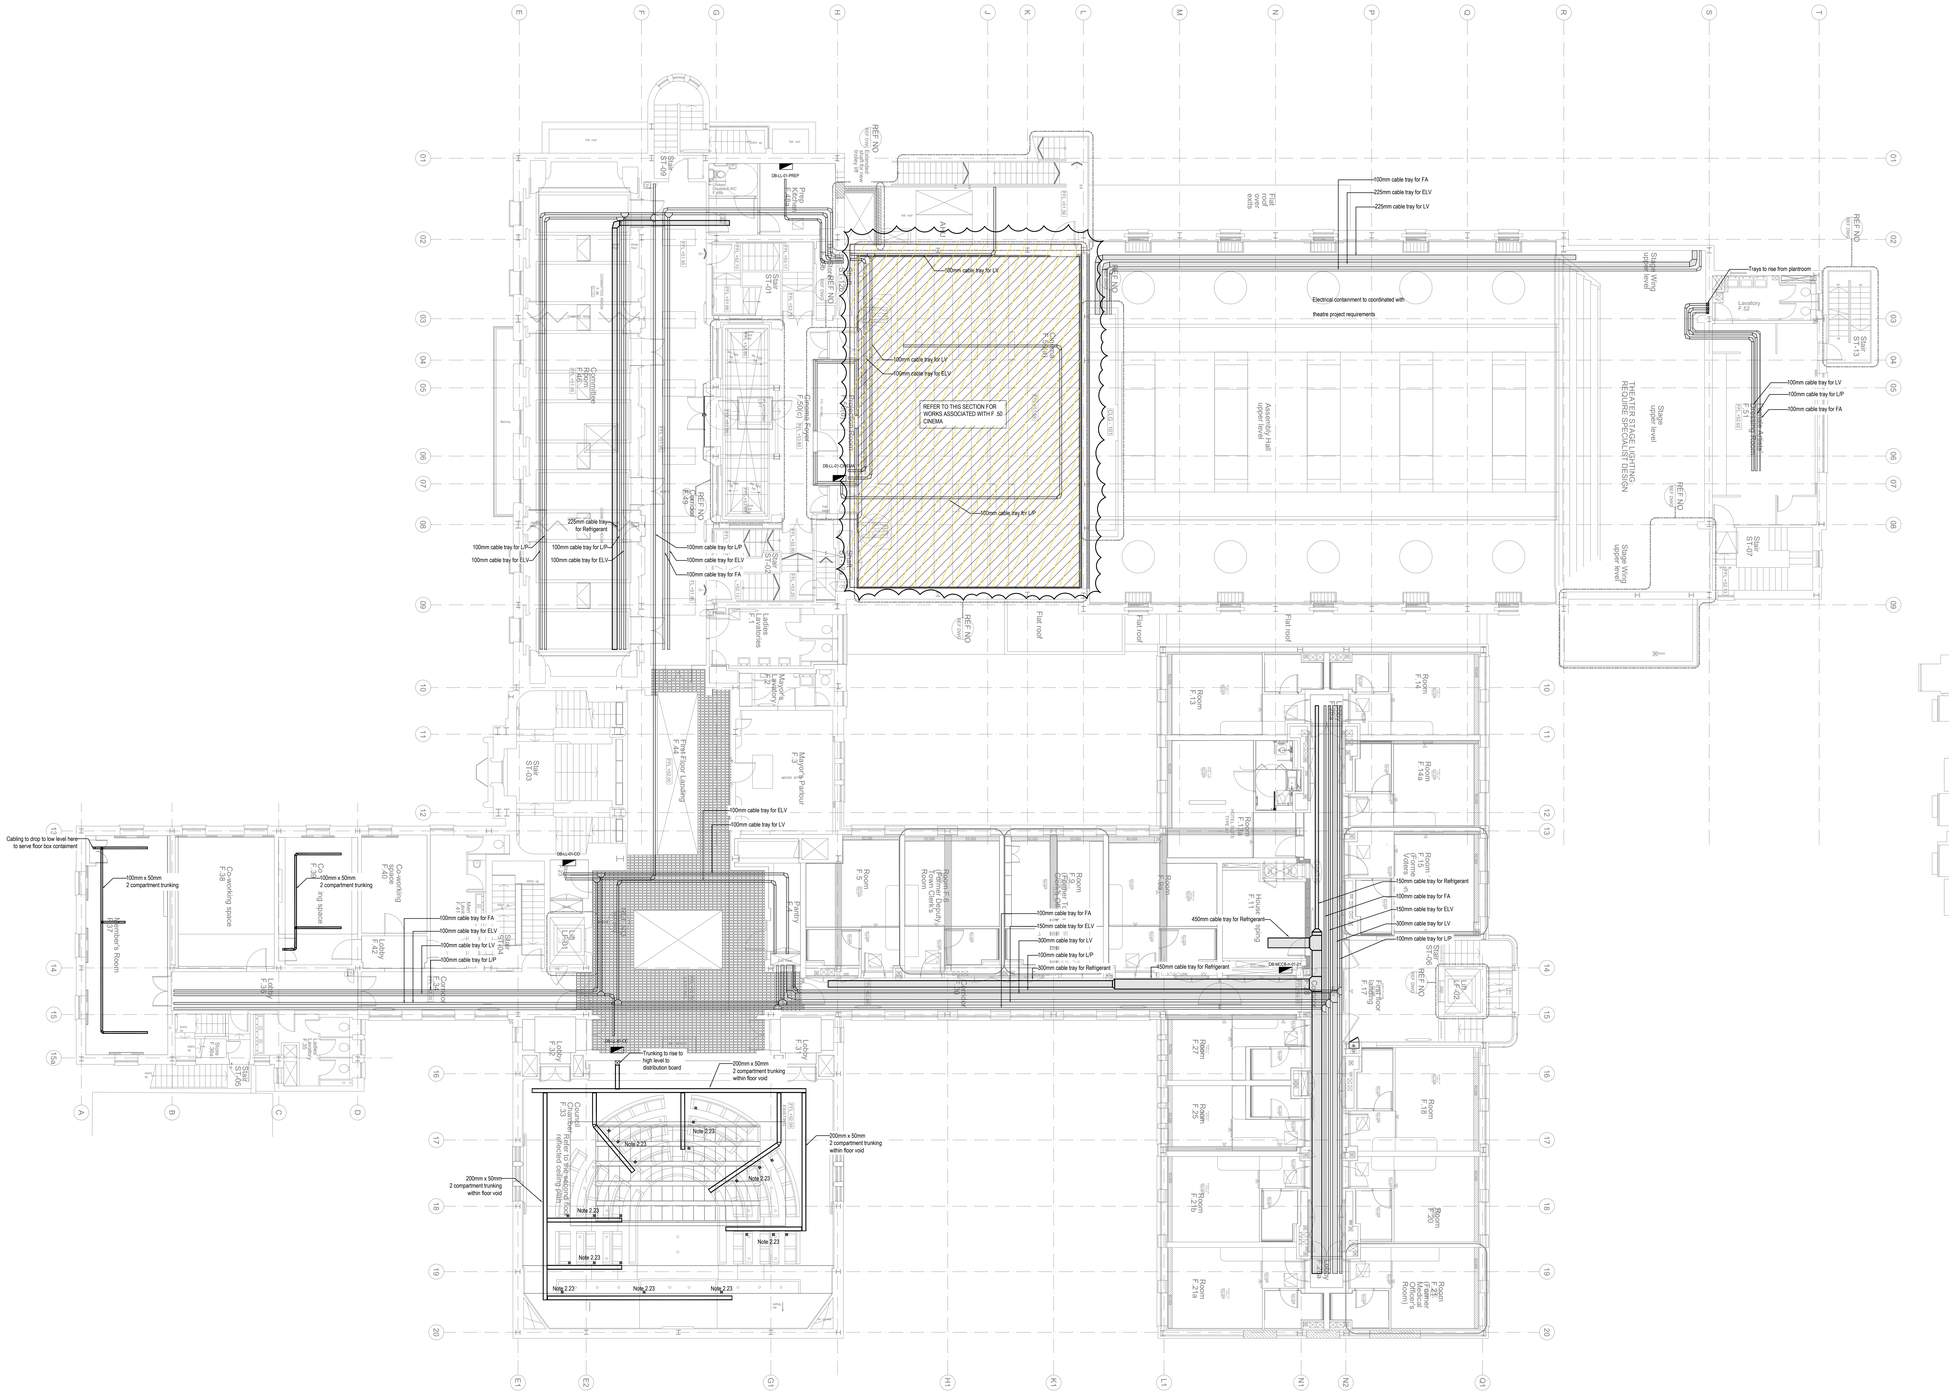

NOTE : B
SERVICE VOIDS TO BE SURVEYED ON SITE PRIOR TO PROCUREMENT AND INSTALLATION TO ENSURE SERVICES CAN BE UNOBSTRUCTED IN SPACE

NOTE : A
DRAWING IS CONSTRUCTION ISSUE PROVIDIONALLY ONLY. EAST WING IS CURRENTLY THE ONLY AREA THAT HAS BEEN FULLY COORDINATED AND DETAILED WITH DESIGN TEAM.

BACKGROUND PLAN AS PER:	KOS ARCHITECTS	
DRAWING No.	REVISION	DATE RECEIVED
3670-KOS-TH-01-DR-A-03-2002	C3	27.08.2021

Rev	Date	Description	Drwn	Chkd
I1	30.11.2022	Issued for information	JH	JM

Current purpose: INFORMATION Scale: 1:100 Size: A0
Original Issue Date: 30.11.2022 Drwn: JH Chkd: JM

Responses to L&P Comments 27.01.2021
1. Please provide co-ordinated sections and details along corridor routes , within rooms. This to verify how access is maintained to all containment. See combined distribution details drawings.
2. Also to verify co-ordination with other services. Mains Power cabling cannot be inverted so cables fall to floor in an escape route under latest Building Regulations. See combined distribution details drawings.
3. Please depict invert levels for each section of containment. See combined distribution details drawings.
4. Containment needs to extend from circuit board and must not stop short with isolated sections shown. This has been updated.
5. Provide a series of drawings demonstrating containment sizing capacity and spare for each section. This does not fall under our scope, schedules are available to assertain amount of cables per tray and spare capacity can be determined from this.
6. Provide fire stopping details. By others.
7. Provide arrangement drawing for each distribution board. Comment not applicable to this drawing.
8. Provide fire stopping details at each bridging section. By others.
9. Provide support installation details. See combined distribution details drawings.
10. Demonstrate how containment concealed from view but fully accessible - All areas. By others

WHITECODE CONSULTING
BUILDING SERVICES DESIGN CONSULTANTS
26-27 The Hill, Northfleet, Gravesend Kent, DA11 9EU
www.whitecode.co.uk
T: 01322 289977 E: design@whitecode.co.uk

Title:
ELECTRICAL SERVICES LAYOUT CONTAINMENT
TOWN HALL FIRST FLOOR
TENANT FIT-OUT ALLOCATION LAYOUTS

Project:
HORNSEY TOWN HALL

Client:
ARDMORE

Dwg Number:
10687-E-02-TH-1101(3)

Rev:
I1

Saved: p:\10687_hornsey town hall\08_format info issue\2022.11.30_information issue town hall\10687-e-02-th-1101(3).dwg