


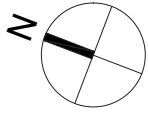


KEY: TOWN HALL FLOOR FINISHES		
Existing finishes	Proposed finishes	
ALT-411	SCR-401	SCR-401: Screed
ALT-415	FL-401	FL-401: Vinyl Sheet Floor Finish
ALT-416	FL-403	FL-403: Linoleum Floor Finish
ALT-429	FL-501	FL-501: Porcelain Tiled Floor Finish
ALT-511	FL-802	FL-802: Timber Flooring
ALT-529	FL-803	FL-803: Timber Flooring
ALT-531	FL-703	FL-703: Porcelain Tiled Floor Finish
ALT-535	FL-704	FL-704: Porcelain Tiled Floor Finish
ALT-541	FL-610	FL-610: Carpet
ALT-538	FL-652	FL-652: Carpet
EXT-811	FL-503	FL-503: Precast Terrazzo Tiles
EXT-810	EXT-145	EXT-145: Timber Decking
	EXT-131	EXT-131: Impermeable Concrete Paving
	EXT-101	EXT-101: Impermeable Concrete Paving
	RFS-201	RFS-201: Mastic Asphalt Cold Roof System



NOTE :
REFER TO KDS DRAWING
3670-KDS-TH-ZZ-DR-A-23-5010
FOR FLOOR BUILD UP DETAILS

KEYPLAN

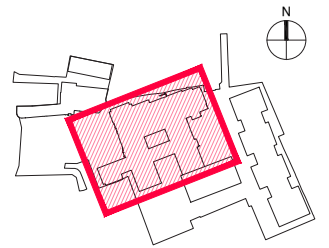

FLOOR FINISHES

REVISION NOTES			
C1	17.05.22	RC	ISSUED FOR CONSTRUCTION
C2	05.07.22	NR	ISSUED FOR CONSTRUCTION



ARDMORE CONSTRUCTION LTD
6 WHARF STUDIOS,
28 WHARF ROAD,
LONDON, N1 7GR
TEL: 0208-344 0300
www.ardmoregroup.co.uk

KDS ASSOCIATES LTD
TECHNICAL • ARCHITECTURAL • MANAGEMENT • CONSULTANTS

101 THE BLACKFRIARS FOUNDRY
158 BLACKFRIARS ROAD
LONDON SE1 8EN
0203 355 0775
www.kdsassociates.co.uk

CONSTRUCTION

© KDS & Associates Ltd

No part of this drawing may be reproduced without written consent.
All contractors must visit site and be responsible for taking and checking all
dimensions relating to this work.
Do not scale from this drawing.

PROJECT / DRAWING TITLE
HORNSEY TOWN HALL
TOWN HALL & BROADWAY ANNEX
LONDON N8 9JJ

DRAWING TITLE
TOWN HALL
GROUND FLOOR PLAN
FLOOR FINISH SCOPING PLAN

DATE / DRAWN BY
13.07.20 JH


SCALE
1:125 @A1

PROJECT / DRAWING NO
3670-KDS-TH-00-DR-A-23-2299

REV
C2



Assembly Hall
Original floor stained and marked,
flooring to be repaired as method
statement ALT-531

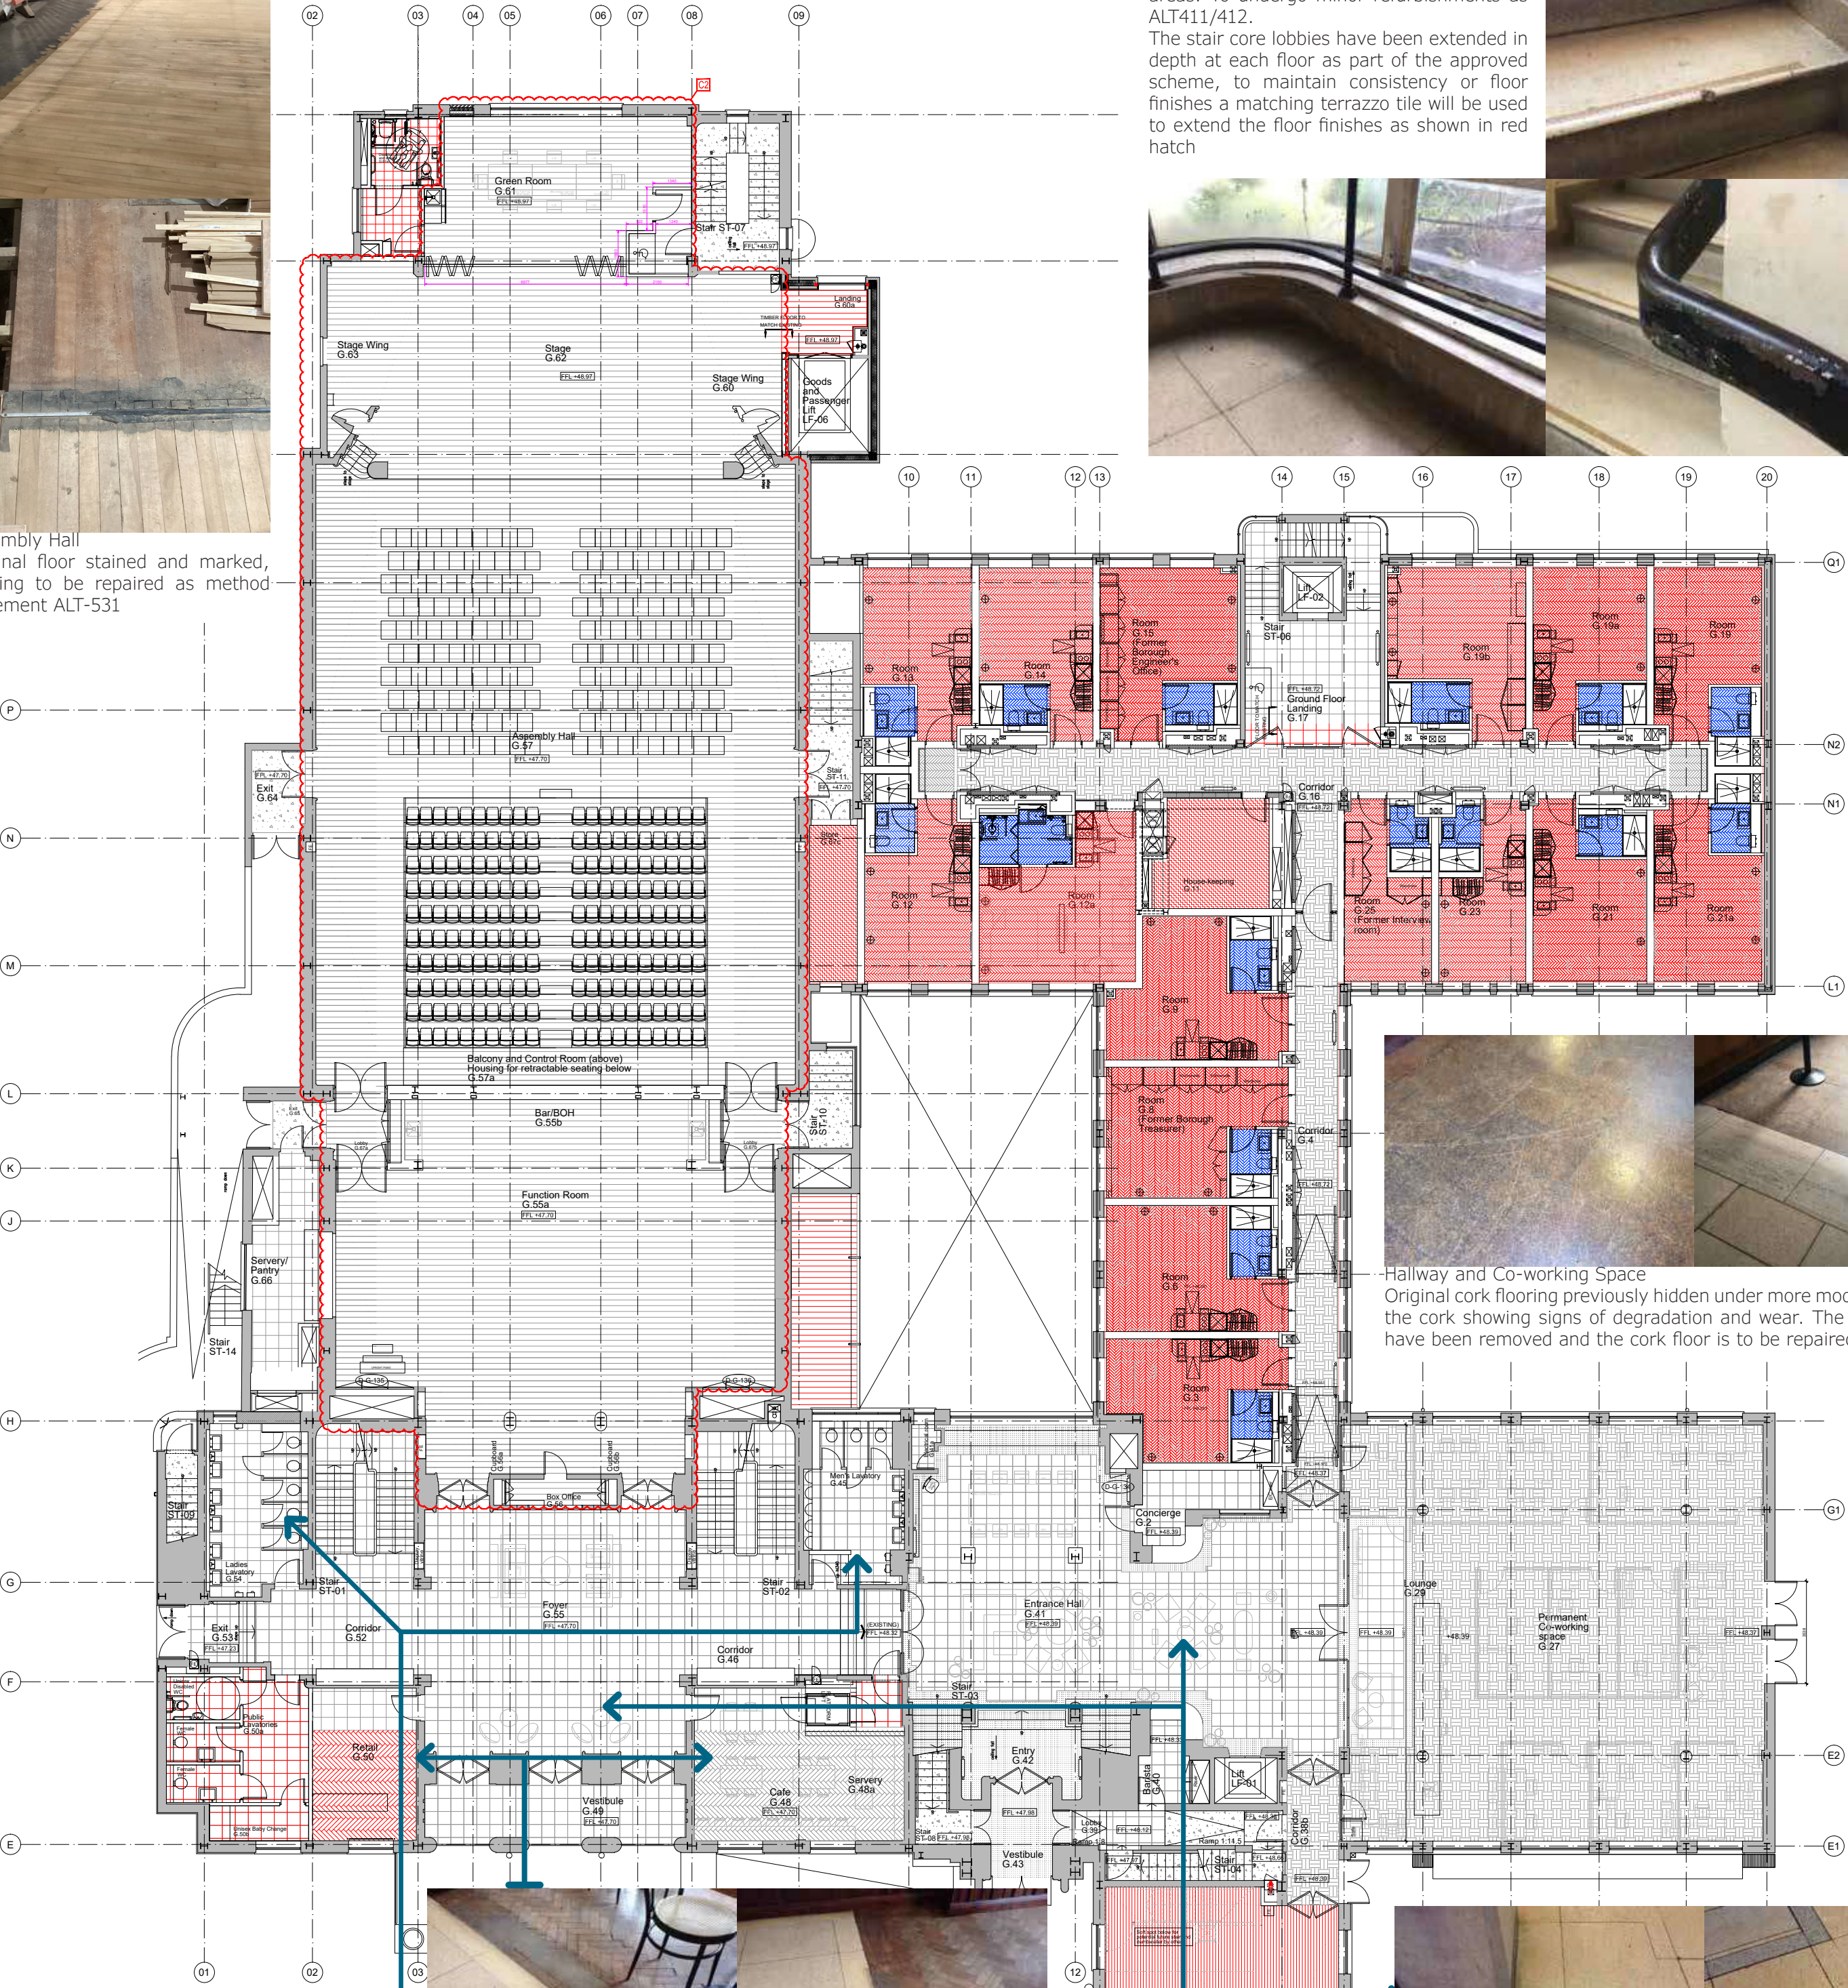

Stair
Existing stair has a terrazzo floor finish
which shows cracks in various locations
and Stair nosings damaged in localised
areas. To undergo minor refurbishments as
ALT411/412.
The stair core lobbies have been extended in
depth at each floor as part of the approved
scheme, to maintain consistency of floor
finishes a matching terrazzo tile will be used
to extend the floor finishes as shown in red
hatch



Hallway and Co-working Space
Original cork flooring previously hidden under more modern coverings with
the cork showing signs of degradation and wear. The modern coverings
have been removed and the cork floor is to be repaired as ALT-511



Cafe and Retail
The lobby terrazzo floors run into the cafe and new retail area (formerly the Ladies Cloakroom), which is bordered with original herringbone flooring, within the new retail space, similarly to the lobbies the terrazzo shows mostly light damage with hairline cracks, light repairs are required as method statement ALT-411 and ALT-412. The existing timber is also heavily worn and scratched, this is to be refurbished as method statement ALT-538.



Lavatories
Terrazzo floors run into the lavatories, similar to the entrance's damage is mostly minor cracking, with scratches notable from cubicle doors. Light repairs are required as method statement ALT-411 and ALT-412



Entrance Foyers
Both the entrance foyer and hall have terrazzo flooring with the foyer using a mixture of pale blue and cream tiles. Localised areas contain mostly hairline cracks with some tiles showing larger sections of damage. (The cracks are to be repaired and any tile beyond repair is to be replaced with a like-for-like finish as method statement ALT-411 and ALT-412

KEY: TOWN HALL FLOOR FINISHES		
Existing finishes	Proposed finishes	
ALT-411	SCR-401	SCR-401: Screed
ALT-415	FL-401	FL-401: Vinyl Sheet Floor Finish
ALT-416	FL-403	FL-403: Linoleum Floor Finish
ALT-429	FL-501	FL-501: Porcelain Tiled Floor Finish
ALT-511	FL-802	FL-802: Timber Flooring
ALT-529	FL-803	FL-803: Timber Flooring
ALT-531	FL-703	FL-703: Porcelain Tiled Floor Finish
ALT-535	FL-704	FL-704: Porcelain Tiled Floor Finish
ALT-541	FL-610	FL-610: Carpet
ALT-538	FL-652	FL-652: Carpet
	FL-503	FL-503: Precast Terrazzo Tiles
EXT-811	EXT-145	EXT-145: Timber Decking
EXT-810	EXT-131	EXT-131: Impermeable Concrete Paving
	EXT-101	EXT-101: Impermeable Concrete Paving
	RFS-201	RFS-201: Mastic Asphalt Cold Roof System

FLOOR BUILD-UP TYPES

REVISION NOTES		
C1	17.05.22	RC ISSUED FOR CONSTRUCTION
C2	01.09.22	RC DRAWING REVISED AS CLOUDED, FLOORING HATCH UPDATED IN REGARDS KEY EXISTING FINISHES



CONSTRUCTION

© KDS & Associates Ltd
No part of this drawing may be reproduced without written consent.
All contractors must visit site and be responsible for taking and checking all dimensions relating to this work.
Do not scale from this drawing.

PROJECT / DRAWING TITLE HORNSEY TOWN HALL TOWN HALL & BROADWAY ANNEX LONDON N8 9JJ		
DRAWING TITLE TOWN HALL GROUND FLOOR PLAN FLOOR FINISH SCOPING PLAN		
DATE / DRAWN BY 13.07.20 JH	SCALE 1:125 @A1	REV C2
PROJECT / DRAWING NO 3670-KDS-TH-00-DR-A-23-2300		

