

Approved Scheme Drawing  
LLA Mark up highlighting cycle store locations



- REVISIONS:
- 1 Minor layout changes to Block A & B
  - 2 Entrance sequence to Block B improved
  - 3 Improvements made to pedestrian routes and North South vehicular route
  - 4 Improvements made to Town Hall Square landscaping
  - 5 Escape stair introduced
  - 6 Landscape treatment to UKPN improved

- General Notes
1. Dimensions are in millimetres unless stated otherwise.
  2. Levels are in metres AOD unless stated otherwise.
  3. Dimensions govern. Do not scale off drawing.
  4. All dimensions to be verified on site before proceeding.
  5. All discrepancies to be notified in writing to Make Limited.
- © Make Limited 2015

KEY

--- Development boundary

|     |          |                  |     |
|-----|----------|------------------|-----|
| 03  | 17/10/17 | For Planning     | EB  |
| 02  | 16/10/17 | For Planning     | EB  |
| 01  | 24/08/17 | For Planning     | EB  |
| 00  | 21/07/17 | For Planning     | EB  |
| Rev | Date     | Reason For Issue | Chk |

FOR PLANNING

DRAWING STATUS


**make**

32 Cleveland Street,  
London, W1T 4JY

tel +44 (0) 20 7636 5151

info@makearchitects.com  
www.makearchitects.com

Client  
Far East Consortium International Limited  
Ground Floor, 12 Stanhope Gate  
London  
W1K 1AW

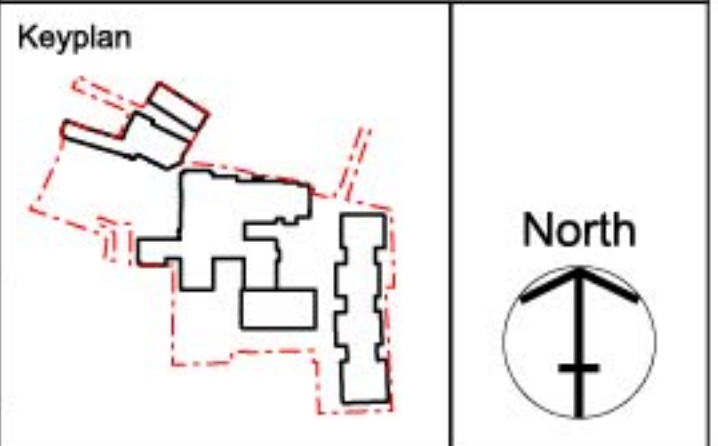

Project  
Hornsey Town Hall

Drawing Title  
Hornsey Town Hall  
Proposed Site Plan  
Ground

Scale  
1: 200

Paper Size  
@A0

Date  
21.07.17

Project No.  
1360

Draw No.  
PX2000

Rev No.  
03

