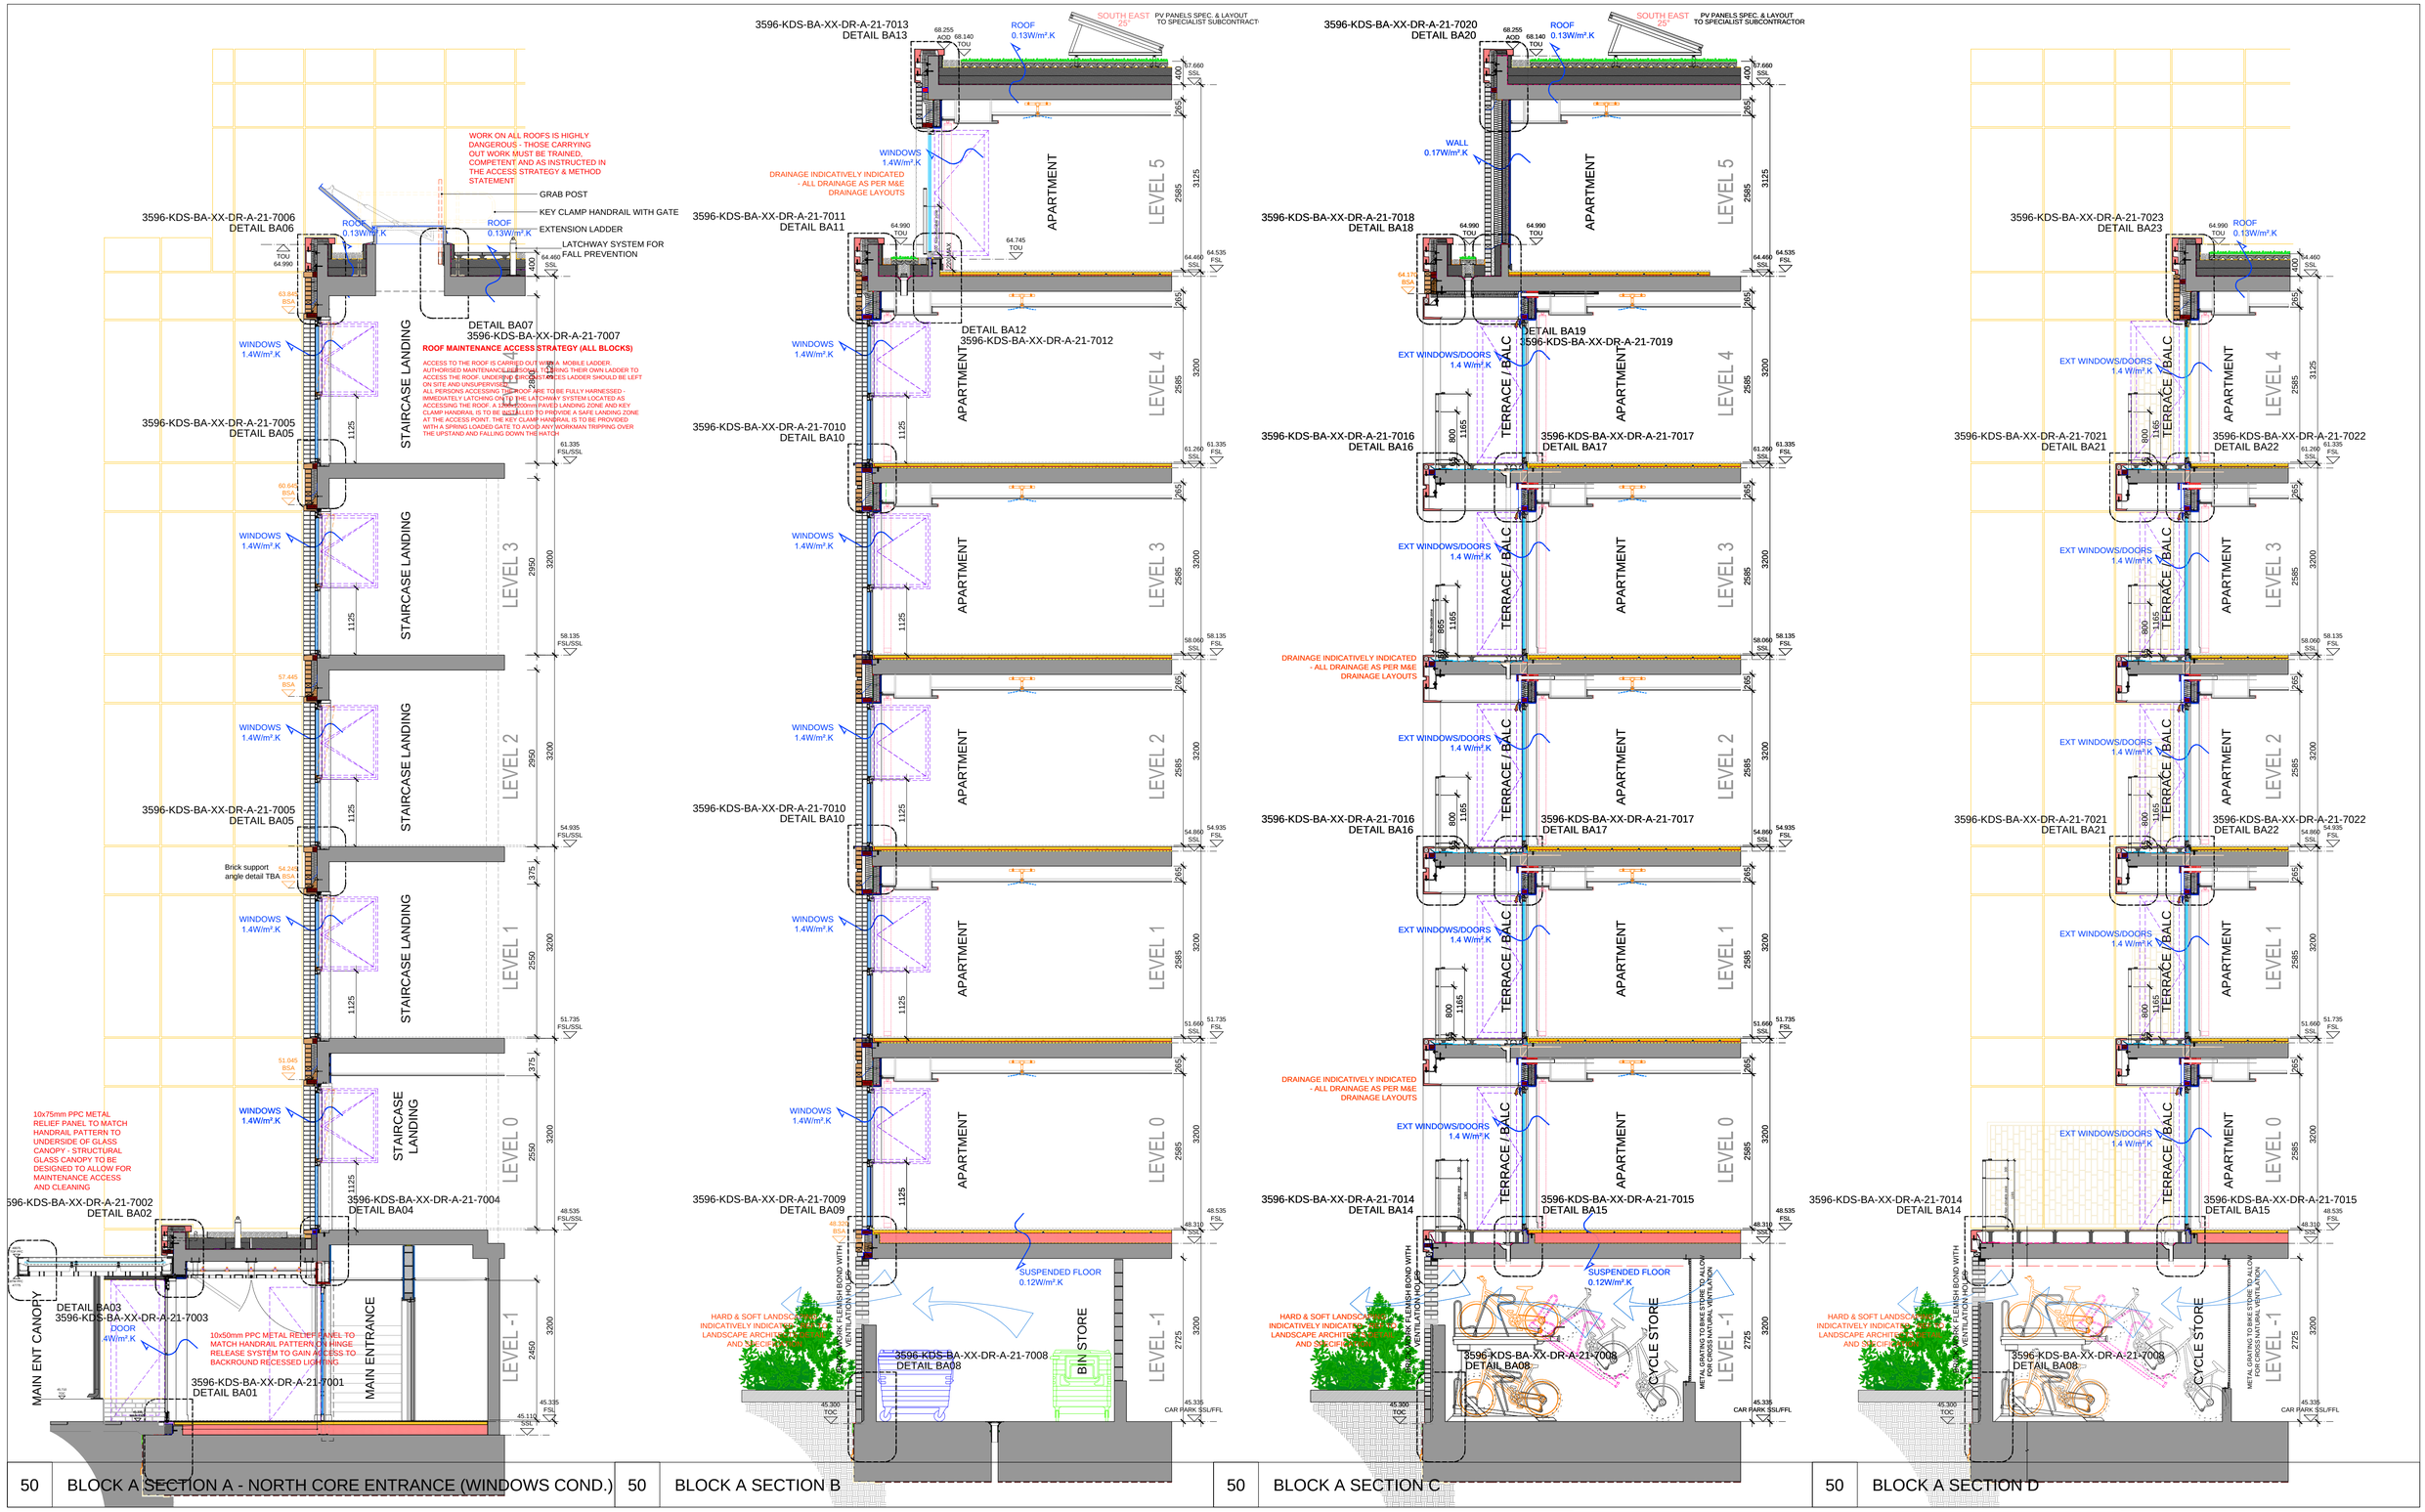

REVISION NOTES

C01	191211	JK	CONSTRUCTION ISSUE. SECTION A EXTERNAL WALL AMENDED WHERE CLOUDED IN RED
WIP	200203	FF	BSA LEVEL AMENDMENT
C02	200309	JK	WATERPROOFING & LATEST PART B AMENDMENTS
C03	200707	JK	AMENDMENTS AS PER CLIENTS INSTRUCTION
C04	220721	FF	LAST CONSTRUCTION ISSUE FOR AS BUILT PURPOSES

REF TO DWG 3596-KDS-BA-XX-DR-A-21-2000 FOR SECTION KEY PLAN

AS BUILT

KDS ASSOCIATES LTD
TECHNICAL ● ARCHITECTURAL ● MANAGEMENT ● CONSULTANTS
101 THE BLACKFRIARS FOUNDRY
156 BLACKFRIARS ROAD
LONDON SE1 8EN
0203 355 0775
www.kdsassociates.co.uk

© KDS & Associates Ltd
No part of this drawing may be reproduced without written consent.
All contractors must visit site and be responsible for taking and checking all dimensions relating to this work.
Do not scale from this drawing.

PROJECT / DRAWING TITLE
HORNSEY TOWN HALL
NEW RESIDENTIAL BUILDINGS

DRAWING TITLE
BLOCK A
STRIP SECTIONS
A / B / C / D

DATE / DRAWN BY: 1709 JUAN

SCALE: 1:50 @A1

PROJECT / DRAWING NO: 3596-KDS-BA-XX-DR-A-21-2001

REV: C04