


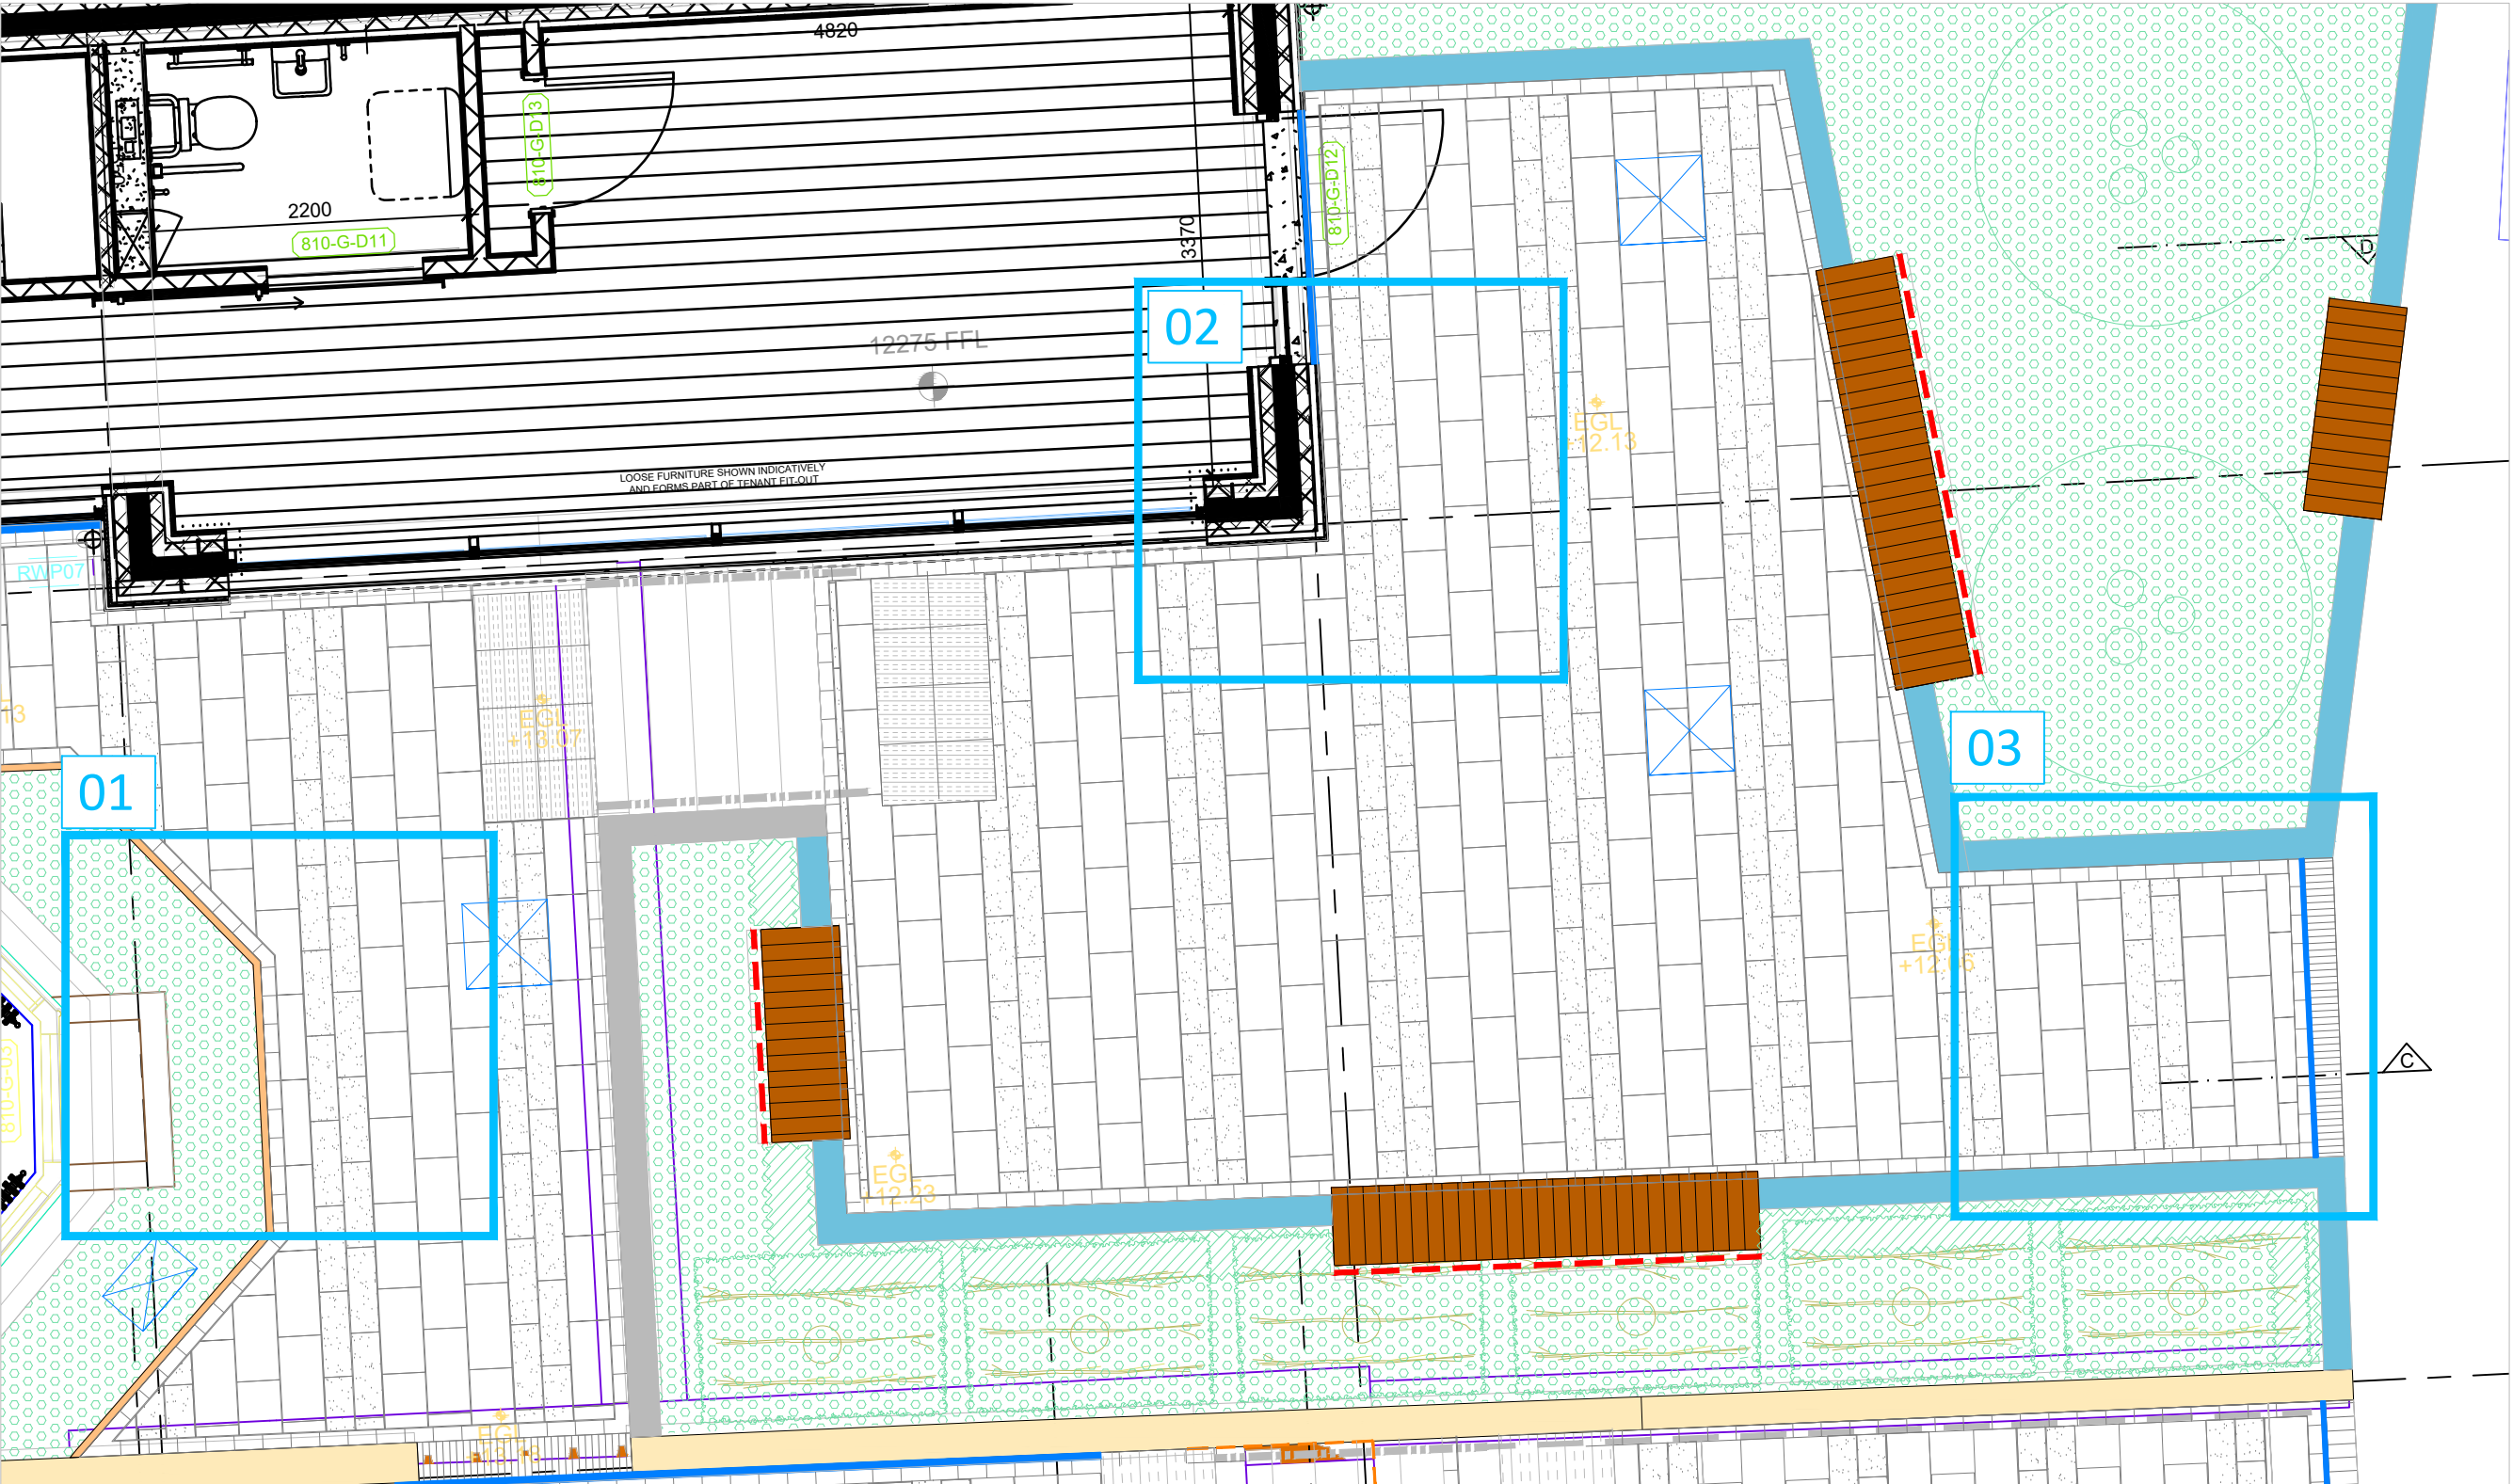

Location Plan
Scale 1:50

Key

01 Paving

01a Natural Stone Paving type 1
Dims: 600(l)x300(w)x50(d) mm
Staggered bond.
Product: Elland Edge
Supplier: Tectonix
Spec ref: Q25/310A

01b Natural Stone Paving type 2
Dims: 600(l)x200(w)x50(d) mm
Staggered bond.
Product: Elland Edge
Supplier: Tectonix
Spec ref: Q25/310B

01d Natural Stone Paving type 3
Dims: 100(w)x200(d) mm x length varies refer to details 8002/05 and 8002/06
Soldier bond
Product: Elland Edge
Supplier: Tectonix
Spec ref: Q25/310D

01e Single Running Course
Natural Stone paving
Dims: 200(l)x100(w)x100(d) mm
Product: Elland Edge
Supplier: Tectonix
Spec ref: Q25/310C

01f Sub base and irrigation crate system to Tisserin Engineer's design and specification.

01g Foundation and structural details to Tisserin Engineer's design and specification.

01h Porous jointing and bedding for Natural Stone: by Steintech or similar approved. Exact specification to be confirmed.

Note: Linework and hatches for bedding, base and sub-bases are indicative and to engineers' specification and drawings.

02 Edges, Walls and Steps

02a Proposed Wall type 1
Dims: 215(w)mm
Flemish bond with header and interpretation branding at the opening
Product: re-claimed brick from site
Refer to drwg: 0960-RFM-XX-00-DR-L-8009/8010
Spec ref: F10/231

02b Drainage
Dims: MD100
to Tisserin's details
Spec ref: Q10/170

02c Proposed Wall type 2
with interpretation branding
Dims: as shown
Product: re-claimed brick from site
Refer to drwg: 0960-RFM-XX-00-DR-L-8002
Spec ref: F10/231

03 Furniture and Features

03a Seating type 1
Top mounted with backrest and armrest
Dims: 1500/3000(l)x500(w) mm
Product: Integrated Planter Benches
Supplier: Woodscape or similar approved
Refer to drwg: 0960-RFM-XX-00-DR-L-8005/8007
Spec ref: Q50/225A

03b Raised Planter type 1 (brick walls)
Dims: 215/440(w)mm
Product: re-claimed brick from site or similar approved
Refer to drwg: 0960-RFM-XX-00-DR-L-8005/8007
Spec ref: F10/233

03c Raised Planter type 2
Dims: as shown
Product: Integrated Planter Walls
Supplier: Woodscape or similar approved
Refer to drwg: 0960-RFM-XX-00-DR-L-8007
Spec ref: Q50/227

03e Picnic Table Set
Dims: 1650(l)x1650(w)x725(h)mm
Product: TBC Client fit out item.
Supplier: TBC Client fit out item.
Spec ref: Q50/220A

04 Planting

04a Proposed Ornamental Planting Mix
Refer to drwg: 0960-RFM-XX-00-DR-L-0004
Spec ref: see Section Q31

04b Proposed Hedge
Refer to drwg: 0960-RFM-XX-00-DR-L-0004
Spec ref: see Section Q31

05 Growing Medium and Planting Build up

05a Bark mulch, 50mm depth or mulch mat
Spec ref: see Section Q28

Topsoil - to BS 3882:2015


05b Top soil to tree, hedge and ornamental planting. 300mm depth topsoil to be tested by a suitably qualified soil scientist in accordance with BS3882 2007
Spec ref: see Section Q28

Subsoil - to BS 8601:2013


05c Subsoil to shrub and hedge planting. Depth 300mm
Spec ref: see Section Q28

Notes


- All dimensions in mm, unless otherwise stated.
- Scaling from drawing if printed incorrectly may lead to errors.
- All information outside red line boundary shown for contextual purpose only.
- All hatch patterns are indicative only unless stated otherwise.
- This drawing is to be read in conjunction with the re-form landscape architecture drawings and specification, F3 Architect's drawings and specification, the Tisserin drawings and specification (civils, drainage and structural proposals) and the Integration UK drawings and specification (Electrical), AND all relevant documentation from the design and project team
- Levels information on this drawing illustrates the design intent. The contractor is to check and verify all levels and dimensions against site survey information.
- Any discrepancies in the design information are to be brought to the attention of re-form landscape architecture, in writing, prior to commencement of construction works.
- All proprietary products shall be installed in strict accordance with manufacturers written instructions.
- Refer to other consultants' drawings and specifications for the following design information:
 - Foundation details
 - Base course and/or sub bases design & specification
 - Waterproofing of any element
 - Levels & Drainage design and infrastructure
 - Lighting and ducting
 - Existing & proposed utilities
- Plant quantities are to suit site areas in accordance with scheduled plant densities.
- Any proposed plant substitution shall be agreed with the landscape architect prior to ordering.
- Drainage system and paving build ups above the roof to Tisserin's design; specialist contractor required notably for the waterproofing layer, which must not be compromised by the contractor carrying out the landscape works.

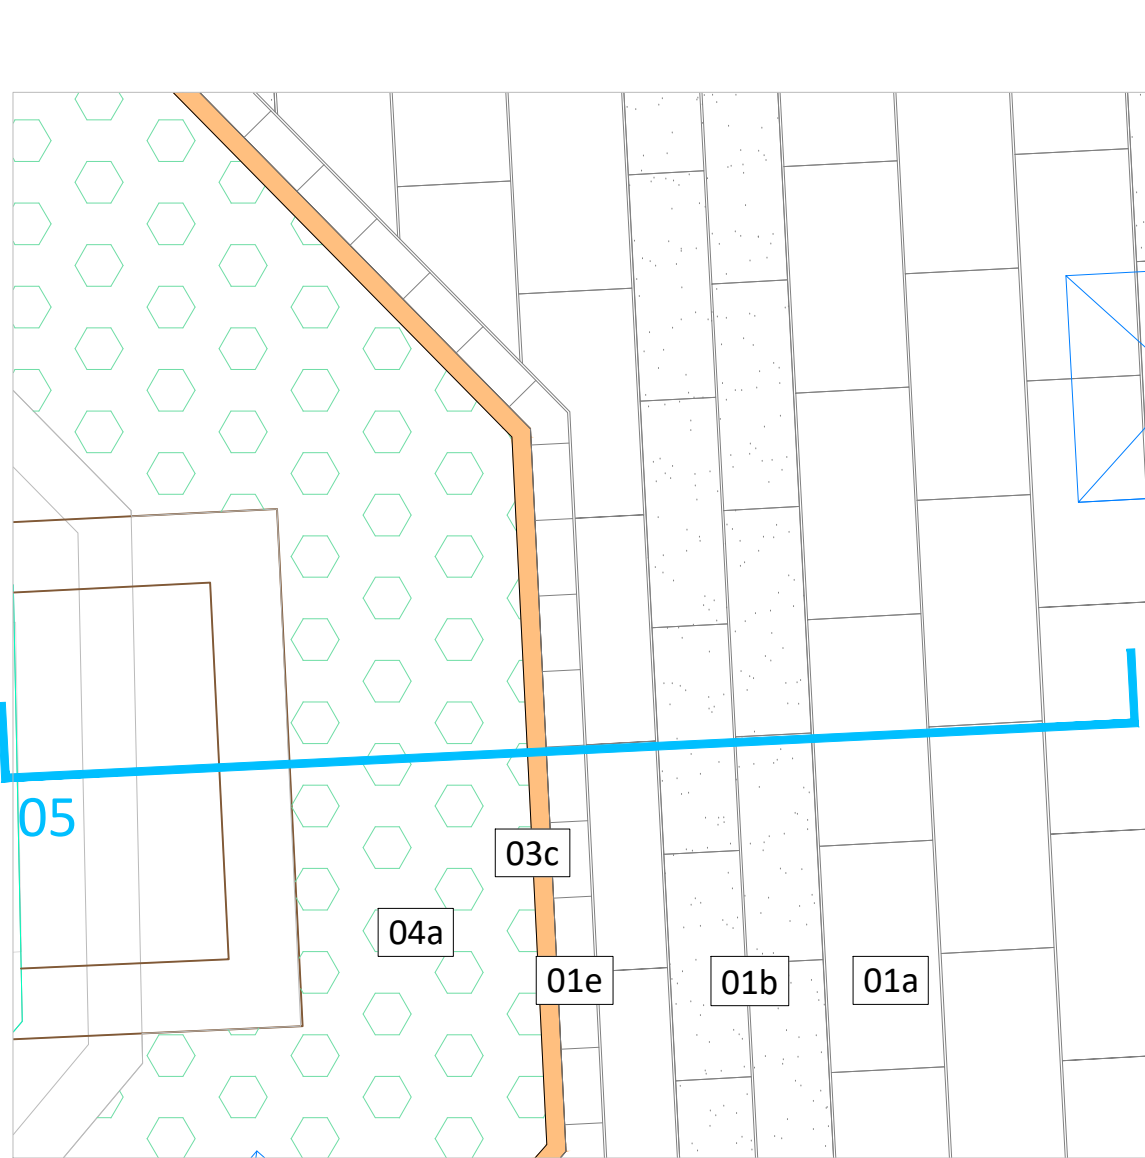

8001
01 Plan: paving detail to planter 1:20

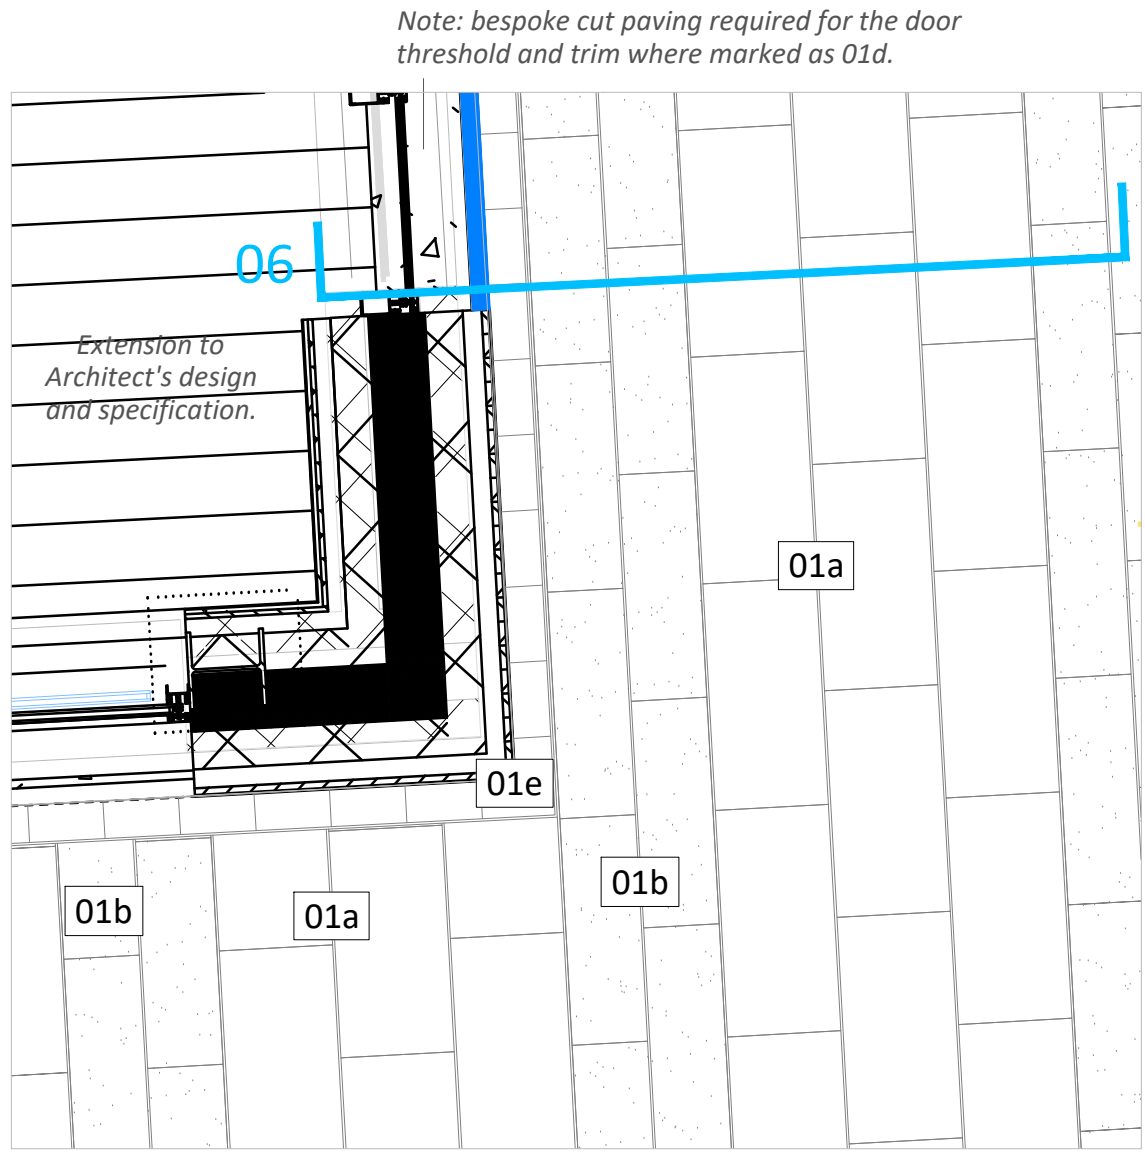


8001
02 Plan: paving detail surrounding new extension 1:20

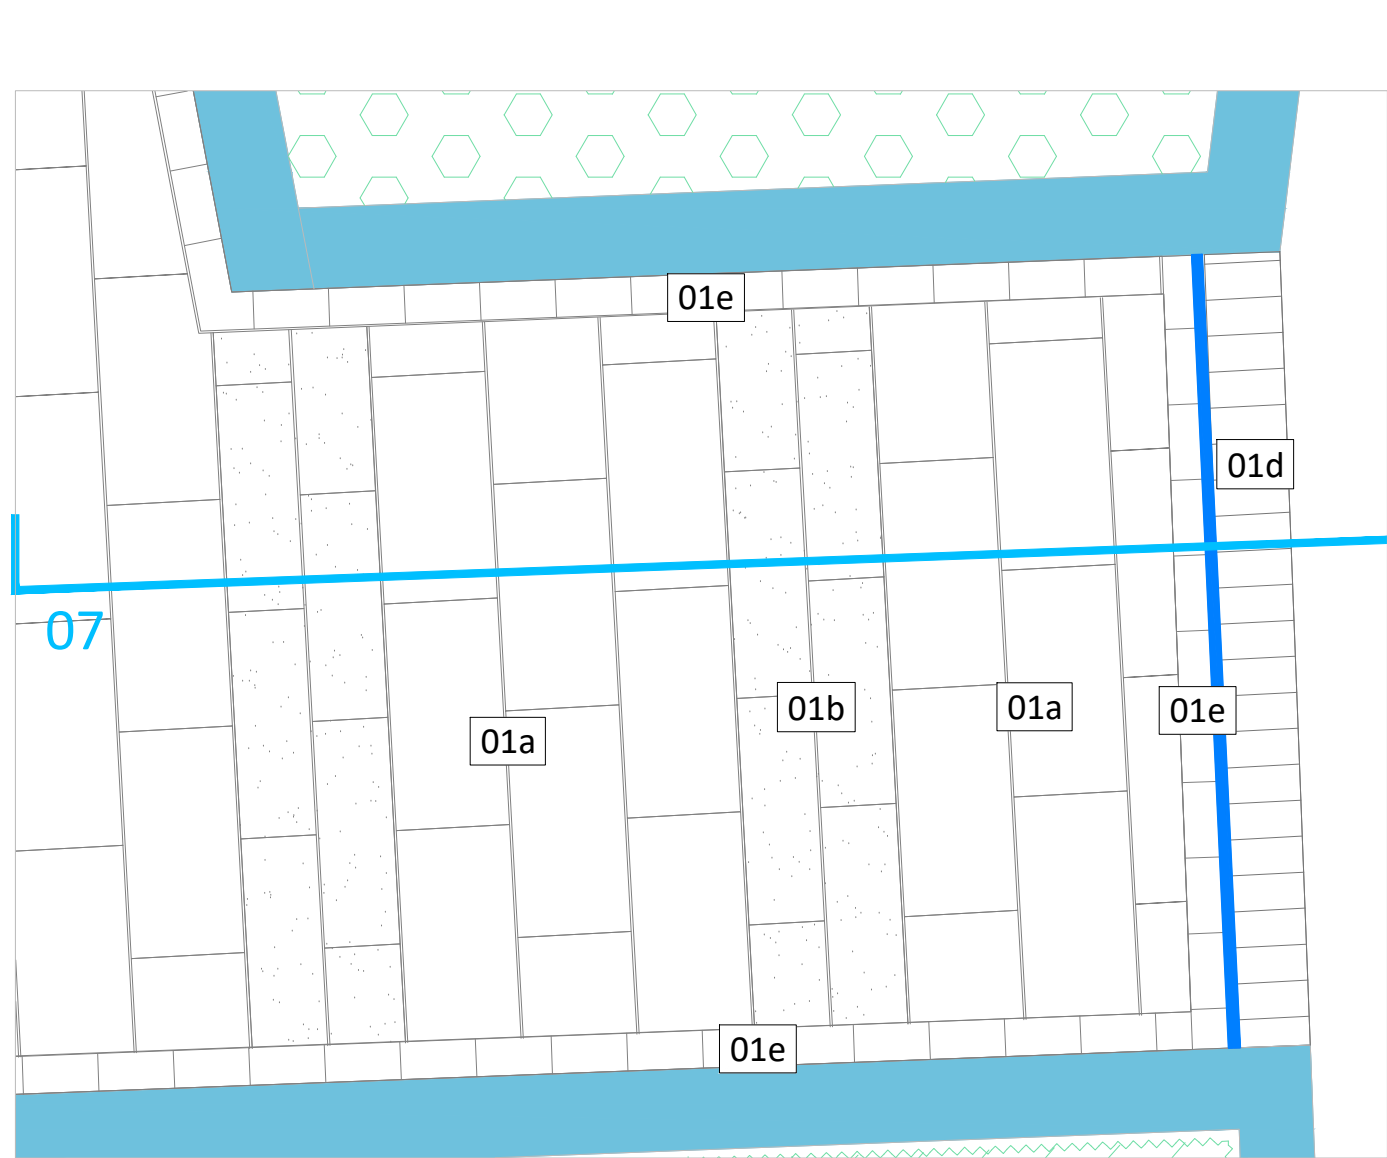




8001
03 Plan: paving detail at rear entrance 1:20

Note: hoarding line will be in place and Paving 01d will mark extents of new paving. Future works to be undertaken east of this area as part of a separate scheme.

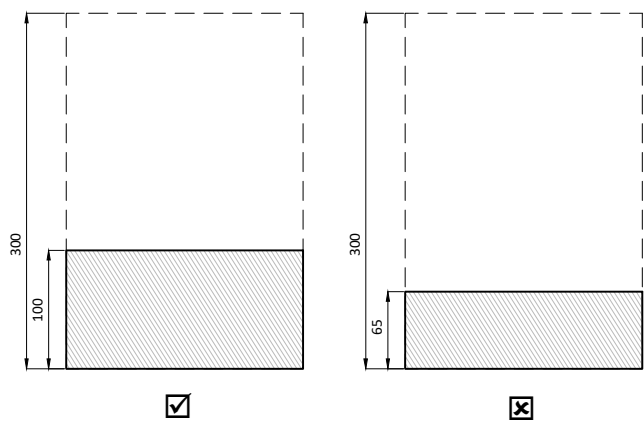


NOTE A (1:5): Pavers should not be cut to less than 1/3 of the length to avoid breakage and insecure laying.


Joints to be adjusted to suit within +2mm tolerance from as far back as necessary to ensure compliance

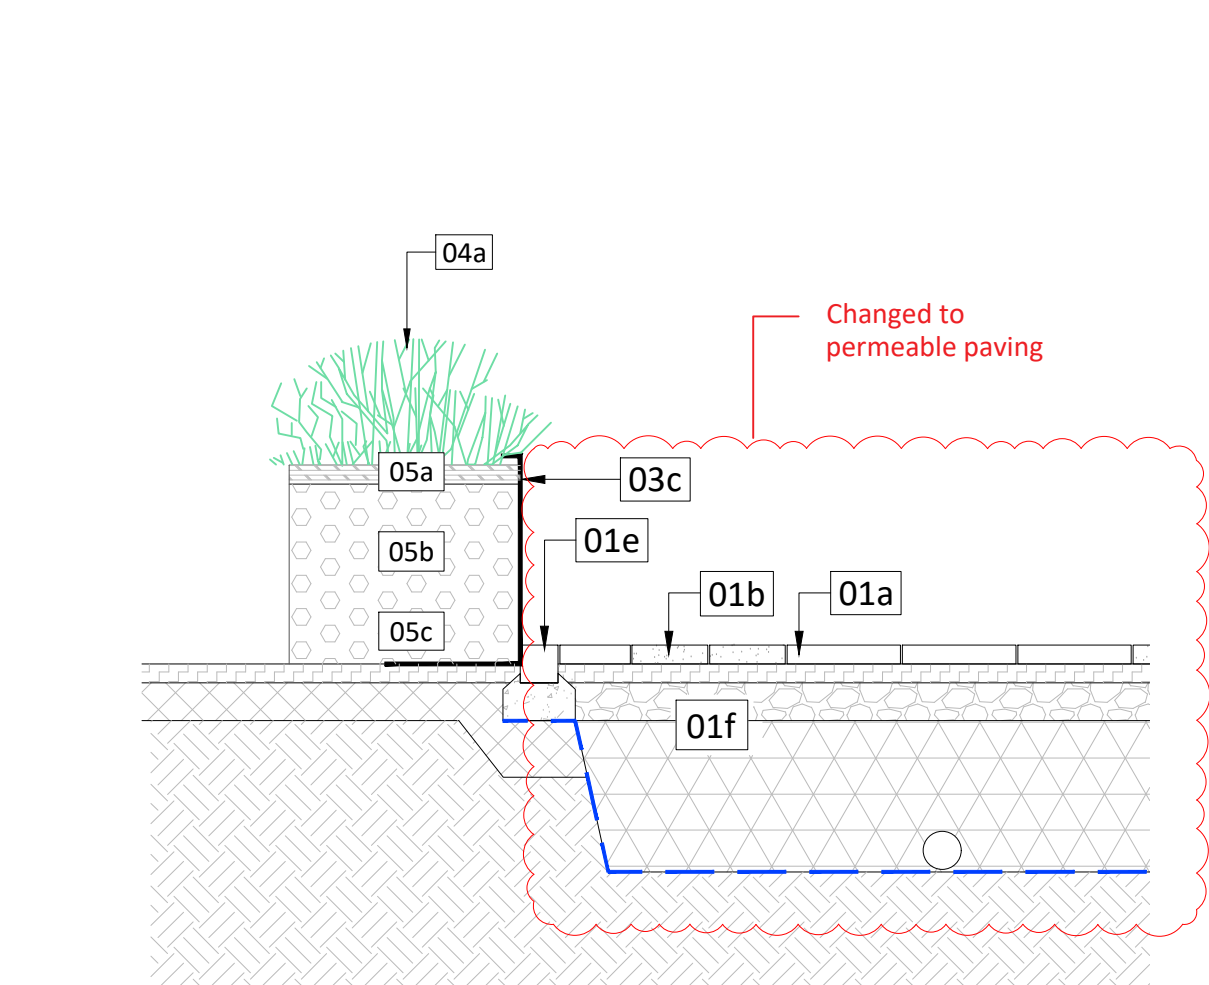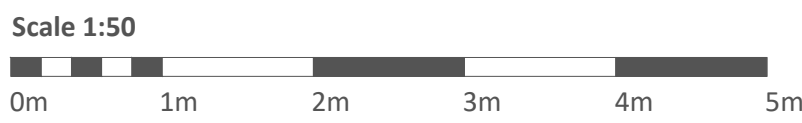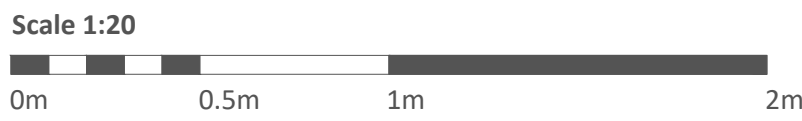

8001
05 Section for Plan 1: typical paving detail to planter 1:20

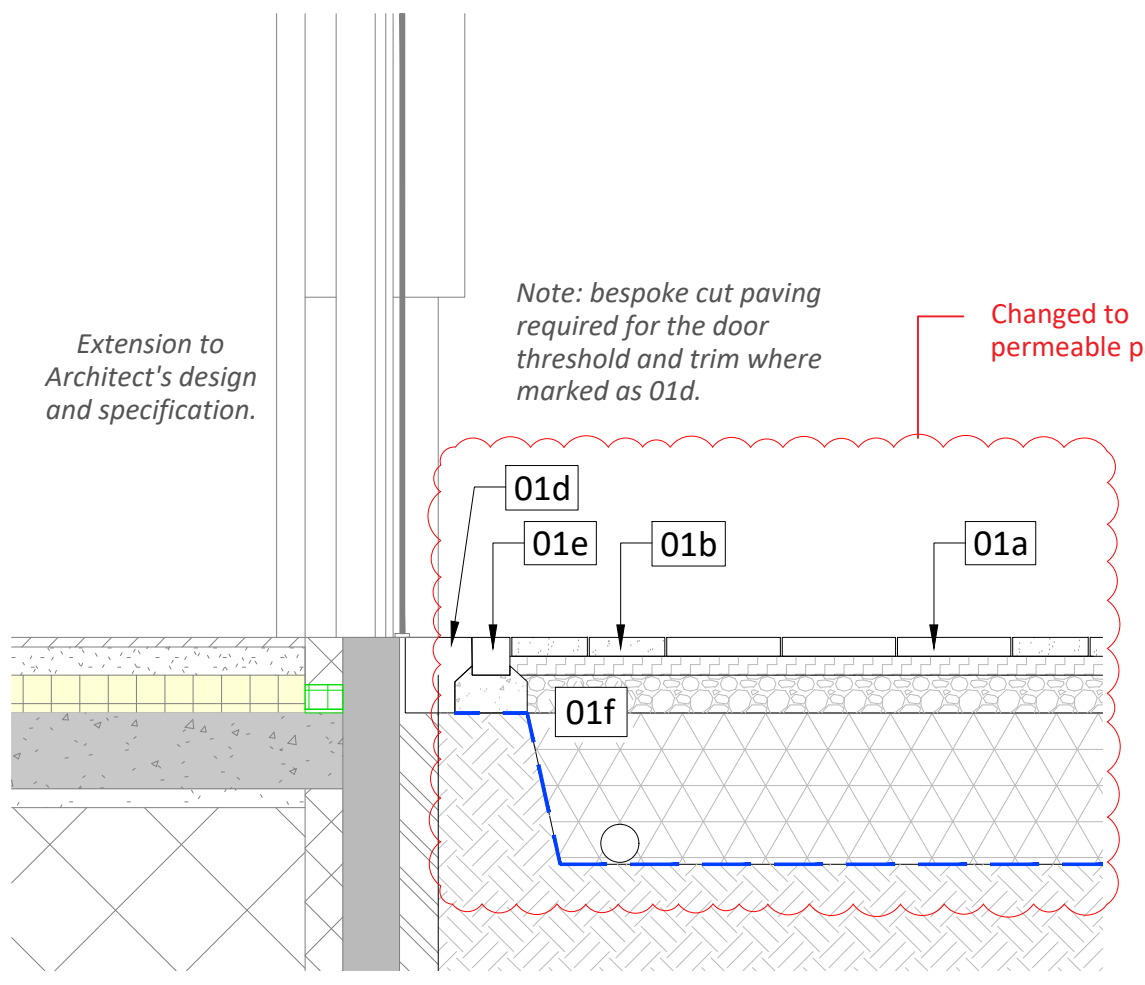

8001
06 Section for Plan 2: paving detail surrounding new extension 1:20

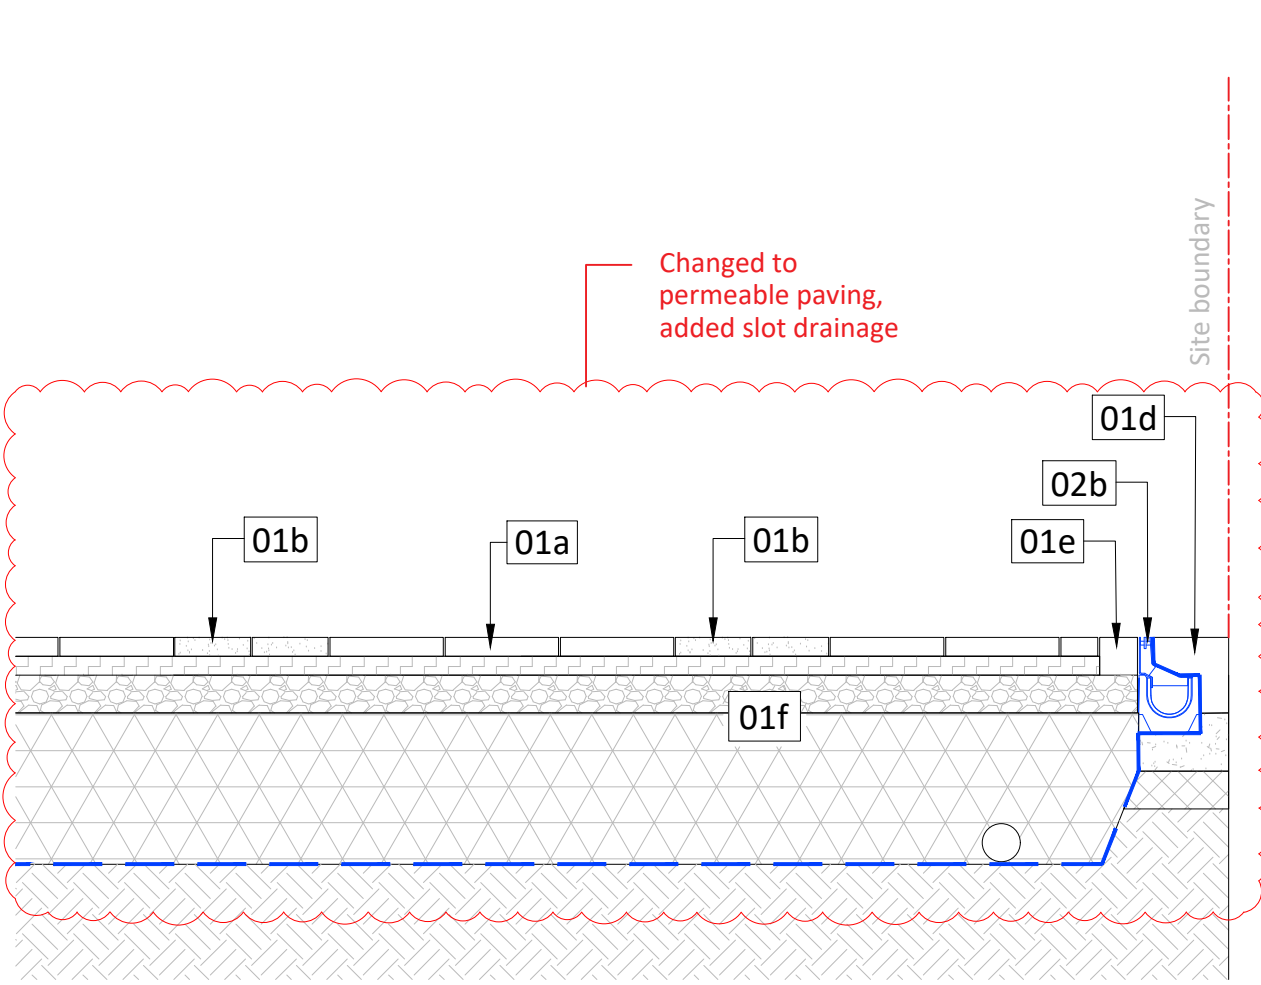

8001
07 Section for Plan 3: paving detail at rear entrance 1:20

Date	Description of revision	VC Drawn by	TD Checked by	DL Approved by	C02 Revision
03.04.25	Changed to permeable paving, added slot drainage				

re-form
landscape architecture

Beehive Mill, Jersey Street,
Manchester M4 6JG
T: +44 (0)161 397 4953
E: info@re-formlandscape.com
W: re-formlandscape.com

Project
808-810 HIGH ROAD, TOTTENHAM
RF22-960

Client
TOTTENHAM HOTSPUR

Document title
PAVING DETAILS - SHEET 1 OF 2

Paper size
A1
Status
APPROVED AS STAGE COMPLETE

Drawing number
0960-RFM-XX-00-DR-L-8001

© re-form landscape architecture

Scale
AS
SHOWN

A4

Revision
C02