


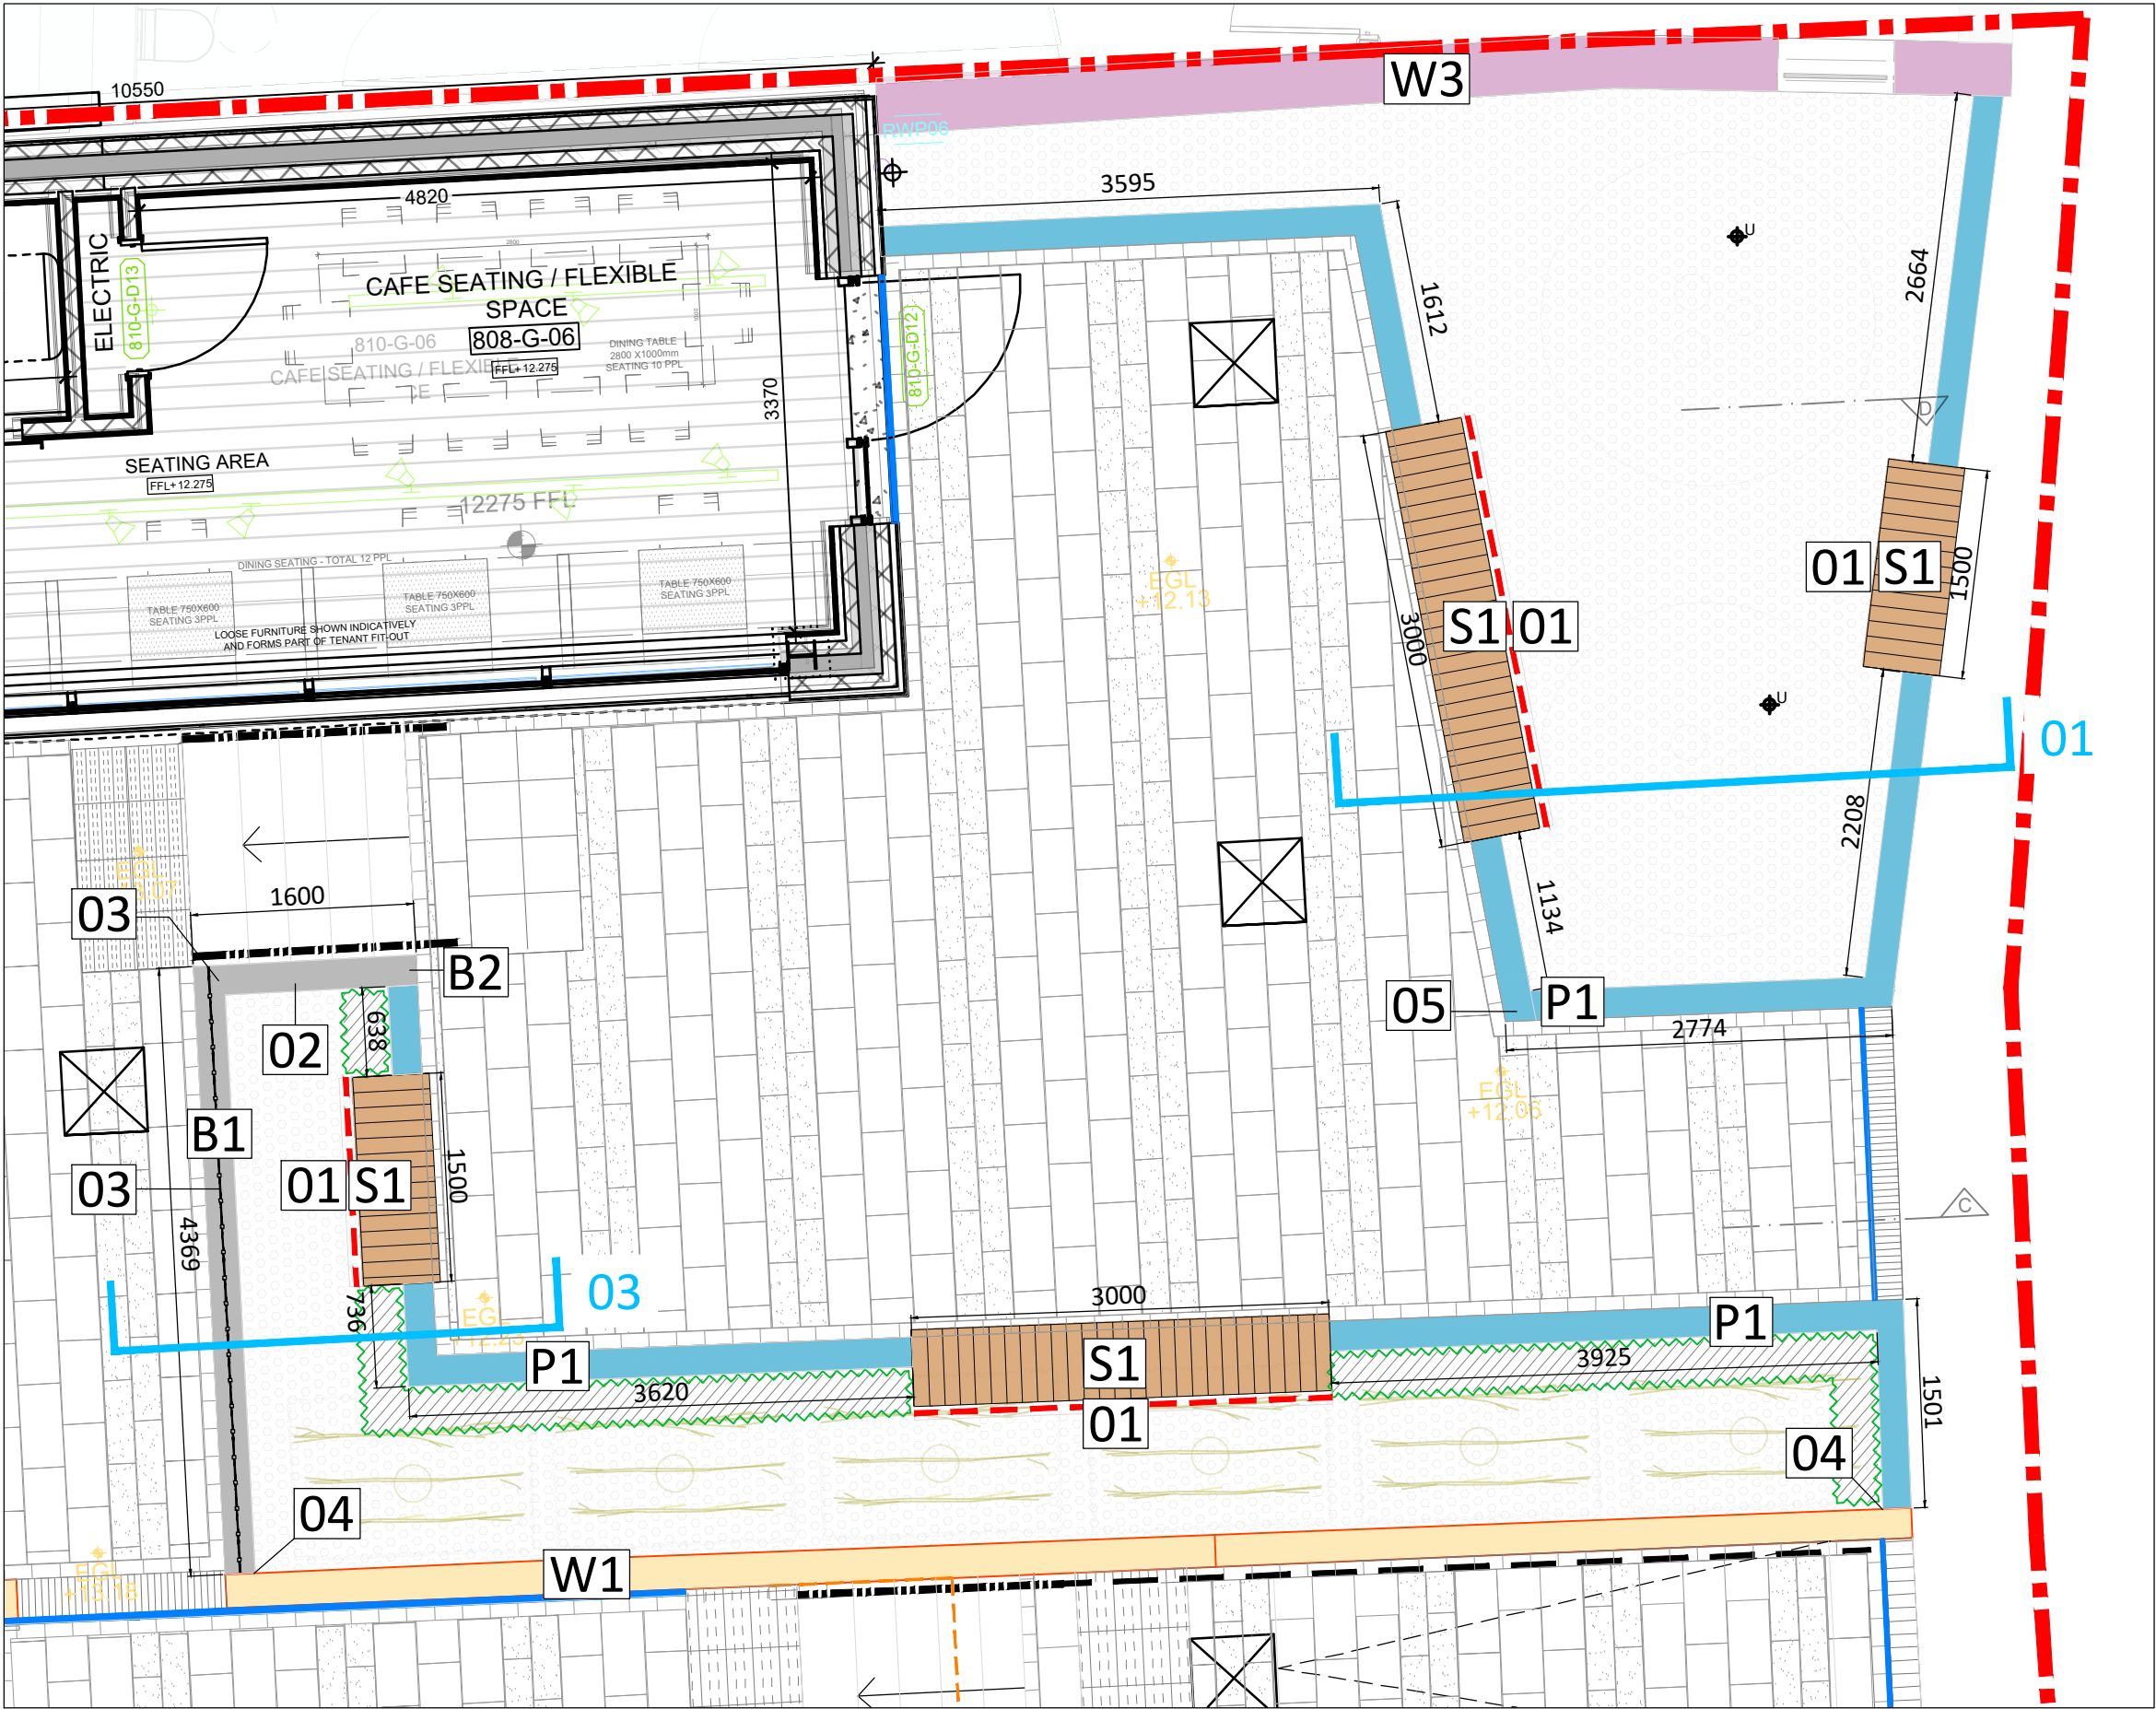

Location Plan
Scale 1:50

Scale 1:50

0m 1m 2m 3m 4m 5m

N


KEY
Note: refer to Overview Plan and Detail drawings for a key with full information on the proposals.

Edges, Walls and Steps

- W1** Proposed Wall type 1 (historic)
Dims: 215(w)mm
Flemish bond with header
- W3** Existing Wall to be retained
- B1** Proposed Balustrade
Product: Bespoke
- Natural Stone Steps

Furniture and Features

- P1** Raised Planter type 1 (brick walls)
Dims: 215/440(w)mm
- S1** Seating type 1.
Top mounted timber with backrest & armrest
- 01** Planter wall will need to be constructed to accommodate supports for the seating. Refer to drawing 8007 for details.
- 02** Wall steps in this location. Refer to Section 01 on this drawing.
- 03** Balustrade to be fixed to the coping using a hidden baseplate detail.
- 04** W1 is a proposal to reconstruct an historic wall. This wall is not completely straight. Tie in detail to Tisserin Engineer's design and specification.
- 05** Planter wall coping and coursing requires angle detailing in several instances.

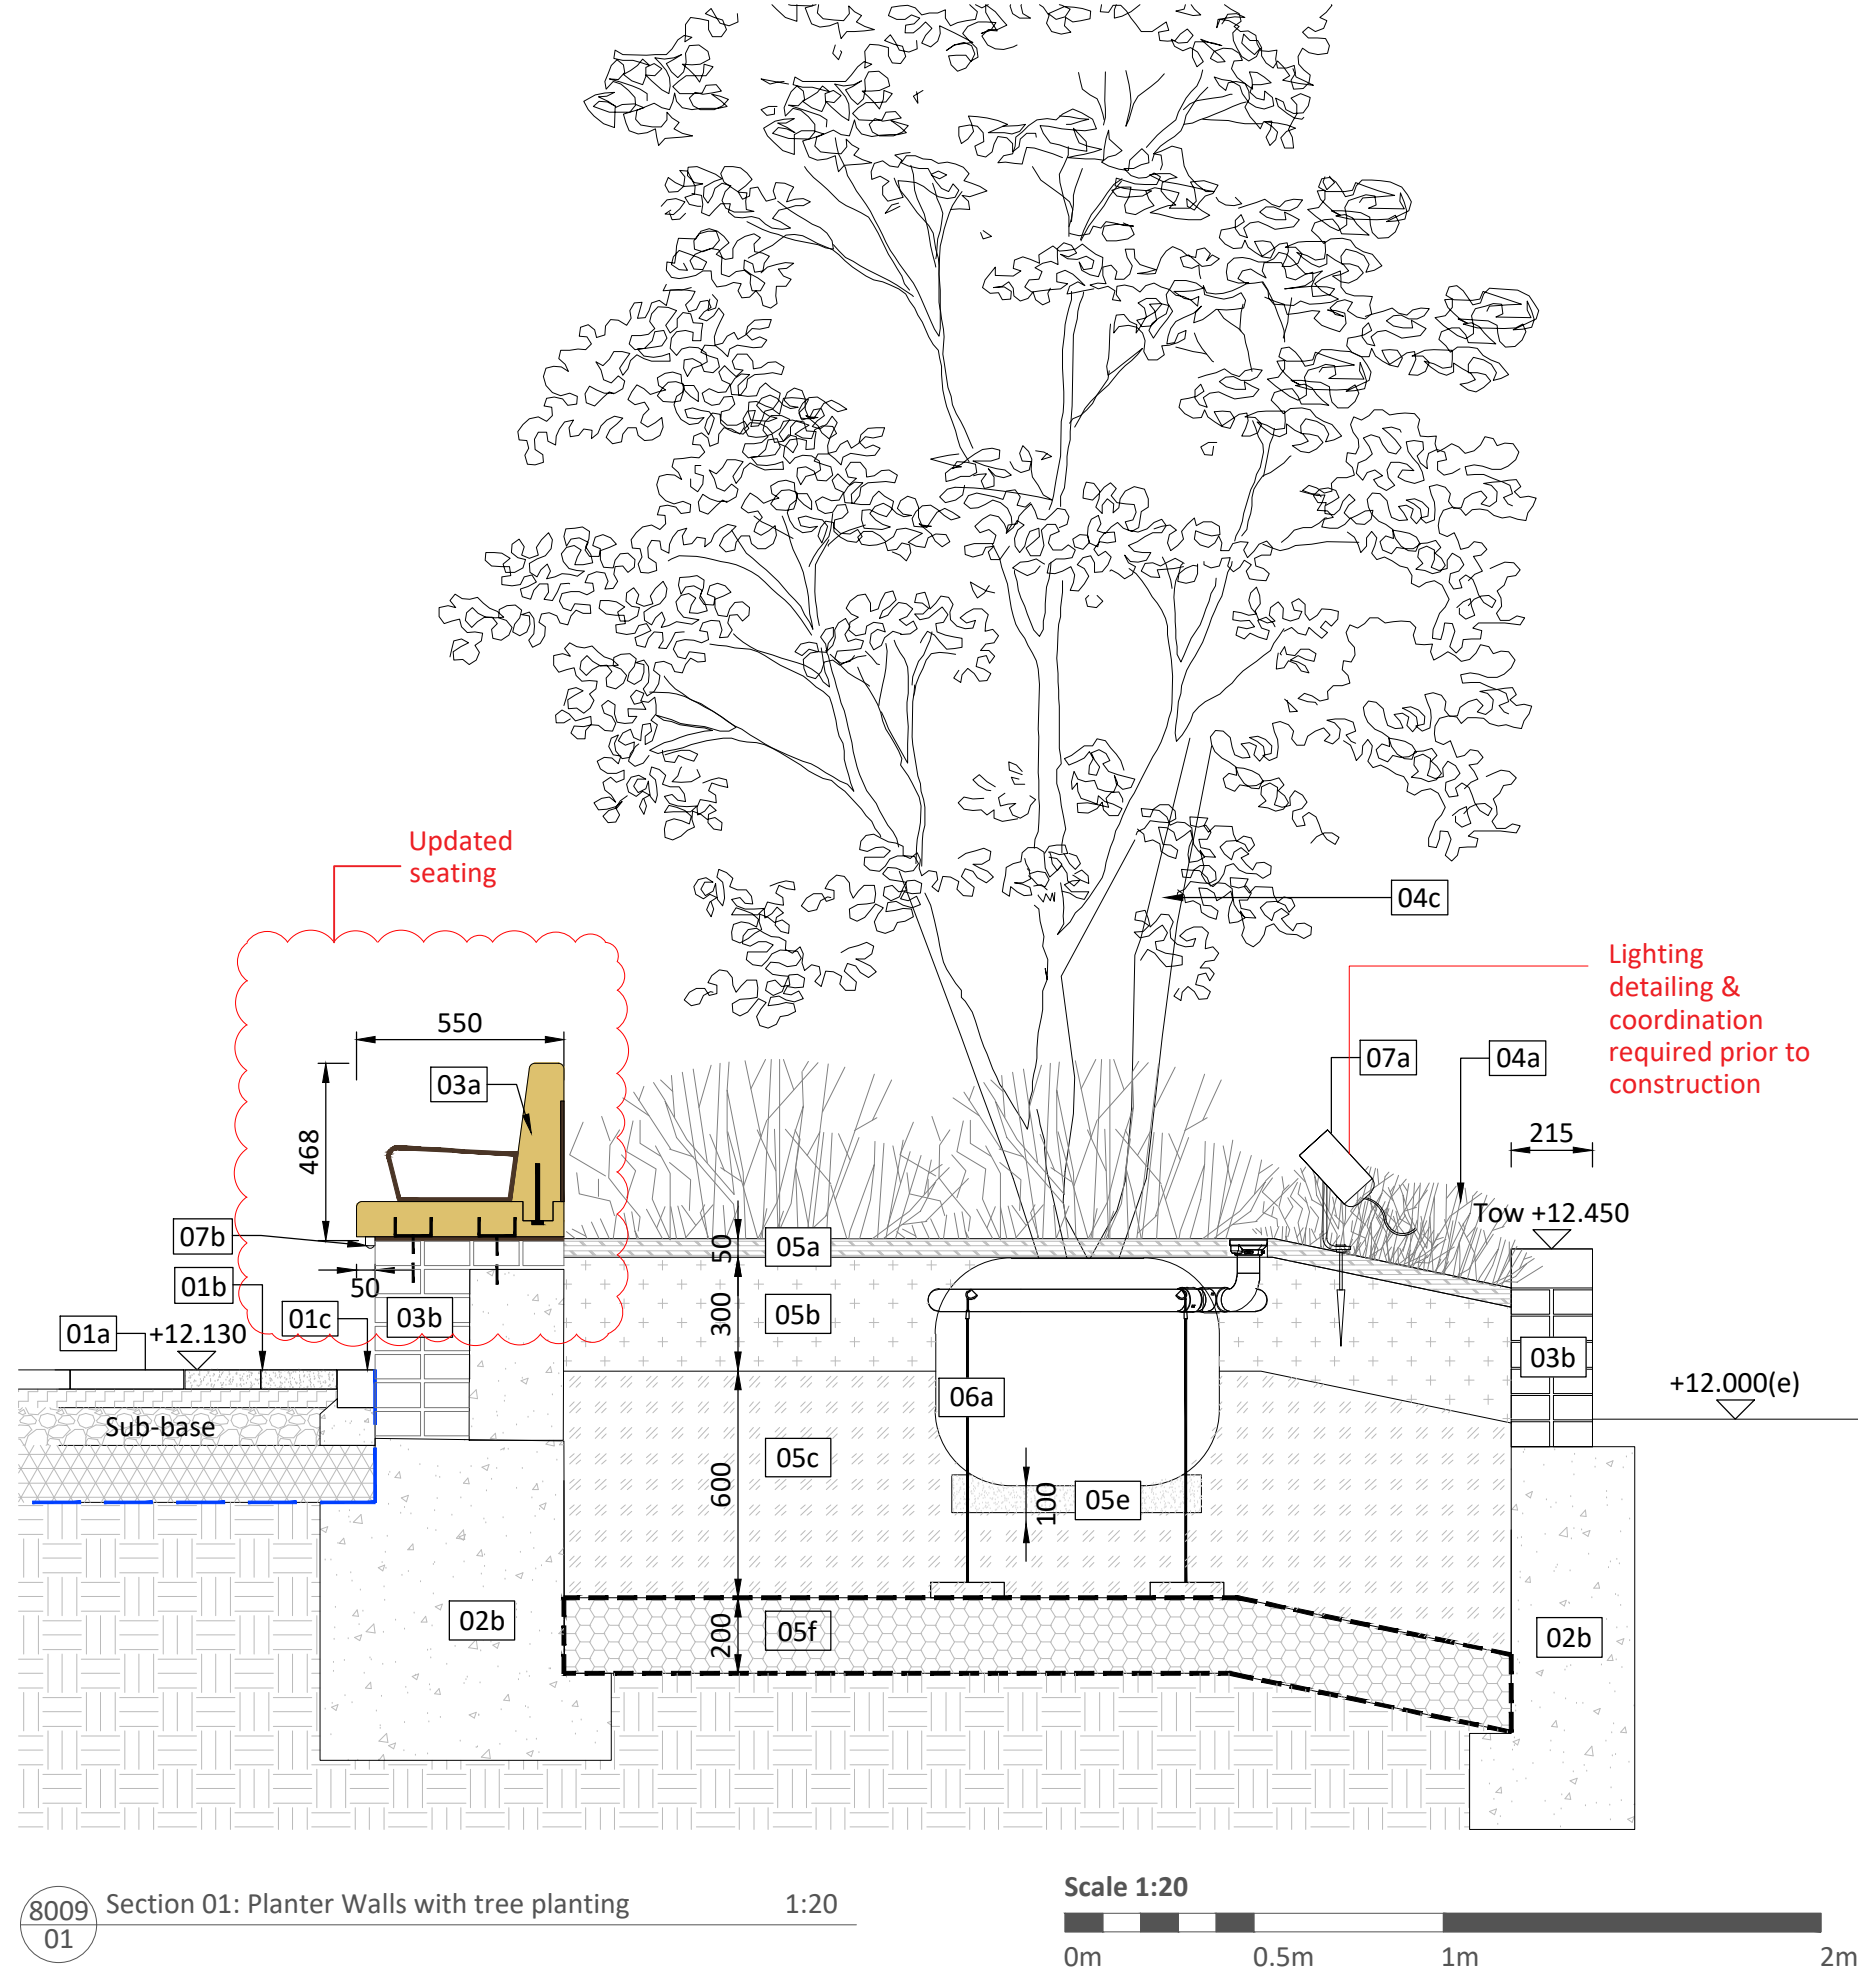


8009 01 Section 01: Planter Walls with tree planting 1:20


Scale 1:20

0m 0.5m 1m 2m

Hidden base plate detailing for the balustrade and handrails

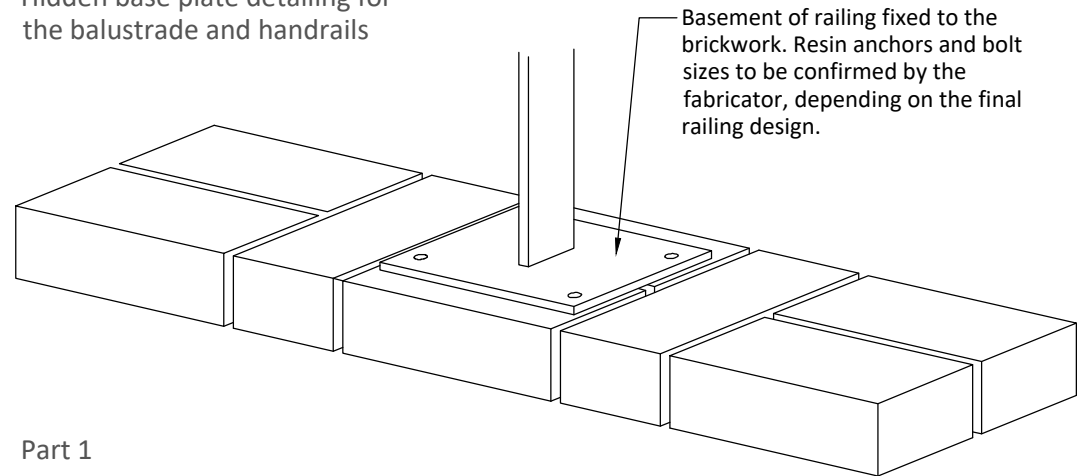

Part 1

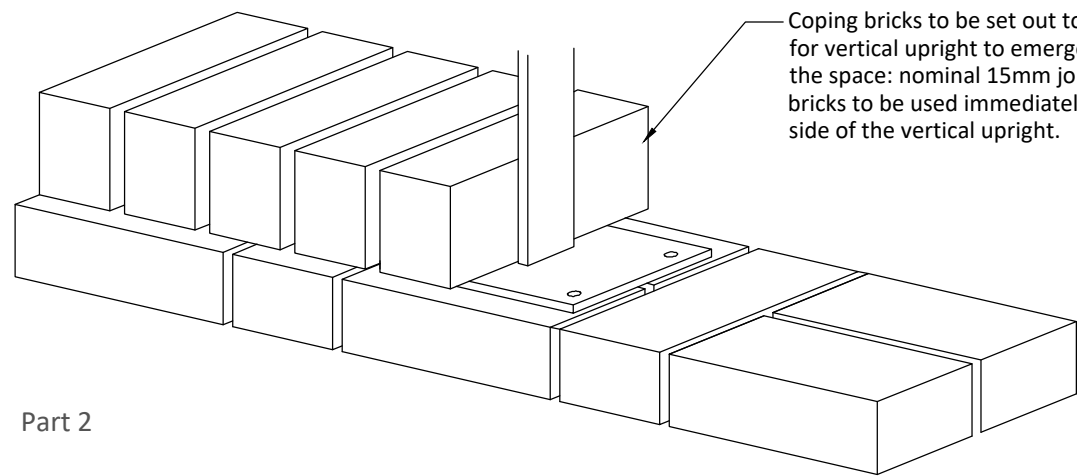

Part 2

Key

01 Paving

01a Natural Stone Paving type 1
Dims: 600(l)x300(w)x50(d) mm
Staggered bond.
Product: Elland Edge
Supplier: Tectonix
Spec ref: Q25/310A

01b Natural Stone Paving type 2
Dims: 600(l)x200(w)x50(d) mm
Staggered bond.
Product: Elland Edge
Supplier: Tectonix
Spec ref: Q25/310B

01c Single Running Course Natural Stone Paving
Dims: 200(l)x100(w)x100(d) mm
Product: Elland Edge
Supplier: Tectonix
Spec ref: Q25/310C

01d Natural Stone Tactile Corduroy paving
Dims: 400(l)x400(w)x50(h) mm
Product: Elland Edge
Supplier: Tectonix
Spec ref: Q25/320

Linework and hatches for bedding, base and sub-bases are indicative and to engineers specification and drawings.

02 Edges, Walls and Steps

02a Proposed Balustrade
Dims: 1000(h)mm, 50(w)x10(d)mm flat steel top, 25x25mm post
Product: Bespoke
Supplier: Tectonix
Spec ref: L37/160

02b Retaining wall
refer to Tisserin drwg for details

02c Proposed Handrail to Steps
Dims: 1000(h)mm
Product: Bespoke
Spec ref: L37/150

03 Furniture and Features

03a Seating type 1
Top mounted with backrest and armrest
Dims: as shown
Product: Integrated Planter Benches
Supplier: Woodscape or similar approved
Spec ref: Q50/225A

03b Raised Planter type 1 (brick walls)
Dims: 215/440(w)mm
Product: re-claimed brick from site or similar approved.
Spec ref: F10/233

04 Planting

04a Proposed Ornamental Planting Mix
Refer to drwg. 0960-RFM-XX-00-DR-L-0004
Spec ref: see Section Q31

04b Proposed Hedge
Refer to drwg. 0960-RFM-XX-00-DR-L-0004
Spec ref: see Section Q31

04c Proposed multi-stem tree in soft landscape
Refer to drwg. 0960-RFM-XX-00-DR-L-0004
Spec ref: see Section Q31

05 Growing Medium and Planting Build up
05a Bark mulch, 50mm depth or mulch mat
Spec ref: see Section Q28

Topsoil - to BS 3882:2015

05b Top soil to tree, hedge and ornamental planting. 300mm depth
topsoil to be tested by a suitably qualified soil scientist in accordance with BS3882 2007
Spec ref: see Section Q28

Subsoil - to BS 8601:2013
05c Subsoil to tree planting. Depth 600mm
05d Subsoil to shrub and hedge planting. Depth 300mm
Spec ref: see Section Q28

05e Rootball to sit on 100-150mm of coarse washed sand. 100mm depth

05f 200mm gravel drainage layer to base of tree pit. wrapped in geotextile membrane


06 Tree Accessories

06a Root ball underground anchoring system

06b Irrigation/ aeration pipe

07 Lighting

07a Uplighter
07b LED Under Seat lighting
Refer to Integration UK's design and specification.

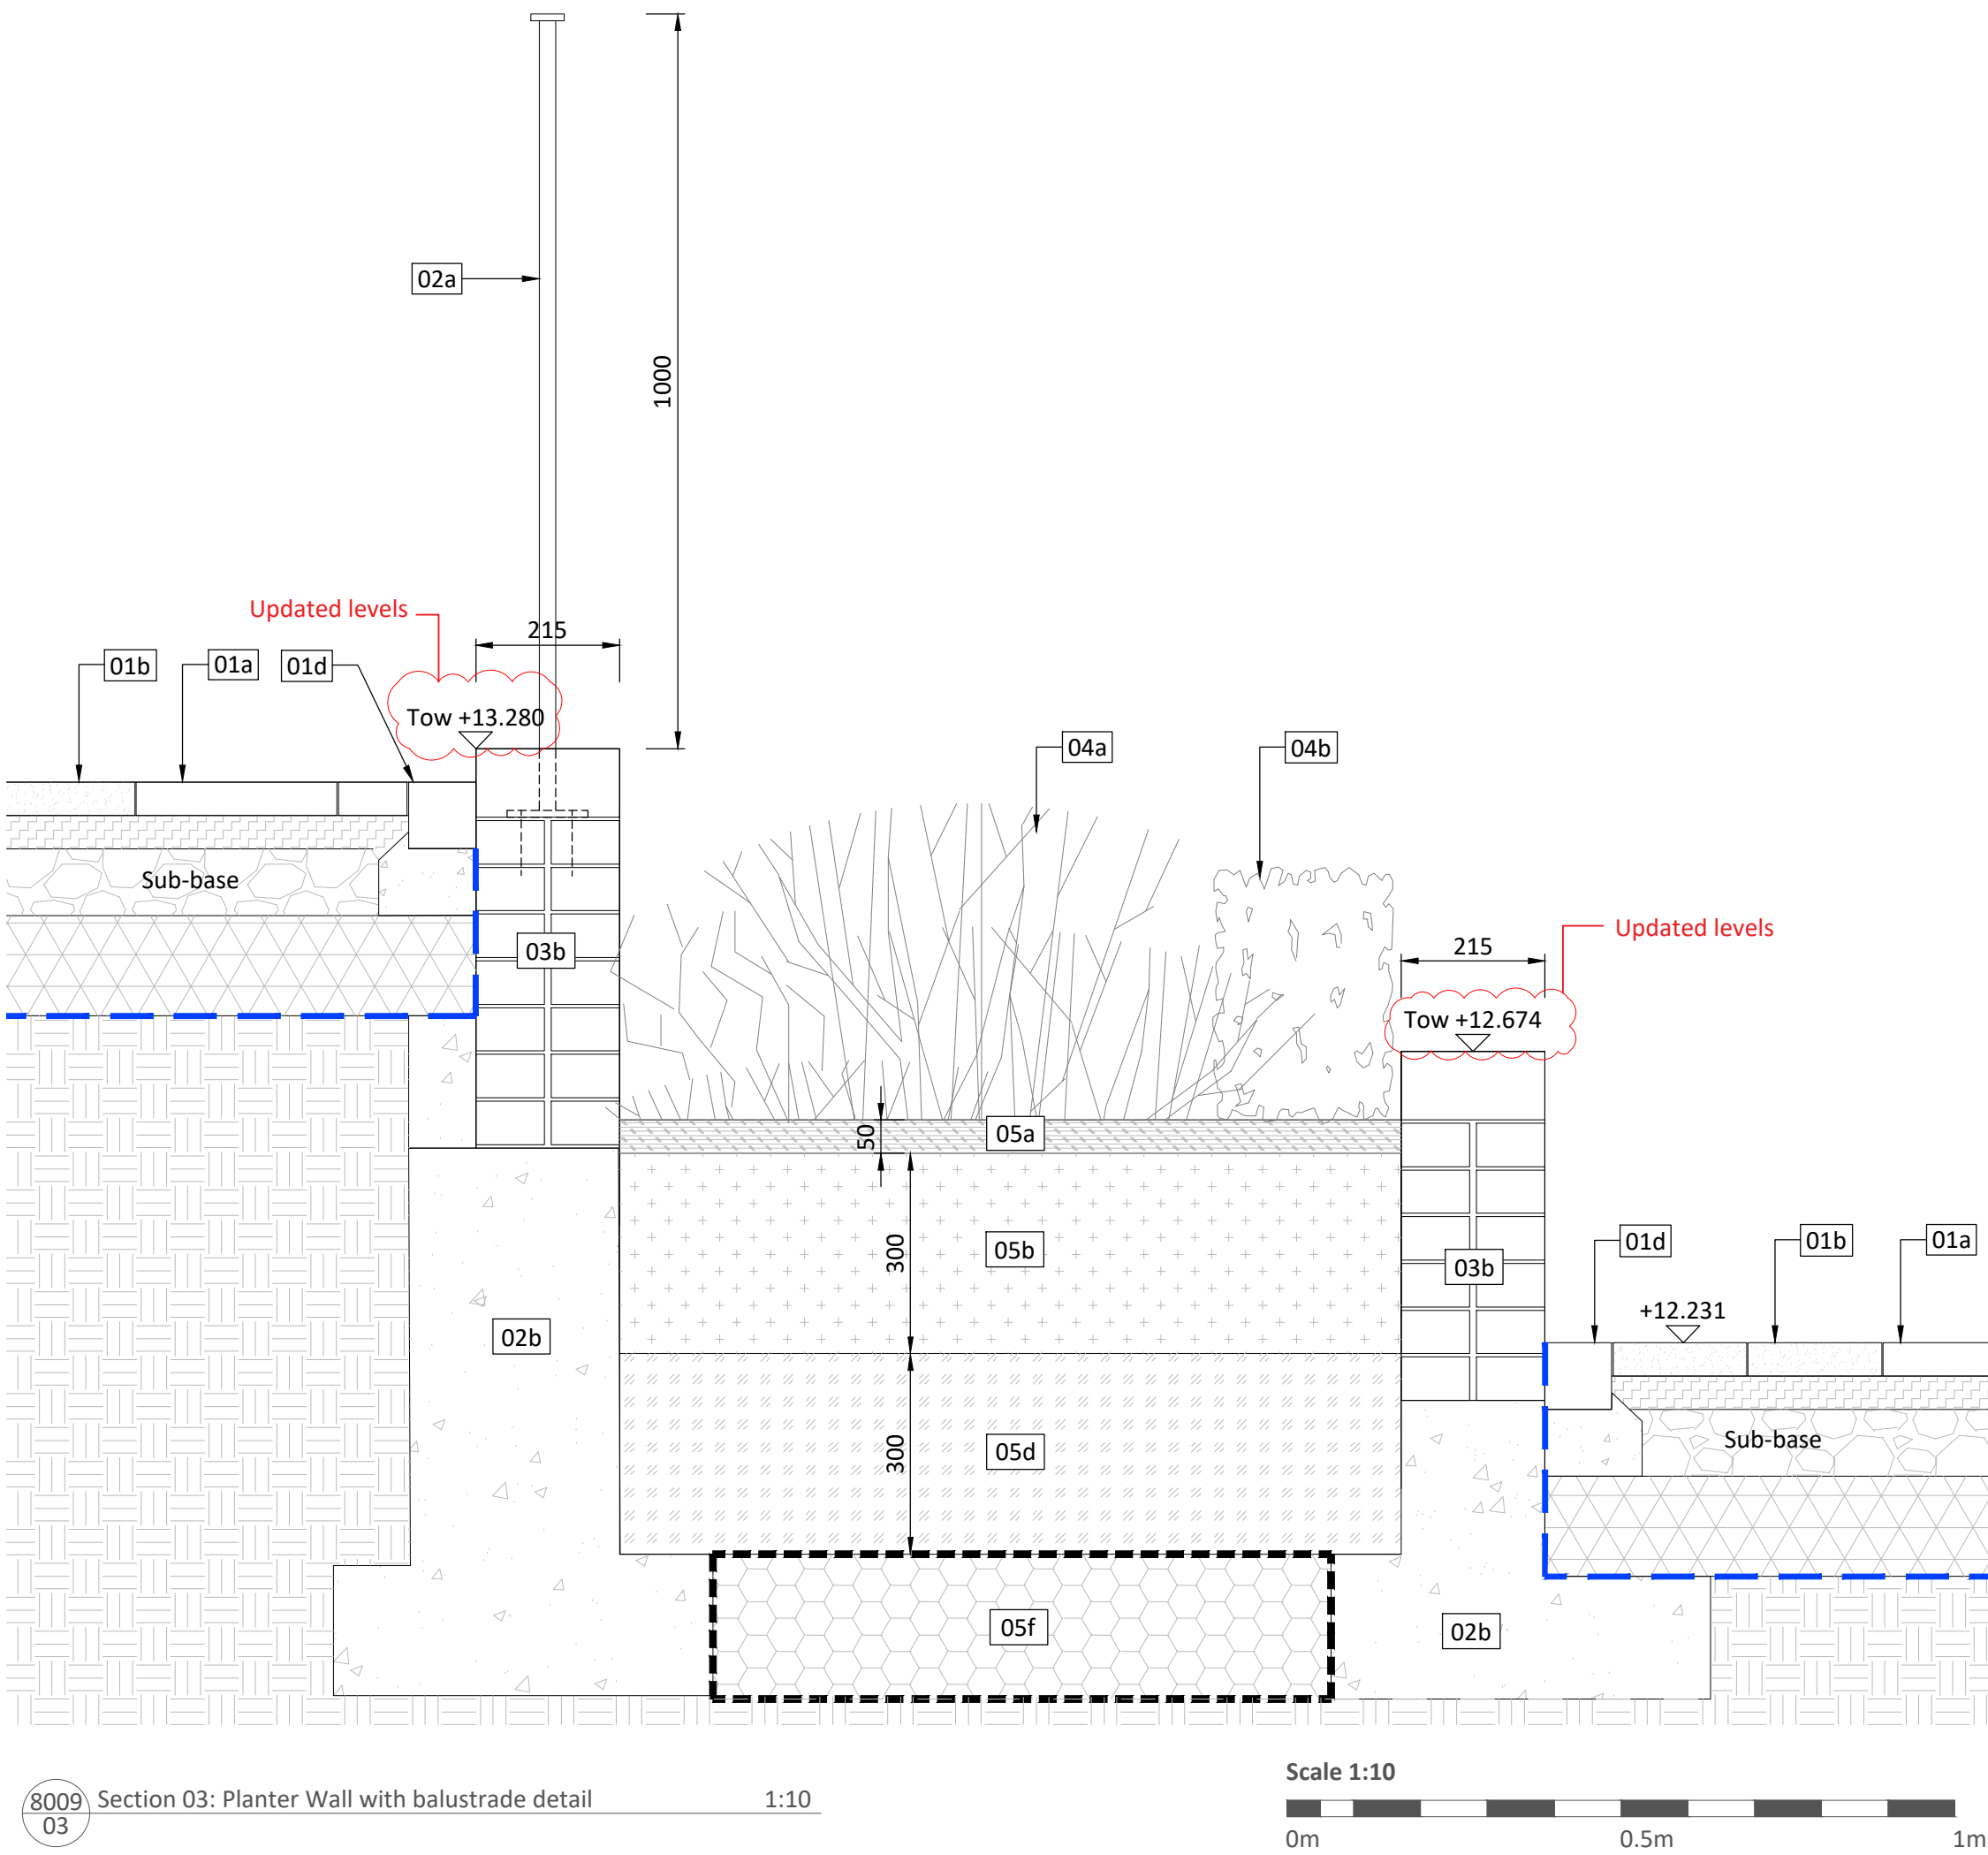

8009 03 Section 03: Planter Wall with balustrade detail 1:10

Scale 1:10

0m 0.5m 1m

- Notes
- All dimensions in mm, unless otherwise stated.
 - Scaling from drawing if printed incorrectly may lead to errors.
 - All information outside red line boundary shown for contextual purpose only.
 - All hatch patterns are indicative only unless stated otherwise.
 - This drawing is to be read in conjunction with the re-form landscape architecture drawings and specification, F3 Architect's drawings and specification, the Tisserin drawings and specification (civils, drainage and structural proposals) and the Integration UK drawings and specification (Electrical), AND all relevant documentation from the design and project team
 - Levels information on this drawing illustrates the design intent. The contractor is to check and verify all levels and dimensions against site survey information.
 - Any discrepancies in the design information are to be brought to the attention of re-form landscape architecture, in writing, prior to commencement of construction works.
 - All proprietary products shall be installed in strict accordance with manufacturers written instructions.
 - Refer to other consultants' drawings and specifications for the following design information:
 - Foundation details
 - Base course and/or sub bases design & specification
 - Waterproofing of any element
 - Levels & Drainage design and infrastructure
 - Lighting and ducting
 - Existing & proposed utilities
 - Plant quantities are to suit site areas in accordance with scheduled plant densities.
 - Any proposed plant substitution shall be agreed with the landscape architect prior to ordering.
 - Drainage system and paving build ups above the roof to Tisserin's design; specialist contractor required notably for the waterproofing layer, which must not be compromised by the contractor carrying out the landscape works.

Date	Description of revision	Drawn by	Checked by	Approved by	Revision
03.04.25	Step overhang adjusted, updated levels and detailing for the balustrade, updated seating	EK/VC	TD	DL	C02

re-form
landscape architecture

Beehive Mill, Jersey Street,
Manchester M4 6JG
T: +44 (0)161 397 4953
E: info@re-formlandscape.com
W: re-formlandscape.com

Project
808-810 HIGH ROAD, TOTTENHAM
RF22-960

Client
TOTTENHAM HOTSPUR
Document title
WALL PLANTER DETAILS

Paper size
A1
Scale
1:20

Status
APPROVED AS STAGE COMPLETE

Drawing number
0960-RFM-XX-00-DR-L-8009

© re-form landscape architecture

Scale
1:20

A4

Revision
C02