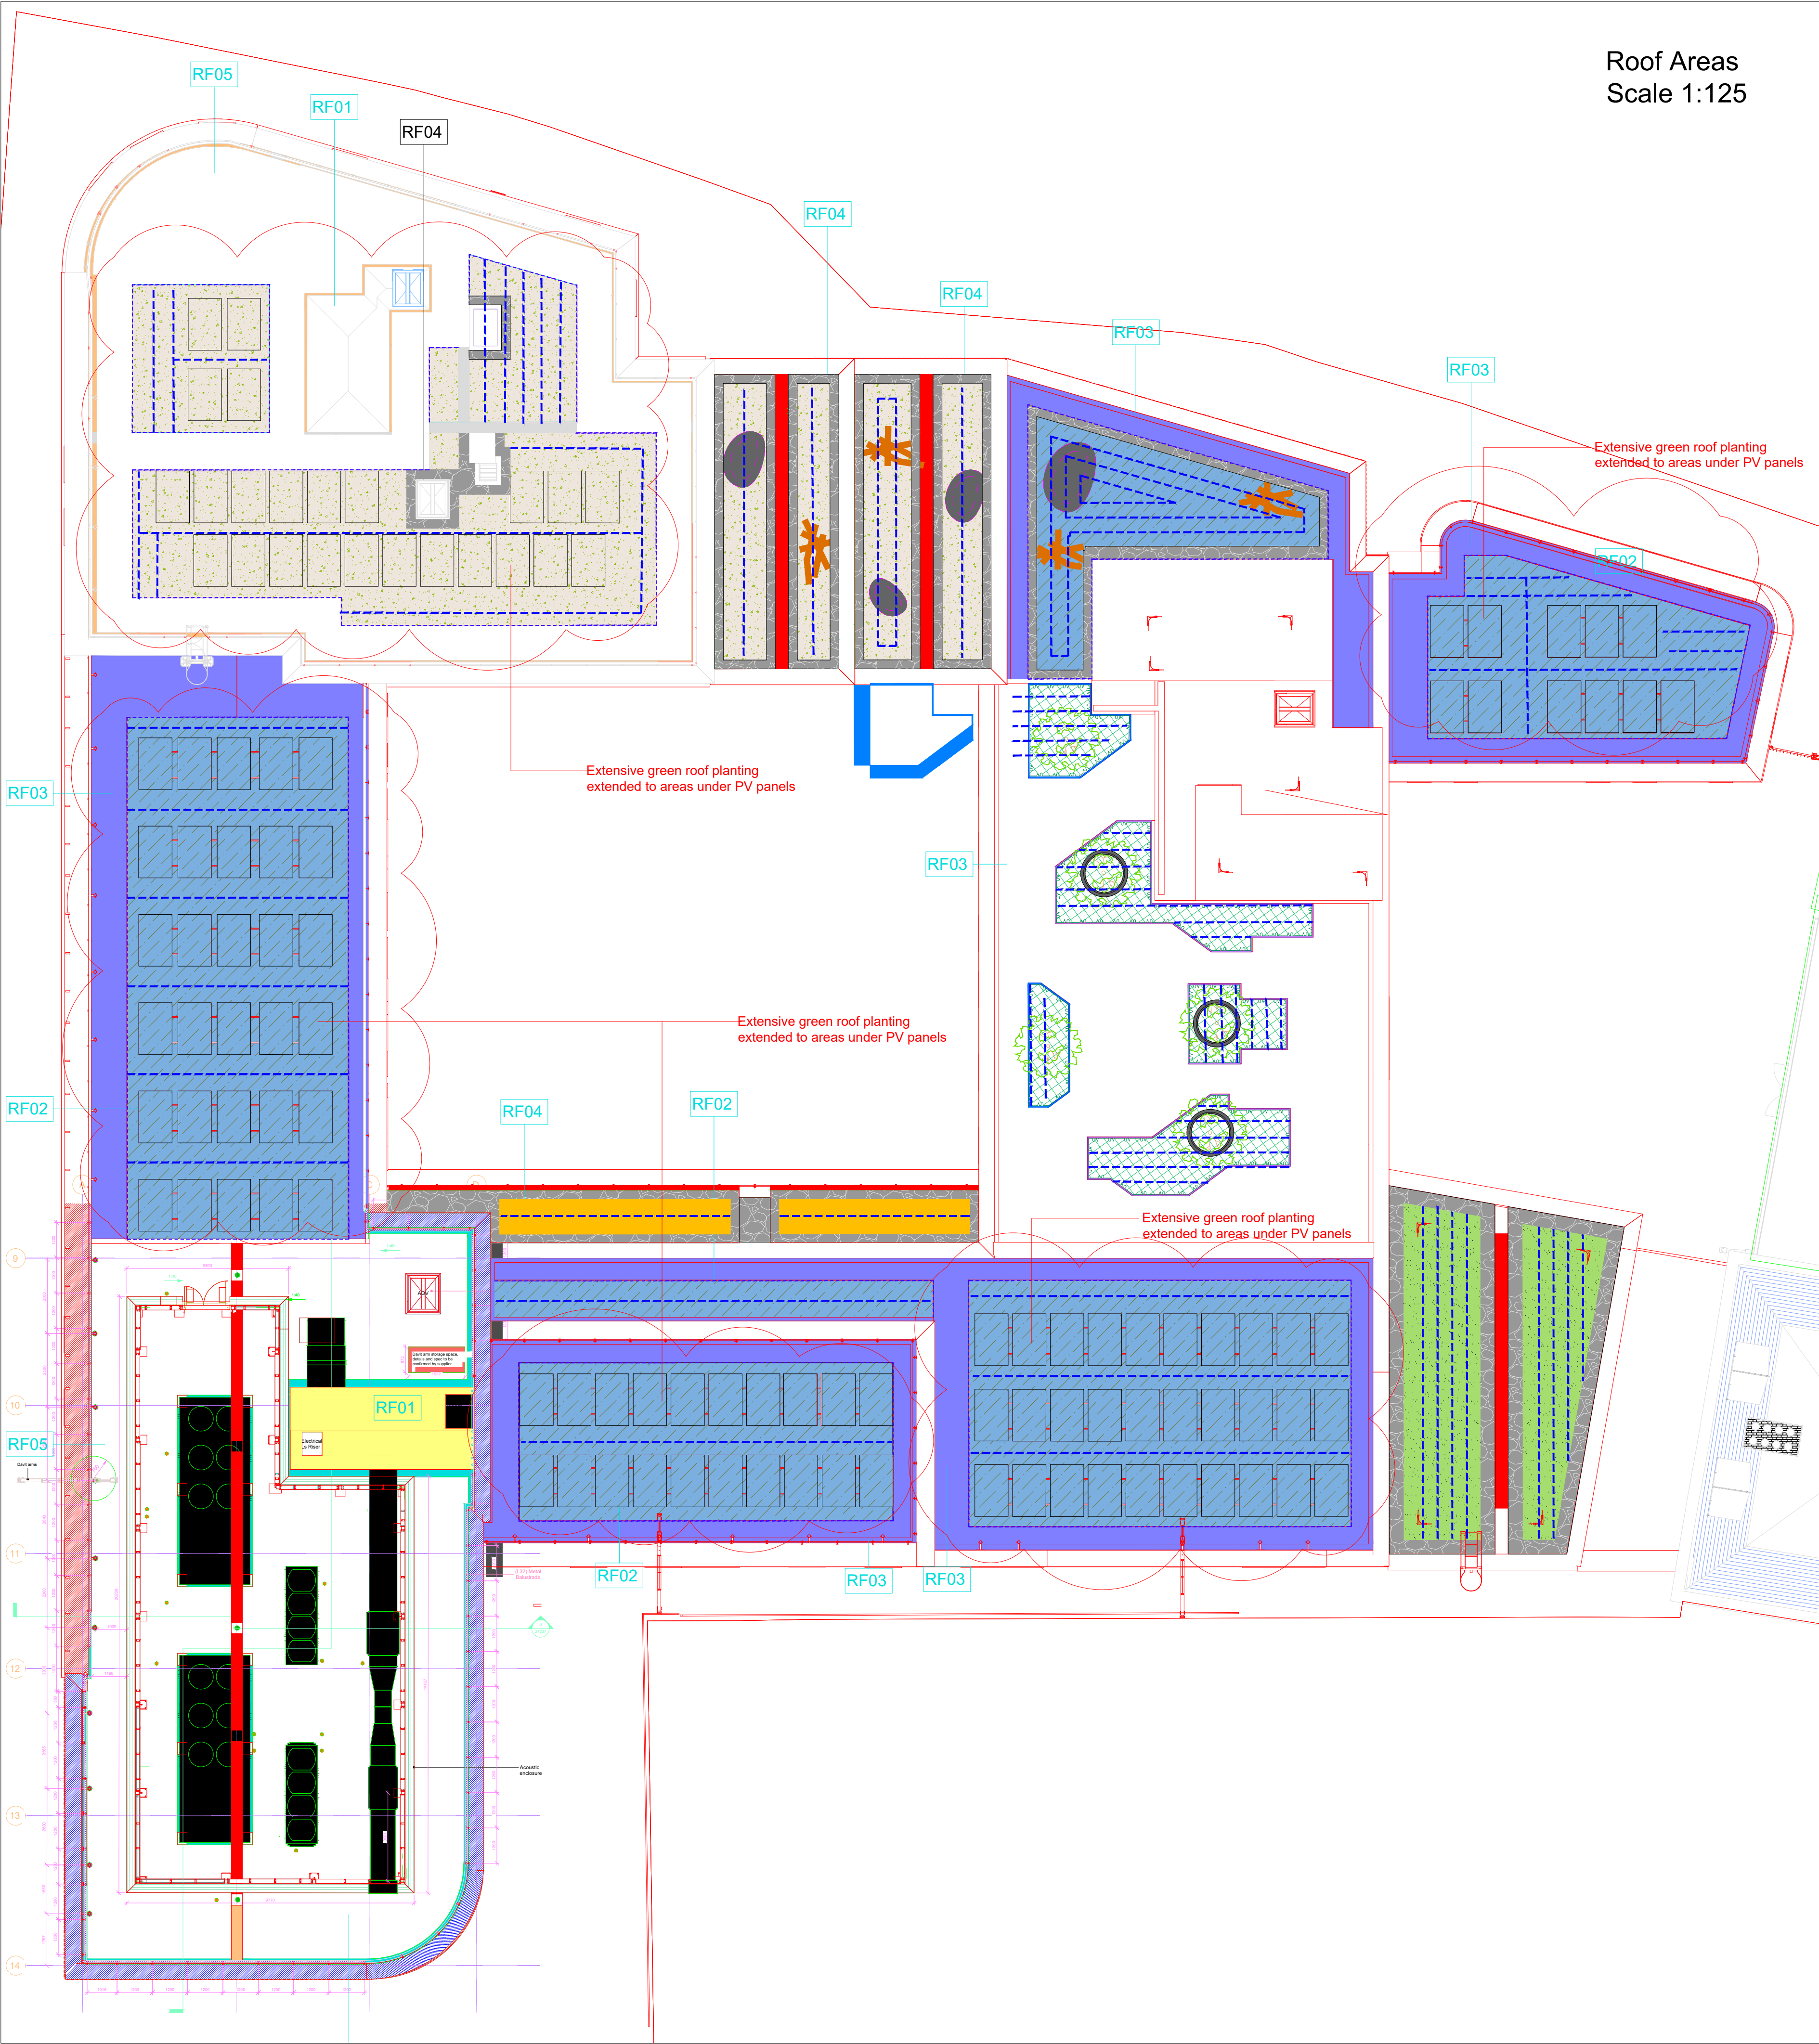
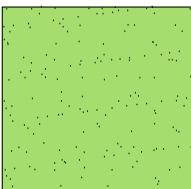
 
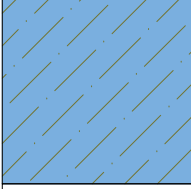
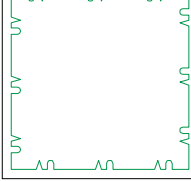


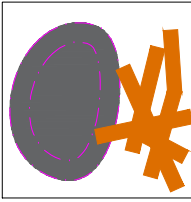
Roof Areas
Scale 1:125



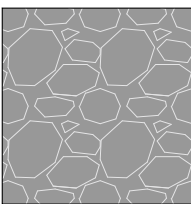
Green Roof Finishes

-  Extensive Green Roof - Type 1
Wildflower Mix inc. 100mm min. substrate depth
Mixture: Wildflower Extensive Living Roof
-  Extensive Green Roof - Type 2
Sedum Mix inc. 80mm min. substrate depth
Sedum Mat containing minimum of 12 sedum varieties
-  Extensive Green Roof - Type 3
Bio Solar Seed Mix inc. 60mm min. substrate depth
Mixture: Biosolar Wildflower Seed
-  Extensive Green Roof - Type 4
Hydro Biodiverse inc. water retention and drainage and contoured growing medium varying between 80 and 150mm depth
Mixture: Hydro Biodiverse Seed Living Roof
-  Podium Planting
Ornamental planting in raised planters, growing medium depth 450mm for planting, 600mm min. for tree planters
Mixture of grasses, herbaceous planting

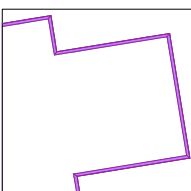
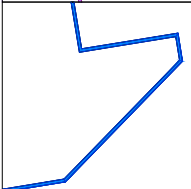
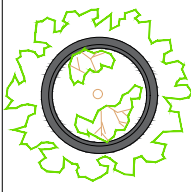
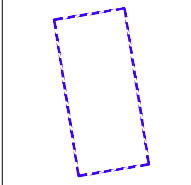
Green Roof Accessories

-  Invertebrate Habitat
Flat stone and semi-buried log piles
size between 1 and 2m²; 10No. in total

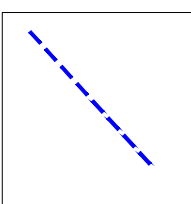
Paving to Green Roof Areas

-  Gravel Ballast
Rounded Pebble Ballast; 20-40mm diam. to 50mm depth

Green Roof Planters to Podium

-  Raised Planter Edge
Metal Edging Type 1
450mm height above FFL
-  Raised Planter Edge
Metal Edging Type 2
1000mm above FFL
-  Tree Pot
Partially submerged in raised metal planter
800mm min. depth
-  Metal Angle Upstand
suitable height to contain enclosed green roof growing medium

Watering Requirements

-  Conceptual locations of dripline irrigation systems within planters, including irrigation points at specimen tree locations as per approved design; full detailed irrigation system design to be provided by others

Note: in addition to automated irrigation system, bib taps are also to be provided in each area to ensure adequate watering can be carried out manually as and when required; full design and detailing of bib taps locations by engineer

Note:
Changes introduced from Reform design have been marked on in red.
Note:
- growing medium extended under PV panels to increase UGF (as advised by architect)

drawing status	S4	
	FOR TENDER	
	FOR CONSTRUCTION	
	AS BUILT	


David Clarke
LANDSCAPE ARCHITECT
29 Uppertown Road, Gleno, Larne
Co. Antrim BT40 3EA
Tel: 07752805988 / 02890767875
Email: david@david-clarke.net

Client:	McAleen & Rushe
Job:	The Printworks 819-829, High Road, Tottenham London N17 8ER
Title:	RF Irrigation Requirements
Dwg Ref:	179-DCA-B1-06-DR-L-90013
Scale:	1:125 @ A1
Date:	23/03/2026
Drawn By:	cs
Rev:	C01