



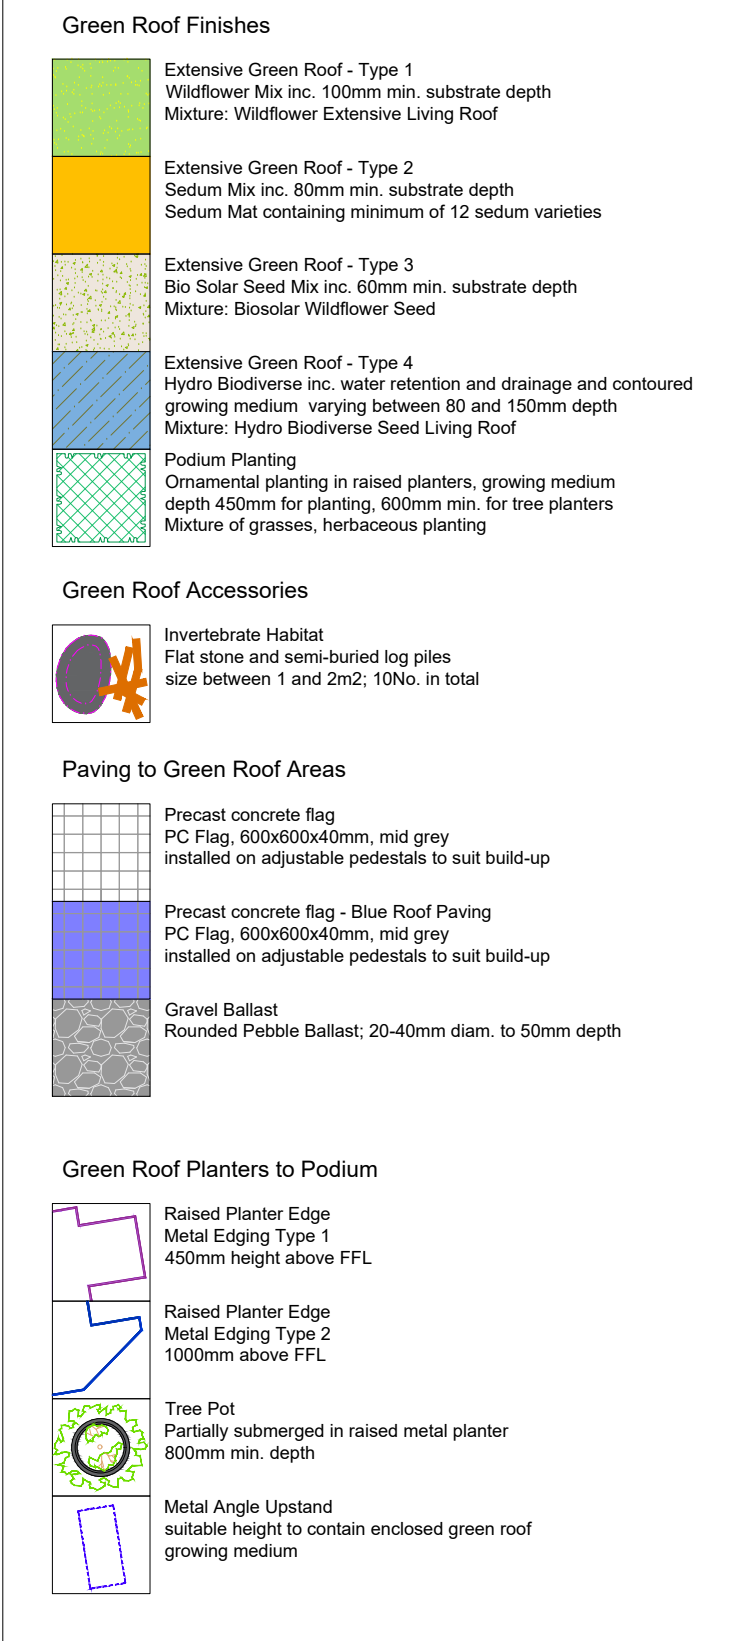

Typical Images Extensive Green Roofs

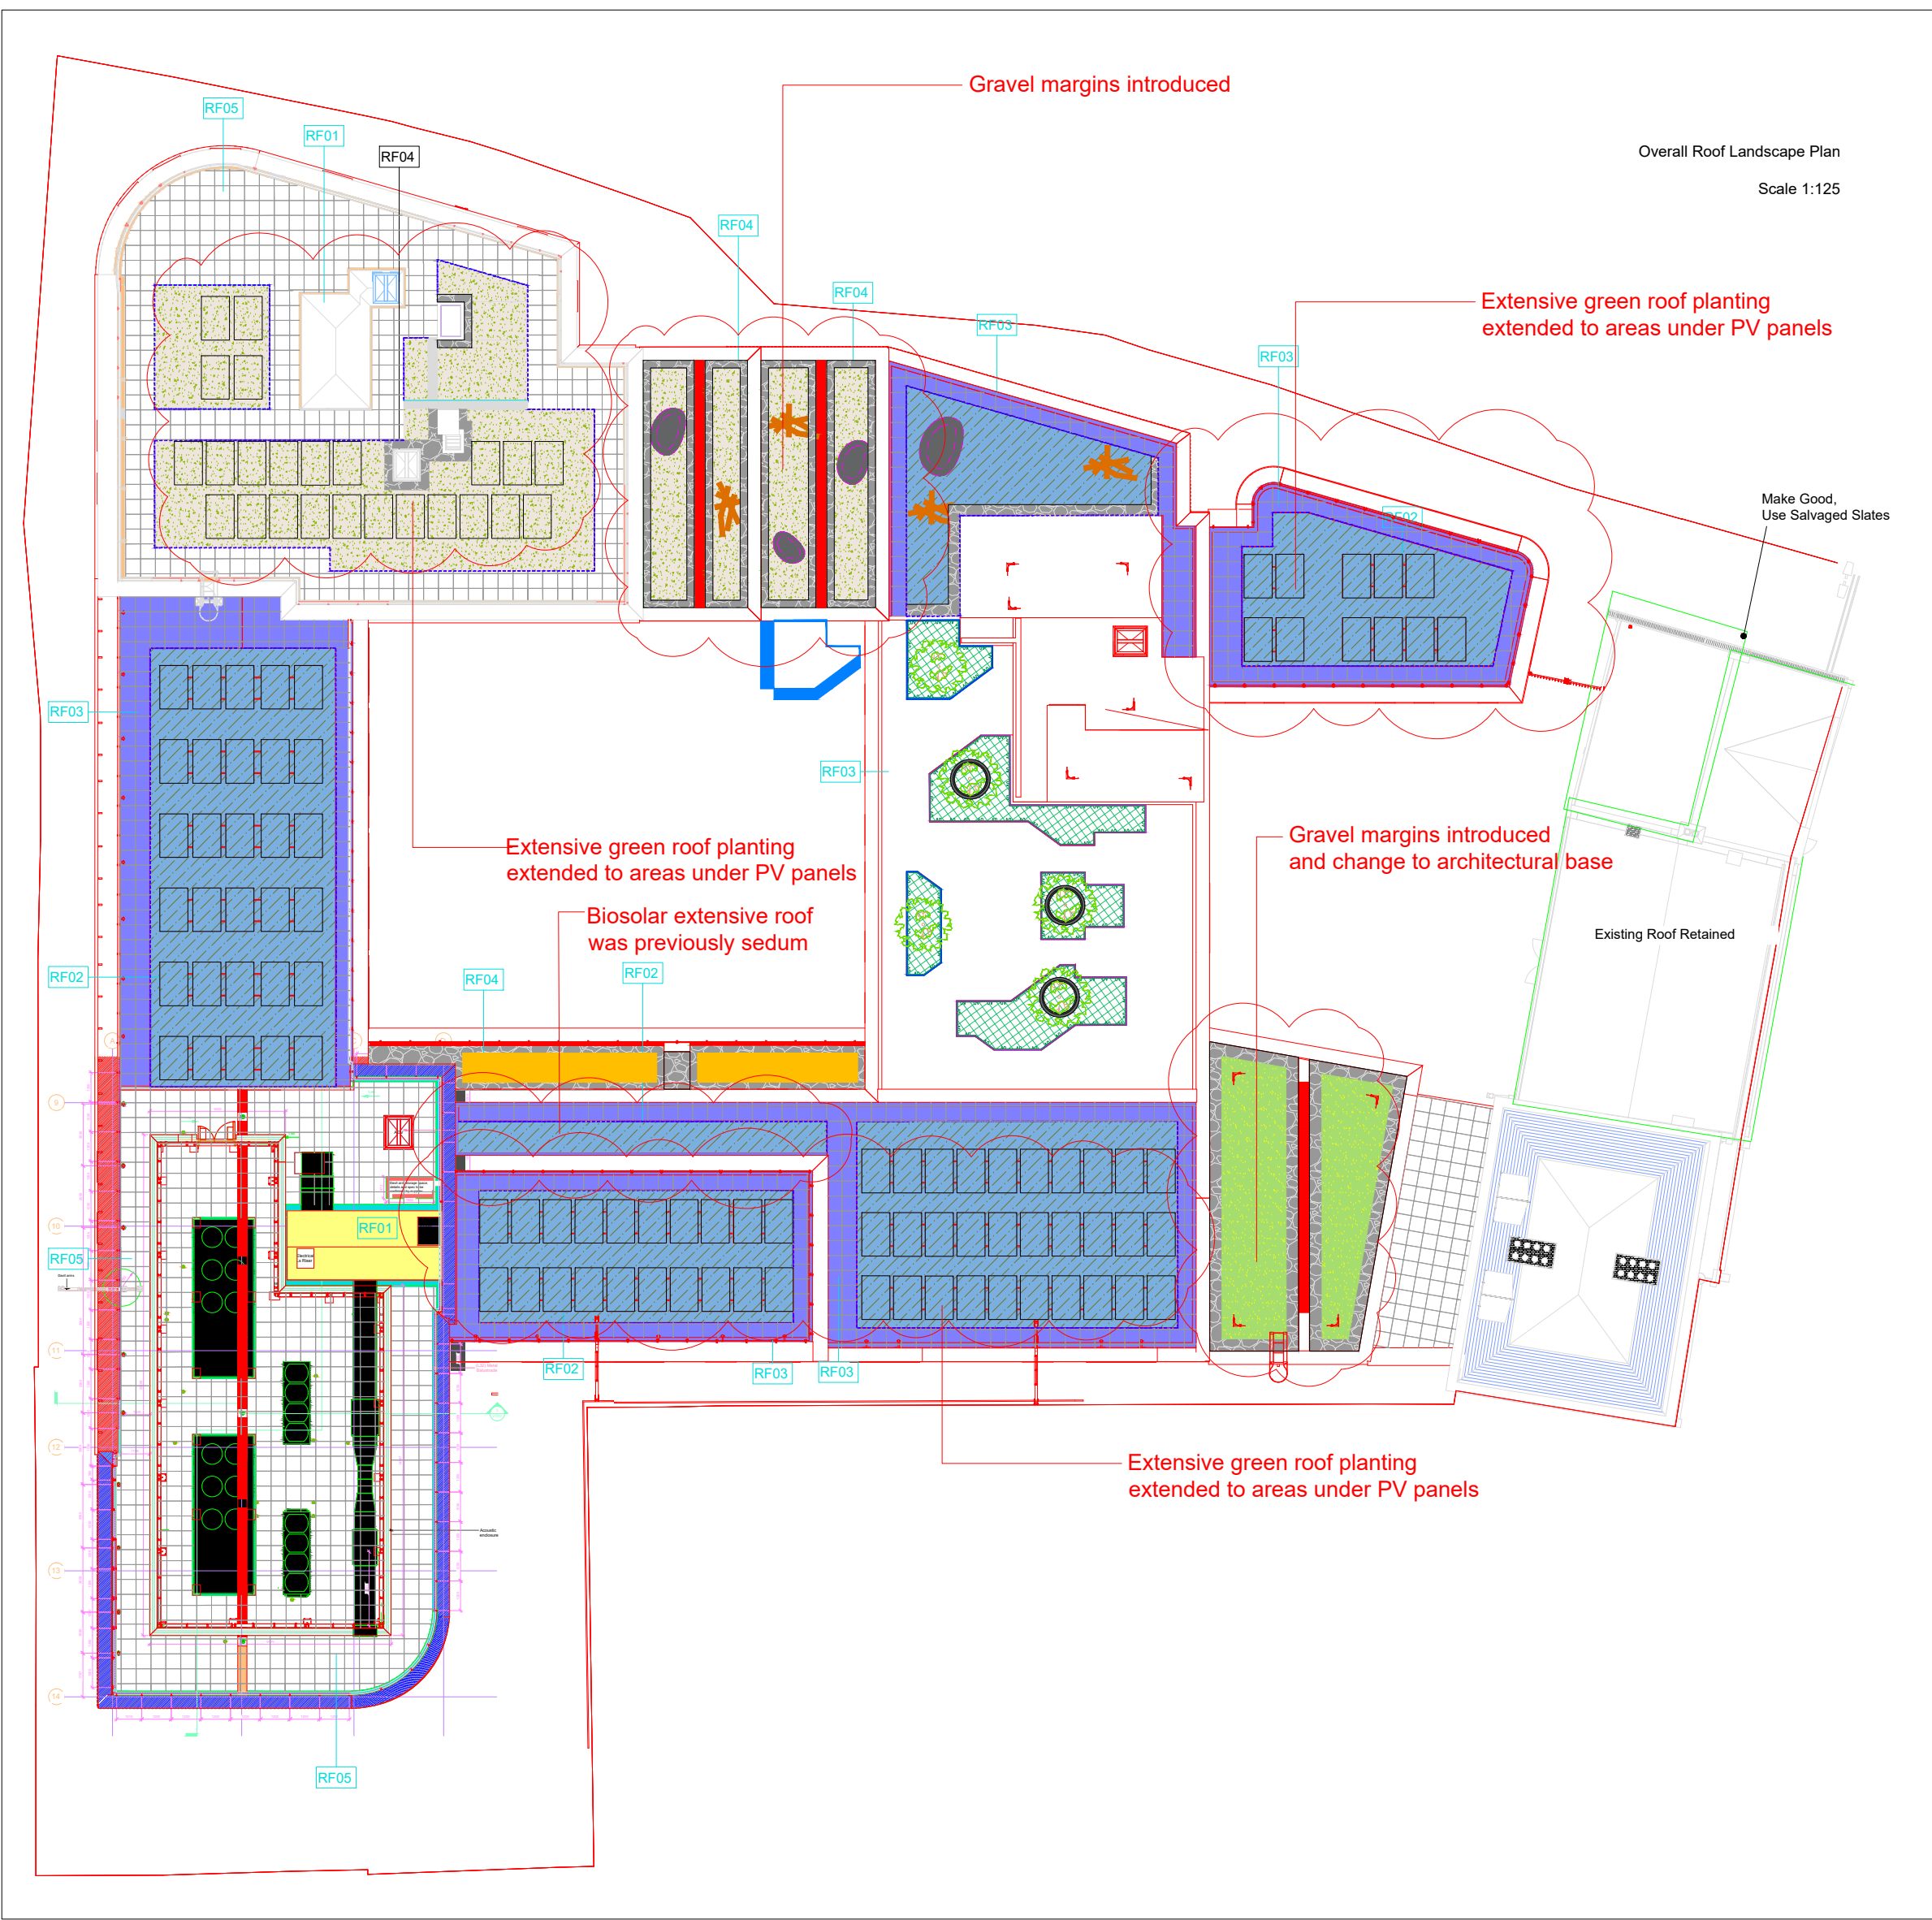

Note:

Changes introduced from Reform design have been marked on in red.

Note:

- gravel margins have been added to meet H&S and fire requirements
- growing medium extended under PV panels to increase UGF (as advised by architect)
- Sedum area reduced and extensive green roof (biosolar) extended in line with architect's plans

Extensive Green Roof with Wildflower Type 1
Seed Mix inc. the species list below (min. 34 native species)

Substrate for extensive green roof:
Extensive plant substrate for green roof planting
min. depth 100mm with undulations up to 150mm;
to comply with FFL Guidelines and GRO best practice standards

Species Mix:

- Agrimony (Agrimonia Eupatoria)
- Bird's Foot Trefoil (Lotus Corniculatus)
- Bladder Campion (Silene Vulgaris)
- Crested Dog's Tail (Cynosurus Cristatus)
- Common Quaking Grass (Briza Media)
- Common Sorrel (Rumex Acetososa)
- Common Toadflax (Linaria Vulgaris)
- Cowslip (Primula Veris)
- Hoary Plantain (Plantago Media)
- Kidney Vetch (Anthyllis Vulneraria)
- Lady's Bedstraw (Galium Verum)
- Ox-Eye Daisy (Leucanthemum Vulgare)
- Perforate St John's Wort (Hypericum Perforatum)
- Red Clover (Trifolium Pratense)
- Rough Hawkbit (Leontodon Hispidus)
- Salad Burnett (Sanguisorba Minor)
- Self Heal (Prunella Vulgaris)
- Small Scabious (Scabiosa Columbaria)
- Sweet Vernal Grass (Anthoxanthum Odorum)
- Vipers Bugloss (Echium Vulgare)
- Wild Marjoram (Origanum Vulgare)
- Thyme (Thymus Polytrichus)
- Yarrow (Achillea Millefolium)
- Common Poppy (Papaver Rhoas)
- Cluster Bellflower (Campanula Glomerata)
- Harebell (Campanula Rotundifolia)
- Red Fescue (Festuca Rubra)
- Brown Top Bent (Agrostis Capillaris)
- Lesser Knapweed (Centaurea Nigra)
- Black Medic (Medicago Lupulina)
- Red Campion (Silene Dioica)
- Betony (Stachys Officinalis)
- Catsear (Hypochaeris)
- Yellow Rattle (Rhianthus Minor)
- Field Scabious (Knautia Arvensis)
- Meadow Buttercup (Ranunculus Acris)
- Comflower (Centaurea Cyanus)
- Corn Marigold (Chrysanthemum Segetum)

Extensive Green Roof Type 2
Sedum Mix inc. the species list below (min. 12 species)

Substrate for extensive green roof:
Extensive plant substrate for green roof planting
min. depth 80mm of substrate;
to comply with FFL Guidelines and GRO best practice standards

Species Mix:

- Sedum selskianum
- Sedum hybridum
- Sedum montanum
- Sedum Pulchellum
- Sedum elacombianum
- Sedum acre
- Sedum album
- Sedum sexangulare
- Sedum spurium
- Sedum floriferum
- Sedum reflexum
- Sedum middendorffianum

Extensive Green Roof Type 3
Biosolar Seed Mix inc. the species list below

Substrate for extensive green roof:
Extensive plant substrate for green roof planting min. depth 60mm;
to comply with FFL Guidelines and GRO best practice standards

Species Mix:

- 65% Wildflowers
- 15% Annual Wildflowers
- 20% Grasses

Yarrow (Achillea millefolium)

- Agrimony (Agrimonia Eupatoria)
- Kidney Vetch (Anthyllis Vulneraria)
- Clustered Bellflower (Campanula glomerata)
- Black Knapweed (Centaurea nigra)
- Centauray (Cetaurium erythraea)
- Wild Basil (Clinopodium vulgare)
- Maiden Oink (Dianthus deltoides)
- Wild Strawberry (Fragaria vesca)
- Lady's Bedstraw (Galium Verum)
- Mouse-ear hawkweed (Hieracium pilosella)
- Catsear (Hypochaeris radicata)
- Field Scabious (Knautia Arvensis)
- Rough Hawkbit (Leontodon Hispidus)
- Common Toadflax (Linaria Vulgaris)
- Bird's Foot Trefoil (Lotus Corniculatus)
- Black medick (Medicago lupulina)
- Wild Marjoram (Origanum Vulgare)
- Hoary Plantain (Plantago Media)
- Cowslip (Primula Veris)
- Self Heal (Prunella Vulgaris)
- Salad Burnett (Sanguisorba Minor)
- Wild Meadow Clary (Salvia verbenacac/pratensis)
- Small Scabious (Scabiosa Columbaria)
- Biting Stonecrop (Sedum acre)
- White Stonecrop (Sedum album)
- Bladder Campion (Silene Vulgaris)
- Lesser Stitchwort (Stellaria graminea)
- Wild Thyme (Thymus polytrichus)
- Red Clover (Trifolium pratense)
- Dog Violet (Viola riviniana)

Corn Cockle (Agrostemma githago)

- Scarlet Pimpernel (Anagallis arvensis)
- Corn Chamomile (Anthemis arvensis)
- Cornflower (Centaurea cyanus)
- Blue Fleabane (Erigeron acer)
- Common Forget-Me-Not (Myosotis arvensis)
- Common Poppy (Papaver rhoas)
- Wild Pansy (Viola tricolor)
- Corn Marigold (Glebione segetum)

Sweet Vernal Grass (Anthoxanthum odoratum)

- Quaking Grass (Briza media)
- Glaucous Sedge (Carex flacca)
- Crested Dog's Tail (Cynosurus cristatus)
- Sheep's Fescue (Festuca ovina)
- Red Fescue (Festuca rura)
- Crested Hair Grass (Koeleria macrantha)
- Yellow Oat-Grass (Trisetum flavescens)

Extensive Green Roof Type 4
Hydro Biodiverse Seed inc. species list below

Substrate for extensive green roof:
Extensive plant substrate for green roof planting
min. depth 80mm with undulations up to 150mm;
to comply with FFL Guidelines and GRO best practice standards

Species Mix:

- 65% Wildflowers
- 15% Annual Wildflowers
- 20% Grasses

Yarrow (Achillea millefolium)

- Agrimony (Agrimonia Eupatoria)
- Kidney Vetch (Anthyllis Vulneraria)
- Clustered Bellflower (Campanula glomerata)
- Black Knapweed (Centaurea nigra)
- Centauray (Cetaurium erythraea)
- Wild Basil (Clinopodium vulgare)
- Maiden Oink (Dianthus deltoides)
- Wild Strawberry (Fragaria vesca)
- Lady's Bedstraw (Galium Verum)
- Mouse-ear hawkweed (Hieracium pilosella)
- Catsear (Hypochaeris radicata)
- Field Scabious (Knautia Arvensis)
- Rough Hawkbit (Leontodon Hispidus)
- Common Toadflax (Linaria Vulgaris)
- Bird's Foot Trefoil (Lotus Corniculatus)
- Black medick (Medicago lupulina)
- Wild Marjoram (Origanum Vulgare)
- Hoary Plantain (Plantago Media)
- Cowslip (Primula Veris)
- Self Heal (Prunella Vulgaris)
- Salad Burnett (Sanguisorba Minor)
- Wild Meadow Clary (Salvia verbenacac/pratensis)
- Small Scabious (Scabiosa Columbaria)
- Biting Stonecrop (Sedum acre)
- White Stonecrop (Sedum album)
- Bladder Campion (Silene Vulgaris)
- Lesser Stitchwort (Stellaria graminea)
- Wild Thyme (Thymus polytrichus)
- Red Clover (Trifolium pratense)
- Dog Violet (Viola riviniana)

Corn Cockle (Agrostemma githago)

- Scarlet Pimpernel (Anagallis arvensis)
- Corn Chamomile (Anthemis arvensis)
- Cornflower (Centaurea cyanus)
- Blue Fleabane (Erigeron acer)
- Common Forget-Me-Not (Myosotis arvensis)
- Common Poppy (Papaver rhoas)
- Wild Pansy (Viola tricolor)
- Corn Marigold (Glebione segetum)

Sweet Vernal Grass (Anthoxanthum odoratum)

- Quaking Grass (Briza media)
- Glaucous Sedge (Carex flacca)
- Crested Dog's Tail (Cynosurus cristatus)
- Sheep's Fescue (Festuca ovina)
- Red Fescue (Festuca rura)
- Crested Hair Grass (Koeleria macrantha)
- Yellow Oat-Grass (Trisetum flavescens)

drawing status	S4	●
	FOR TENDER	○
	FOR CONSTRUCTION	○
	AS BUILT	○



David Clarke
LANDSCAPE ARCHITECT

29 Uppertown Road, Gleno, Larne
Co. Antri mBT40 3EA
Tel: 0752805986 / 02890767875
Email: david@david-clarke.net

Client: McAleer & Rushe

Job: The Printworks
819-829, High Road, Tottenham
London N17 8ER

Title: RF Landscape Planting Plan

Dwg Ref: 179-DCA-B1-06-GA-L-90010

Scale: 1:250 @ A1 Date: 11/05/2026

Drawn By: cs Rev: C02