
Materials to match existing unless otherwise stated on the drawings.

Any rooflights not to project more than 150mm from the plane of the roof

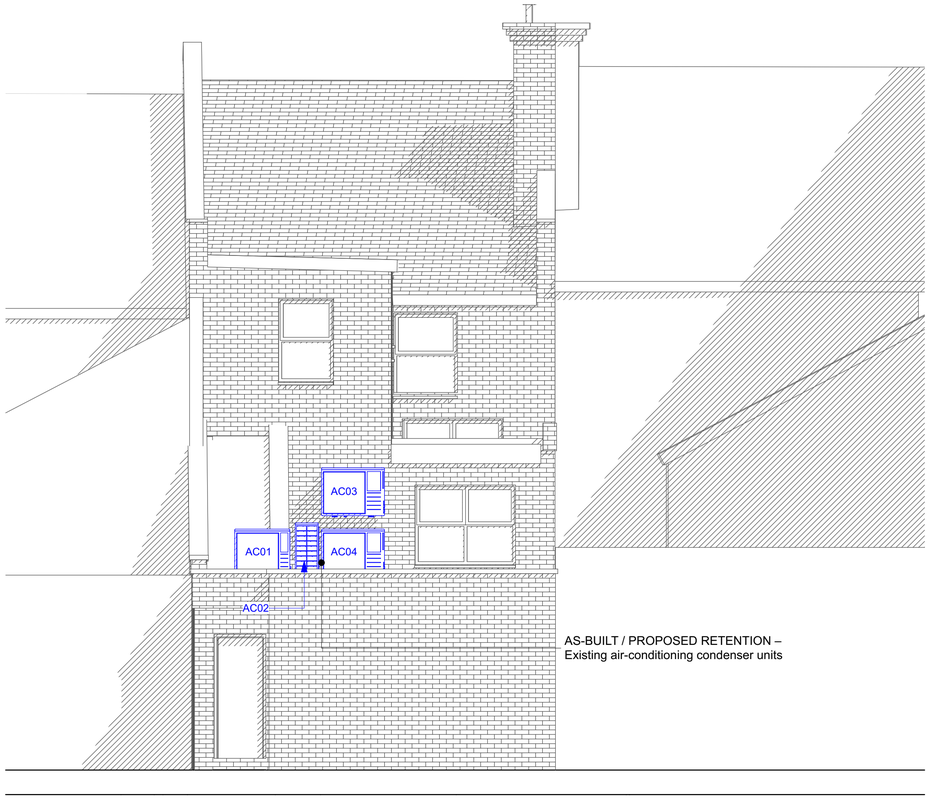

AS-BUILT / PROPOSED RETENTION EAST ELEVATION 1:50



AS-BUILT / PROPOSED RETENTION WEST ELEVATION 1:50

Looking to extend your home?
Call for a free consultation today;
020 8954 6291
www.yooparchitects.co.uk
YOOP Architects, your local architect

Existing
New

YOOP Architects
Office 128, 28A Church Road, Stanmore, Middlesex, HA7 4AW, England
020 8954 6291
studio@yooparchitects.co.uk

Notes
This drawing is copyright of YOOP Architects.
Drawing for planning purposes, not construction

Scale Bar
0 1 2 3 4 5

Scale
1:50 @A1
1:100 @A3

Purpose of Issue
PLANNING

Date of Issue
Thursday, 27 August 2026

Project
Extension & Refurbishment
5 The Broadway, Crouch End, N8 8DS

Project No.
2021/006

Layout Title
AS-BUILT FRONT REAR ELEVATIONS

Drawing Number
006/PR/221

Revision