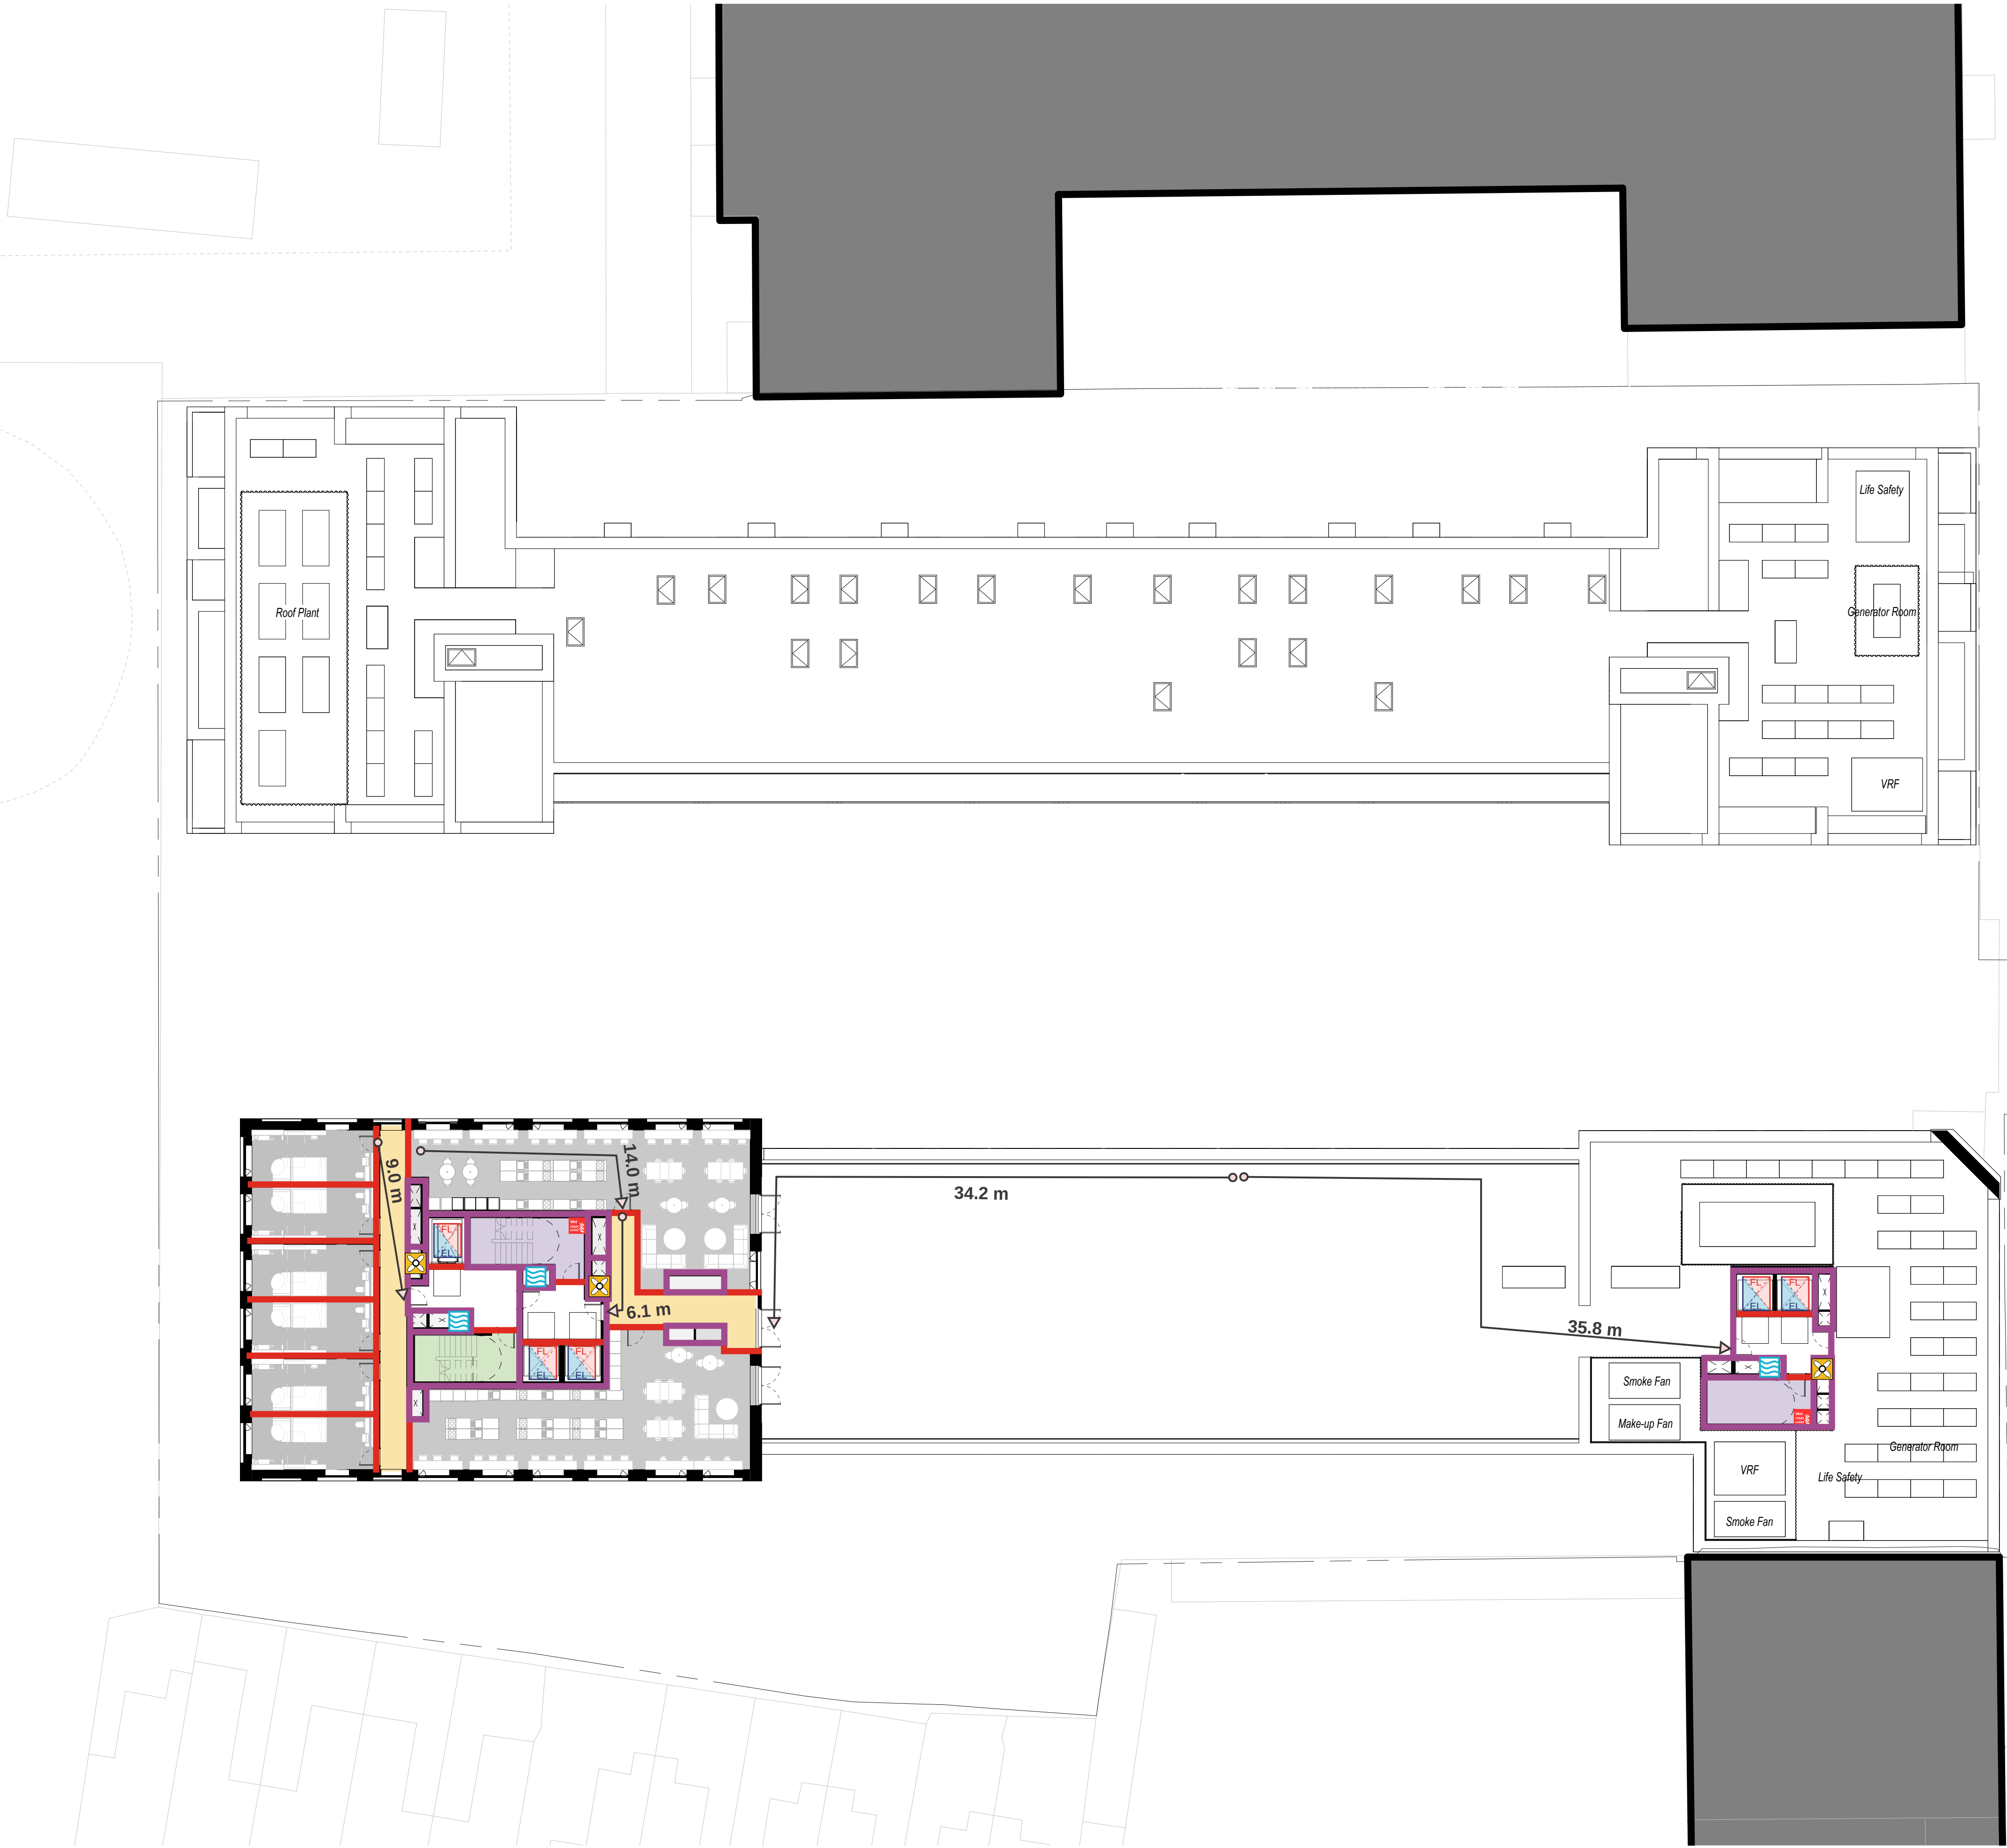




ASHLEY HOUSE SITE - PROPOSED 7th FLOOR PLAN
1 : 200



Project Name:
Ashley Park, Tottenham Hale

Drawing Title:
FIRE STRATEGY MARK-UPS & COMMENTS

Author: CK

Date: 19.08.26

Checked: GT

Issue: 03

 
Project Number: AF 6610

Fire Resistance

Rating (Minutes)	Walls	Doors	
		With Smoke Seals	Without Smoke Seals
30			
60			
120			
240			

Legend

Firefighting Stair

Protected Stair

Mechanically ventilated area

Naturally ventilated area

Evacuation lift

Firefighting/evacuation lift

Natural smoke shaft (1.5m2)

Mechanical extract shaft

Inlet air shaft

AOV at head of stair

Fire Fighting

Dry riser inlet

Dry riser outlet

Wet riser inlet

Wet riser outlet

4.1 m Hose laying distance

FRS access road

FRS vehicle

Hydrant



ASHLEY HOUSE SITE - PROPOSED 8th FLOOR PLAN
1 : 200

**ASHTON** | FIRE

Project Name:
Ashley Park, Tottenham Hale

Drawing Title:
FIRE STRATEGY MARK-UPS & COMMENTS

Author: CK

Date: 19.08.26

Checked: GT

Issue: 03

 
Project Number: AF 6610

 **Fire Resistance**

Rating (Minutes)	Walls	Doors	
		With Smoke Seals	Without Smoke Seals
30			
60			
120			
240			

Legend

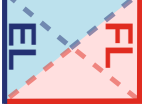
 Firefighting Stair

 Protected Stair

 Mechanically ventilated area

 Naturally ventilated area

 Evacuation lift

 Firefighting/evacuation lift

 Natural smoke shaft (1.5m2)

 Mechanical extract shaft

 Inlet air shaft

 AOV at head of stair

Fire Fighting

 Dry riser inlet

 Dry riser outlet

 Wet riser inlet

 Wet riser outlet

 4.1 m Hose laying distance

 FRS access road

 FRS vehicle

 Hydrant



ASHLEY HOUSE SITE - PROPOSED 9th FLOOR PLAN
1 : 200



ASHTON | FIRE

Project Name:
Ashley Park, Tottenham Hale

Drawing Title:
FIRE STRATEGY MARK-UPS & COMMENTS

Author: CK

Date: 19.08.26

Checked: GT

Issue: 03

Project Number: AF 6610

 
ASHTON | FIRE

Fire Resistance

Rating (Minutes)	Walls	Doors	
		With Smoke Seals	Without Smoke Seals
30			
60			
120			
240			

Legend

Firefighting Stair

Protected Stair

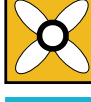
Mechanically ventilated area

Naturally ventilated area

Evacuation lift

Firefighting/evacuation lift

Natural smoke shaft (1.5m2)

Mechanical extract shaft

Inlet air shaft

AOV at head of stair

Fire Fighting

Dry riser inlet

Dry riser outlet

Wet riser inlet

Wet riser outlet

4.1 m
Hose laying distance

FRS access road

FRS vehicle

Hydrant

DOCUMENT NUMBER
AHCF-DLA-ZZ-09-DR-A- 20209DOCUMENT PURPOSE
PLANNINGREVISION
P10



ASHLEY HOUSE SITE - PROPOSED 10th FLOOR PLAN

1 : 200



ASHTON | FIRE

Project Name:

Ashley Park, Tottenham Hale

Drawing Title:

FIRE STRATEGY MARK-UPS & COMMENTS

Author: CK

Date: 19.08.26

Checked: GT

Issue: 03

 
Project Number: AF 6610

Fire Resistance

Rating (Minutes)	Walls	Doors	
		With Smoke Seals	Without Smoke Seals
30			
60			
120			
240			

Legend

Firefighting Stair

Protected Stair

Mechanically ventilated area

Naturally ventilated area

Evacuation lift

Firefighting/evacuation lift

Natural smoke shaft (1.5m2)

Mechanical extract shaft

Inlet air shaft

AOV at head of stair

Fire Fighting

Dry riser inlet

Dry riser outlet

Wet riser inlet

Wet riser outlet

4.1 m

Hose laying distance

FRS access road

FRS vehicle

Hydrant

DOCUMENT NUMBER

AHCF-DLA-ZZ-10-DR-A- 20210

DOCUMENT PURPOSE

PLANNING

REVISION

P10



ASHLEY HOUSE SITE - PROPOSED 11th FLOOR PLAN
1 : 200



ASHTON | FIRE

Project Name:
Ashley Park, Tottenham Hale

Drawing Title:
FIRE STRATEGY MARK-UPS & COMMENTS

Author: CK

Date: 19.08.26

Checked: GT

Issue: 03

 
Project Number: AF 6610

Fire Resistance

Rating (Minutes)	Walls	Doors	
		With Smoke Seals	Without Smoke Seals
30			
60			
120			
240			

Legend

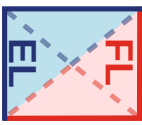
Firefighting Stair

Protected Stair

Mechanically ventilated area

Naturally ventilated area

Evacuation lift

Firefighting/evacuation lift

Natural smoke shaft (1.5m2)

Mechanical extract shaft

Inlet air shaft

AOV at head of stair

Fire Fighting

Dry riser inlet

Dry riser outlet

Wet riser inlet

Wet riser outlet

4.1 m

Hose laying distance

FRS access road

FRS vehicle

Hydrant

DOCUMENT NUMBER
AHCF-DLA-ZZ-11-DR-A- 20211

DOCUMENT PURPOSE
PLANNING

REVISION
P10



ASHLEY HOUSE SITE - PROPOSED 12th FLOOR PLAN
1 : 200



ASHTON | FIRE

Project Name:
Ashley Park, Tottenham Hale

Drawing Title:
FIRE STRATEGY MARK-UPS & COMMENTS

Author: CK

Date: 19.08.26

Checked: GT

Issue: 03

 
Project Number: AF 6610

Fire Resistance

Rating (Minutes)	Walls	Doors	
		With Smoke Seals	Without Smoke Seals
30			
60			
120			
240			

Legend

Firefighting Stair

Protected Stair

Mechanically ventilated area

Naturally ventilated area

Evacuation lift

Firefighting/evacuation lift

Natural smoke shaft (1.5m2)

Mechanical extract shaft

Inlet air shaft

AOV at head of stair

Fire Fighting

Dry riser inlet

Dry riser outlet

Wet riser inlet

Wet riser outlet

4.1 m



Hose laying distance



FRS access road



FRS vehicle



Hydrant

DOCUMENT NUMBER
AHCF-DLA-ZZ-12-DR-A- 20212

DOCUMENT PURPOSE
PLANNING

REVISION
P10



ASHLEY HOUSE SITE - PROPOSED 13th FLOOR PLAN
1 : 200

**ASHTON** | FIRE

Project Name:
Ashley Park, Tottenham Hale

Drawing Title:
FIRE STRATEGY MARK-UPS & COMMENTS

Author: CK

Date: 19.08.26

Checked: GT

Issue: 03

 
Project Number: AF 6610

 **Fire Resistance**

Rating (Minutes)	Walls	Doors	
		With Smoke Seals	Without Smoke Seals
30			
60			
120			
240			

Legend

 Firefighting Stair

 Protected Stair

 Mechanically ventilated area

 Naturally ventilated area

 Evacuation lift

 Firefighting/evacuation lift

 Natural smoke shaft (1.5m2)

 Mechanical extract shaft

 Inlet air shaft

 AOV at head of stair

Fire Fighting

 Dry riser inlet

 Dry riser outlet

 Wet riser inlet

 Wet riser outlet

 4.1 m Hose laying distance

 FRS access road

 FRS vehicle

 Hydrant

DOCUMENT NUMBER
AHCF-DLA-ZZ-13-DR-A- 20213

DOCUMENT PURPOSE
PLANNING

REVISION
P10



ASHLEY HOUSE SITE - PROPOSED 14th FLOOR PLAN
1 : 200



Project Name:
Ashley Park, Tottenham Hale

Drawing Title:
FIRE STRATEGY MARK-UPS & COMMENTS

Author: CK

Date: 19.08.26

Checked: GT

Issue: 03

Project Number: AF 6610

Fire Resistance

Rating (Minutes)	Walls	Doors	
		With Smoke Seals	Without Smoke Seals
30			
60			
120			
240			

Legend

Firefighting Stair

Protected Stair

Mechanically ventilated area

Naturally ventilated area

Evacuation lift

Firefighting/evacuation lift

Natural smoke shaft (1.5m2)

Mechanical extract shaft

Inlet air shaft

AOV at head of stair

Fire Fighting

Dry riser inlet

Dry riser outlet

Wet riser inlet

Wet riser outlet

4.1 m

FRS access road

FRS vehicle

Hydrant

DOCUMENT NUMBER

AHCF-DLA-ZZ-14-DR-A- 20214

DOCUMENT PURPOSE

PLANNING

REVISION

P10



ASHLEY HOUSE SITE - PROPOSED 15th FLOOR PLAN
1 : 200

Project Name:
Ashley Park, Tottenham Hale

Drawing Title:
FIRE STRATEGY MARK-UPS & COMMENTS

Author: CK

Date: 19.08.26

Checked: GT

Issue: 03

Project Number: AF 6610

Fire Resistance

Rating (Minutes)	Walls	Doors	
		With Smoke Seals	Without Smoke Seals
30			
60			
120			
240			

Legend

Firefighting Stair

Protected Stair

Mechanically ventilated area

Naturally ventilated area

Evacuation lift

Firefighting/evacuation lift

Natural smoke shaft (1.5m2)

Mechanical extract shaft

Inlet air shaft

AOV at head of stair

Fire Fighting

Dry riser inlet

Dry riser outlet

Wet riser inlet

Wet riser outlet

Hose laying distance

FRS access road

FRS vehicle

Hydrant



ASHLEY HOUSE SITE - PROPOSED 16th FLOOR PLAN
1 : 200



Project Name:
Ashley Park, Tottenham Hale

Drawing Title:
FIRE STRATEGY MARK-UPS & COMMENTS

Author: CK

Date: 19.08.26

Checked: GT

Issue: 03

 
Project Number: AF 6610

Fire Resistance

Rating (Minutes)	Walls	Doors	
		With Smoke Seals	Without Smoke Seals
30			
60			
120			
240			

Legend

Firefighting Stair

Protected Stair

Mechanically ventilated area

Naturally ventilated area

Evacuation lift

Firefighting/evacuation lift

Natural smoke shaft (1.5m2)

Mechanical extract shaft

Inlet air shaft

AOV at head of stair

Fire Fighting

Dry riser inlet

Dry riser outlet

Wet riser inlet

Wet riser outlet

4.1 m

Hose laying distance

FRS access road

FRS vehicle

Hydrant

DOCUMENT NUMBER

AHCF-DLA-ZZ-16-DR-A- 20216

DOCUMENT PURPOSE

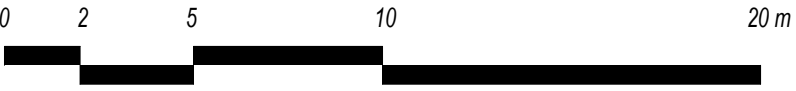
PLANNING

REVISION

P10



ASHLEY HOUSE SITE - PROPOSED 17th FLOOR PLAN
1 : 200



Project Name:
Ashley Park, Tottenham Hale

Drawing Title:
FIRE STRATEGY MARK-UPS & COMMENTS

Author: CK

Date: 19.08.26

Checked: GT

Issue: 03

Project Number: AF 6610

Fire Resistance

Rating (Minutes)	Walls	Doors	
		With Smoke Seals	Without Smoke Seals
30			
60			
120			
240			

Legend

Firefighting Stair

Protected Stair

Mechanically ventilated area

Naturally ventilated area

Evacuation lift

Firefighting/evacuation lift

Natural smoke shaft (1.5m2)

Mechanical extract shaft

Inlet air shaft

AOV at head of stair

Fire Fighting

Dry riser inletDry riser outletWet riser inletWet riser outlet4.1 m
Hose laying distanceFRS access roadFRS vehicleHydrantDOCUMENT NUMBER
AHCF-DLA-ZZ-17-DR-A- 20217

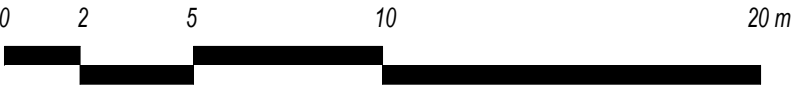
DOCUMENT PURPOSE
PLANNING

REVISION
P10



ASHLEY HOUSE SITE - PROPOSED 18th FLOOR PLAN

1 : 200



Project Name:
Ashley Park, Tottenham Hale

Drawing Title:
FIRE STRATEGY MARK-UPS & COMMENTS

Author: CK

Date: 19.08.26

Checked: GT

Issue: 03

Project Number: AF 6610

Fire Resistance

Rating (Minutes)	Walls	Doors	
		With Smoke Seals	Without Smoke Seals
30			
60			
120			
240			

Legend

Firefighting Stair

Protected Stair

Mechanically ventilated area

Naturally ventilated area

Evacuation lift

Firefighting/evacuation lift

Natural smoke shaft (1.5m2)

Mechanical extract shaft

Inlet air shaft

AOV at head of stair

Fire Fighting

Dry riser inlet

Dry riser outlet

Wet riser inlet

Wet riser outlet

Hose laying distance

FRS access road

FRS vehicle

Hydrant

DOCUMENT NUMBER

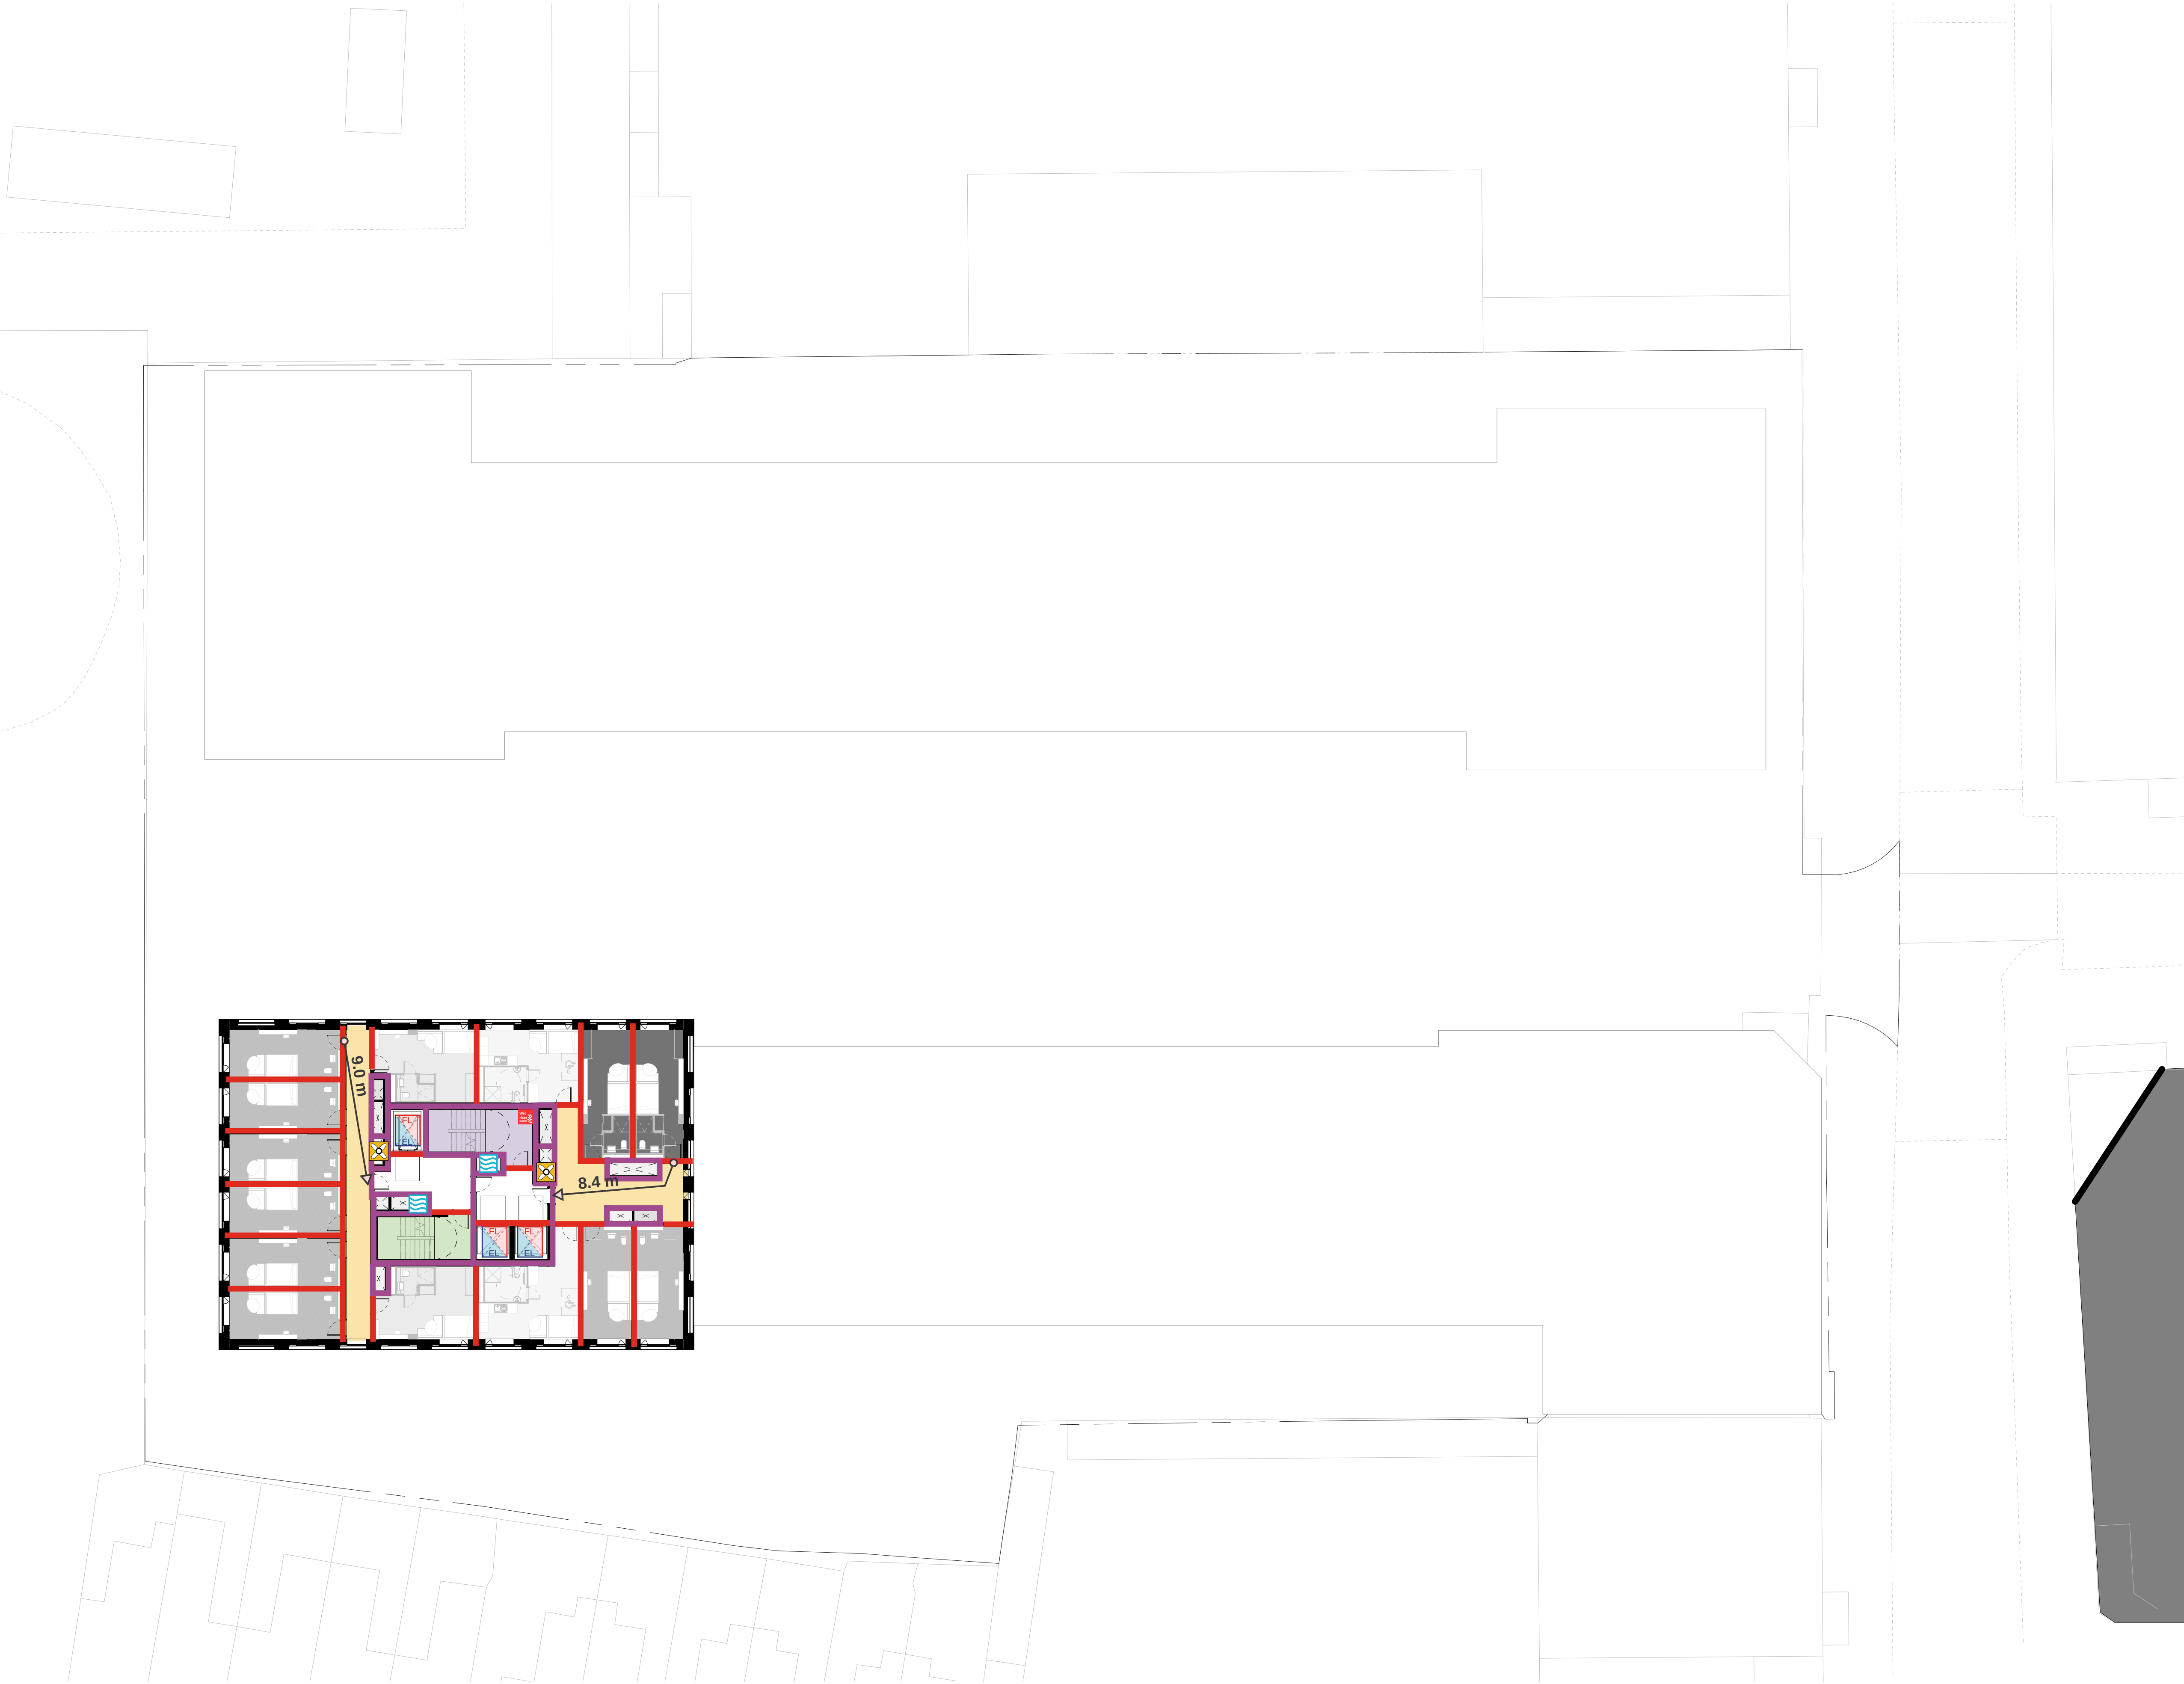
AHCF-DLA-ZZ-18-DR-A- 20218

DOCUMENT PURPOSE

PLANNING

REVISION

P10



ASHLEY HOUSE SITE - PROPOSED 19th FLOOR PLAN
1 : 200



Project Name:
Ashley Park, Tottenham Hale

Drawing Title:
FIRE STRATEGY MARK-UPS & COMMENTS

Author: CK

Date: 19.08.26

Checked: GT

Issue: 03

 
Project Number: AF 6610

Fire Resistance

Rating (Minutes)	Walls	Doors	
		With Smoke Seals	Without Smoke Seals
30			
60			
120			
240			

Legend

Firefighting Stair

Protected Stair

Mechanically ventilated area

Naturally ventilated area

Evacuation lift

Firefighting/evacuation lift

Natural smoke shaft (1.5m2)

Mechanical extract shaft

Inlet air shaft

AOV at head of stair

Fire Fighting

Dry riser inlet

Dry riser outlet

Wet riser inlet

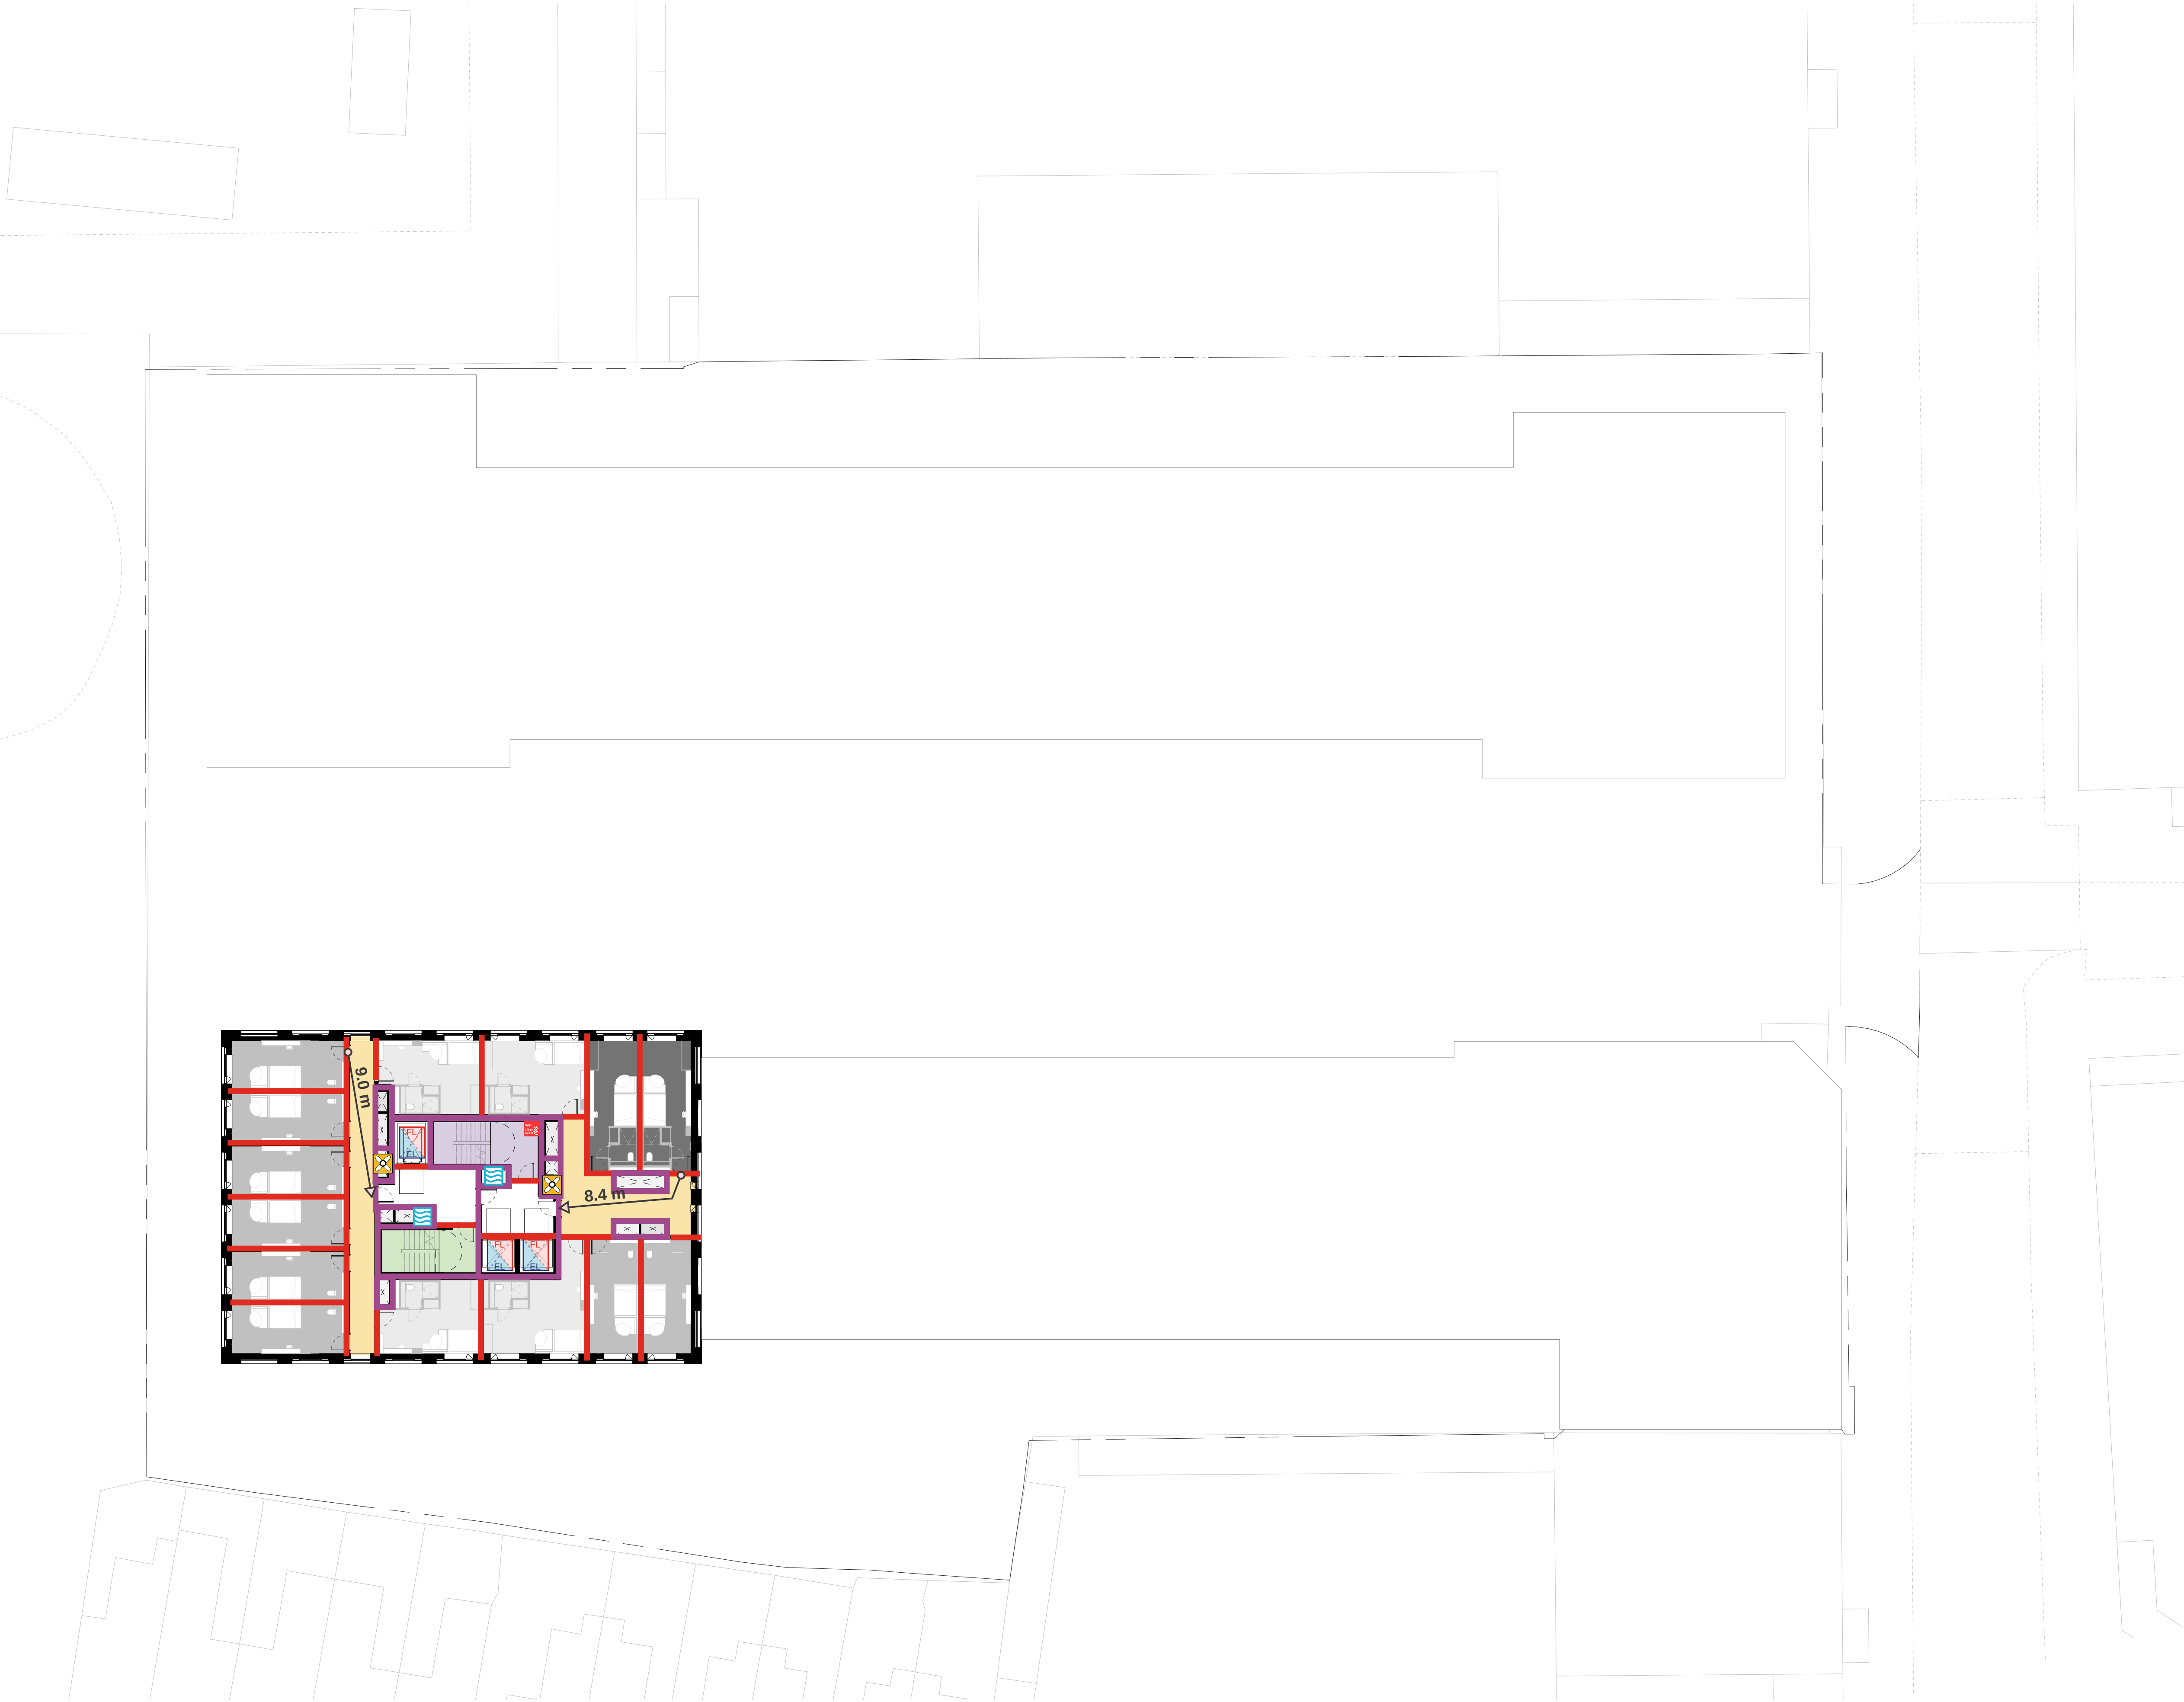
Wet riser outlet

Hose laying distance

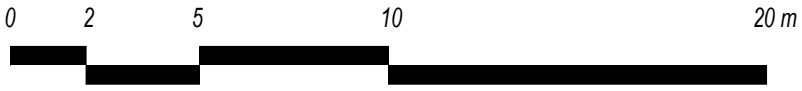
FRS access road

FRS vehicle

Hydrant



ASHLEY HOUSE SITE - PROPOSED 20th FLOOR PLAN
1 : 200



Project Name:
Ashley Park, Tottenham Hale

Drawing Title:
FIRE STRATEGY MARK-UPS & COMMENTS

Author: CK

Date: 19.08.26

Checked: GT

Issue: 03

Project Number: AF 6610

Fire Resistance

Rating (Minutes)	Walls	Doors	
		With Smoke Seals	Without Smoke Seals
30			
60			
120			
240			

Legend

Firefighting Stair

Protected Stair

Mechanically ventilated area

Naturally ventilated area

Evacuation lift

Firefighting/evacuation lift

Natural smoke shaft (1.5m2)

Mechanical extract shaft

Inlet air shaft

AOV at head of stair

Fire Fighting

Dry riser inlet

Dry riser outlet

Wet riser inlet

Wet riser outlet

Hose laying distance

FRS access road

FRS vehicle

Hydrant

DOCUMENT NUMBER

AHCF-DLA-ZZ-19-DR-A- 20220

DOCUMENT PURPOSE

PLANNING

REVISION

P11