
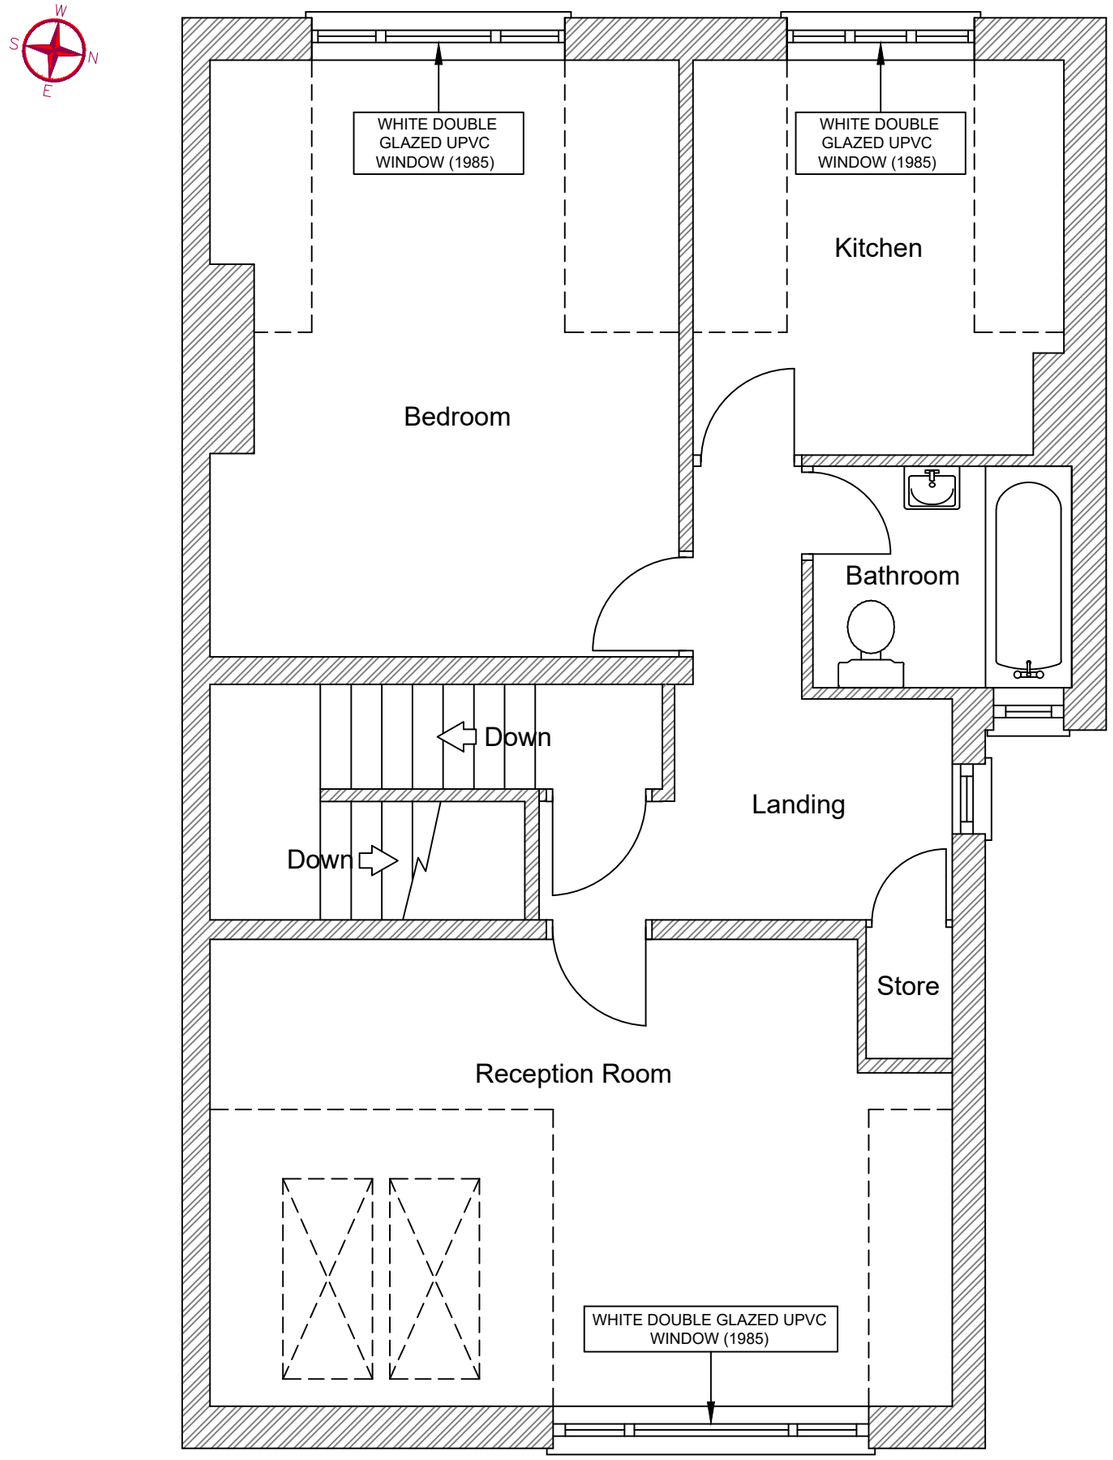


PLAN LAYOUT BEFORE WORKS

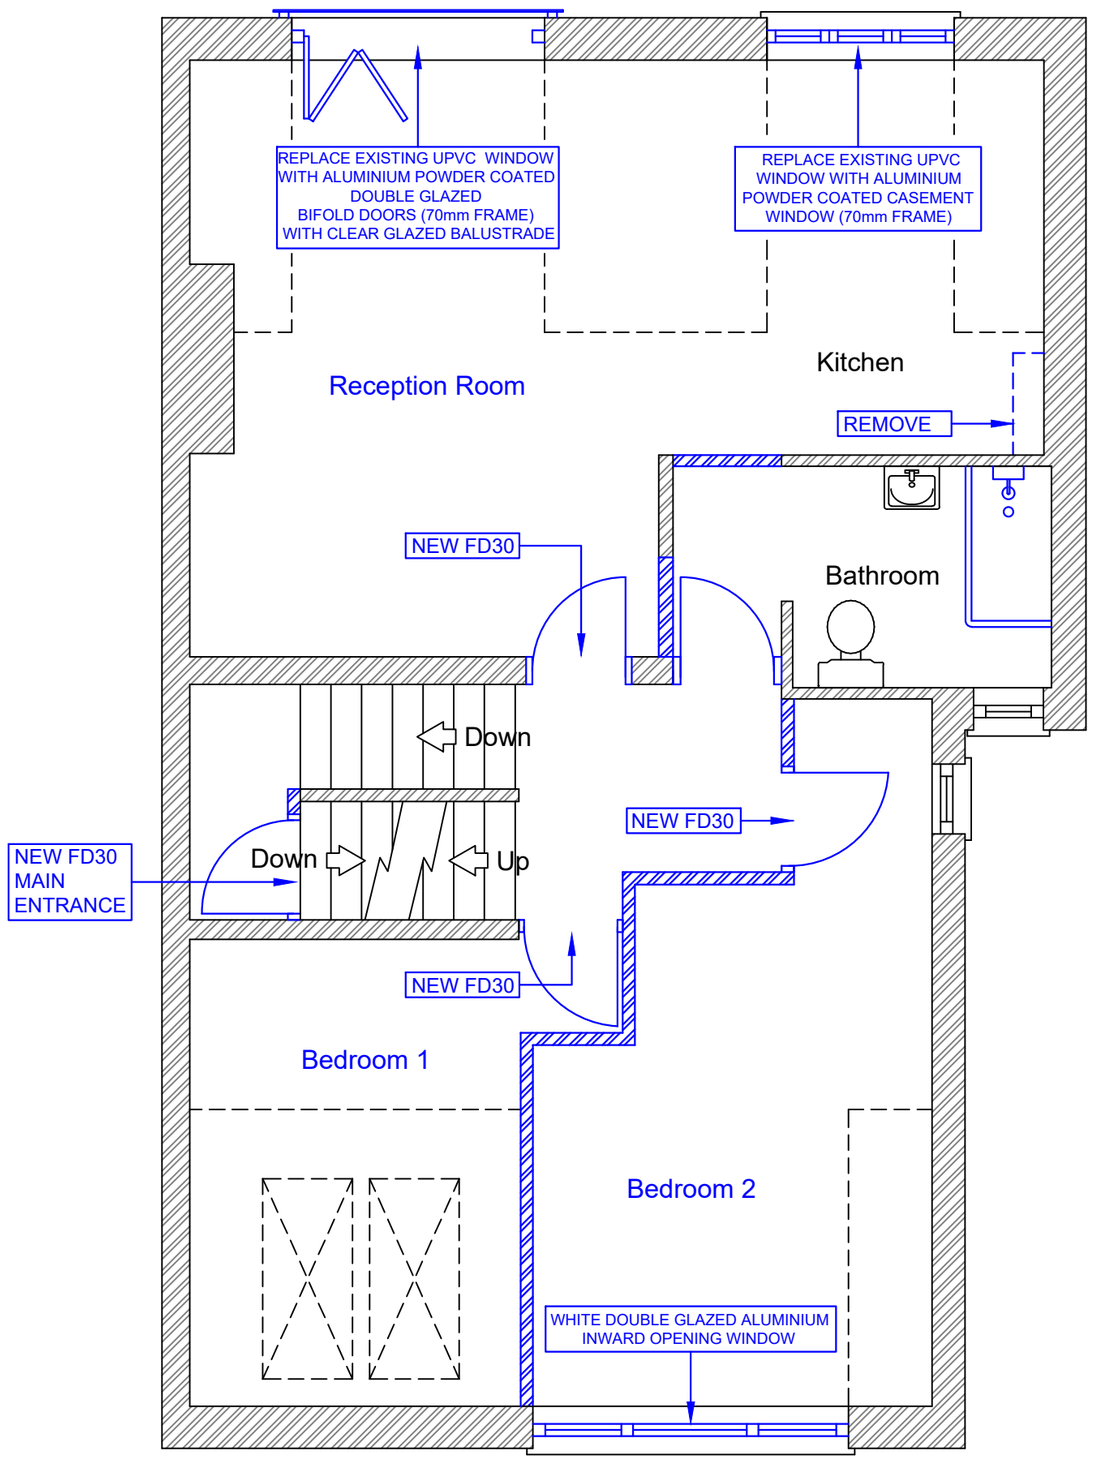

PLAN LAYOUT AS EXISTING AND PROPOSED

NO FURTHER WORKS PROPOSED. THE DEVELOPMENT IS SHOWN AS BUILT.

0 1 2 3 4

Scale Bar Metres

ISSUE:	DESCRIPTION:	DATE:
D	GENERAL AMENDMENT	25.09.26
C	LANDING DOORS RECONFIG.	17.11.25
B	BATHROOM DOOR RELOCATED	08.02.23
A	FIRST ISSUE	07.10.19

S Carver
22B Talbot Road
Highgate, London
N6 4QR

This drawing is issued on the condition that it is not copied in full or in part, or it's contents communicated to any party without first obtaining the permission of Mr Andrew Marshall

DATE: 08.10.19
DRAWN: C Halsall
SCALE: 1:50 @ A3

PROJECT TITLE: AMENDMENTS
22B TALBOT ROAD
HIGHGATE
LONDON, N6 4RQ

DRAWING TITLE: EXISTING & PROPOSED PLAN LAYOUT

DRAWING No.: AM-TR-01
SHEET: 1 of 1
ISSUE: D