
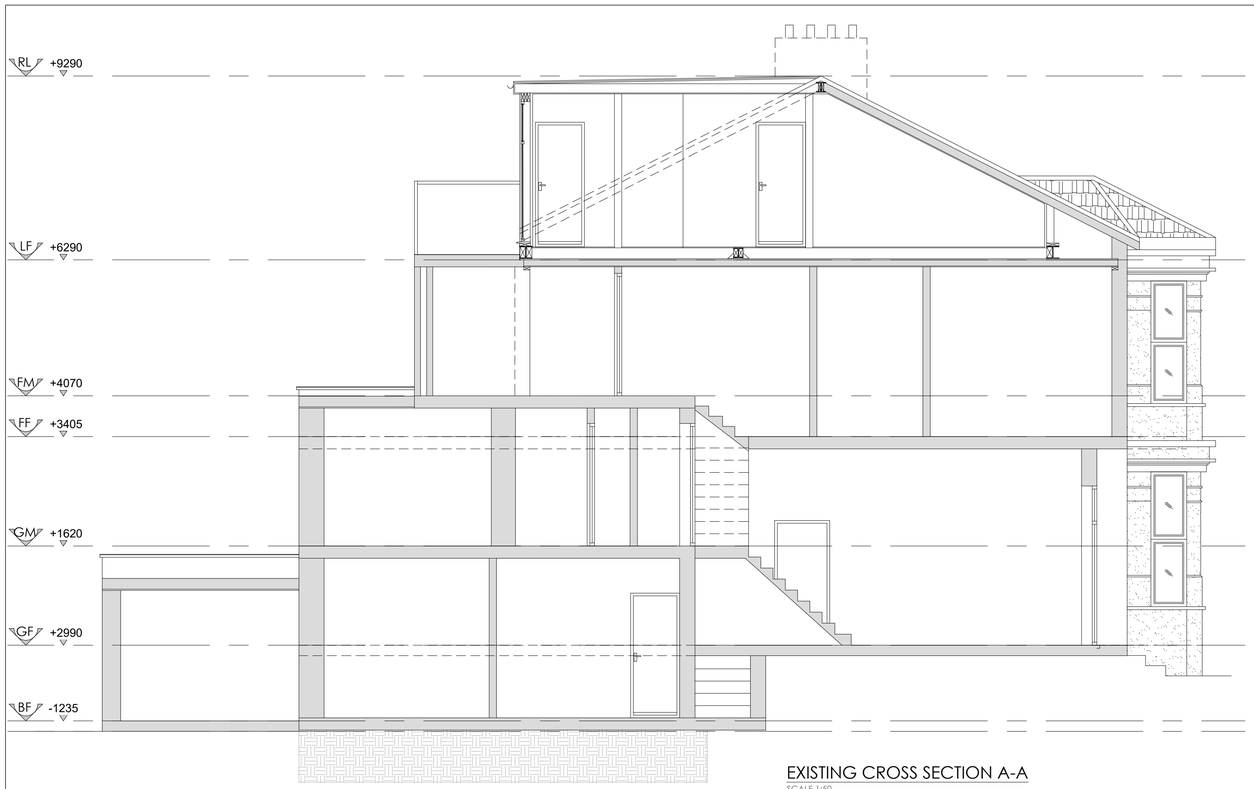



EXISTING CROSS SECTION A-A

SCALE 1:50

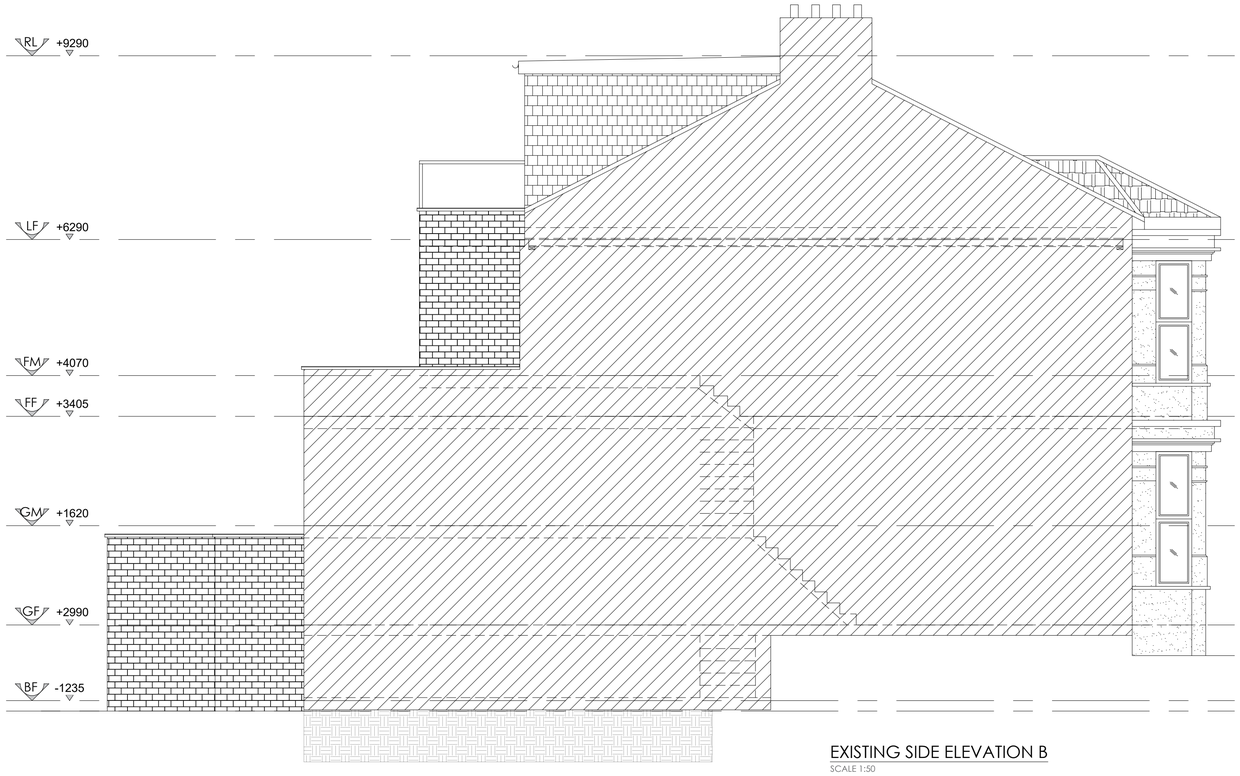

EXISTING SIDE ELEVATION B

SCALE 1:50

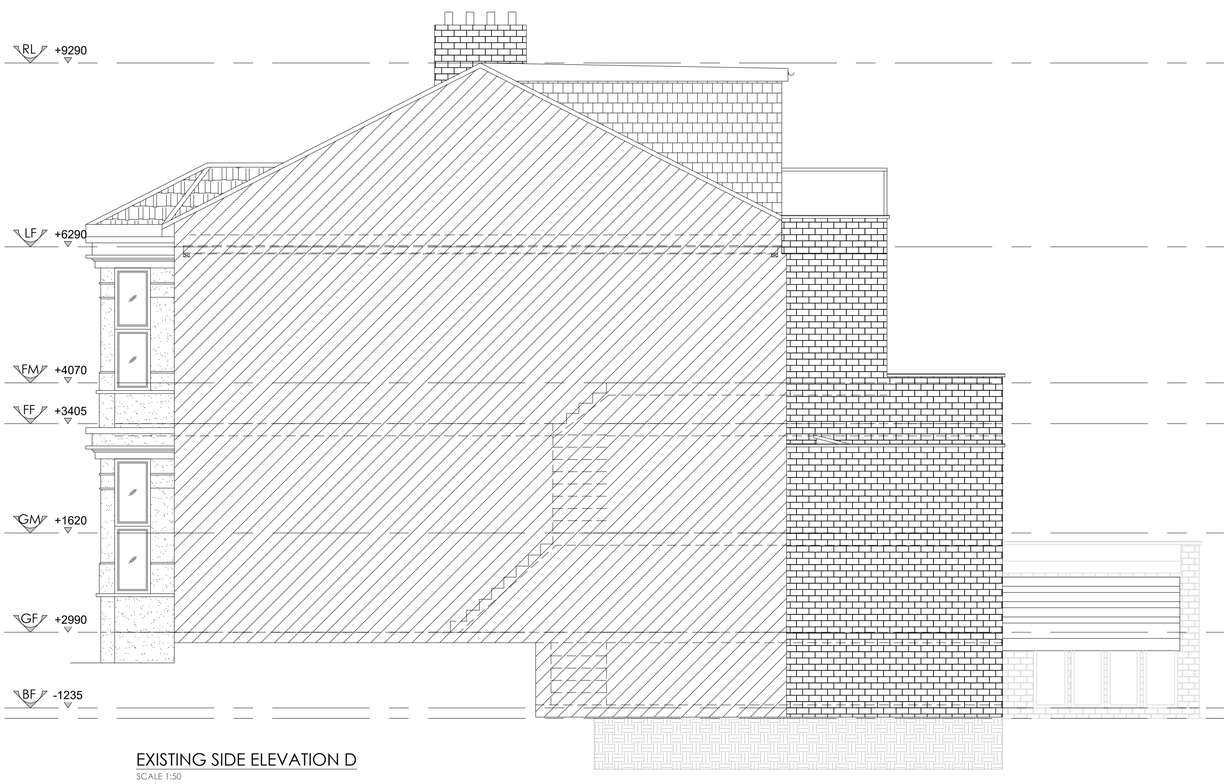

EXISTING SIDE ELEVATION D

SCALE 1:50

Demolition line

1:50
0 1 2 3 4 cm
0 1000 2000 3000 4000 mm

Do not scale off the drawings (scale only for planning purposes).

malathy design
www.malathydesign.com
02037 462 100
074 6610 3263

ARCH./CLIENT
—

Project Title
43 VARTRY ROAD LONDON N15 6PR

Drawing Title
AS-BUILT ELEVATIONS AND SECTION

Drawn: BC
Checked: SP
Scale: 1:50
Size: A1
Project No.: 2726
Drawing No.: P-04
Rev.: A