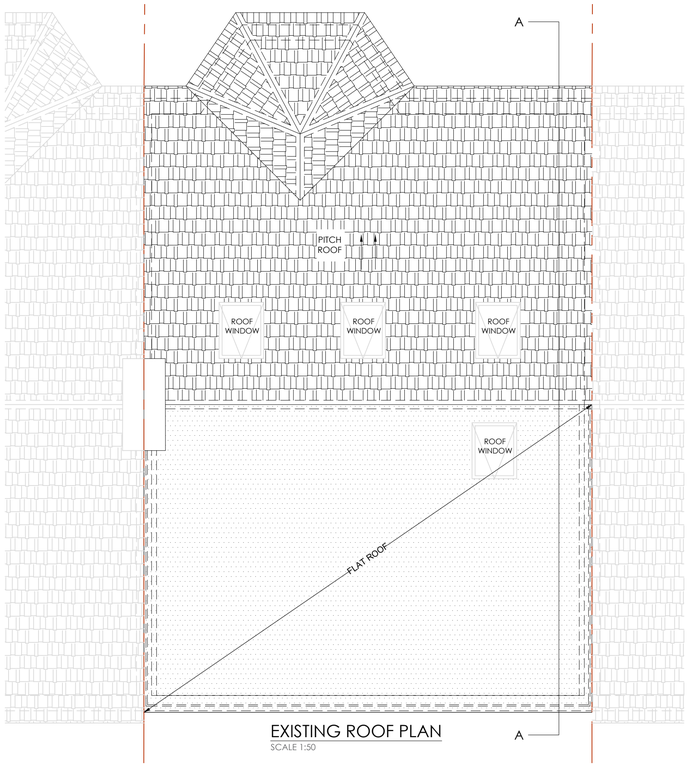
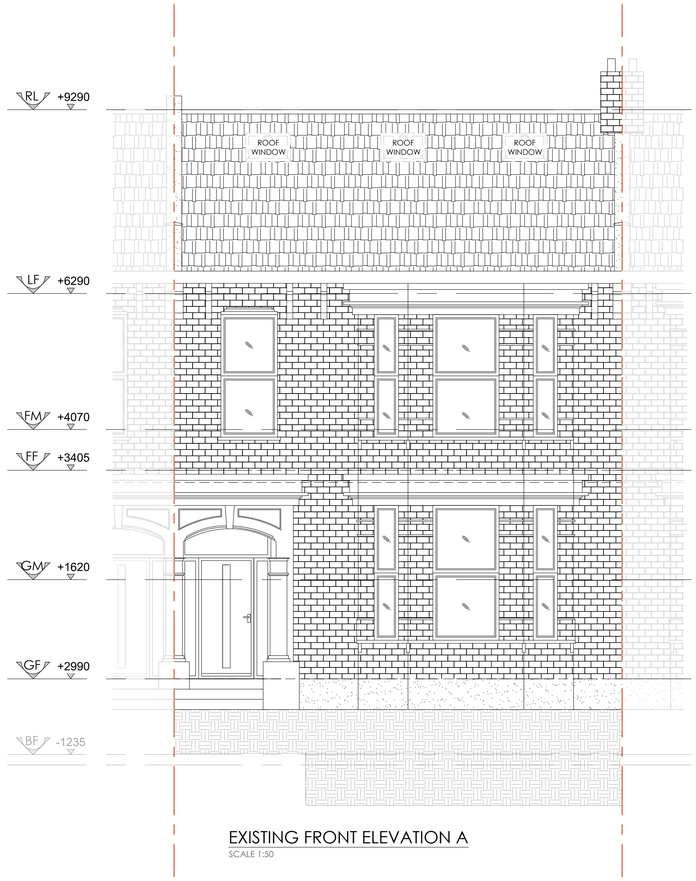


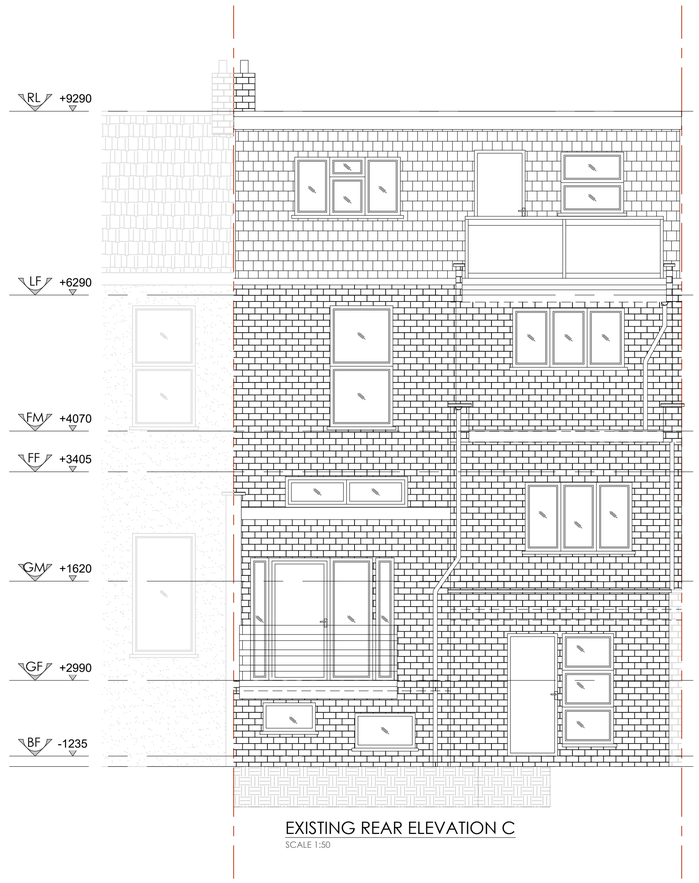

EXISTING ROOF PLAN

SCALE 1:50




EXISTING FRONT ELEVATION A

SCALE 1:50




EXISTING REAR ELEVATION C

SCALE 1:50

Demolition line

1:50

0 1 2 3 4 cm

0 1000 2000 3000 4000 mm

Do not scale off the drawings (scale only for planning purposes).

malathy design

www.malathydesign.com
02037 462 100
074 6610 3263

ARCH./CLIENT

—

Project Title

43 VARTRY ROAD LONDON N15 6PR

Drawing Title

AS-BUILT FLOOR ROOF PLAN AND ELEVATIONS

Drawn: BC

Checked: SP

Scale: 1:50

Size: A1

Project No.: 2726

Drawing No.: P-03

Rev.: A